PHARR-SAN JUAN-ALAMO ISD

Purchasing Department

Emily Garza, Director of Purchasing

October 2, 2018

ADDENDUM#3

To Whom It May Concern:

Concerning the <u>"PSJA ISD AGRICULTURAL FACILITY PHASE I BID # 18-19-003"</u> to be opened at 4:00p.m., Thursday, OCTOBER 4, 2018. Please consider the following:

PLEASE SEE ATTACHMENT

For any questions pertaining to these changes, please contact Janet Robles, Chief Financial Officer or Monique Richie, Purchasing Secretary at (956) 354-2000. Please include a signed copy of the "ADDENDUM ACKNOWLEDGMENT FORM # 3" with your bid / proposal.

Sincerely,

Emily Garza

Director of Purchasing

Emily Garya

ADDENDUM ACKNOWLEDGMENT FORM (To Be Submitted)

October 2, 2018

This form is to acknowledge that I have received **ADDENDUM #3 – "PSJA ISD AGRICULTURAL FACILITY PHASE I BID # 18-19-003"** to be opened at 4:00P.M., Thursday, October 4, 2018. Please sign and submit with bid / proposal package.

COMPANY NAME:	
AUTHORIZED SIGNATURE:	
AUTHORIZED SIGNATURE (PRINT):	
ADDRESS:	
CITY / STATE / ZIP:	
TELEPHONE NUMBER:	
FAX NUMBER:	

ADDENDUM NUMBER THREE (3) TO THE PLANS AND SPECIFICATIONS FOR:

PSJA Agricultural Facility – Phase I PSJA ISD Bid # Project No. 16.08

GIGNAC & ASSOCIATES 416 STARR STREET CORPUS CHRISTI, TEXAS 78401 (361) 884-2661 October 2, 2018

GISUAC & ASSOCIATES 3700 N. 10th STREET, SUITE 205 McALLEN, TEXAS 78501 (956) 686-0100

This addendum is generally separated into sections for convenience; however, all contractors, subcontractors, materialmen, and other parties shall be responsible for reading the entire addendum. The failure to list an item or items in all affected sections of this addendum does not relieve any party affected from performing as per instructions, provided that the information is set forth any time, any place in this addendum. These documents shall be attached to and become a part of the contract documents for this project.

SPECIFICATION ITEMS:

Item S-1

RFI: The spec. calls out for the glass to be 1-5/16" which is not necessary this far inland and will not fit in the window system spec'd. Would you want to use 1" overall glass with the same makeup (Solarban 70XL (#2) Azuria Tempered, 1/2 Airspace, 1/4" Clear Tempered) or change opening system to accommodate the wider glass?

Sheet A-500

Refer to Sheet A-500 regarding window thickness, 1" thickness will be used.

Item S-2

RFI: The Alternate Bid Form only indicates one Alternate; will this sheet be revised so that we have space for both Alternates?

Section <u>004323 Alternates Form</u>

Yes, Refer to attached updated Section 004323 Alternates Form.

Item S-3

RFI: How many copies do we provide at bid? (Bid Proposal & other required information). **RFI:** How many copies of the bid proposal and other forms need to be provided for the bid?

Refer to front end section in Project Manual, 3 copies.

Item S-4

RFI: Can the HUB Subcontractor Plan be turned in 24 hours after the bid?

No, only the Subcontractor List. All other forms required must be submitted at designated time.

Item S-5

RFI: The Section 13125 includes elevated Bleachers and a Press Box specifications for an 8 foot x 15 foot box. However there are no elevations or plan views that indicate a press box to be included with the bleachers. Please confirm that no press box is to be included with this scope of work.

Void Section 2.03 in Specification 13125, no press box shall be required.

Item S-6

RFI: On sheet AS102 detail 7 depicts a rolling gate which is constructed of chain link fencing. Its noted that chain link fencing is utilized throughout the project. Specification 32 31 13 section 2.5 calls for Industrial Horizontal-Slide Gates. Please advise which material/detail should be used for the main entrance gate.

Under Specification 323113, section 2.5 INDUSTRIAL HORIZONTAL-SLIDE GATES, part A General, point 1 Classification shall be Rolling Gate in lieu on Cantilever.

Item S-7

RFI: Alternate 2 calls for concrete paving in lieu of asphalt. Please confirm that Alternate 2 is to provide a price to change only the base bid Asphalt area to concrete and not to include the additional parking area (shown on plan east side by Veterans Blvd).

RFI: Sheet C-10 is titled Alternate 3. please clarify if in fact there is an Alternate 3.

Section 012300 Alternates & Sheet C-10

Refer to Section 012300 Alternates regarding what is listed under Alternate 1, Alternate 2, and Alternate 3. Also see attached revised Sheet C-10 for clarity.

CLARIFICATION ITEMS:

Item C-1

RFI: The Facility will not have climate control in the open area as shown in the mechanical drawings. Will the fire sprinkler system require a wet or dry system? Please confirm.

Sheet FP-100

Dry system, See revised Sheet FP-100

Item C-2

RFI: In regard to the fire sprinkler piping, should black steel pipe be installed as shown on Part 2.02A of the specifications (Sheet FP-200) or galvanized pipe since the system will be exposed? Please confirm.

Sheet FP-100 & FP-200

Galvanized Pipe, See revised Sheet FP-100 and FP-200 for clarification.

Item C-3

RFI: We would like to get clarification on the 'PSJA ISD Agricultural Facility' Project. Addendum #1 asks for 850 sq. ft. of Hydromulch, but our calculations with the provided plan gave us a total of 52,763.991 sq. ft. We would like to get clarification on the provided area to give an accurate pricing for this bid proposal.

Section 329300 Plant Materials

Refer to revised Section 329300 Plant Materials.

PLAN ITEMS:

Item P-1

RFI: See attached sheet S2.2 alternate #1 foundation has no slab in Exercise Arena. What do you want for general contractor to place in Exercise Arena for example top soil, sand, etc..... Please verify/clarify.

Sheet S2.2-R2

Refer to revised Sheet S2.2-R2 for clarification regarding slab in Exercise Arena.

Owner has stated earth and 6" of sand for the area where the animals will exercise in the arena.



Agricultural Facility SECTION 004323 - ALTERNATES FORM PART 1 - Alternates Form **BID INFORMATION** 1.1 Α. Bidder: Project Name: PSJA Agricultural Facility Phase I B. Project Location: +/- 2300 S. I Rd., Pharr, TX 78577 C. D. Owner: Pharr, San Juan, Alamo ISD Owner Project Number: #18-19-003 E. Architect: Gignac & Associates F. Architect Project Number: 16.08 G. **BID FORM SUPPLEMENT** 1.2 This form is required to be attached to the Bid Form. Α. **DESCRIPTION** 1.3 Α. The undersigned Bidder proposes the amount below be added to or deducted from the Base Bid if particular alternates are accepted by Owner. Amounts listed for each alternate include costs of related coordination, modification, or adjustment. B. The Bidder shall be responsible for determining from the Contract Documents the affects of each alternate on the Contract Time and the Contract Sum. C. Owner reserves the right to accept or reject any alternate, in any order, and to award or amend the Contract accordingly within 30 days of the Notice of Award unless otherwise indicated in the Contract Documents. Acceptance or non-acceptance of any alternates by the Owner shall have no affect on the D. Contract Time unless the "Schedule of Alternates" Article below provides a formatted space for the adjustment of the Contract Time. SCHEDULE OF ALTERNATES 1.4 Alternate No. One: Add Exercise Pavilion, additional parking lot, bleachers and its associated Α. site work as shown in the contract documents. 1. ADD DEDUCT NO CHANGE . 2. Dollars 3. ADD DEDUCT calendar days to adjust the Contract Time for this alternate. Alternate No. Two: Provide concrete paving in lieu of asphalt paving in the base bid as shown in B. the contract documents. ADD DEDUCT NO CHANGE . 1. 2. **Dollars** 3. ADD DEDUCT calendar days to adjust the Contract Time for this alternate. Alternate No. Three: Provide concrete paving in lieu of the asphalt paving for the Alternate One C. parking lot as shown in the contract documents. 1. ADD DEDUCT NO CHANGE .

ADD DEDUCT ___ calendar days to adjust the Contract Time for this alternate.

2.

3.

_____ Dollars



Agricultural Facility

1.5	SUBMISSION OF BID SUPPLEMENT		
A.	Respectfully submitted this day of	, 2018.	
В.	Submitted By:corporation).	(Insert name of bidding firm o	
C.	Authorized Signature:	(Handwritten signature).	
D.	Signed By:	(Type or print name).	
E.	Title:	(Owner/Partner/President/Vice President).	

END OF SECTION 004323



Agricultural Facility

SECTION 012300 - ALTERNATES

PART 1 - GENERAL

- 1.1 RELATED DOCUMENTS
 - A. Drawings and general provisions of the Contract, including General and Supplementary Conditions and other Division 01 Specification Sections, apply to this Section.
- 1.2 SUMMARY
 - A. Section includes administrative and procedural requirements for alternates.
- 1.3 DEFINITIONS
 - A. Alternate: An amount proposed by bidders and stated on the Bid Form for certain work defined in the bidding requirements that may be added to or deducted from the base bid amount if Owner decides to accept a corresponding change either in the amount of construction to be completed or in the products, materials, equipment, systems, or installation methods described in the Contract Documents.
 - Alternates described in this Section are part of the Work only if enumerated in the Agreement.
 - 2. The cost or credit for each alternate is the net addition to or deduction from the Contract Sum to incorporate alternate into the Work. No other adjustments are made to the Contract Sum.

1.4 PROCEDURES


- A. Coordination: Revise or adjust affected adjacent work as necessary to completely integrate work of the alternate into Project.
 - Include as part of each alternate, miscellaneous devices, accessory objects, and similar items incidental to or required for a complete installation whether or not indicated as part of alternate.
- B. Notification: Immediately following award of the Contract, notify each party involved, in writing, of the status of each alternate. Indicate if alternates have been accepted, rejected, or deferred for later consideration. Include a complete description of negotiated revisions to alternates.
- C. Execute accepted alternates under the same conditions as other work of the Contract.
- D. Schedule: A schedule of alternates is included at the end of this Section. Specification Sections referenced in schedule contain requirements for materials necessary to achieve the work described under each alternate.


PART 2 - PRODUCTS (Not Used)

PART 3 - EXECUTION

- 3.1 SCHEDULE OF ALTERNATES
 - A. Alternate No. One (1): Addition of exercise pavilion.
 - 1. Provide all material, equipment, and labor to construct the exercise pavilion, additional parking lot, associated flatwork, and bleachers. All associated architectural, structural, civil, and MEP work as shown in the drawings and specifications.
 - B. Alternate No. Two (2): Concrete drives in lieu of asphalt
 - Provide concrete paving in lieu of asphalt paving as indicated in the civil drawings and shown in the specifications.
 - C. Alternate No. Three (3); Concrete top for Alternate One parking lot.
 - 1. Provide concrete paving in lieu of asphalt paving as indicated in the civil drawings and shown in the specifications for the **Alternate One parking lot addition**.

END OF SECTION 012300

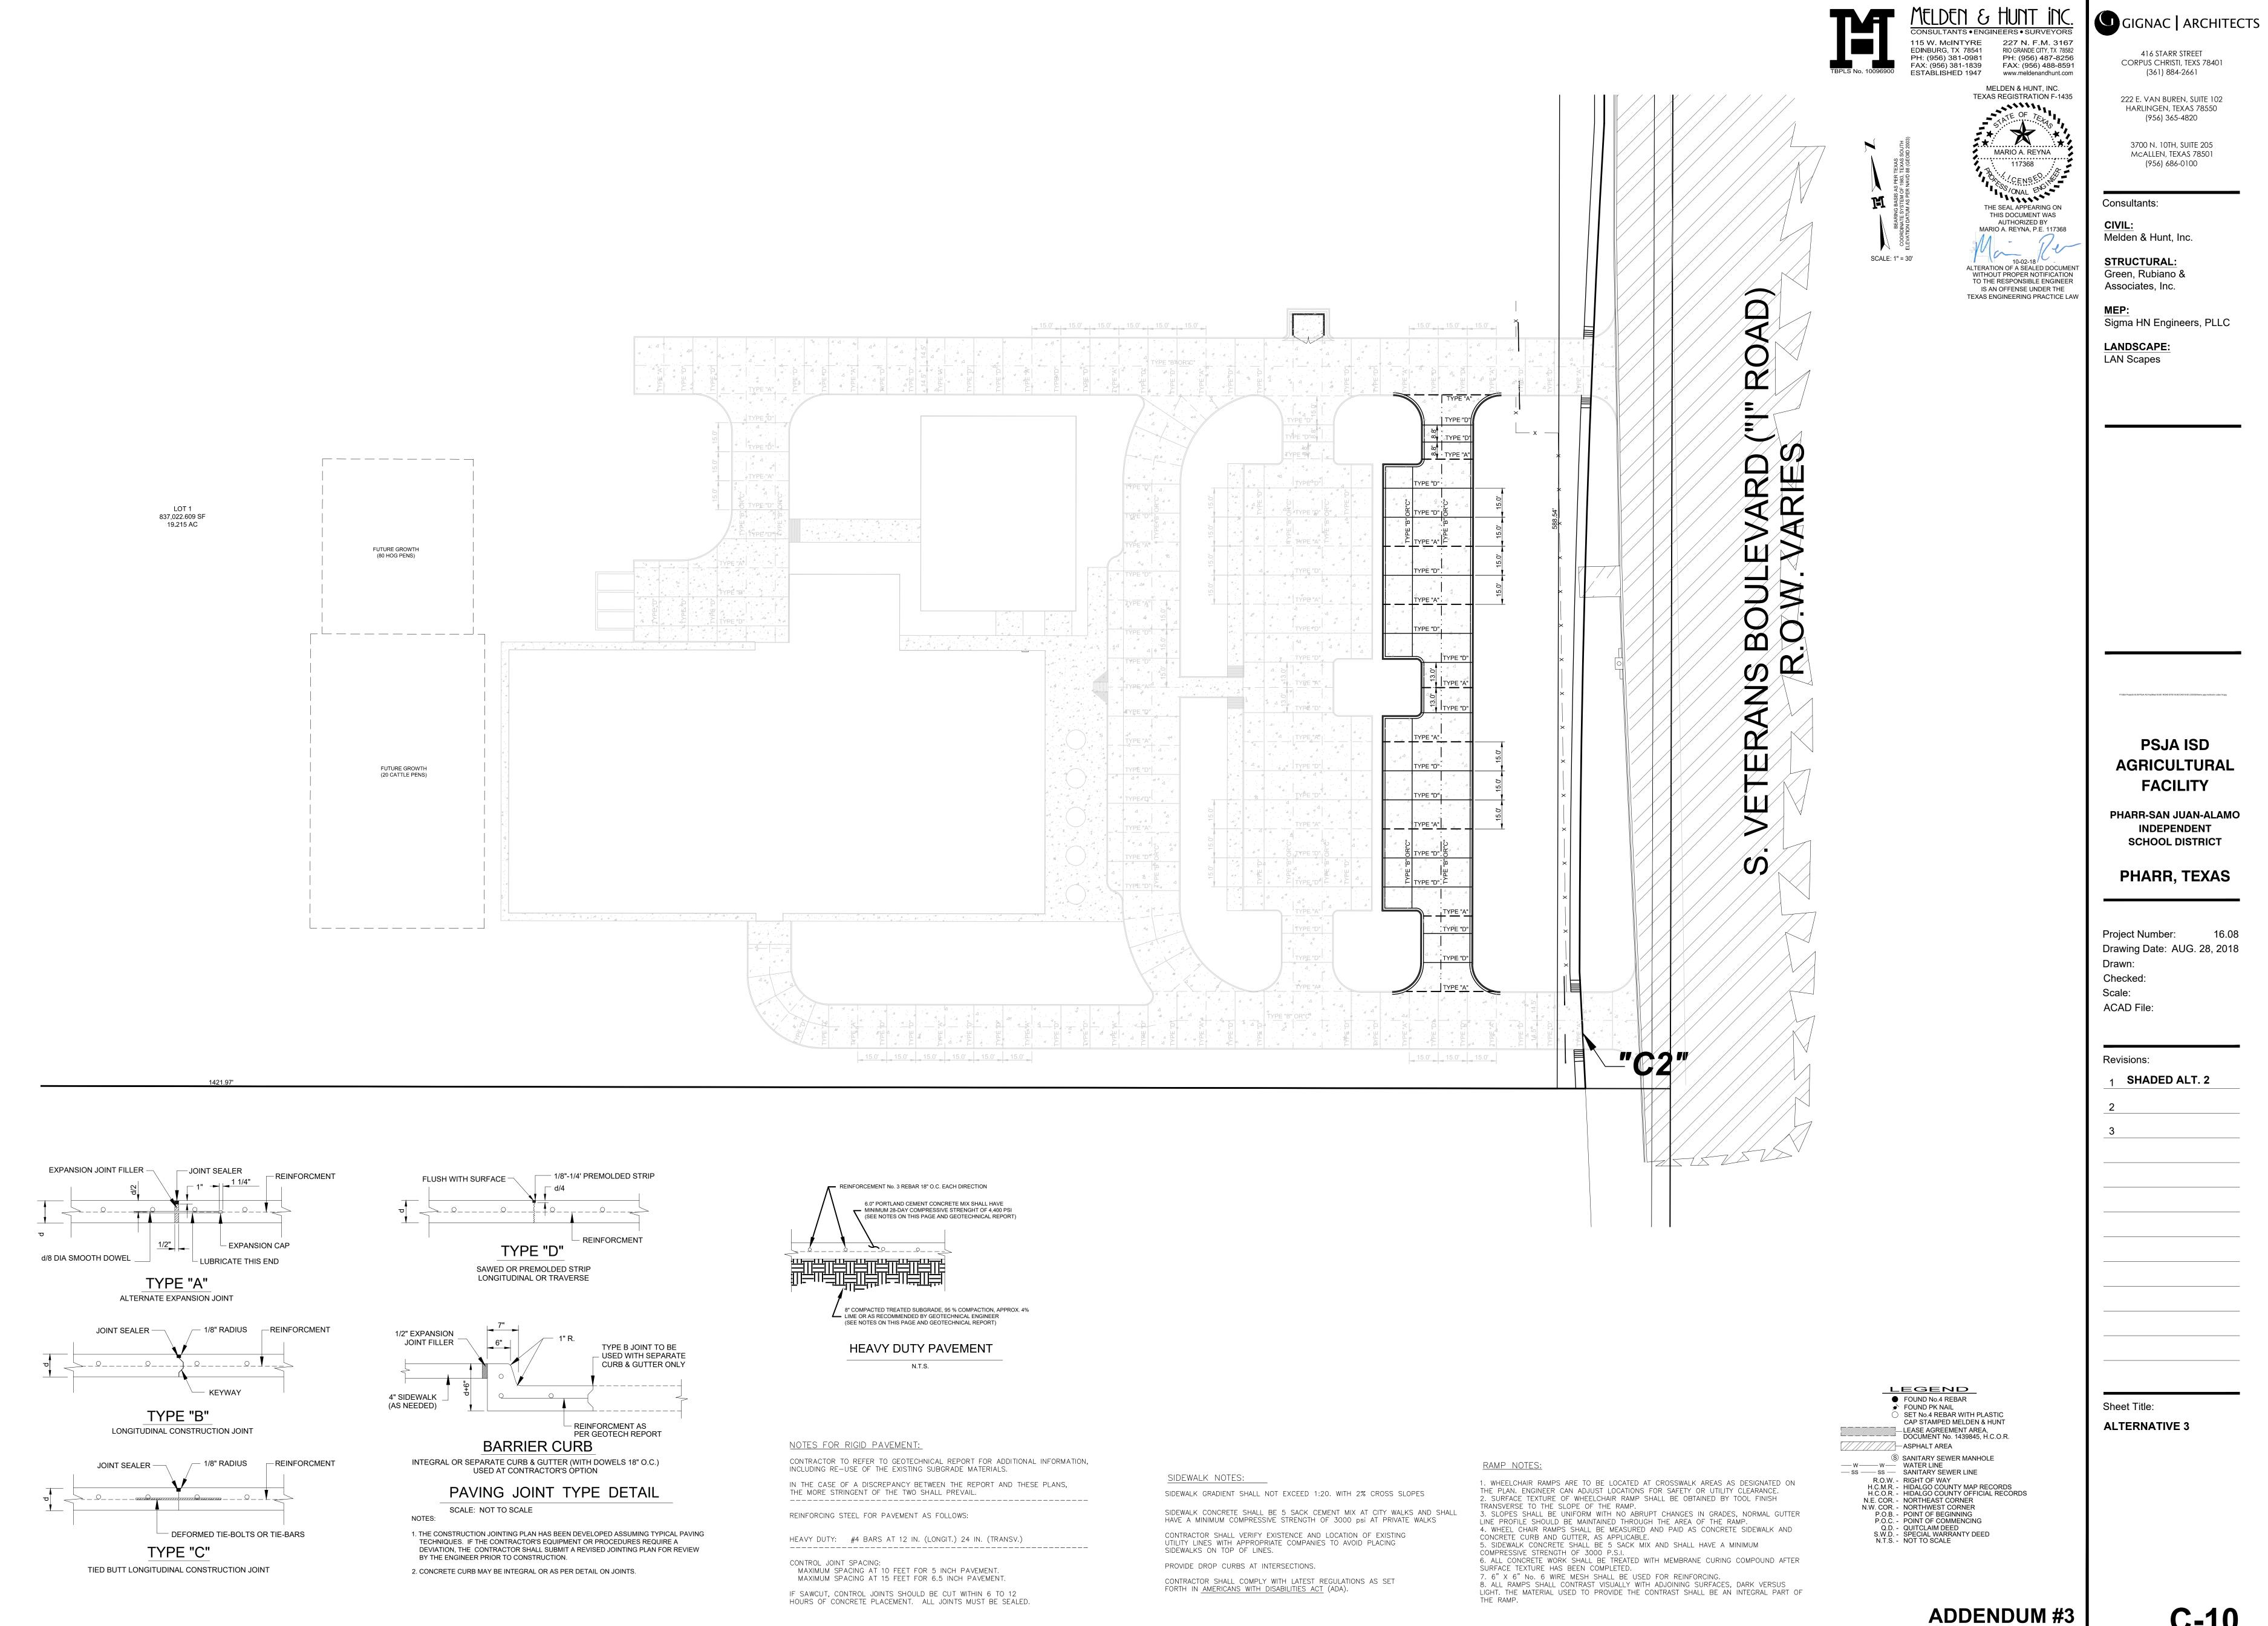

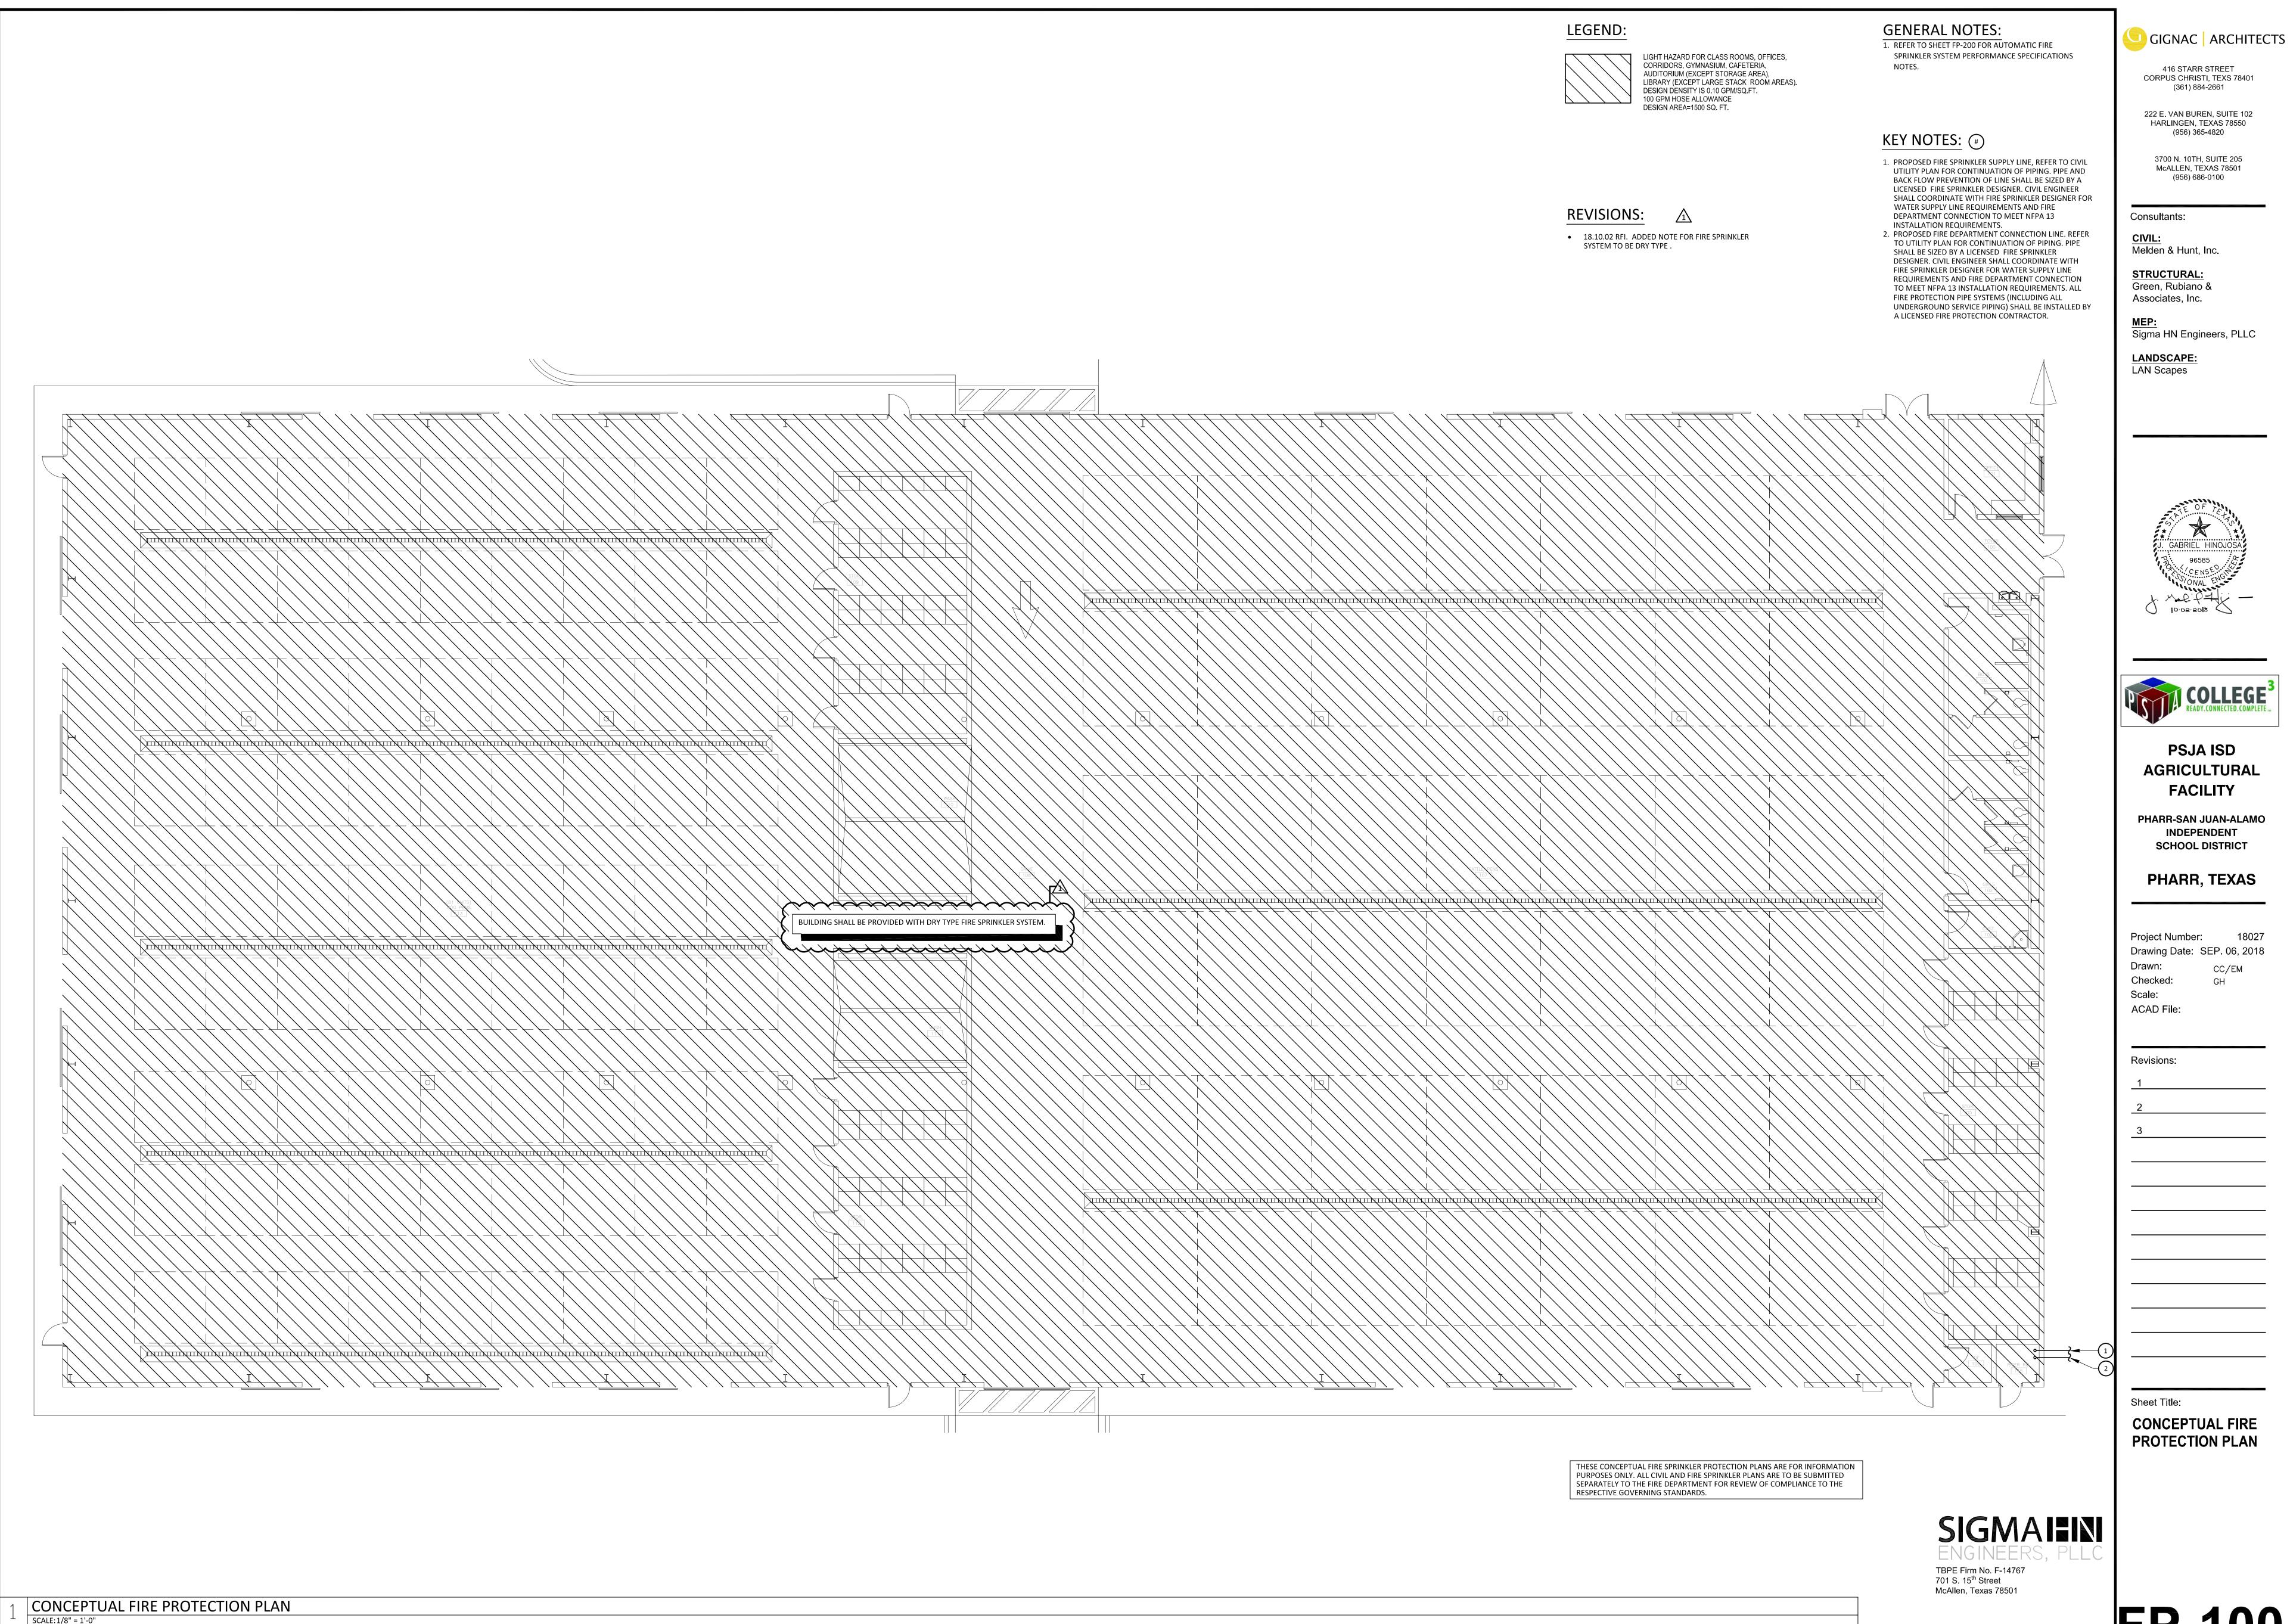


CORPUS CHRISTI, TEXS 78401



PHARR, TEXAS

FP-100

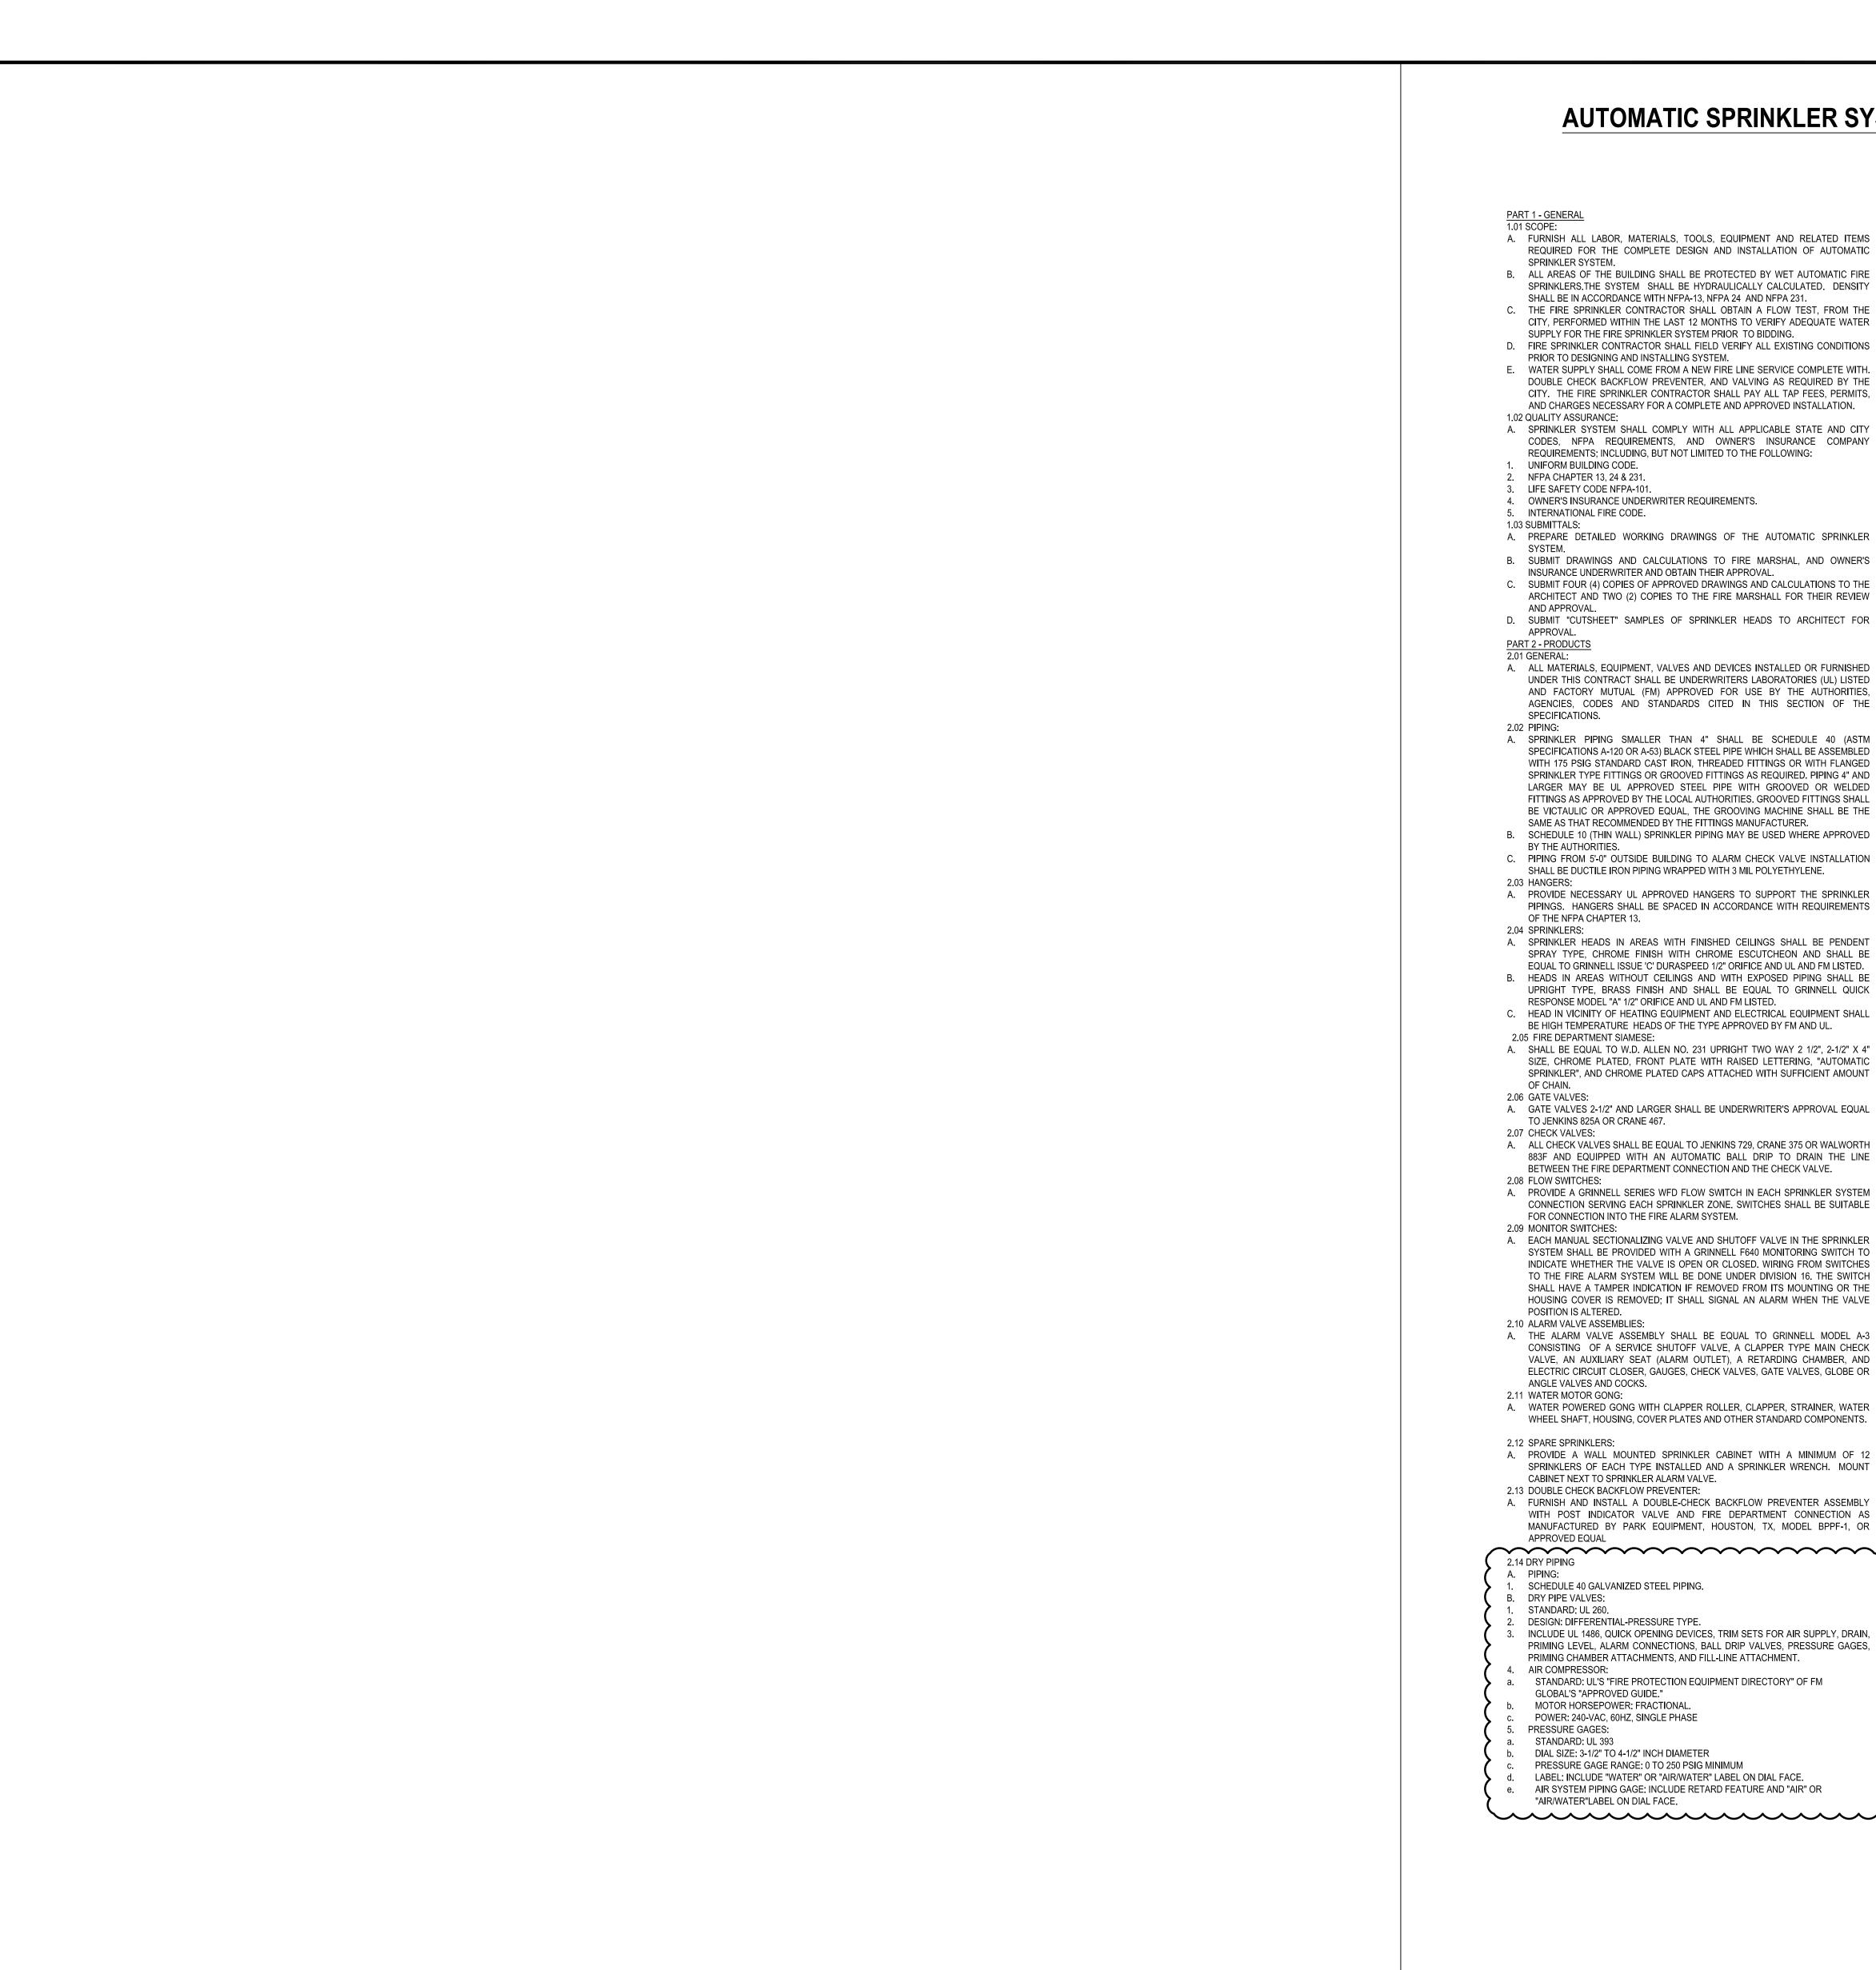

AUTOMATIC SPRINKLER SYSTEM PERFORMANCE SPECIFICATION NOTES:

- A. FURNISH ALL LABOR, MATERIALS, TOOLS, EQUIPMENT AND RELATED ITEMS REQUIRED FOR THE COMPLETE DESIGN AND INSTALLATION OF AUTOMATIC SPRINKLER SYSTEM. B. ALL AREAS OF THE BUILDING SHALL BE PROTECTED BY WET AUTOMATIC FIRE
- SPRINKLERS.THE SYSTEM SHALL BE HYDRAULICALLY CALCULATED. DENSITY SHALL BE IN ACCORDANCE WITH NFPA-13, NFPA 24 AND NFPA 231. THE FIRE SPRINKLER CONTRACTOR SHALL OBTAIN A FLOW TEST, FROM THE CITY, PERFORMED WITHIN THE LAST 12 MONTHS TO VERIFY ADEQUATE WATER SUPPLY FOR THE FIRE SPRINKLER SYSTEM PRIOR TO BIDDING.
- D. FIRE SPRINKLER CONTRACTOR SHALL FIELD VERIFY ALL EXISTING CONDITIONS PRIOR TO DESIGNING AND INSTALLING SYSTEM. WATER SUPPLY SHALL COME FROM A NEW FIRE LINE SERVICE COMPLETE WITH. DOUBLE CHECK BACKFLOW PREVENTER, AND VALVING AS REQUIRED BY THE CITY. THE FIRE SPRINKLER CONTRACTOR SHALL PAY ALL TAP FEES, PERMITS,
- 1.02 QUALITY ASSURANCE: A. SPRINKLER SYSTEM SHALL COMPLY WITH ALL APPLICABLE STATE AND CITY CODES, NFPA REQUIREMENTS, AND OWNER'S INSURANCE COMPANY REQUIREMENTS; INCLUDING, BUT NOT LIMITED TO THE FOLLOWING: UNIFORM BUILDING CODE.
- NFPA CHAPTER 13, 24 & 231. LIFE SAFETY CODE NFPA-101.
- 4. OWNER'S INSURANCE UNDERWRITER REQUIREMENTS. INTERNATIONAL FIRE CODE. 1.03 SUBMITTALS:
- A. PREPARE DETAILED WORKING DRAWINGS OF THE AUTOMATIC SPRINKLER B. SUBMIT DRAWINGS AND CALCULATIONS TO FIRE MARSHAL, AND OWNER'S
- INSURANCE UNDERWRITER AND OBTAIN THEIR APPROVAL. . SUBMIT FOUR (4) COPIES OF APPROVED DRAWINGS AND CALCULATIONS TO THE ARCHITECT AND TWO (2) COPIES TO THE FIRE MARSHALL FOR THEIR REVIEW
- AND APPROVAL D. SUBMIT "CUTSHEET" SAMPLES OF SPRINKLER HEADS TO ARCHITECT FOR APPROVAL. PART 2 - PRODUCTS
- 2.01 GENERAL: A. ALL MATERIALS, EQUIPMENT, VALVES AND DEVICES INSTALLED OR FURNISHED UNDER THIS CONTRACT SHALL BE UNDERWRITERS LABORATORIES (UL) LISTED AND FACTORY MUTUAL (FM) APPROVED FOR USE BY THE AUTHORITIES, AGENCIES, CODES AND STANDARDS CITED IN THIS SECTION OF THE SPECIFICATIONS.
- A. SPRINKLER PIPING SMALLER THAN 4" SHALL BE SCHEDULE 40 (ASTM SPECIFICATIONS A-120 OR A-53) BLACK STEEL PIPE WHICH SHALL BE ASSEMBLED WITH 175 PSIG STANDARD CAST IRON, THREADED FITTINGS OR WITH FLANGED SPRINKLER TYPE FITTINGS OR GROOVED FITTINGS AS REQUIRED. PIPING 4" AND LARGER MAY BE UL APPROVED STEEL PIPE WITH GROOVED OR WELDED FITTINGS AS APPROVED BY THE LOCAL AUTHORITIES. GROOVED FITTINGS SHALL BE VICTAULIC OR APPROVED EQUAL, THE GROOVING MACHINE SHALL BE THE SAME AS THAT RECOMMENDED BY THE FITTINGS MANUFACTURER.
- B. SCHEDULE 10 (THIN WALL) SPRINKLER PIPING MAY BE USED WHERE APPROVED BY THE AUTHORITIES. PIPING FROM 5'-0" OUTSIDE BUILDING TO ALARM CHECK VALVE INSTALLATION
- SHALL BE DUCTILE IRON PIPING WRAPPED WITH 3 MIL POLYETHYLENE. A. PROVIDE NECESSARY UL APPROVED HANGERS TO SUPPORT THE SPRINKLER
- PIPINGS. HANGERS SHALL BE SPACED IN ACCORDANCE WITH REQUIREMENTS OF THE NFPA CHAPTER 13. 2.04 SPRINKLERS: A. SPRINKLER HEADS IN AREAS WITH FINISHED CEILINGS SHALL BE PENDENT
- EQUAL TO GRINNELL ISSUE 'C' DURASPEED 1/2" ORIFICE AND UL AND FM LISTED. B. HEADS IN AREAS WITHOUT CEILINGS AND WITH EXPOSED PIPING SHALL BE UPRIGHT TYPE, BRASS FINISH AND SHALL BE EQUAL TO GRINNELL QUICK
- RESPONSE MODEL "A" 1/2" ORIFICE AND UL AND FM LISTED. C. HEAD IN VICINITY OF HEATING EQUIPMENT AND ELECTRICAL EQUIPMENT SHALL BE HIGH TEMPERATURE HEADS OF THE TYPE APPROVED BY FM AND UL. 2.05 FIRE DEPARTMENT SIAMESE:
- A. SHALL BE EQUAL TO W.D. ALLEN NO. 231 UPRIGHT TWO WAY 2 1/2", 2-1/2" X 4" SIZE, CHROME PLATED, FRONT PLATE WITH RAISED LETTERING, "AUTOMATIC SPRINKLER", AND CHROME PLATED CAPS ATTACHED WITH SUFFICIENT AMOUNT OF CHAIN. 2.06 GATE VALVES:
- A. GATE VALVES 2-1/2" AND LARGER SHALL BE UNDERWRITER'S APPROVAL EQUAL 3.06 INSTALLATION: TO JENKINS 825A OR CRANE 467. 2.07 CHECK VALVES:
- A. ALL CHECK VALVES SHALL BE EQUAL TO JENKINS 729. CRANE 375 OR WALWORTH 883F AND EQUIPPED WITH AN AUTOMATIC BALL DRIP TO DRAIN THE LINE BETWEEN THE FIRE DEPARTMENT CONNECTION AND THE CHECK VALVE. 2.08 FLOW SWITCHES:
- A. PROVIDE A GRINNELL SERIES WFD FLOW SWITCH IN EACH SPRINKLER SYSTEM CONNECTION SERVING EACH SPRINKLER ZONE. SWITCHES SHALL BE SUITABLE FOR CONNECTION INTO THE FIRE ALARM SYSTEM.
- 2.09 MONITOR SWITCHES: A. EACH MANUAL SECTIONALIZING VALVE AND SHUTOFF VALVE IN THE SPRINKLER SYSTEM SHALL BE PROVIDED WITH A GRINNELL F640 MONITORING SWITCH TO INDICATE WHETHER THE VALVE IS OPEN OR CLOSED. WIRING FROM SWITCHES TO THE FIRE ALARM SYSTEM WILL BE DONE UNDER DIVISION 16. THE SWITCH SHALL HAVE A TAMPER INDICATION IF REMOVED FROM ITS MOUNTING OR THE HOUSING COVER IS REMOVED; IT SHALL SIGNAL AN ALARM WHEN THE VALVE POSITION IS ALTERED. 2.10 ALARM VALVE ASSEMBLIES:
- A. THE ALARM VALVE ASSEMBLY SHALL BE EQUAL TO GRINNELL MODEL A-3 CONSISTING OF A SERVICE SHUTOFF VALVE, A CLAPPER TYPE MAIN CHECK VALVE, AN AUXILIARY SEAT (ALARM OUTLET), A RETARDING CHAMBER, AND ELECTRIC CIRCUIT CLOSER, GAUGES, CHECK VALVES, GATE VALVES, GLOBE OR ANGLE VALVES AND COCKS. 2.11 WATER MOTOR GONG:
- A. WATER POWERED GONG WITH CLAPPER ROLLER, CLAPPER, STRAINER, WATER WHEEL SHAFT, HOUSING, COVER PLATES AND OTHER STANDARD COMPONENTS.
- A. PROVIDE A WALL MOUNTED SPRINKLER CABINET WITH A MINIMUM OF 12 SPRINKLERS OF EACH TYPE INSTALLED AND A SPRINKLER WRENCH. MOUNT CABINET NEXT TO SPRINKLER ALARM VALVE. 2.13 DOUBLE CHECK BACKFLOW PREVENTER:
- A. FURNISH AND INSTALL A DOUBLE-CHECK BACKFLOW PREVENTER ASSEMBLY WITH POST INDICATOR VALVE AND FIRE DEPARTMENT CONNECTION AS MANUFACTURED BY PARK EQUIPMENT, HOUSTON, TX, MODEL BPPF-1, OR APPROVED EQUAL
- 2.14 DRY PIP**I**NG SCHEDULE 40 GALVANIZED STEEL PIPING.
- DRY PIPE VALVES: STANDARD: UL 260.
- DESIGN: DIFFERENTIAL-PRESSURE TYPE. INCLUDE UL 1486, QUICK OPENING DEVICES, TRIM SETS FOR AIR SUPPLY, DRAIN, PRIMING LEVEL. ALARM CONNECTIONS, BALL DRIP VALVES, PRESSURE GAGES. PRIMING CHAMBER ATTACHMENTS, AND FILL-LINE ATTACHMENT.
- a. STANDARD: UL'S "FIRE PROTECTION EQUIPMENT DIRECTORY" OF FM GLOBAL'S "APPROVED GUIDE."
- MOTOR HORSEPOWER: FRACTIONAL.
- POWER: 240-VAC, 60HZ, SINGLE PHASE
- PRESSURE GAGES: a. STANDARD: UL 393 DIAL SIZE: 3-1/2" TO 4-1/2" INCH DIAMETER PRESSURE GAGE RANGE: 0 TO 250 PSIG MINIMUM
 - LABEL: INCLUDE "WATER" OR "AIR/WATER" LABEL ON DIAL FACE. AIR SYSTEM PIPING GAGE: INCLUDE RETARD FEATURE AND "AIR" OR "AIR/WATER"LABEL ON DIAL FACE.

PART 3 - EXECUTION

- 3.01 SCOPE A. FURNISH AND INSTALL WITH ALL RELATED ITEMS, A COMPLETELY DESIGNED FIRE 1. CONTRACTOR SHALL INSTALL AN AUTOMATIC SPRINKLER SYSTEM FOR THE PROTECTION AUTOMATIC SPRINKLER SYSTEM.
- .02 CERTIFIED CONTRACTORS: A. FABRICATION AND INSTALLATION SHALL BE BY STATE LICENSED FIRE SPRINKLER COMPANY WITH EXPERIENCED, COMPETENT WORKMEN REGULARLY ENGAGED IN THE
- 3.03 COORDINATION: WORK SHALL INCLUDE, BUT NOT NECESSARILY BE LIMITED TO THE FOLLOWING: REQUIRED FITTINGS AND VALVES, ETC.
- OVERHEAD SPRINKLER SYSTEM FOR ENTIRE BUILDING, INCLUDING ALL REQUIRED ITEMS, EXCEPT UNDER EXTERIOR CANOPIES AND/OR OVERHANGS OVER WALKWAYS. 3.04 DESIGN:
- PIPING IN AREAS HAVING CEILINGS, OTHER THAN THE UNDERSIDE OF THE ROOF DECK, SHALL BE CONCEALED; PIPING IN STORAGE AND SERVICE AREAS MAY BE EXPOSED BUT KEPT AT A MINIMUM DISTANCE FROM CEILING. ALL PIPING SHALL BE NEW, CLEAN AND FREE FROM RUST
- B. THE SPRINKLER CONTRACTOR SHALL COORDINATE HIS WORK AND SERVICES WITH ALL OTHER CEILING MOUNTED, SUSPENDED OR OVERHEAD EQUIPMENT AND WITH STRUCTURAL SYSTEM. NO SPRINKLER LINES SHALL PASS THROUGH DUCTWORK. DEEP ESCUTCHEONS MAY BE USED IN ORDER TO LOCATE HEADS CLOSE TO LIGHTING FIXTURES. WHERE SPRINKLER HEADS OCCUR UNDER OVERHANGS, ESCUTCHEONS OF LESSER DEPTH MAY BE USED WHERE ACCEPTABLE TO THE CITY FIRE MARSHAL AND
- D. RISERS SHALL BE LOCATED WHERE INDICATED ON THE DRAWINGS AND BE EQUIPPED WITH VARIABLE PRESSURE ALARM VALVES. VALVES SHALL BE COMPLETE WITH ALL NECESSARY ITEMS, FITTINGS, IDENTIFICATION TAGS OR PLATES, AND ACCESSORIES INCLUDING ALARM VALVE AND WATER MOTOR GONG. DESIGN SHALL ALLOW FOR SUITABLE VENTING AND DRAINAGE OF SAME, ALL TO MEET WITH THE APPROVAL OF THE
- CITY FIRE MARSHAL AND THE OWNER'S INSURANCE UNDERWRITER AND NFPA 13. DESIGNS REQUIRING CUTTING OF STRUCTURAL MEMBERS FOR PASSAGE OF SPRINKLER PIPE AND HANGER SHALL BE AVOIDED. WHEN DESIGN, DUE TO ECONOMY, APPEARANCE AND SIMILAR ASPECTS, DENOTE THE NECESSITY OF CUTTING, IT SHALL BE HELD TO AN ABSOLUTE MINIMUM AND DONE ONLY WITH THE ARCHITECT'S WRITTEN APPROVAL.
- F. IN ADDITION TO MEETING THE NATIONAL FIRE PROTECTION ASSOCIATION NO. 13 REQUIREMENTS. THE FOLLOWING WILL APPLY TO THE SPRINKLER SYSTEM: 1. THE SPRINKLER SYSTEM SHALL BE ELECTRICALLY INTER-CONNECTED TO THE BUILDING
- THE SPRINKLER SYSTEM MAIN CONTROL VALVE SHALL BE ELECTRICALLY SUPERVISED SO THAT AT LEAST A LOCAL ALARM WILL SOUND WHEN THE VALVE IS CLOSED. 3.05 DRAWINGS:
- A. SHOP DRAWINGS CONSISTING OF THE FOLLOWING SHALL BE FURNISHED BY THE SPRINKLER SUB- CONTRACTOR: LAYOUT DRAWING OF COMPLETE OVERHEAD AUTOMATIC SPRINKLER SYSTEM INDICATING RELATIONSHIP OF ALL OTHER OVERHEAD ITEMS INCLUDING LIGHT FIXTURES, LOCATION OF RISERS, PIPING, ETC. SHALL BE AS INCONSPICUOUS AS POSSIBLE,
- REQUIREMENTS. SPRINKLER CONTRACTOR SHALL OBTAIN A COPY OF APPROVED CEILING GRID SYSTEM FROM CEILING SUB-CONTRACTOR AND SHALL WORK TO THIS LAYOUT WHEN PREPARING SHOP DRAWINGS AND INSTALLING WORK. CUTTING OF CEILING RUNNERS WILL NOT BE

PROVIDE A PLEASING OVERHEAD APPEARANCE, AND STILL FULFILL ALL FUNCTIONAL

- PILOT PLAN INDICATING LOCATION OF ALL UNDERGROUND CONNECTIONS, CONTROL VALVES, PIPING AND ALL RELATED ITEMS, AND ANY OTHER ITEMS OF DATA DEEMED NECESSARY BY THE CITY FIRE MARSHAL AND NFPA 13.
- 4. COMPLETE DETAILS AND SECTIONS AS REQUIRED TO CLEARLY DEFINE AND CLARIFY THE DESIGN INDICATED BY THE AFOREMENTIONED LAYOUT AND PILOT PLAN.
- 5. ALL SHOP DRAWINGS, PRIOR TO BEING SENT TO THE ARCHITECT, MUST BEAR BOTH THE CITY FIRE ENGINEERING DEPT. STAMP OF ACCEPTANCE AND THE OWNER'S INSURANCE UNDERWRITER STAMP OF ACCEPTANCE.
- B. FURNISH AND INSTALL, NEXT TO THE SPRINKLER RISER MAIN, A PRINTED SHEET, PROTECTED BY WOOD FRAMED GLASS COVER, GIVING BRIEF INSTRUCTIONS REGARDING CONTROL, EMERGENCY PROCEDURE AND OTHER DATA AS DEEMED NECESSARY BY THE CITY FIRE MARSHAL AND THE OWNER'S INSURANCE UNDERWRITER.
- C. UPON COMPLETION OF THE WORK, ACCURATELY MARK ONE COPY OF SHOP DRAWINGS SHOWING LOCATION OF ALL UNDERGROUND FIRE PREVENTION SYSTEM PIPING, VALVES, ETC., AS FINALLY INSTALLED. SHOW LOCATION OF UNDERGROUND PIPING AND VALVES BY DIMENSION. ALSO, GIVE FLOW LINE ELEVATIONS OF UNDERGROUND PIPING FROM STREET MAIN TO BUILDING. UPON COMPLETION OF THE JOB, FURNISH OWNER ONE (1) NEAT LEGIBLE COPY OF "AS BUILT" DRAWINGS.
- A. SLEEVES SHALL BE PROVIDED FOR PIPING PASSING THROUGH CONCRETE SLABS, CONCRETE OR MASONRY WALLS AND PARTITIONS, THROUGH FLOORS, CEILINGS, WALLS, OR PARTITIONS OF OTHER BUILDING MATERIALS. WATERTIGHT SLEEVES CAULKED WITH MASTIC OR LEAD SHALL BE PROVIDED FOR FLOOR SLABS AND WALLS ON OR BELOW GRADE. STANDARD PIPE OR GALVANIZED SHEET METAL SLEEVES SHALL BE INSTALLED IN ABOVE GRADE CONSTRUCTION AS MAY BE REQUIRED. THE SLEEVES SHALL BE OF SUFFICIENT DIAMETER TO PASS PIPE LINES WITH COUPLINGS OR WITH INSULATION OR ANNULAR AREA FOR CAULKING WHERE REQUIRED. ESCUTCHEONS SHALL BE APPROVED FLOOR AND CEILING PLATES MADE OF STEEL OR BRASS, PLAIN OR CHROMIUM PLATE FINISH AND SHALL BE INSTALLED AROUND ALL EXPOSED PIPING PASSING THROUGH A
- DIAMETER TO COVER THE SLEEVE OPENING AND SHALL BE PROVIDED WITH SPRINGS OR SET SCREWS TO INSURE THEM FITTING SNUGLY AROUND THE PIPE. ALL OPENINGS FOR PIPING SHOULD BE ANTICIPATED AND INDICATED ON THE APPROVED AND ACCEPTED SHOP DRAWINGS. ANY ADDITIONAL CUTTING OF OPENINGS MUST HAVE WRITTEN APPROVAL OF THE ARCHITECT. THIS CONTRACTOR WILL NOT USE AIR CONDITIONING DUCT SUPPORTS, AIR DEVICE

FINISHED FLOOR, WALL OR CEILING. THE PLATES SHALL BE OF SUFFICIENT OUTSIDE

MATERIAL, ACCESSORIES OR WORKMEN IN THE INSTALLATION OF THE SYSTEM. 3.07 GUARANTEE: A. THE ENTIRE INSTALLATION SHALL BE GUARANTEED FOR A PERIOD OF ONE YEAR FROM THE BUILDING ACCEPTANCE DATE.

OUTLETS OR SUPPORTS, PIPING OR SUPPORTS AS A MEANS OF SUPPORT OF ANY

- A. PRIOR TO CONNECTING TO THE OVERHEAD SPRINKLER PIPING, THE UNDERGROUND MAIN SHALL BE FLUSHED PER THE REQUIREMENTS OF THE NFPA. B. AFTER COMPLETION OF THE INSTALLATION, THE ENTIRE SYSTEM SHALL BE TESTED FOR ACCEPTANCE BY THE OWNER'S INSURANCE UNDERWRITER. 3.09 ACCEPTANCE:
- A. THE OWNER'S INSURANCE UNDERWRITER, AFTER SATISFYING THEMSELVES THAT THE INSTALLATION IS SATISFACTORY IN ALL RESPECTS, WILL ISSUE A LETTER OF FINAL ACCEPTANCE. LETTER SHALL BE ADDRESSED TO THE SPRINKLER COMPANY RESPONSIBLE FOR THE INSTALLATION, PREPARED IN TRIPLICATE AND GIVEN TO THE OWNER.
- B. AFTER COMPLETION OF ALL INSTALLATION, TESTS, ETC. AND PRIOR TO THE OPENING DATE THE SPRINKLER CONTRACTOR SHALL INSTRUCT THE OWNER IN THE OPERATION OF THE SPRINKLER SYSTEM. PROVIDE WRITTEN OPERATING INSTRUCTIONS AND MOUNT ON WALL IN A FRAME WITH GLASS FRONT. INCLUDE THE FOLLOWING SO THAT THE OWNER: WILL IMMEDIATELY RECOGNIZE THE MAIN VALVES ARE IN OPEN OR CLOSED POSITION.
- WILL KNOW HOW TO RESET THE ALARM SYSTEM. 4. WILL KNOW NOW TO MAKE COMPLETE WEEKLY INSPECTION.

WILL KNOW HOW TO DRAIN THE SYSTEM.

3.08 TESTS:

- 5. WILL KNOW HOW TO MAINTAIN SYSTEM IN ACCORDANCE WITH NFPA NO. 13.
- 3.10 PROTECTION DURING CONSTRUCTION: CONTRACTOR SHALL COMPLETE THE AUTOMATIC FIRE SPRINKLER SYSTEM A. READY FOR OPERATION, IN ALL RESPECTS, AS SOON AS POSSIBLE. WHEN THE SYSTEM IS COMPLETE AND READY FOR CONTINUOUS OPERATION, ACTIVATE THE SYSTEM FOR ITS INTENDED USE.

FIRE PROTECTION NOTES:

- UNDFRWRITER
- AREA SHALL BE "STANDARD ORIFICE TYPE" WITH 1/2 INCH DIAMETER NOMINAL ORIFICE SIZE, AND ALL SPRINKLERS LOCATED IN ORDINARY HAZARD GROUP 2 AREA SHALL BE "LARGE ORIFICE TYPE" WITH 17/32 INCH DIAMETER NOMINAL ORIFICE SIZE OR OTHER FM APPROVED AND UL LISTED SPRINKLERS AS
- APPROVED FOR THE PROPOSED APPLICATION. 3. CONTRACTOR SHALL INSTALL 10 POUND DRY CHEMICAL PORTABLE FIRE EXTINGUISHERS AND FIRE EXTINGUISHER CABINETS IN ACCORDANCE WITH NFPA 10. UNLESS OTHERWISE INDICATED BY THE CITY FIRE MARSHAL 4. CONTRACTOR SHALL INSTALL A FIRE ALARM SYSTEM REQUIRED FOR LIFE
- SAFETY IN ACCORDANCE WITH NFPA 70. NFPA 72. FACTORY MUTUAL ENGINEERING DESIGN CRITERIA. UNIFORM FIRE CODE. CITY APPLICABLE BUILDING CODE TEXAS ACCESSIBILITY STANDARDS, AND THE AMERICAN WITH DISABILITIES ACT REQUIREMENTS. CONTRACTOR SHALL SUBMIT FOR ENGINEER'S APPROVAL THE PROPOSED FIRE ALARM SYSTEM DESIGN AND
- ALARM SPECIALIST CONTRACTOR SHALL SUBMIT FOR ENGINEER'S REVIEW AND APPROVAL (BEFORE COMMENCEMENT OF WORK) A PROPOSED FIRE PROTECTION SPRINKLER SYSTEM PREPARED BY A LICENSED AND REGISTERED FIRE SPRINKLER SYSTEM PROFESSIONAL, THE SUBMITTAL SHALL INCLUDE, BUT NOT LIMITED TO THE
- FOLLOWING ELEMENTS: A. CONSTRUCTION DRAWINGS OF THE PROPOSED FIRE PROTECTION SYSTEM. INCLUDING: PIPE LAYOUT, ALARM VALVE, DRAIN VALVES, TEST VALVES, ETC... AND THE CENTERLINE ELEVATIONS OF THE BRANCH LINES, CROSS MAINS FEED
- METHODS AND MATERIALS OF CONSTRUCTION. (THE LICENSED PROFESSIONAL MUST BE KNOWLEDGEABLE WITH AND IN COMPLIANCE WITH ALL APPROPRIATE UL LISTINGS AND FACTORY MUTUAL REQUIREMENTS. SYSTEM DESIGN. MATERIAL, FABRICATION AND INSTALLATION SHALL MEET MOST CURRENT EDITION OF NFPA 13, UNIFORM FIRE CODE, AND FACTORY MUTUAL DESIGN AND INSTALLATION REQUIREMENTS AND SHALL BE SUBMITTED FOR APPROVAL BY CITY FIRE MARSHAL. STATE AND THE OWNER'S INSURANCE UNDERWRITER.) 6. 3" AND LARGER PIPING SHALL BE BLACK CARBON STEEL SCH-40 ASTM A53 WITH CUT GROOVED FITTINGS. 2 1/2" AND SMALLER PIPING SHALL BE BLACK CARBON STEEL SCH-40 ASTM A53 WITH THREADED CLASS 125 FITTINGS. ALL PIPE HANGERS SHALL BE BLACK CARBON STEEL. PIPING, FITTINGS AND PIPE HANGERS BE AS MANUFACTURED BY VICTAULIC, ITT GRINNEL, GRUVLOK OR APPROVED EQUAL. OR OTHER FM APPROVED AND UL LISTED PIPING AS

B. CONTRACTOR'S WORK PLAN AND SCHEDULING

APPROVED FOR THE PROPOSED APPLICATION.

THROUGH THE MAIN DRAIN

- ALL PIPE HANGER MATERIAL TO BE BLACK IRON 3. NEW PIPING TO BE HYDROSTATICALLY TESTED AT 210 PSI FOR A MINIMUM 2 HOURS, TEST TO BE WITNESSED BY OWNER'S REPRESENTATIVE.). CONTRACTOR SHALL INSTALL FIRE PROTECTION SYSTEM PLUMB AND STRAIGHT
- WITH BUILDING VERTICAL AND HORIZONTAL. 0. ALL VALVES SUCH AS INSPECTOR TEST VALVES TO BE LOCATED AT LEAST 6' FROM FLOOR. INSPECTOR TEST VALVES SHALL BE INSTALLED AS PER 13 REQUIREMENTS. 11. CONTRACTOR SHALL PLACE THE SPRINKLER HEADS IN THE CENTERS OF CEILING TILES. AND SHALL ALIGN SPRINKLER HEADS. 12. CONTRACTOR SHALL INSTALL HIGH END TEST STATIONS AND LOW END AS REQUIRED BY NFPA 13. CONTRACTOR SHALL INSTALL ALL SPRINKLER PIPES AND FITTINGS LEVEL, SO THAT THE SYSTEM CAN BE DRAINED, TRAPPED PIPING SHALL BE THROUGH

AUXILIARY DRAINS. THESE AUXILIARY DRAINS SHALL BE AT THE LOCATIONS

WHERE A CHANGE IN PIPING DIRECTION DRAINAGE OF THE SYSTEM PIPING

BUILDING IN ACCORDANCE WITH NFPA 13. "INSTALLATION OF SPRINKLER SYSTEM" AS DESIGNED BY A LICENSED FIRE PROTECTION SPECIALIST. AND AS APPROVED BY THE LOCAL FIRE MARSHALL AND THE OWNER'S INSURANCE ALL SPRINKLERS LOCATED IN LIGHT HAZARD AND ORDINARY HAZARD GROUP 1

Consultants:

Melden & Hunt, Inc. STRUCTURAL: Green, Rubiano & Associates, Inc.

PRODUCT INFORMATION, AS PREPARED BY A REGISTERED QUALIFIED FIRE Sigma HN Engineers, PLLC

> LANDSCAPE: LAN Scapes



GIGNAC ARCHITECTS

416 STARR STREET CORPUS CHRISTI, TEXS 78401 (361) 884-2661

222 E. VAN BUREN, SUITE 102 HARLINGEN, TEXAS 78550

(956) 365-4820

3700 N. 10TH, SUITE 205

McALLEN, TEXAS 78501

(956) 686-0100



PSJA ISD AGRICULTURAL FACILITY

PHARR-SAN JUAN-ALAMO INDEPENDENT **SCHOOL DISTRICT**

PHARR, TEXAS

Project Number: Drawing Date: SEP. 06, 2018 Drawn:

Checked:

ACAD File:

Scale:

devisions:	
1	
2	
3	

Sheet Title: FIRE SPRINKLER SPECS.

SIGMALIN TBPE Firm No. F-14767

• 18.10.02 RFI. ADDED NOTE FOR FIRE SPRINKLER SYSTEM

REVISIONS:

TO BE DRY TYPE.

701 S. 15th Street McAllen, Texas 78501



PLANT MATERIALS

I. TREES

- A. (9 count) Cedar Elm (Ulmus crasifolia)

 4" caliper b&b 12' tall by 4.5' wide
- B. <u>(4 count) Cedar Elm</u> 2 1/2" caliper 7.5' tall by 3' wide
- C. (9 count) Silver Date Palm (Phoenix sylvestris)

 10' clear trunk b&b
- D. <u>(12 count) Mexican Sycamore (Platanus mexicana)</u> 30 gal, 8-10' tall by 3-3.5' spread
- E. (3 count) Texas Persimmon (Diospyros. texanum) 3-3.5" caliper b&b 8-10' tall by 4-5' wide

II. SHRUBS

- A. (45 count) Dwarf Barbados Cherry (Malpighia punicifolia)
 3gal. 12-15" tall by 12-across
- B. <u>(14 count) Green Cloud Sage (leucophyllum frutescens) 'Green Cloud'</u> 3 gal. 24" tall 18" wide
- C. (30 count) Lantana Radiation (Lantana camara) 'Radiation' 1 gal. 10" tall 12" wide
- D. <u>(60 count) Muhlenbergia Grass</u> 1 gal.
- E. <u>(12 count) Bamboo Muhly (Muhlenbergia dumosa)</u> 12" tall, full pot
- F. (48 count) Gulf Muhly (Muhlenbergia capillaris) 8" tall, full pots



G. (320 count) - Liriope spicata.


4" container 3.5" tall, pot full

H. Hydromulch 30

Refer to Sheet L-1.0 in Construction Documents regarding coverage of Hydromulch.

Note: If project is ready for landscape by March or later 100% Common Bermuda seed should be used. Soil temperature needs to be 72 degrees or higher for Bermuda seed germination. If landscape work is to be completed in the cooler. Months (October - April) a ratio of 60% Bermuda seed and 40% Rye seed is to be incorporated into the Hydromulch mix.

END OF SECTION 32 93 00

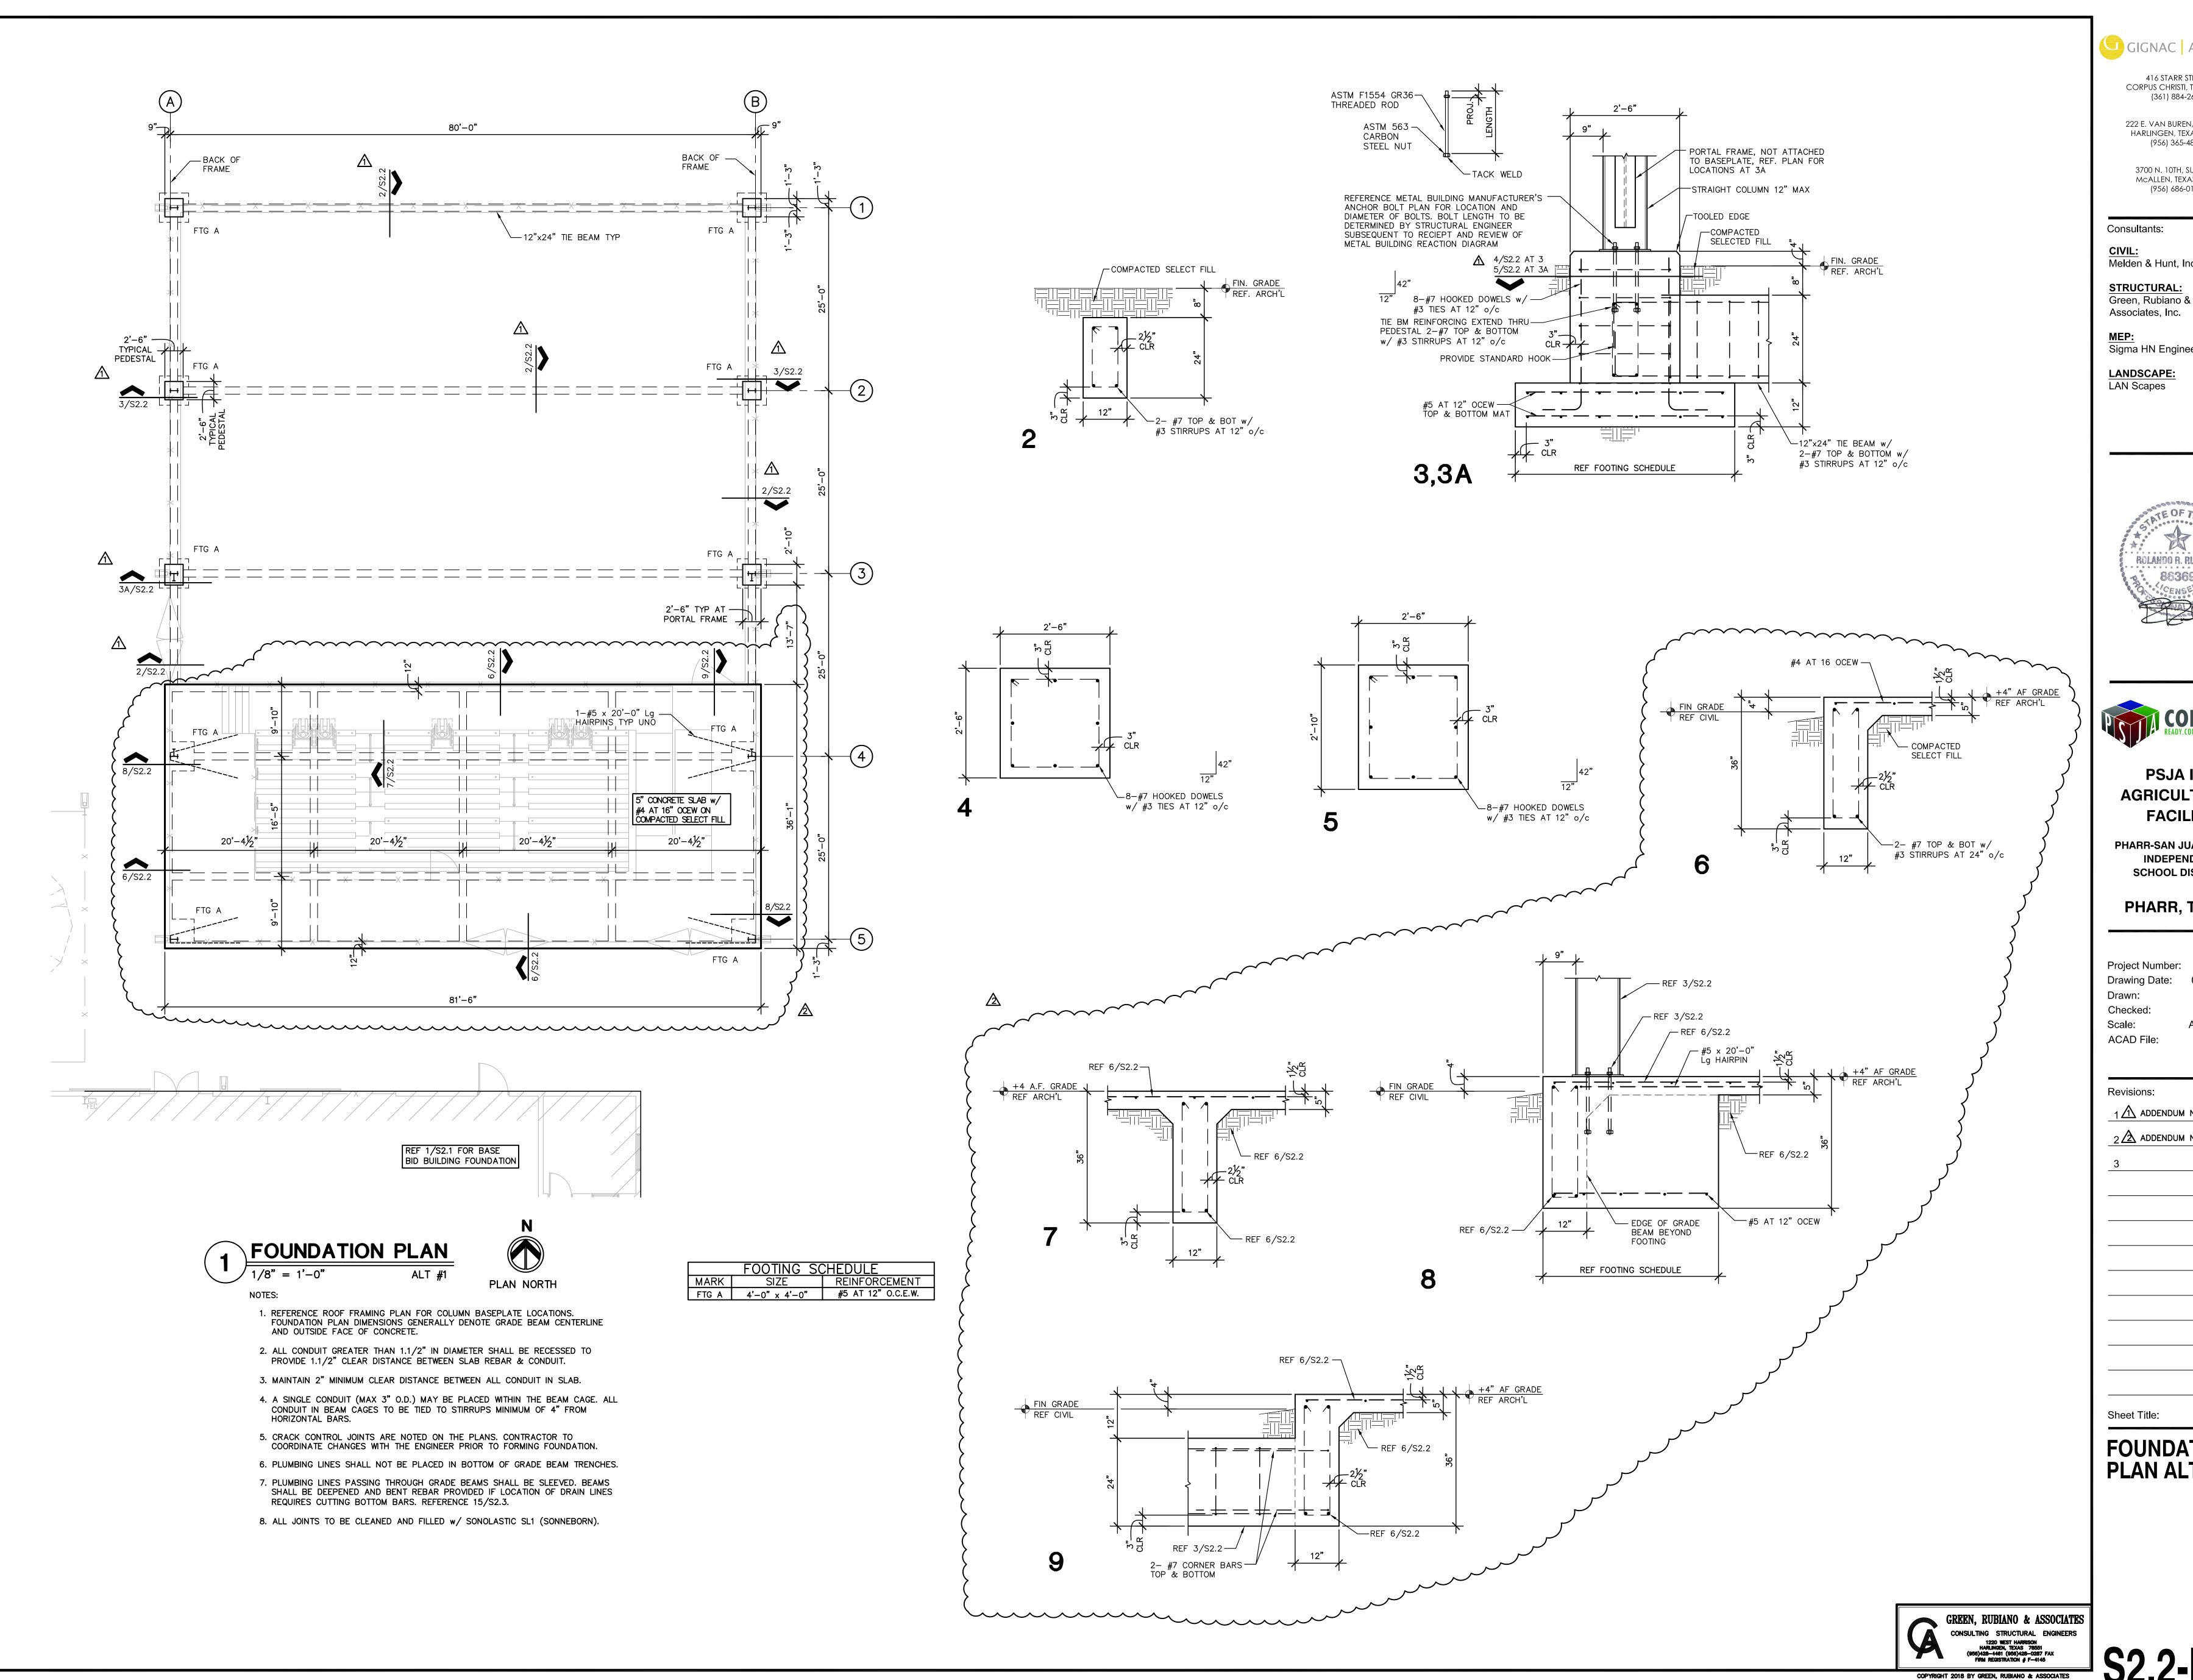

GIGNAC | ARCHITECTS

416 STARR STREET CORPUS CHRISTI, TEXS 78401

(361) 884-2661 222 E. VAN BUREN, SUITE 102 HARLINGEN, TEXAS 78550

(956) 365-4820

(956) 686-0100

3700 N. 10TH, SUITE 205 McALLEN, TEXAS 78501

Consultants:

Melden & Hunt, Inc.

STRUCTURAL:

Sigma HN Engineers, PLLC

LANDSCAPE:



PSJA ISD AGRICULTURAL FACILITY

PHARR-SAN JUAN-ALAMO INDEPENDENT SCHOOL DISTRICT

PHARR, TEXAS

Project Number: Drawing Date: 09-06-2018 Drawn: Checked:

AS SHOWN Scale: ACAD File:

Revisions: 1 ADDENDUM NO-1 09-21-18

2 ADDENDUM NO-3 10-02-18

Sheet Title:

FOUNDATION PLAN ALT #1