

Region One Education Service Center

1900 W. Schunior, Edinburg, TX 78541 • Ph (956) 984-6000 • Fax (956) 984-7655

ADDENDUM #4

Date:March 9, 2019Proposal Category:Region One Education Service Center Edinburg Additions
and RenovationsProposal Number:19-AGENCY-000065

The Region One Education Service Center (ESC) is accepting proposals for **Region One Education Service Center Edinburg Additions and Renovations.**

Region One ESC is amending the following information to the Region One Education Service Center Edinburg Additions and Renovations Competitive Sealed Proposals (CSP) 19-AGENCY-000065 through this addendum:

- Questions & Answers modified deadline Thursday, March 21, 2019, 2 PM CST
- Revision to Proposal Due Date Thursday, March 28, 2019, 2 PM CST
- Clarification Items Items C-1 C-11
- **Specification Items** Items S-1 S-3
- Plan Items Items P-1 P-43

Questions/clarifications regarding this RFP must be submitted in writing through the "Bid Q&A" option located within the solicitation available through the eBuyOne website: <u>https://esc1.buyspeed.com/bso/</u> no later than 2 PM, Thursday, March 21, 2019. Questions/clarifications regarding this RFP will not be answered by phone. It is the Respondent's responsibility to view the webpage regularly, or prior to submitting a response, to view any response(s) to question(s) issued for this solicitation.

Region One ESC Purchasing Department will receive proposals for **Region One Education Service Center Edinburg Additions and Renovations CSP 19-AGENCY-000065** electronically through the eBuyOne website: https://esc1.buyspeed.com/bso/ no later than 2 PM local time, Thursday, March 28, 2019. Late submittals will not be considered. A paper/hardcopy is highly discouraged; however, Region One ESC will be accepting sealed RFPs on USB or hardcopy through the mail or hand delivery to Region One ESC, 1900 W. Schunior St., Edinburg, Texas 78541 by the date and time specified, and it must be **clearly labeled** Attention: Marc David Garcia, Purchasing Specialist – Region One Education Service Center Edinburg Additions and Renovations CSP 19-AGENCY-000065. All sealed proposals received after the specified deadline shall be retained sealed and unopened until after a final award is made. After a final award is made, the Region One ESC may open the "late" or "disqualified" proposal and retain it as a public record which will be subject to the Texas Public Information Act A signed,

submitted proposal constitutes an offer to perform work and/or deliver the services specified in the procurement solicitation.

The ESC has a critical need for the work to begin on **May 1, 2019** and be substantially complete by **August 31, 2020 OR as fixed in the Notice to Proceed.**

The awarding of the proposal will take place at a public Region One ESC board meeting. The Board of Region One ESC reserves the right to accept, reject any and/or all proposals, waive minor technicalities, to award contracts for individual items as they may appear advantageous to the Region One ESC and its members or to award the proposal to the most responsible offeror which best serves the interest of the Region One ESC.

Sincerely,

Dr. Cornelie Tonzalez

Dr. Cornelio Gonzalez Executive Director

Comi Jon


Connie Lopez, CPA Deputy Director for Business Operations and Finance Support

ADDENDUM #4 must be acknowledged in eBuyOne for Region One Education Service Center Edinburg Additions and Renovations CSP 19-AGENCY-000065.

ADDENDUM NUMBER FOUR (4) TO THE PLANS AND SPECIFICATIONS FOR:

REGION ONE EDUCATION SERVICE CENTER EDINBURG ADDITIONS AND RENOVATIONS 1900 W. Schunior, Edinburg, Texas 78541 Project No. 17.14

GIGNAC & ASSOCIATES 416 STARR STREET CORPUS CHRISTI, TEXAS 78401 (361) 884-2661

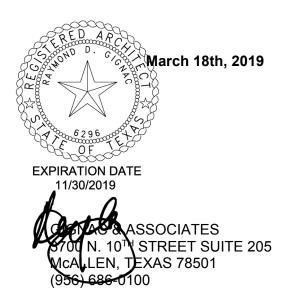

This addendum is generally separated into sections for convenience; however, all contractors, subcontractors, materialmen, and other parties shall be responsible for reading the entire addendum. The failure to list an item or items in all affected sections of this addendum does not relieve any party affected from performing as per instructions, provided that the information is set forth any time, any place in this addendum. These documents shall be attached to and become a part of the contract documents for this project.

CLARIFICATION ITEMS :

Item C-1

Missing details for water, sanitary sewer, storm drainage and concrete paving. Information required to bid properly.

Details have been issued on Addendum #4.

Item C-2

Provide size of folding partitions for all applicable rooms.

Detail at intersection by manufacturer. Size of folding partitions is being provided in Addendum #4.

Item C-3

- **Substitution Request for Moderco**
- Substitution Request has been denied.

Item C-4

Sheet CS1, CS2 & CS3 has Not to Scale. How are we to scale what the square foot for each type of CPT or any floor finishes?

 Unless we issue dimensioned plans for floor finishes and/or provide a scale on the drawing, for the CPT in the Training Rooms, Sheet CS2 has a note 4 for border carpet that states "5' Borders Typ." may be sufficient to bid from when cross-referencing the dimensions on the floor plans.

Item C-5

Will Alternate #1 (Training Rooms "F & G" floors be the same pattern as Training Rooms "A-E" as shown on sheet CS2?

- Yes. Same Pattern, with 5'-0" wide borders around the entire perimeter of both rooms, except just 5'-0" border along the folding panel partition.

Item C-6

- CS2 shows Reception D112 different from sheet A-102. Which way will it be going?
- Reference the Enlarged Floor Plan 1 on Sheet A-700 issued in Addendum #4 for the updated configuration of the room.

Item C-7

Will Rooms D123 Food Prep, D114 MDF, D125 Riser Room, D126 Mech., D127 Elect. & D128 floors be concrete sealed, concrete stained, etc.? CS1 shows to have Base only.

- A room finish schedule has been issued with Addendum #4.

Item C-8

Alternate # 2 Existing Training Rooms into Offices Space. What kind of floor & base will be installed ? Example LVT, CPT #3, CPT #4, CPT #5, Base #1 or Base #2.

- A room finish schedule has been issued with Addendum #4.

Item C-9

Clarification on insulated standing seam metal roof-. Detail 5/A-314 identifies an insulated standing seam metal roof, however, in reviewing Wall Section 4/A307, Building Sections 1/A-301, 2/A-301, 3/A-301, 8/A-302, and Roof Plan Drawing Sheet A-400 do not identify this standing seam metal roof. Please provide clarification as to the extent of the insulated standing seam metal roof.

- Clarification has been provided on Addendum #4

Item C-10

Section 095113 acoustical panel ceilings and sheet A-409 ceiling plan. Plan sheet A-409 shows all training facilities to be 4x4 tile but spec shows 2x2 clarify which size to use. Armstrong doesn't make in 4x4

- The design intent is Armstrong Metalworks 3D as specified.

Item C-11

What type of screens are being requested? What type of projectors are being used? Is there a brand of speakers that is preferred? Will every room be controlled individually or all on one platform? Dimensions for requested rack? What is the goal for audio/video?

- All information is provided in the construction documents.

SPECIFICATION ITEMS :

Item S-1

Section 09 50 00 - Acoustical Metal Ceiling Blades.

Section 09 50 00 – Acoustical Metal Ceiling Blades attached here with shall become part of the Contract Documents.

Item S-2

Section 09 50 00 - OC-Acoustical Metal Ceiling Open Cell.

Section 09 50 00 – OC-Acoustical Metal Ceiling Open Cell attached here with shall become part of the Contract Documents.

Item S-3

Section 09 51 33 – Acoustical Metal Ceilings – 3D

Section 09 51 33 – Acoustical Metal Ceilings 3D attached here with shall become part of the Contract Documents.

<u> Plan ITEMS :</u>

Item P-1

Sheet C-3.0 – Water and Sewer Layout

Sheet C-3.0 – Water and Sewer Layout included within this addendum shall be added to become part of the construction documents and substitute C-3.0 – Water and Sewer Layout.

Item P-2

Sheet C-4.0 – Dimensional Control Site Plan

Sheet C-4.0 – Dimensional Control Site Plan included within this addendum shall be added to become part of the construction documents and substitute C-4.0 – Dimensional Control Site Plan.

Item P-3

Sheet C-5.0 – Paving and Drainage Plan

Sheet C-5.0 – Paving and Drainage Plan included within this addendum shall be added to become part of the construction documents and substitute C-5.0 – Paving and Drainage Plan.

Item P-4

Sheet C-6.0 – Erosion and Sediment Control Plan

Sheet C-6.0 – Erosion and Sediment Control Plan included within this addendum shall be added to become part of the construction documents and substitute C-6.0 – Erosion and Sediment Control Plan.

Item P-5

Sheet C-9.0 – Jointing Plan

Sheet C-9.0 – Jointing Plan included within this addendum shall be added to become part of the construction documents and C-9.0 – Jointing Plan.

Item P-6

Sheet A-105-R1– Miscellaneous Details

Sheet A-105-R1– Miscellaneous Details_included within this addendum shall be added to become part of the construction documents and substitute A-105 Miscellaneous Details.

Item P-7

Sheet C-10.0 – Water Details

Sheet C-10.0 – Water Details included within this addendum shall be added to become part of the construction documents.

Sheet C-11.0 – Sewer Details

Sheet C-11.0 – Sewer Details included within this addendum shall be added to become part of the construction documents.

Item P-9

Sheet C-12.0 – Drainage Details

Sheet C-12.0 – Drainage Details included within this addendum shall be added to become part of the construction documents.

Item P-10

<u>Sheet C-14.0 – Street Details</u>

Sheet C-14.0 – Street Details included within this addendum shall be added to become part of the construction documents.

Item P-11

Sheet C-15.0 – Street Details

Sheet C-15.0 – Street Details included within this addendum shall be added to become part of the construction documents.

Item P-12

Sheet AS-101-R1– Architectural Site Plan

Sheet AS-101-R1– Architectural Site Plan included within this addendum shall be added to become part of the construction documents and substitute AS-101 Architectural Site Plan.

Item P-13

<u>Sheet A-103-R1– Floor Plan – Training Facility W/ Alternate #1</u> Sheet A-103-R1– Floor Plan – Training Facility W/ Alternate #1 included within this addendum shall be added to become part of the construction documents and substitute A-103 – Floor Plan – Training Facility W/ Alternate #1.

Item P-14

Sheet A-106-R1– Enlarged Floor Plans

Sheet A-106-R1– Enlarged Floor Plans included within this addendum shall be added to become part of the construction documents and substitute A-106– Enlarged Floor Plans.

Item P-15

Sheet A-107-R1– Enlarged Floor Plans

Sheet A-107-R1– Enlarged Floor Plans included within this addendum shall be added to become part of the construction documents and substitute A-107– Enlarged Floor Plans.

Item P-16

Sheet A-202– Exterior Elevations

Detail 1 shown on sheet A-202 Exterior Elevations included within this addendum shall be added to Sheet A-202 Exterior Elevations and replace 1/A-202.

Sheet A-400-R1– Composite Roof Plan

Sheet A-400-R1– Composite Roof Plan included within this addendum shall be added to become part of the construction documents and substitute A-400– Composite Roof Plan.

Item P-18

Sheet A-403– Roof Details

Detail 5 shown on sheet A-403 Roof Details included within this addendum shall be added to Sheet A-403-Roof Details and become part of the construction documents.

Item P-19

Sheet A-407-R1– Composite Reflected Ceiling Plan

Sheet A-407-R1– Composite Reflected Ceiling Plan included within this addendum shall be added to become part of the construction documents and substitute A-407– Composite Reflected Ceiling Plan.

Item P-20

<u>Sheet A-408-R1– Reflected Ceiling Plan – Training Facility</u> Sheet A-408-R1– Reflected Ceiling Plan – Training Facility included within this addendum shall be added to become part of the construction documents and substitute A-408– Reflected Ceiling Plan – Training Facility.

Item P-21

<u>Sheet A-409-R1– Reflected Ceiling Plan – Training Facility w/ Alternate #1</u> Sheet A-409-R1– Reflected Ceiling Plan – Training Facility w/ Alternate #1 included within this addendum shall be added to become part of the construction documents and substitute A-409– Reflected Ceiling Plan – Training Facility w/ Alternate #1.

Item P-22

Sheet A–700 Millwork Details

Sheet A–700 Millwork Details included within this addendum shall be added to become part of the construction documents.

Item P-23

Sheet A–701 Finish Schedules

Sheet A–701 Finish Schedules included within this addendum shall be added to become part of the construction documents.

Item P-24

Sheet AV-110– Reflected Ceiling Plan – Training Facility

Sheet AV-110– Reflected Ceiling Plan – Training Facility included within this addendum shall be added to become part of the construction documents and AV-110– Reflected Ceiling Plan – Training Facility. Removed extra CAM locations so that location quantities match the functional details.

Item P-25

Sheet AV-111- Reflected Ceiling Plan - Training Facility W/ Alternate #1

 Sheet AV-111– Reflected Ceiling Plan – Training Facility W/ Alternate #1 included within this addendum shall be added to become part of the construction documents and AV-111– Reflected Ceiling Plan – Training Facility W/ Alternate #1. Removed extra CAM locations so that location quantities match the functional details.

Sheet TL-110 Reflected Ceiling Plan - Training Facility

Sheet TL–110 Reflected Ceiling Plan – Training Facility included within this addendum shall be added to become part of the construction documents and TL–110 Reflected Ceiling Plan – Training Facility. Added lighting control zones 1C, 2A, and 5A.

Item P-27

Sheet MEP-101 MEP Roof Plan

Sheet MEP–101 MEP Roof Plan included within this addendum shall be added to become part of the construction documents and substitute MEP–101 MEP Roof Plan.

Item P-28

Sheet P-101 Plumbing Plan Training Facility

Sheet P–101 Plumbing Plan Training Facility included within this addendum shall be added to become part of the construction documents and substitute P–101 Plumbing Plan Training Facility.

Item P-29

<u>Sheet P–102 Plumbing Plan Training Facility w/ Alternate #1</u> Sheet P–102 Plumbing Plan Training Facility w/ Alternate #1 included within this addendum shall be added to become part of the construction documents and substitute P–102 Plumbing Plan Training Facility w/ Alternate #1.

Item P-30

<u>Sheet P–103 Plumbing Plan – Offices, Café, Alternate and Mezzanine</u> Sheet P–103 Plumbing Plan – Offices, Café, Alternate and Mezzanine included within this addendum shall be added to become part of the construction documents and substitute P–103 Plumbing Plan – Offices, Café, Alternate and Mezzanine.

Item P-31

Sheet P-303 Plumbing Risers

Sheet P–303 Plumbing Risers included within this addendum shall be added to become part of the construction documents and substitute P–303 Plumbing Risers.

Item P-32

Sheet M-100 Mechanical Plan

Sheet M–100 Mechanical Plan included within this addendum shall be added to become part of the construction documents and substitute M–100 Mechanical Plan.

Item P-33

Sheet M-300 Mechanical Schedules

Sheet M–300 Mechanical Schedules included within this addendum shall be added to become part of the construction documents and substitute M–300 Mechanical Schedules.

Item P-34

Sheet ES-100 Electrical Site Plan, Enlargement, Alternate #4 and Details

Sheet ES–100 Electrical Site Plan, Enlargement, Alternate #4 and Details included within this addendum shall be added to become part of the construction documents and substitute ES–100 Electrical Site Plan, Enlargement, Alternate #4 and Details.

Item P-35

Sheet E-100 Electrical Lighting Plan

Sheet E–100 Electrical Lighting Plan included within this addendum shall be added to become part of the construction documents and substitute E–100 Electrical Lighting Plan.

Item P-36

Sheet E-101 Electrical Lighting Plan

Sheet E–101 Electrical Lighting Plan included within this addendum shall be added to become part of the construction documents and substitute E–101 Electrical Lighting Plan.

Item P-37

<u>Sheet E–102 Electrical Lighting Plan – Alternates & Mezzanine</u> Sheet E–102 Electrical Lighting Plan – Alternates & Mezzanine included within this addendum shall be added to become part of the construction documents and substitute E–102 Electrical Lighting Plan – Alternates & Mezzanine.

Item P-38

Sheet E-103 Electrical Power Plan

Sheet E–103 Electrical Power Plan included within this addendum shall be added to become part of the construction documents and substitute E–103 Electrical Power Plan.

Item P-39

Sheet E-104 Electrical Power Plan

Sheet E–104 Electrical Power Plan included within this addendum shall be added to become part of the construction documents and substitute E–104 Electrical Power Plan.

Item P-40

Sheet E-105 Electrical Power Plan - Alternates & Mezzanine

Sheet E–105 Electrical Power Plan – Alternates & Mezzanine included within this addendum shall be added to become part of the construction documents and substitute E–105 Electrical Power Plan – Alternates & Mezzanine.

Item P-41

Sheet E–200 Electrical Panel Schedules

Sheet E–200 Electrical Panel Schedules included within this addendum shall be added to become part of the construction documents and substitute E–200 Electrical Panel Schedules.

Item P-42

Sheet E–201 Electrical Panel Schedules

Sheet E–201 Electrical Panel Schedules included within this addendum shall be added to become part of the construction documents and substitute E–201 Electrical Panel Schedules.

<u>Sheet E–300 Light Fixture Schedule & Electrical General Legend</u> Sheet E–300 Light Fixture Schedule & Electrical General Legend_included within this addendum shall be added to become part of the construction documents and substitute E–300 Light Fixture Schedule & Electrical General Legend.



SECTION 09 50 00 - ACOUSTICAL METAL CEILINGS - BLADES

PART 1 - GENERAL

1.1 RELATED DOCUMENTS

A. Section Includes

Drawings and general conditions of Contract, including General and Supplementary Conditions and Divisions-1 Specification sections apply to work of this section

1.2 SUMMARY

A. Section Includes

- 1. Acoustical metal ceiling panels
- 2. Exposed grid suspension system
- 3. Wire hangers, fasteners, main runners, cross tees, and wall angle moldings
- 4. Perimeter Trim
- B. Related Sections:
 - 1. Section 09 51 33.13 Acoustical Snap In Metal Pan Ceiling
 - 2. Section 09 20 00 (09250) Plaster and Gypsum Board
 - 3. Section 09 51 13 (09500) Acoustical Fabric-Faced Panel Ceilings
 - 4. Section 09 53 00 (09500) Acoustical Ceiling Suspension Assemblies
 - 5. Section 01 81 13 Sustainable Design Requirements
 - 6. Section 01 81 19 Indoor Air Quality Requirements
 - 7. Section 09 54 00 Specialty Ceilings
 - 8. Divisions 23 HVAC Air Distribution
 - 9. Division 26 Electrical

1.3 REFERENCES

A. American Society for Testing and Materials (ASTM):

1. ASTM A 1008 Standard Specification for Steel, Sheet, Cold Rolled, Carbon, Structural, High-Strength Low-Alloy and High-Strength Low-Alloy with Improved Formability

2. ASTM A 641 Standard Specification for Zinc-Coated (Galvanized) Carbon Steel Wire

3. ASTM A 653 Standard Specification for Steel Sheet, Zinc-Coated (Galvanized) by the Hot-Dip Process

4. ASTM C 423 Sound Absorption and Sound Absorption Coefficients by the Reverberation Room Method

5. ASTM C 635 Standard Specification for Metal Suspension Systems for Acoustical Tile and Lay-in Panel Ceilings

6. ASTM C 636 Recommended Practice for Installation of Metal Ceiling Suspension Systems for Acoustical Tile and Lay-in Panels

7. ASTM D 3273 Standard Test Method for Resistance to Growth of Mold on the Surface of Interior Coatings in an Environmental Chamber

8. ASTM E 84 Standard Test Method for Surface Burning Characteristics of Building Materials

9. ASTM E 580 Installation of Metal Suspension Systems in Areas Requiring Moderate Seismic Restraint

10. ASTM E 1111 Standard Test Method for Measuring the Interzone Attenuation of Ceilings Systems

11. ASTM E 1414 Standard Test Method for Airborne Sound Attenuation Between Rooms Sharing a Common Ceiling Plenum

12. ASTM E 1264 Classification for Acoustical Ceiling Products

- B. International Building Code
- C. ASHRAE Standard 62 1 2004 Ventilation for Acceptable Indoor Air Quality
- D. NFPA 70 National Electrical Code



E. ASCE 7 American Society of Civil Engineers, Minimum Design Loads for Buildings and Other Structures

F. International Code Council-Evaluation Services - AC 156 Acceptance Criteria for Seismic Qualification Testing of Non-structural Components

G. International Code Council-Evaluation Services Report - Seismic Engineer Report
 1. ESR 1308 - Armstrong Suspension Systems

H. International Association of Plumbing and Mechanical Officials - Seismic Engineer Report 1. 0244 - Armstrong Single Span Suspension System

I. California Department of Public Health CDPH/EHLB Emission Standard Method Version 1.1 2010 J. LEED - Leadership in Energy and Environmental Design is a set of rating systems for the design, construction, operation, and maintenance of green buildings

K. International Well Building Standard

L. Mindful Materials

M. Living Building Challenge

N. U.S. Department of Agriculture BioPreferred program (USDA BioPreferred).

1.4 SYSTEM DESCRIPTION

Discontinuous/Open Plenum

1.5 SUBMITTALS

A. Product Data: Submit manufacturer's technical data for each type of acoustical ceiling unit and suspension system required.

B. Samples: Minimum 6 inch x 6 inch samples of specified acoustical panel; 8 inch long samples of exposed wall molding and suspension system, including main runner and 4 foot cross tees.C. Shop Drawings: Layout and details of acoustical ceilings show locations of items that are to be coordinated with, or supported by the ceilings.

D. Certifications: Manufacturer's certifications that products comply with specified requirements, including laboratory reports showing compliance with specified tests and standards. For acoustical performance, each carton of material must carry an approved independent laboratory classification of NRC, CAC, and AC.

E. If the material supplied by the acoustical subcontractor does not have an Underwriter's Laboratory classification of acoustical performance on every carton, subcontractor shall be required to send material from every production run appearing on the job to an independent or NVLAP approved laboratory for testing, at the architect's or owner's discretion. All products not conforming to manufacturer's current published values must be removed, disposed of and replaced with complying product at the expense of the Contractor performing the work.

1.6 SUSTAINABLE MATERIALS

Transparency: Manufacturers will be given preference when they provide documentation to support sustainable requirements for the following: Material ingredient transparency, Removal of Red List Ingredients per LBCV3, Life Cycle impact information, Low-Emitting Materials, and Clean Air performance.

1. Health Product Declaration. The end use product has a published, complete Health Product Declaration with disclosure at a minimum of 1000ppm of known hazards in compliance with the Health Product Declaration open Standard.

2. Declare Label. The end use product has a published Declare label by the International Living Future Institute with disclosure of 100 ppm with a designation of Red List Free or Compliant (less than 1% proprietary ingredients).

3. Low Emitting products with VOC emissions data. Preference will also be given to manufacturers that can provide emissions data showing their products meet CDHP Standard Method v1.1 (Section 01350).

4. Life cycle analysis. Products that have communicated lifecycle data through Environmental Product Declarations (EPDs) will be preferred.



5. End of Life Programs/Recycling: Where applicable, manufacturers that provide the option for recycling of their products into new products at end-of-life through take-back programs will be preferred.

6. Products meeting LEED V4 requirements including:

Storage & Collection of Recyclables

Construction and Demolition Waste Management Planning

Building Life-Cycle Impact Reduction

Building Product Disclosure and Optimization Environmental Product Declarations

Building Product Disclosure and Optimization Sourcing of Raw Materials

Building Product Disclosure and Optimization Material Ingredients

Construction and Demolition Waste Management

1.7 QUALITY ASSURANCE

A. Single-Source Responsibility: Provide acoustical panel units and grid components by a single manufacturer.

B. Fire Performance Characteristics: Identify acoustical ceiling components with appropriate markings of applicable testing and inspecting organization.

a. Surface Burning Characteristics: As follows, tested per ASTM E 84 and complying with ASTM E 1264 Classification.

C. Acoustic Panels: As with other architectural features located at the ceiling, may obstruct or skew the planned fire sprinkler water distribution pattern through possibly delay or accelerate the activation of the sprinkler or fire detection systems by channeling heat from a fire either toward or away from the device. Designers and installers are advised to consult a fire protection engineer, NFPA 13, or their local codes for guidance where automatic fire detection and suppression systems are present. D. Coordination of Work: Coordinate acoustical ceiling work with installers of related work including, but not limited to building insulation, gypsum board, light fixtures, mechanical systems, electrical systems, and sprinklers.

1.8 DELIVERY, STORAGE AND HANDLING

A. Deliver acoustical ceiling units to project site in original, unopened packages and store them in a fully enclosed space where they will be protected against damage from moisture, direct sunlight, surface contamination, and other causes.

B. Before installing acoustical ceiling units, permit them to reach room temperature and a stabilized moisture content.

C. Handle acoustical ceiling units carefully to avoid chipping edges or damaged units in any way.

1.9 PROJECT CONDITIONS

A. Space Enclosure:

Standard Ceilings: Do not install interior ceilings until space is enclosed and weatherproof; wet work in place is completed and nominally dry; work above ceilings is complete; and ambient conditions of temperature and humidity are continuously maintained at values near those intended for final occupancy. Building areas to receive ceilings shall be free of construction dust and debris. HumiGuard Plus Ceilings: Building areas to receive ceilings shall be free of construction dust and debris. Products with HumiGuard Plus performance and hot dipped galvanized steel, aluminum or stainless steel suspension systems can be installed up to 120°F (49°C) and in spaces before the building is enclosed, where HVAC systems are cycled or not operating. Cannot be used in exterior applications where standing water is present or where moisture will come in direct contact with the ceiling.

HumiGuard Max Ceilings: Building areas to receive ceilings shall be free of construction dust and debris. Ceilings with HumiGuard Max performance can be installed in conditions up to 120°F (49°C) and maximum humidity exposure including outdoor applications, and other standing water applications, so long as they are installed with either SS Prelude Plus, AL Prelude Plus, or Prelude Plus Fire Guard XL suspension systems. Products with Humiguard Max performance can be installed in exterior applications, where standing water is present, or where moisture will



come in direct contact with the ceiling. Only Ceramaguard with AL Prelude Plus suspension system can be installed over swimming pools.

1.10 WARRANTY

A. Acoustical Panel: Submit a written warranty executed by the manufacturer, agreeing to repair or replace panels that fail within the warranty period. Failures include, but are not limited to the following:

- 1. Acoustical Panels: Sagging and warping
- 2. Grid System: Rusting and manufacturer's defects
- B. Warranty Period:
 - 1. Acoustical Metal panels: One (1) year from date of substantial completion
 - 2. Grid: Ten (10) years from date of substantial completion

C. The Warranty shall not deprive the Owner of other rights the Owner may have under other provisions of the Contract Documents and will be in addition to and run concurrent with other warranties made by the Contractor under the requirements of the Contract Documents.

1.11 MAINTENANCE

A. Extra Materials: Deliver extra materials to Owner. Furnish extra materials described below that match products installed. Packaged with protective covering for storage and identified with appropriate labels.

1. Acoustical Metal Ceiling Units: Furnish quality of full-size units equal to 5.0 percent of amount installed.

2. Exposed Suspension System Components: Furnish quantity of each exposed suspension component equal to 2.0 percent of amount installed.

PART 2 - PRODUCTS

2.1 MANUFACTURERS

A. Metal Ceiling Panels:

1. Armstrong World Industries, Inc. – Basis of Design

- B. Suspension Systems:
 - 1. Armstrong World Industries, Inc. Basis of Design
- C. Aluminum Custom Trims:
 - 1. Armstrong World Industries, Inc. Basis of Design

2.2.1 ACOUSTICAL CEILING UNITS

A. Acoustical Panels Type AMP

1. Acoustical Panels Type AMP-1:

- a. Surface Texture: Smooth
- b. Composition: Metal
- c. Color: Whitelume
- d. Size: 4 in x 96 in
- e. Edge Profile: 15/16 in for interface with 360 Painted Grid grid.
- f. Perforation Option: Unperforated
- g. Flame Spread: ASTM E 1264; Class A (HPVA).
- h. Light Reflectance (LR) White Panel: ASTM E 1477; 0.77.
- i. Dimensional Stability: Standard
- j. Material Ingredient Transparency: Health Product Declaration (HPD)
- k. Basis of Design: MetalWorks Blades Classics, 7202M1
- 2. Metal Panel Accessories:
 - 1. 7204 MetalWorks Blades Attachment Clip
 - 2. 7205 MetalWorks Blades Alignment Device
 - 3. 8158 MW Blades Classics Field Cut End Cap
- 2.3.1 METAL SUSPENSION SYSTEMS

A. Components:

Main beams and cross tees, base metal and end detail, fabricated from commercial quality hot dipped galvanized steel complying with ASTM A 653. Main beams and cross tees are double-web



steel construction with type exposed flange design. Exposed surfaces chemically cleansed, capping prefinished galvanized steel in baked polyester paint. Main beams and cross tees shall have rotary stitching.

a. Structural Classification: ASTM C 635 Heavy Duty duty

b. Color: Tech Blackand match the actual color of the selected ceiling tile, unless noted otherwise.

c. Basis of Design: 360 Painted Grid as manufactured by Armstrong World Industries B. Attachment Devices:

Size for five times design load indicated in ASTM C 635, Table 1, Direct Hung unless otherwise indicated.

C. Wire for Hangers and Ties:

ASTM A 641, Class 1 zinc coating, soft annealed, with a yield stress load of at least times three design load, but not less than 12 gauge.

D. Edge Moldings and Trim:

E. Accessories:

PART 3 - EXECUTION

3.1 EXAMINATION

A. Do not proceed with installation until all wet work such as concrete, terrazzo, plastering and painting has been completed and thoroughly dried out, unless expressly permitted by manufacturer's printed recommendations. (Exception: HumiGuard Max Ceilings)

3.2 PREPARATION

A. Measure each ceiling area and establish layout of acoustical units to balance border widths at opposite edges of each ceiling. Avoid use of less than half width units at borders, and comply with reflected ceiling plans. Coordinate panel layout with mechanical and electrical fixtures.

B. Coordination: Furnish layouts for preset inserts, clips, and other ceiling anchors whose installation is specified in other sections.

1. Furnish concrete inserts and similar devices to other trades for installation well in advance of time needed for coordination of other work.

3.3 INSTALLATION

A. Follow manufacturer installation instructions

B. Install suspension system and panels in accordance with the manufacturer's instructions, and in compliance with ASTM C 636 and with the authorities having jurisdiction.

C. Install wall moldings at intersection of suspended ceiling and vertical surfaces. Miter corners where wall moldings intersect or install corner caps.

D. For reveal edge panels: Cut and reveal or rabbet edges of ceiling panels at border areas and vertical surfaces.

E. Install acoustical panels in coordination with suspended system, with edges resting on flanges of main runner and cross tees. Cut and fit panels neatly against abutting surfaces. Support edges by wall moldings.

F. Install acoustical panels in coordination with suspended system, with edges resting on flanges of main runner and cross tees. Cut and fit panels neatly against abutting surfaces. Support edges by wall moldings.

3.4 ADJUSTING AND CLEANING

A. Replace damaged and broken panels.

B. Clean exposed surfaces of ceilings panels, including trim, edge moldings, and suspension members. Comply with manufacturer's instructions for cleaning and touch up of minor finish damage. Remove and replace work that cannot be successfully cleaned and repaired to permanently eliminate evidence of damage.

END OF SECTION 09 50 00



END OF SECTION 09 50 00



SECTION 09 50 00 OC - ACOUSTICAL METAL CEILINGS - OPEN CELL

PART 1 - GENERAL

1.1 RELATED DOCUMENTS

A. Section Includes

Drawings and general conditions of Contract, including General and Supplementary Conditions and Divisions-1 Specification sections apply to work of this section

1.2 SUMMARY

- A. Section Includes
 - 1. Acoustical metal ceiling panels
 - 2. Exposed grid suspension system
 - 3. Wire hangers, fasteners, main runners, cross tees, and wall angle moldings
 - 4. Perimeter Trim
- B. Related Sections:
 - 1. Section 09 51 33.13 Acoustical Snap In Metal Pan Ceiling
 - 2. Section 09 20 00 (09250) Plaster and Gypsum Board
 - 3. Section 09 51 13 (09500) Acoustical Fabric-Faced Panel Ceilings
 - 4. Section 09 53 00 (09500) Acoustical Ceiling Suspension Assemblies
 - 5. Section 01 81 13 Sustainable Design Requirements
 - 6. Section 01 81 19 Indoor Air Quality Requirements
 - 7. Section 09 54 00 Specialty Ceilings
 - 8. Divisions 23 HVAC Air Distribution
 - 9. Division 26 Electrical

1.3 REFERENCES

A. American Society for Testing and Materials (ASTM):

1. ASTM A 1008 Standard Specification for Steel, Sheet, Cold Rolled, Carbon, Structural, High-Strength Low-Alloy and High-Strength Low-Alloy with Improved Formability

2. ASTM A 641 Standard Specification for Zinc-Coated (Galvanized) Carbon Steel Wire

3. ASTM A 653 Standard Specification for Steel Sheet, Zinc-Coated (Galvanized) by the Hot-Dip Process

4. ASTM C 423 Sound Absorption and Sound Absorption Coefficients by the Reverberation Room Method

5. ASTM C 635 Standard Specification for Metal Suspension Systems for Acoustical Tile and Lay-in Panel Ceilings

6. ASTM C 636 Recommended Practice for Installation of Metal Ceiling Suspension Systems for Acoustical Tile and Lay-in Panels

7. ASTM D 3273 Standard Test Method for Resistance to Growth of Mold on the Surface of Interior Coatings in an Environmental Chamber

8. ASTM E 84 Standard Test Method for Surface Burning Characteristics of Building Materials



9. ASTM E 580 Installation of Metal Suspension Systems in Areas Requiring Moderate Seismic Restraint

10. ASTM E 1111 Standard Test Method for Measuring the Interzone Attenuation of Ceilings Systems

11. ASTM E 1414 Standard Test Method for Airborne Sound Attenuation Between Rooms Sharing a Common Ceiling Plenum

12. ASTM E 1264 Classification for Acoustical Ceiling Products

B. International Building Code

C. ASHRAE Standard 62 1 2004 Ventilation for Acceptable Indoor Air Quality

D. NFPA 70 National Electrical Code

E. ASCE 7 American Society of Civil Engineers, Minimum Design Loads for Buildings and Other Structures

F. International Code Council-Evaluation Services - AC 156 Acceptance Criteria for Seismic Qualification Testing of Non-structural Components

G. International Code Council-Evaluation Services Report - Seismic Engineer Report 1. ESR 1308 - Armstrong Suspension Systems

H. International Association of Plumbing and Mechanical Officials - Seismic Engineer Report 1. 0244 - Armstrong Single Span Suspension System

I. California Department of Public Health CDPH/EHLB Emission Standard Method Version 1.1 2010 J. LEED - Leadership in Energy and Environmental Design is a set of rating systems for the design, construction, operation, and maintenance of green buildings

K. International Well Building Standard

L. Mindful Materials

M. Living Building Challenge

N. U.S. Department of Agriculture BioPreferred program (USDA BioPreferred).

1.4 SYSTEM DESCRIPTION

Discontinuous/Open Plenum

1.5 SUBMITTALS

A. Product Data: Submit manufacturer's technical data for each type of acoustical ceiling unit and suspension system required.

B. Samples: Minimum 6 inch x 6 inch samples of specified acoustical panel; 8 inch long samples of exposed wall molding and suspension system, including main runner and 4 foot cross tees.C. Shop Drawings: Layout and details of acoustical ceilings show locations of items that are to be coordinated with, or supported by the ceilings.

D. Certifications: Manufacturer's certifications that products comply with specified requirements, including laboratory reports showing compliance with specified tests and standards. For acoustical performance, each carton of material must carry an approved independent laboratory classification of NRC, CAC, and AC.

E. If the material supplied by the acoustical subcontractor does not have an Underwriter's Laboratory classification of acoustical performance on every carton, subcontractor shall be required to send material from every production run appearing on the job to an independent or NVLAP approved laboratory for testing, at the architect's or owner's discretion. All products not conforming to manufacturer's current published values must be removed, disposed of and replaced with complying product at the expense of the Contractor performing the work.

1.6 QUALITY ASSURANCE

A. Single-Source Responsibility: Provide acoustical panel units and grid components by a single manufacturer.

B. Fire Performance Characteristics: Identify acoustical ceiling components with appropriate markings of applicable testing and inspecting organization.

a. Surface Burning Characteristics: As follows, tested per ASTM E 84 and complying with ASTM E 1264 Classification.



C. Acoustic Panels: As with other architectural features located at the ceiling, may obstruct or skew the planned fire sprinkler water distribution pattern through possibly delay or accelerate the activation of the sprinkler or fire detection systems by channeling heat from a fire either toward or away from the device. Designers and installers are advised to consult a fire protection en gineer, NFPA 13, or their local codes for guidance where automatic fire detection and suppression systems are present. D. Coordination of Work: Coordinate acoustical ceiling work with installers of related work including, but not limited to building insulation, gypsum board, light fixtures, mechanical systems, electrical systems, and sprinklers.

1.7 DELIVERY, STORAGE AND HANDLING

A. Deliver acoustical ceiling units to project site in original, unopened packages and store them in a fully enclosed space where they will be protected against damage from moisture, direct sunlight, surface contamination, and other causes.

B. Before installing acoustical ceiling units, permit them to reach room temperature and a stabilized moisture content.

C. Handle acoustical ceiling units carefully to avoid chipping edges or damaged units in any way. 1.8 PROJECT CONDITIONS

A. Space Enclosure:

Standard Ceilings: Do not install interior ceilings until space is enclosed and weatherproof; wet work in place is completed and nominally dry; work above ceilings is complete; and ambient conditions of temperature and humidity are continuously maintained at values near those intended for final occupancy. Building areas to receive ceilings shall be free of construction dust and debris.

HumiGuard Plus Ceilings: Building areas to receive ceilings shall be free of construction dust and debris. Products with HumiGuard Plus performance and hot dipped galvanized steel, aluminum or stainless steel suspension systems can be installed up to 120°F (49°C) and in spaces before the building is enclosed, where HVAC systems are cycled or not operating. Cannot be used in exterior applications where standing water is present or where moisture will come in direct contact with the ceiling.

HumiGuard Max Ceilings: Building areas to receive ceilings shall be free of construction dust and debris. Ceilings with HumiGuard Max performance can be installed in conditions up to 120°F (49°C) and maximum humidity exposure including outdoor applications, and other standing water applications, so long as they are installed with either SS Prelude Plus, AL Prelude Plus, or Prelude Plus Fire Guard XL suspension systems. Products with Humiguard Max performance can be installed in exterior applications, where standing water is present, or where moisture will come in direct contact with the ceiling. Only Ceramaguard with AL Prelude Plus suspension system can be installed over swimming pools.

1.9 WARRANTY

A. Acoustical Panel: Submit a written warranty executed by the manufacturer, agreeing to repair or replace panels that fail within the warranty period. Failures include, but are not limited to the following:

- 1. Acoustical Panels: Sagging and warping
- 2. Grid System: Rusting and manufacturer's defects
- B. Warranty Period:
 - 1. Acoustical Metal panels: One (1) year from date of substantial completion
 - 2. Grid: Ten (10) years from date of substantial completion

C. The Warranty shall not deprive the Owner of other rights the Owner may have under other provisions of the Contract Documents and will be in addition to and run concurrent with other warranties made by the Contractor under the requirements of the Contract Documents.

1.10 MAINTENANCE

A. Extra Materials: Deliver extra materials to Owner. Furnish extra materials described below that match products installed. Packaged with protective covering for storage and identified with appropriate labels.



1. Acoustical Metal Ceiling Units: Furnish quality of full-size units equal to 5.0 percent of amount installed.

2. Exposed Suspension System Components: Furnish quantity of each exposed suspension component equal to 2.0 percent of amount installed.

PART 2 - PRODUCTS

2.1 MANUFACTURERS

A. Metal Ceiling Panels:

1. Armstrong World Industries, Inc. – Basis of Design

- B. Suspension Systems:
 - 1. Armstrong World Industries, Inc. Basis of Design
- C. Aluminum Custom Trims:
 - 1. Armstrong World Industries, Inc. Basis of Design
- 2.2 ACOUSTICAL CEILING UNITS
 - A. Acoustical Panels Type AMP
 - 1. Acoustical Panels Type AMP-1:
 - a. Surface Texture: Open Cell
 - b. Composition: Metal
 - c. Color: White
 - d. Size: 24 in x 24 in
 - e. Edge Profile: Square Lay-In 9/16 in for interface with SUPRAFINE XL 9/16"
 - Exposed Tee grid.
 - f. Perforation Option: Open Cell
 - g. Flame Spread: ASTM E 1264; Class A (IBC).
 - h. Light Reflectance (LR) White Panel: ASTM E 1477; .
 - i. Dimensional Stability: Standard
 - j. Basis of Design Product: MetalWorks Open Cell, 6194
 - 2. Metal Panel Accessories:
- 2.3 METAL SUSPENSION SYSTEMS

A. Components:

Main beams and cross tees, base metal and end detail, fabricated from commercial quality hot dipped galvanized steel complying with ASTM A 653. Main beams and cross tees are double-web steel construction with type exposed flange design. Exposed surfaces chemically cleansed, capping prefinished galvanized steel in baked polyester paint. Main beams and cross tees shall have rotary stitching.

- a. Structural Classification: ASTM C 635 Heavy Duty
- b. Color: Whitesand match the actual color of the selected ceiling tile, unless noted otherwise.
- c. Basis of Design Product: Suprafine XL 9/16" Exposed Tee
- B. Attachment Devices:

Size for five times design load indicated in ASTM C 635, Table 1, Direct Hung unless otherwise indicated.

C. Wire for Hangers and Ties:

ASTM A 641, Class 1 zinc coating, soft annealed, with a yield stress load of at least times three design load, but not less than 12 gauge.

- D. Edge Moldings and Trim:
- E. Accessories: 7901 9/16" Shadow Reveal Transition Molding



PART 3 - EXECUTION

3.1 EXAMINATION

A. Do not proceed with installation until all wet work such as concrete, terrazzo, plastering and painting has been completed and thoroughly dried out, unless expressly permitted by manufacturer's printed recommendations. (Exception: HumiGuard Max Ceilings)

3.2 PREPARATION

A. Measure each ceiling area and establish layout of acoustical units to balance border widths at opposite edges of each ceiling. Avoid use of less than half width units at borders, and comply with reflected ceiling plans. Coordinate panel layout with mechanical and electrical fixtures.

B. Coordination: Furnish layouts for preset inserts, clips, and other ceiling anchors whose installation is specified in other sections.

1. Furnish concrete inserts and similar devices to other trades for installation well in advance of time needed for coordination of other work.

3.3 INSTALLATION

A. Follow manufacturer installation instructions

B. Install suspension system and panels in accordance with the manufacturer's instructions, and in compliance with ASTM C 636 and with the authorities having jurisdiction.

C. Install wall moldings at intersection of suspended ceiling and vertical surfaces. Miter corners where wall moldings intersect or install corner caps.

D. For reveal edge panels: Cut and reveal or rabbet edges of ceiling panels at border areas and vertical surfaces.

E. Install acoustical panels in coordination with suspended system, with edges resting on flanges of main runner and cross tees. Cut and fit panels neatly against abutting surfaces. Support edges by wall moldings.

F. Install acoustical panels in coordination with suspended system, with edges resting on flanges of main runner and cross tees. Cut and fit panels neatly against abutting surfaces. Support edges by wall moldings.

3.4 ADJUSTING AND CLEANING

A. Replace damaged and broken panels.

B. Clean exposed surfaces of ceilings panels, including trim, edge moldings, and suspension members. Comply with manufacturer's instructions for cleaning and touch up of minor finish damage. Remove and replace work that cannot be successfully cleaned and repaired to permanently eliminate evidence of damage.

END OF SECTIO 09 50 00 - OC



SECTION 09 51 33 - ACOUSTICAL METAL CEILINGS - 3D

PART 1 - GENERAL

- **1.1 RELATED DOCUMENTS**
- A. Section Includes

Drawings and general conditions of Contract, including General and Supplementary Conditions and Divisions-1 Specification sections apply to work of this section

1.2 SUMMARY

A. Section Includes

- 1. Acoustical metal ceiling panels
- 2. Exposed grid suspension system
- 3. Wire hangers, fasteners, main runners, cross tees, and wall angle moldings
- 4. Perimeter Trim
- B. Related Sections:
 - 1. Section 09 51 33.13 Acoustical Snap In Metal Pan Ceiling
 - 2. Section 09 20 00 (09250) Plaster and Gypsum Board
 - 3. Section 09 51 13 (09500) Acoustical Fabric-Faced Panel Ceilings
 - 4. Section 09 53 00 (09500) Acoustical Ceiling Suspension Assemblies
 - 5. Section 01 81 13 Sustainable Design Requirements
 - 6. Section 01 81 19 Indoor Air Quality Requirements
 - 7. Section 09 54 00 Specialty Ceilings
 - 8. Divisions 23 HVAC Air Distribution
 - 9. Division 26 Electrical

1.3 REFERENCES

A. American Society for Testing and Materials (ASTM):

1. ASTM A 1008 Standard Specification for Steel, Sheet, Cold Rolled, Carbon, Structural, High-Strength Low-Alloy and High-Strength Low-Alloy with Improved Formability

2. ASTM A 641 Standard Specification for Zinc-Coated (Galvanized) Carbon Steel Wire

3. ASTM A 653 Standard Specification for Steel Sheet, Zinc-Coated (Galvanized) by the Hot-Dip Process

4. ASTM C 423 Sound Absorption and Sound Absorption Coefficients by the Reverberation Room Method

5. ASTM C 635 Standard Specification for Metal Suspension Systems for Acoustical Tile and Lay-in Panel Ceilings

6. ASTM C 636 Recommended Practice for Installation of Metal Ceiling Suspension Systems for Acoustical Tile and Lay-in Panels

7. ASTM D 3273 Standard Test Method for Resistance to Growth of Mold on the Surface of Interior Coatings in an Environmental Chamber

8. ASTM E 84 Standard Test Method for Surface Burning Characteristics of Building Materials

9. ASTM E 580 Installation of Metal Suspension Systems in Areas Requiring Moderate Seismic Restraint

10. ASTM E 1111 Standard Test Method for Measuring the Interzone Attenuation of Ceilings Systems

11. ASTM E 1414 Standard Test Method for Airborne Sound Attenuation Between Rooms Sharing a Common Ceiling Plenum

12. ASTM E 1264 Classification for Acoustical Ceiling Products

B. International Building Code

C. ASHRAE Standard 62 1 2004 Ventilation for Acceptable Indoor Air Quality

D. NFPA 70 National Electrical Code

E. ASCE 7 American Society of Civil Engineers, Minimum Design Loads for Buildings and Other Structures

F. International Code Council-Evaluation Services - AC 156 Acceptance Criteria for Seismic Qualification Testing of Non-structural Components



- G. International Code Council-Evaluation Services Report Seismic Engineer Report
 - 1. ESR 1308 Armstrong Suspension Systems
- H. International Association of Plumbing and Mechanical Officials Seismic Engineer Report 1. 0244 - Armstrong Single Span Suspension System
- I. California Department of Public Health CDPH/EHLB Emission Standard Method Version 1.1 2010 J. LEED - Leadership in Energy and Environmental Design is a set of rating systems for the design, construction, operation, and maintenance of green buildings
- K. International Well Building Standard
- L. Mindful Materials
- M. Living Building Challenge
- N. U.S. Department of Agriculture BioPreferred program (USDA BioPreferred).
- 1.4 SYSTEM DESCRIPTION
 - Discontinuous/Open Plenum
- **1.5 SUBMITTALS**

A. Product Data: Submit manufacturer's technical data for each type of acoustical ceiling unit and suspension system required.

B. Samples: Minimum 6 inch x 6 inch samples of specified acoustical panel; 8 inch long samples of exposed wall molding and suspension system, including main runner and 4 foot cross tees.C. Shop Drawings: Layout and details of acoustical ceilings show locations of items that are to be coordinated with, or supported by the ceilings.

D. Certifications: Manufacturer's certifications that products comply with specified requirements, including laboratory reports showing compliance with specified tests and standards. For acoustical performance, each carton of material must carry an approved independent laboratory classification of NRC, CAC, and AC.

E. If the material supplied by the acoustical subcontractor does not have an Underwriter's Laboratory classification of acoustical performance on every carton, subcontractor shall be required to send material from every production run appearing on the job to an independent or NVLAP approved laboratory for testing, at the architect's or owner's discretion. All products not conforming to manufacturer's current published values must be removed, disposed of and replaced with complying product at the expense of the Contractor performing the work.

1.6 QUALITY ASSURANCE

A. Single-Source Responsibility: Provide acoustical panel units and grid components by a single manufacturer.

B. Fire Performance Characteristics: Identify acoustical ceiling components with appropriate markings of applicable testing and inspecting organization.

a. Surface Burning Characteristics: As follows, tested per ASTM E 84 and complying with ASTM E 1264 Classification.

C. Acoustic Panels: As with other architectural features located at the ceiling, may obstruct or skew the planned fire sprinkler water distribution pattern through possibly delay or accelerate the activation of the sprinkler or fire detection systems by channeling heat from a fire either toward or away from the device. Designers and installers are advised to consult a fire protection en gineer, NFPA 13, or their local codes for guidance where automatic fire detection and suppression systems are present. D. Coordination of Work: Coordinate acoustical ceiling work with installers of related work including, but not limited to building insulation, gypsum board, light fixtures, mechanical systems, electrical systems, and sprinklers.

1.7 DELIVERY, STORAGE AND HANDLING

A. Deliver acoustical ceiling units to project site in original, unopened packages and store them in a fully enclosed space where they will be protected against damage from moisture, direct sunlight, surface contamination, and other causes.

B. Before installing acoustical ceiling units, permit them to reach room temperature and a stabilized moisture content.

C. Handle acoustical ceiling units carefully to avoid chipping edges or damaged units in any way.



1.8 PROJECT CONDITIONS

A. Space Enclosure:

Standard Ceilings: Do not install interior ceilings until space is enclosed and weatherproof; wet work in place is completed and nominally dry; work above ceilings is complete; and ambient conditions of temperature and humidity are continuously maintained at values near those intended for final occupancy. Building areas to receive ceilings shall be free of construction dust and debris. HumiGuard Plus Ceilings: Building areas to receive ceilings shall be free of construction dust and debris. Products with HumiGuard Plus performance and hot dipped galvanized steel, aluminum or stainless steel suspension systems can be installed up to 120°F (49°C) and in spaces before the building is enclosed, where HVAC systems are cycled or not operating. Cannot be used in exterior applications where standing water is present or where moisture will come in direct contact with the ceiling.

HumiGuard Max Ceilings: Building areas to receive ceilings shall be free of construction dust and debris. Ceilings with HumiGuard Max performance can be installed in conditions up to 120°F (49°C) and maximum humidity exposure including outdoor applications, and other standing water applications, so long as they are installed with either SS Prelude Plus, AL Prelude Plus, or Prelude Plus Fire Guard XL suspension systems. Products with Humiguard Max performance can be installed in exterior applications, where standing water is present, or where moisture will come in direct contact with the ceiling. Only Ceramaguard with AL Prelude Plus suspension system can be installed over swimming pools.

1.9 WARRANTY

A. Acoustical Panel: Submit a written warranty executed by the manufacturer, agreeing to repair or replace panels that fail within the warranty period. Failures include, but are not limited to the following:

- 1. Acoustical Panels: Sagging and warping
- 2. Grid System: Rusting and manufacturer's defects
- B. Warranty Period:
 - 1. Acoustical Metal panels: One (1) year from date of substantial completion
 - 2. Grid: Ten (10) years from date of substantial completion

C. The Warranty shall not deprive the Owner of other rights the Owner may have under other provisions of the Contract Documents and will be in addition to and run concurrent with other warranties made by the Contractor under the requirements of the Contract Documents.

1.10 MAINTENANCE

A. Extra Materials: Deliver extra materials to Owner. Furnish extra materials described below that match products installed. Packaged with protective covering for storage and identified with appropriate labels.

1. Acoustical Metal Ceiling Units: Furnish quality of full-size units equal to 5.0 percent of amount installed.

2. Exposed Suspension System Components: Furnish quantity of each exposed suspension component equal to 2.0 percent of amount installed.

PART 2 - PRODUCTS

2.1 MANUFACTURERS

A. Metal Ceiling Panels:

1. Armstrong World Industries, Inc. – Basis of Design

- B. Suspension Systems:
 - 1. Armstrong World Industries, Inc. Basis of Design
- C. Aluminum Custom Trims:
 - 1. Armstrong World Industries, Inc. Basis of Design
- 2.2 ACOUSTICAL CEILING UNITS
 - A. Acoustical Panels Type AMP



- 1. Acoustical Panels Type AMP-1:
 - a. Surface Texture: Smooth
 - b. Composition: Metal
 - c. Color: To be selected by Architect from Mfgr.'s full range
 - d. Size: 24 in x 24 in

e. Edge Profile: Square Up Tegular 9/16 in for interface with SUPRAFINE XL 9/16" Exposed Tee grid.

f. Perforation Option: Round - Diagonal

g. Noise Reduction Coefficient (NRC): ASTM C 423; Classified with UL label on product carton 0.70

- h. Flame Spread: ASTM E 1264; Class A (painted) / Class B (laminate).
- i. Light Reflectance (LR) White Panel: ASTM E 1477; 0.61.
- j. Dimensional Stability: Standard
 - k. Basis of Design Product: MetalWorks 3D
- 2. Metal Panel Accessories:
 - a. 5823 BioAcoustic Infill Panel (Black Matte)
- 2.3 METAL SUSPENSION SYSTEMS
 - A. Components:

Main beams and cross tees, base metal and end detail, fabricated from commercial quality hot dipped galvanized steel complying with ASTM A 653. Main beams and cross tees are double-web steel construction with type exposed flange design. Exposed surfaces chemically cleansed, capping prefinished galvanized steel in baked polyester paint. Main beams and cross tees shall have rotary stitching.

a. Structural Classification: ASTM C 635 Heavy Duty duty

b. Color: Tech Blackand match the actual color of the selected ceiling tile, unless noted otherwise.

c. Basis of Design Product: Suprafine XL 9/16" Exposed Tee

B. Attachment Devices:

Size for five times design load indicated in ASTM C 635, Table 1, Direct Hung unless otherwise indicated.

C. Wire for Hangers and Ties:

ASTM A 641, Class 1 zinc coating, soft annealed, with a yield stress load of at least times three design load, but not less than 12 gauge.

- D. Edge Moldings and Trim: To be selected by Architect
- E. Accessories: 7901 9/16" Shadow Reveal Transition Molding
- 2.4 ALUMINUM CUSTOM TRIM EXTRUDED

Product/Manufacturer: Axiom Trim Channel: 6in Axiom Vector Straight Armstrong World Industries, Incorporated

A. Commercial quality extruded aluminum alloy 6063 trim channel, factory finished in baked polyester paint. Commercial quality galvanized steel unfinished T-bar connection clips; galvanized steel splice plates.

- 1. Color: Brushed Bright or as selected by Architect from mfgr's full range
- 2. Size: 120 in X 6 in
- 3. Basis of Design Product: Axiom Vector, 6in Axiom Vector Straight
- B. Axiom Trim Channel:
 - 6in Axiom Vector Straight

C. Axiom Outside Corner Posts (Straight Only): 2in Axiom Vector Outside Corner Post 360 Painted

- D. Axiom Accessories:
 - 1. AX4SPLICE Splice Plate with Setscrews



PART 3 - EXECUTION

3.1 EXAMINATION

A. Do not proceed with installation until all wet work such as concrete, terrazzo, plastering and painting has been completed and thoroughly dried out, unless expressly permitted by manufacturer's printed recommendations. (Exception: HumiGuard Max Ceilings)

3.2 PREPARATION

A. Measure each ceiling area and establish layout of acoustical units to balance border widths at opposite edges of each ceiling. Avoid use of less than half width units at borders, and comply with reflected ceiling plans. Coordinate panel layout with mechanical and electrical fixtures.

B. Coordination: Furnish layouts for preset inserts, clips, and other ceiling anchors whose installation is specified in other sections.

1. Furnish concrete inserts and similar devices to other trades for installation well in advance of time needed for coordination of other work.

3.3 INSTALLATION

A. Follow manufacturer installation instructions

B. Install suspension system and panels in accordance with the manufacturer's instructions, and in compliance with ASTM C 636 and with the authorities having jurisdiction.

C. Install wall moldings at intersection of suspended ceiling and vertical surfaces. Miter corners where wall moldings intersect or install corner caps.

D. For reveal edge panels: Cut and reveal or rabbet edges of ceiling panels at border areas and vertical surfaces.

E. Install acoustical panels in coordination with suspended system, with edges resting on flanges of main runner and cross tees. Cut and fit panels neatly against abutting surfaces. Support edges by wall moldings.


F. Install acoustical panels in coordination with suspended system, with edges resting on flanges of main runner and cross tees. Cut and fit panels neatly against abutting surfaces. Support edges by wall moldings.


3.4 ADJUSTING AND CLEANING


A. Replace damaged and broken panels.


B. Clean exposed surfaces of ceilings panels, including trim, edge moldings, and suspension members. Comply with manufacturer's instructions for cleaning and touch up of minor finish damage. Remove and replace work that cannot be successfully cleaned and repaired to permanently eliminate evidence of damage.


END OF SECTION 09 51 33

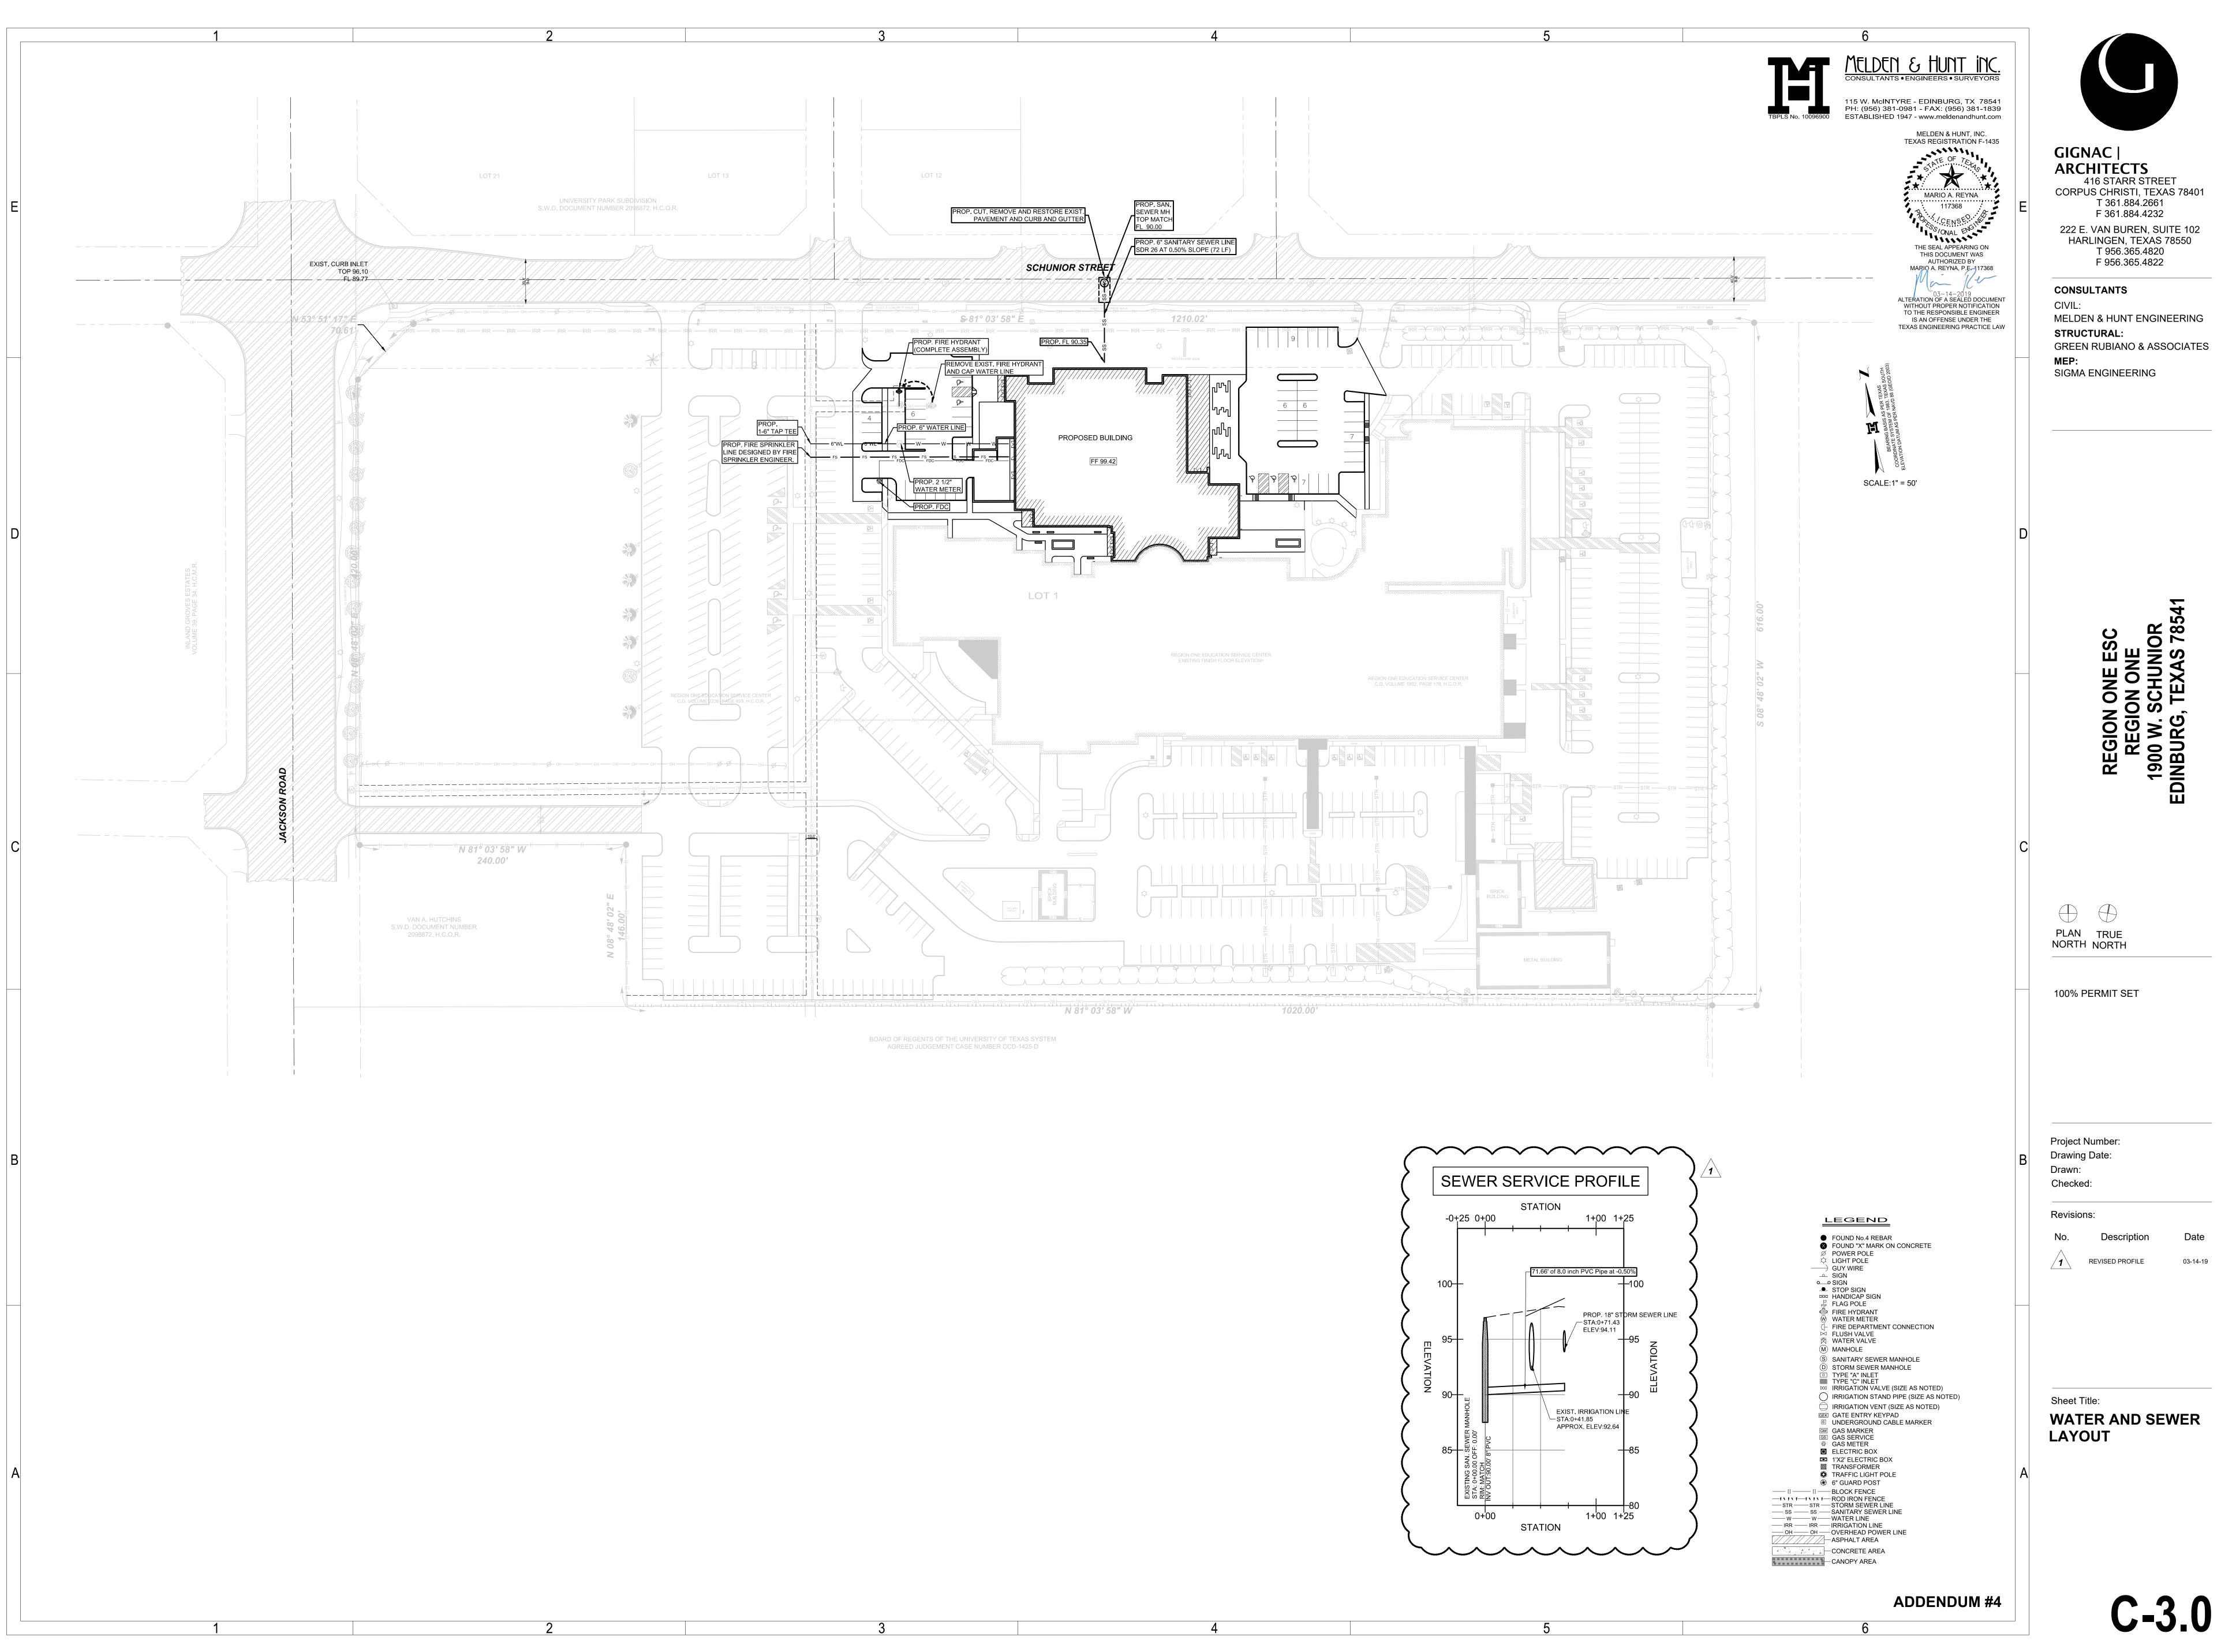

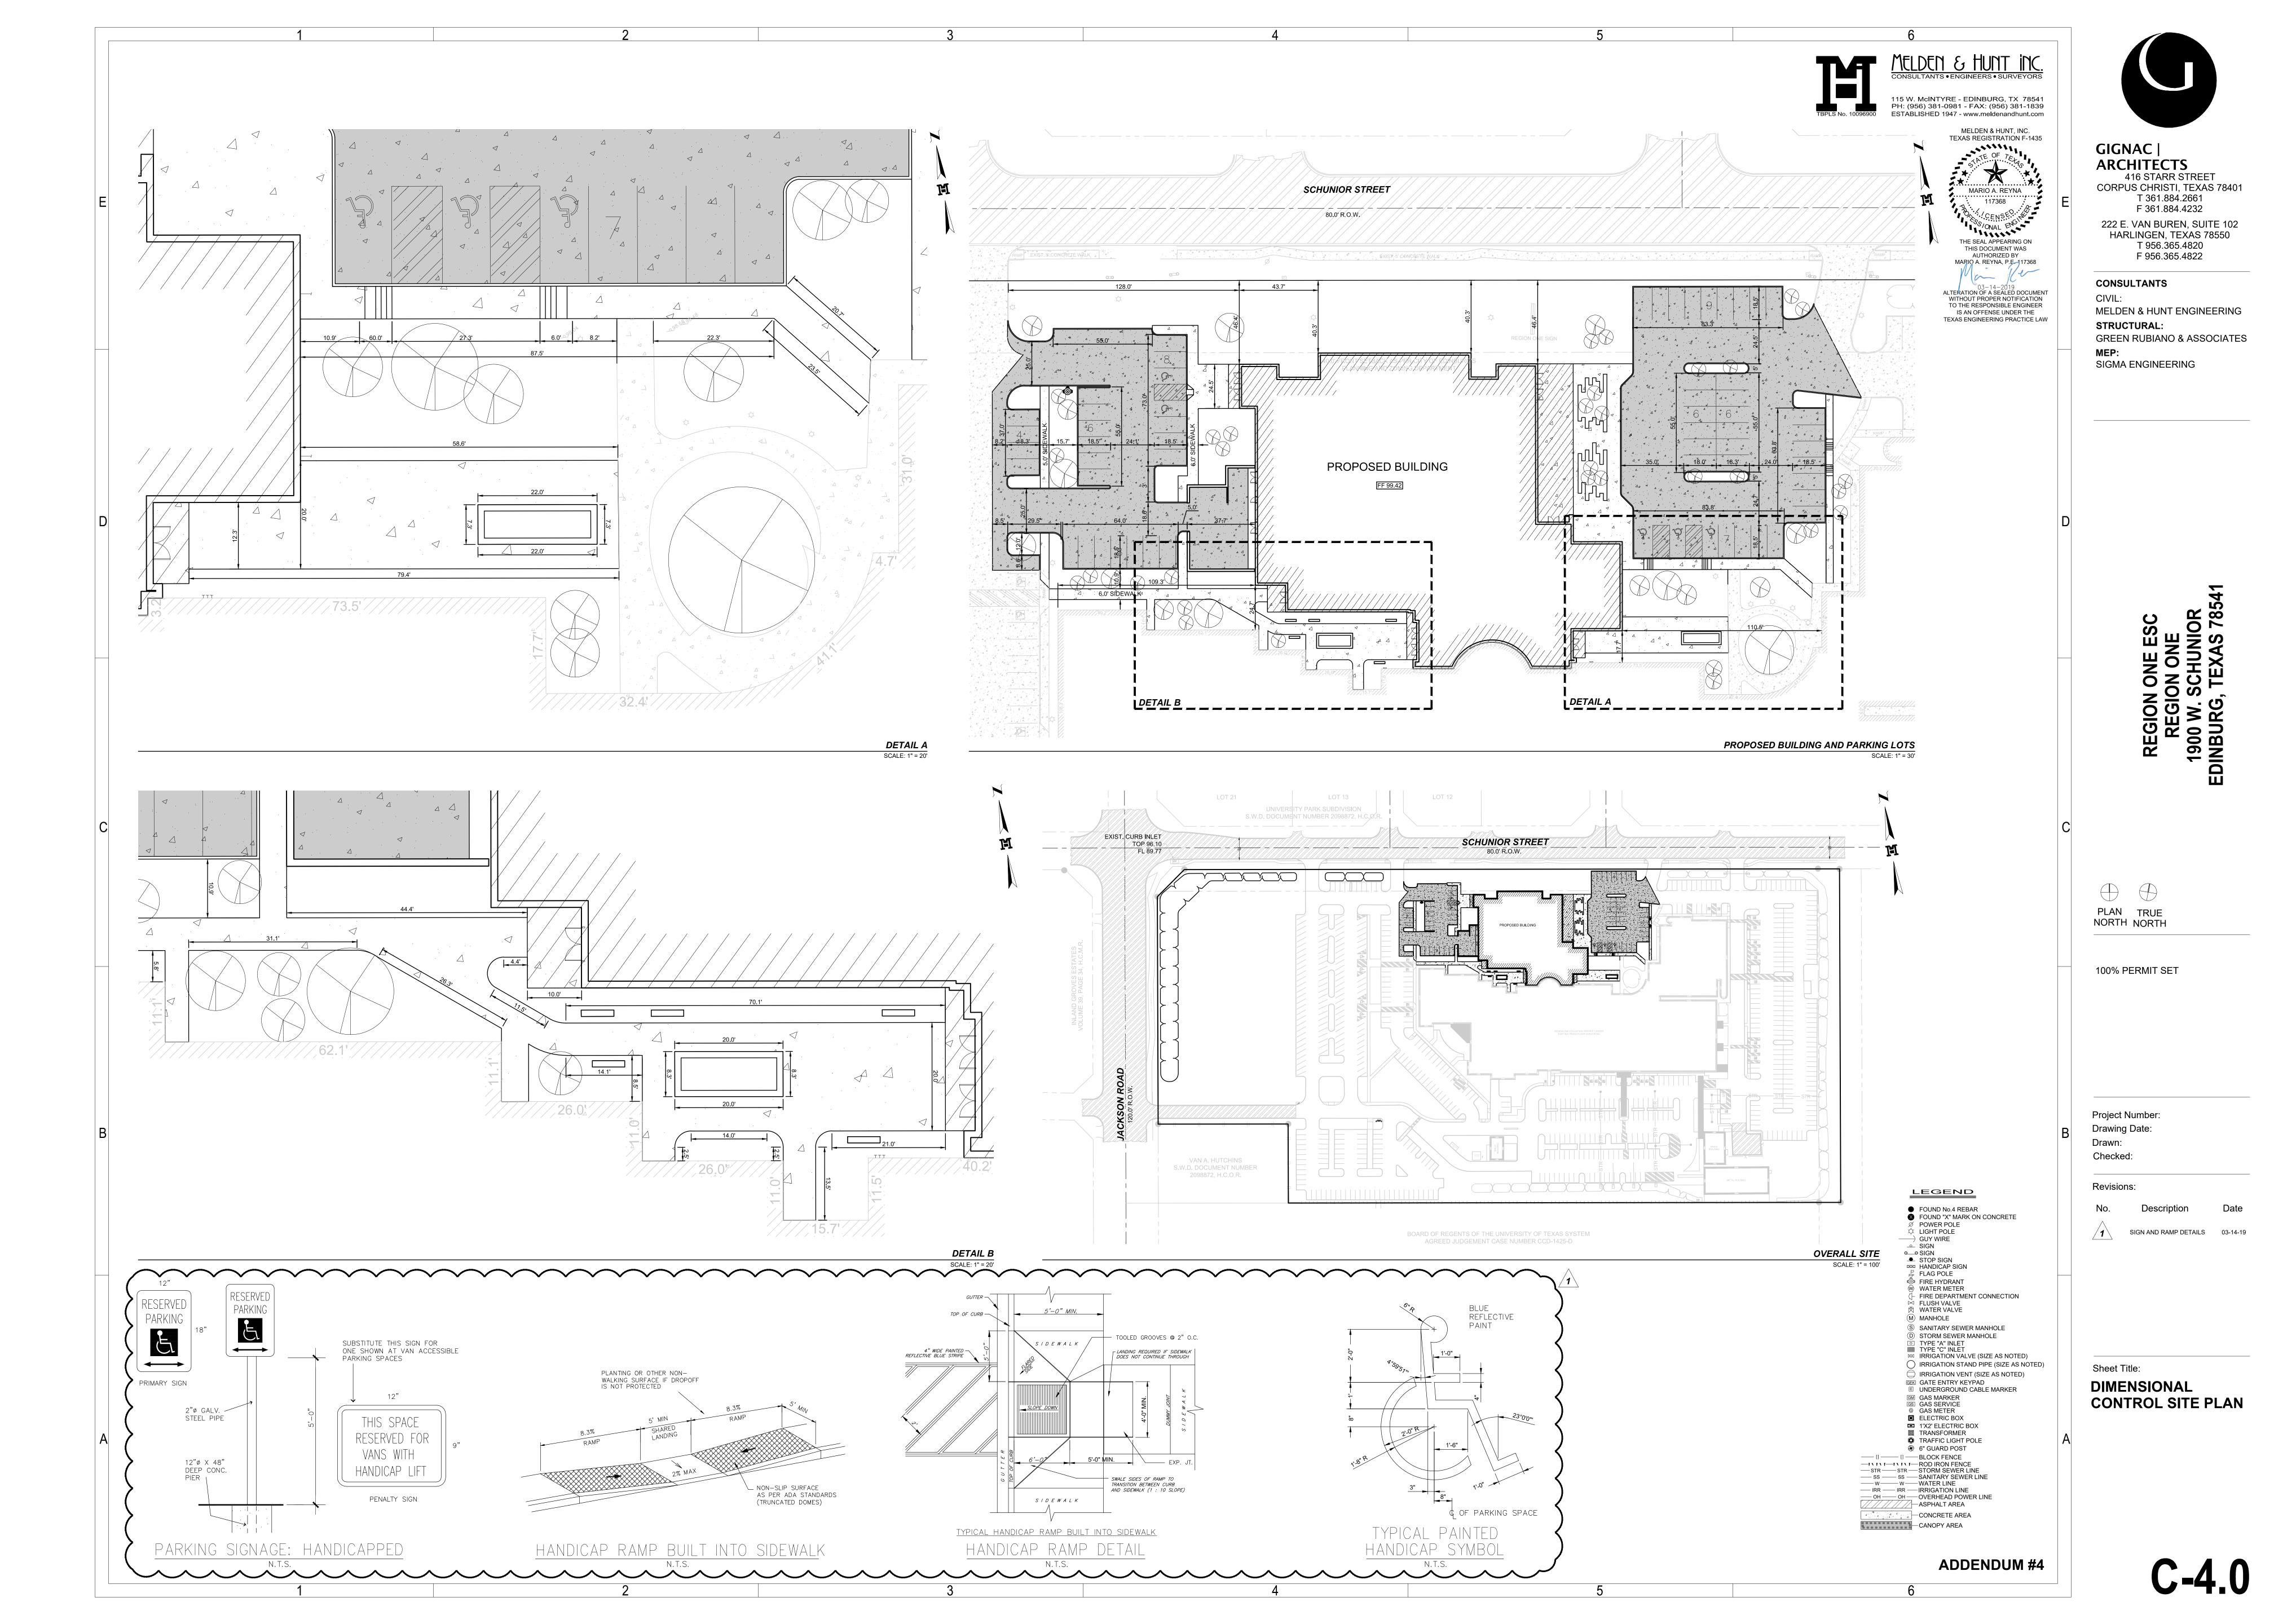

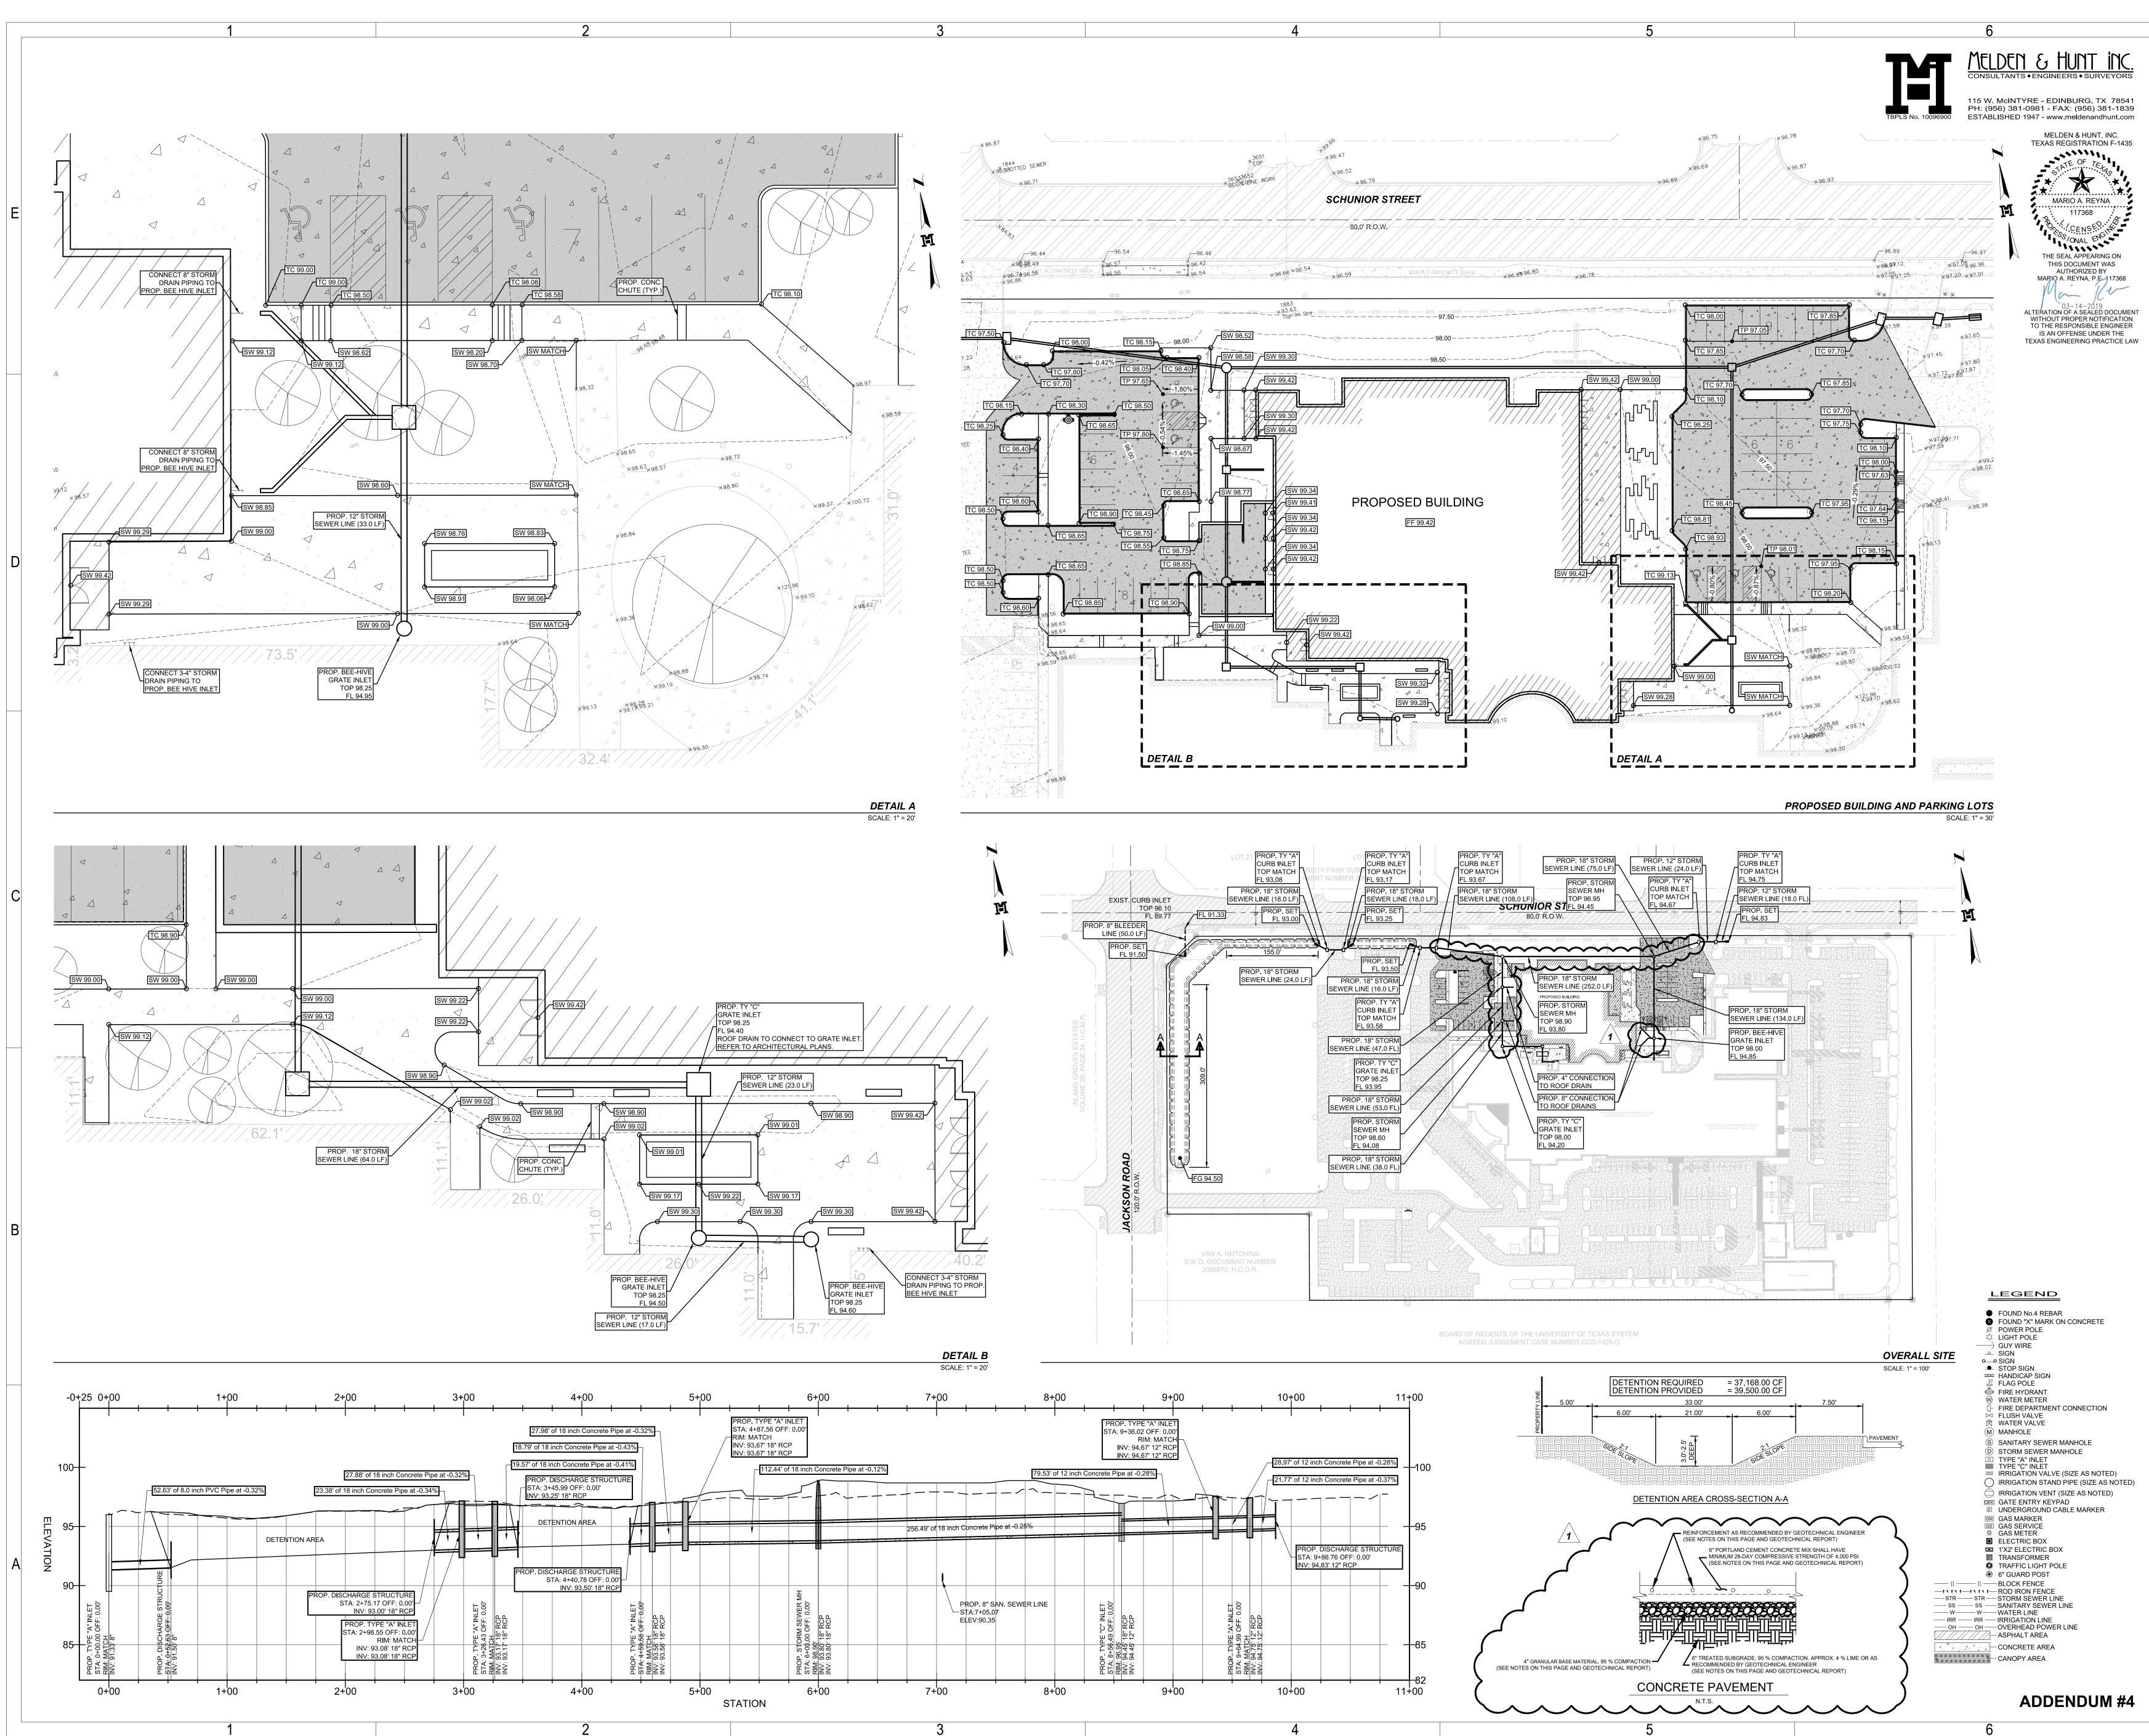

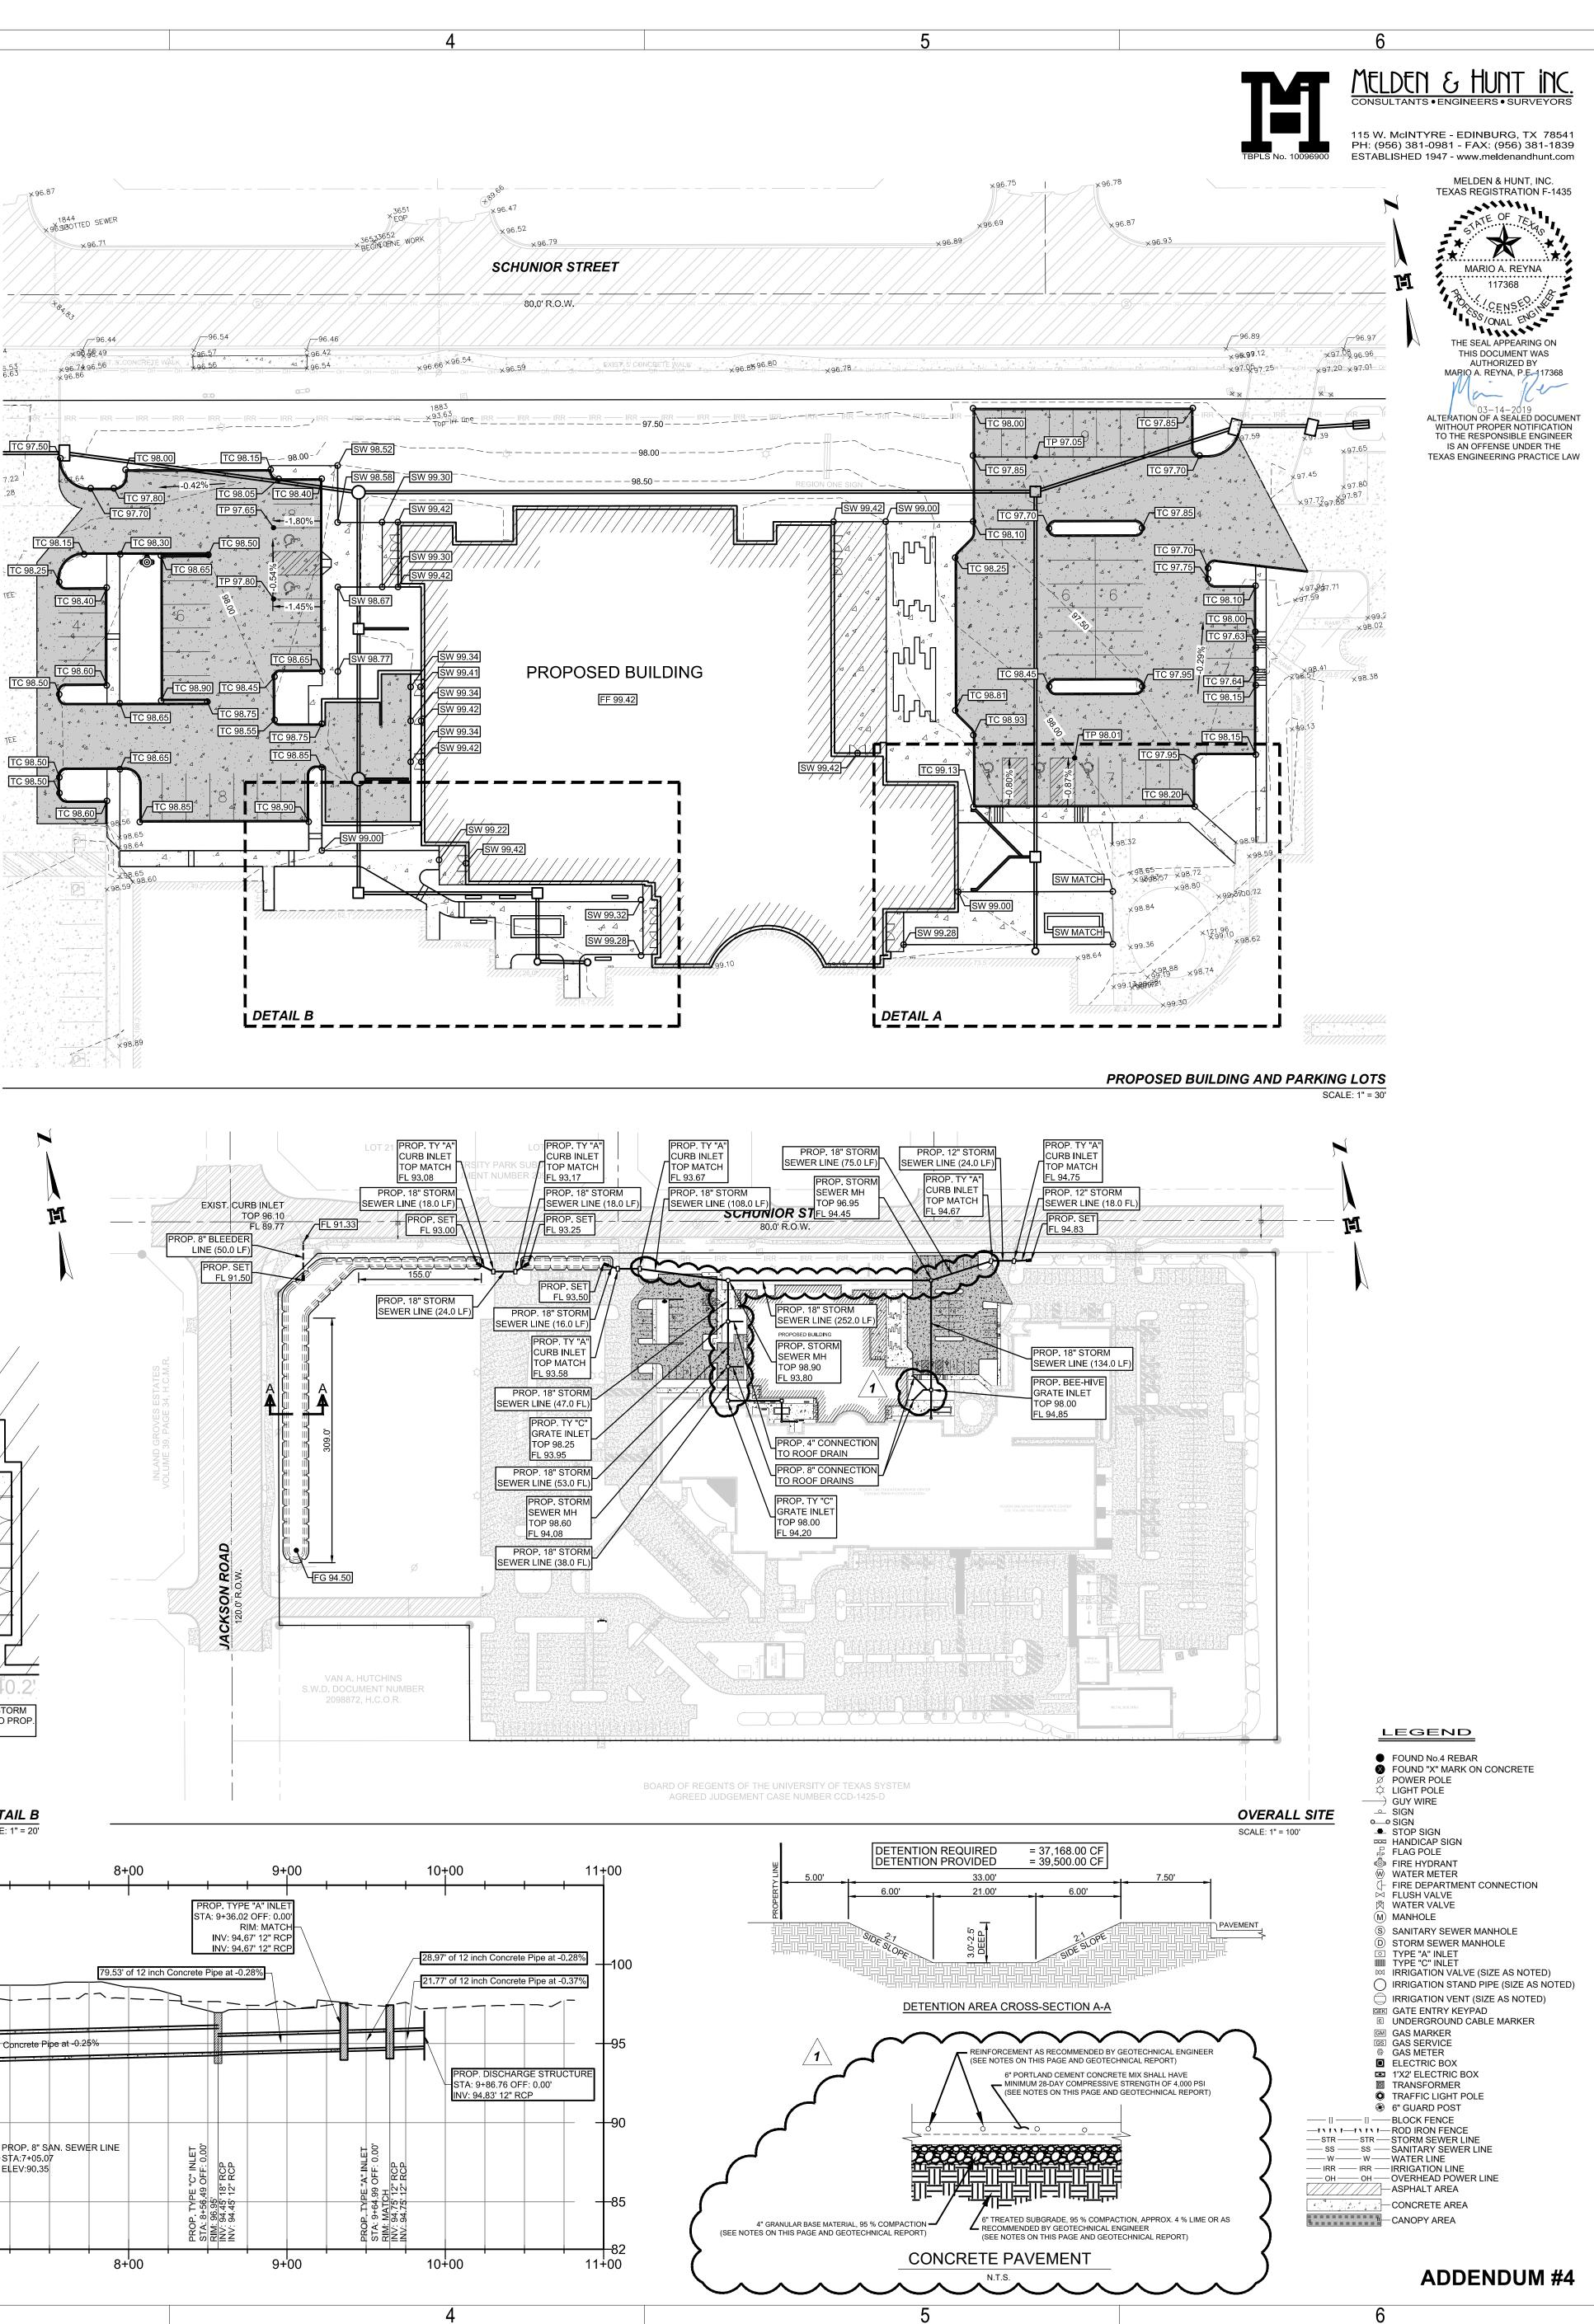

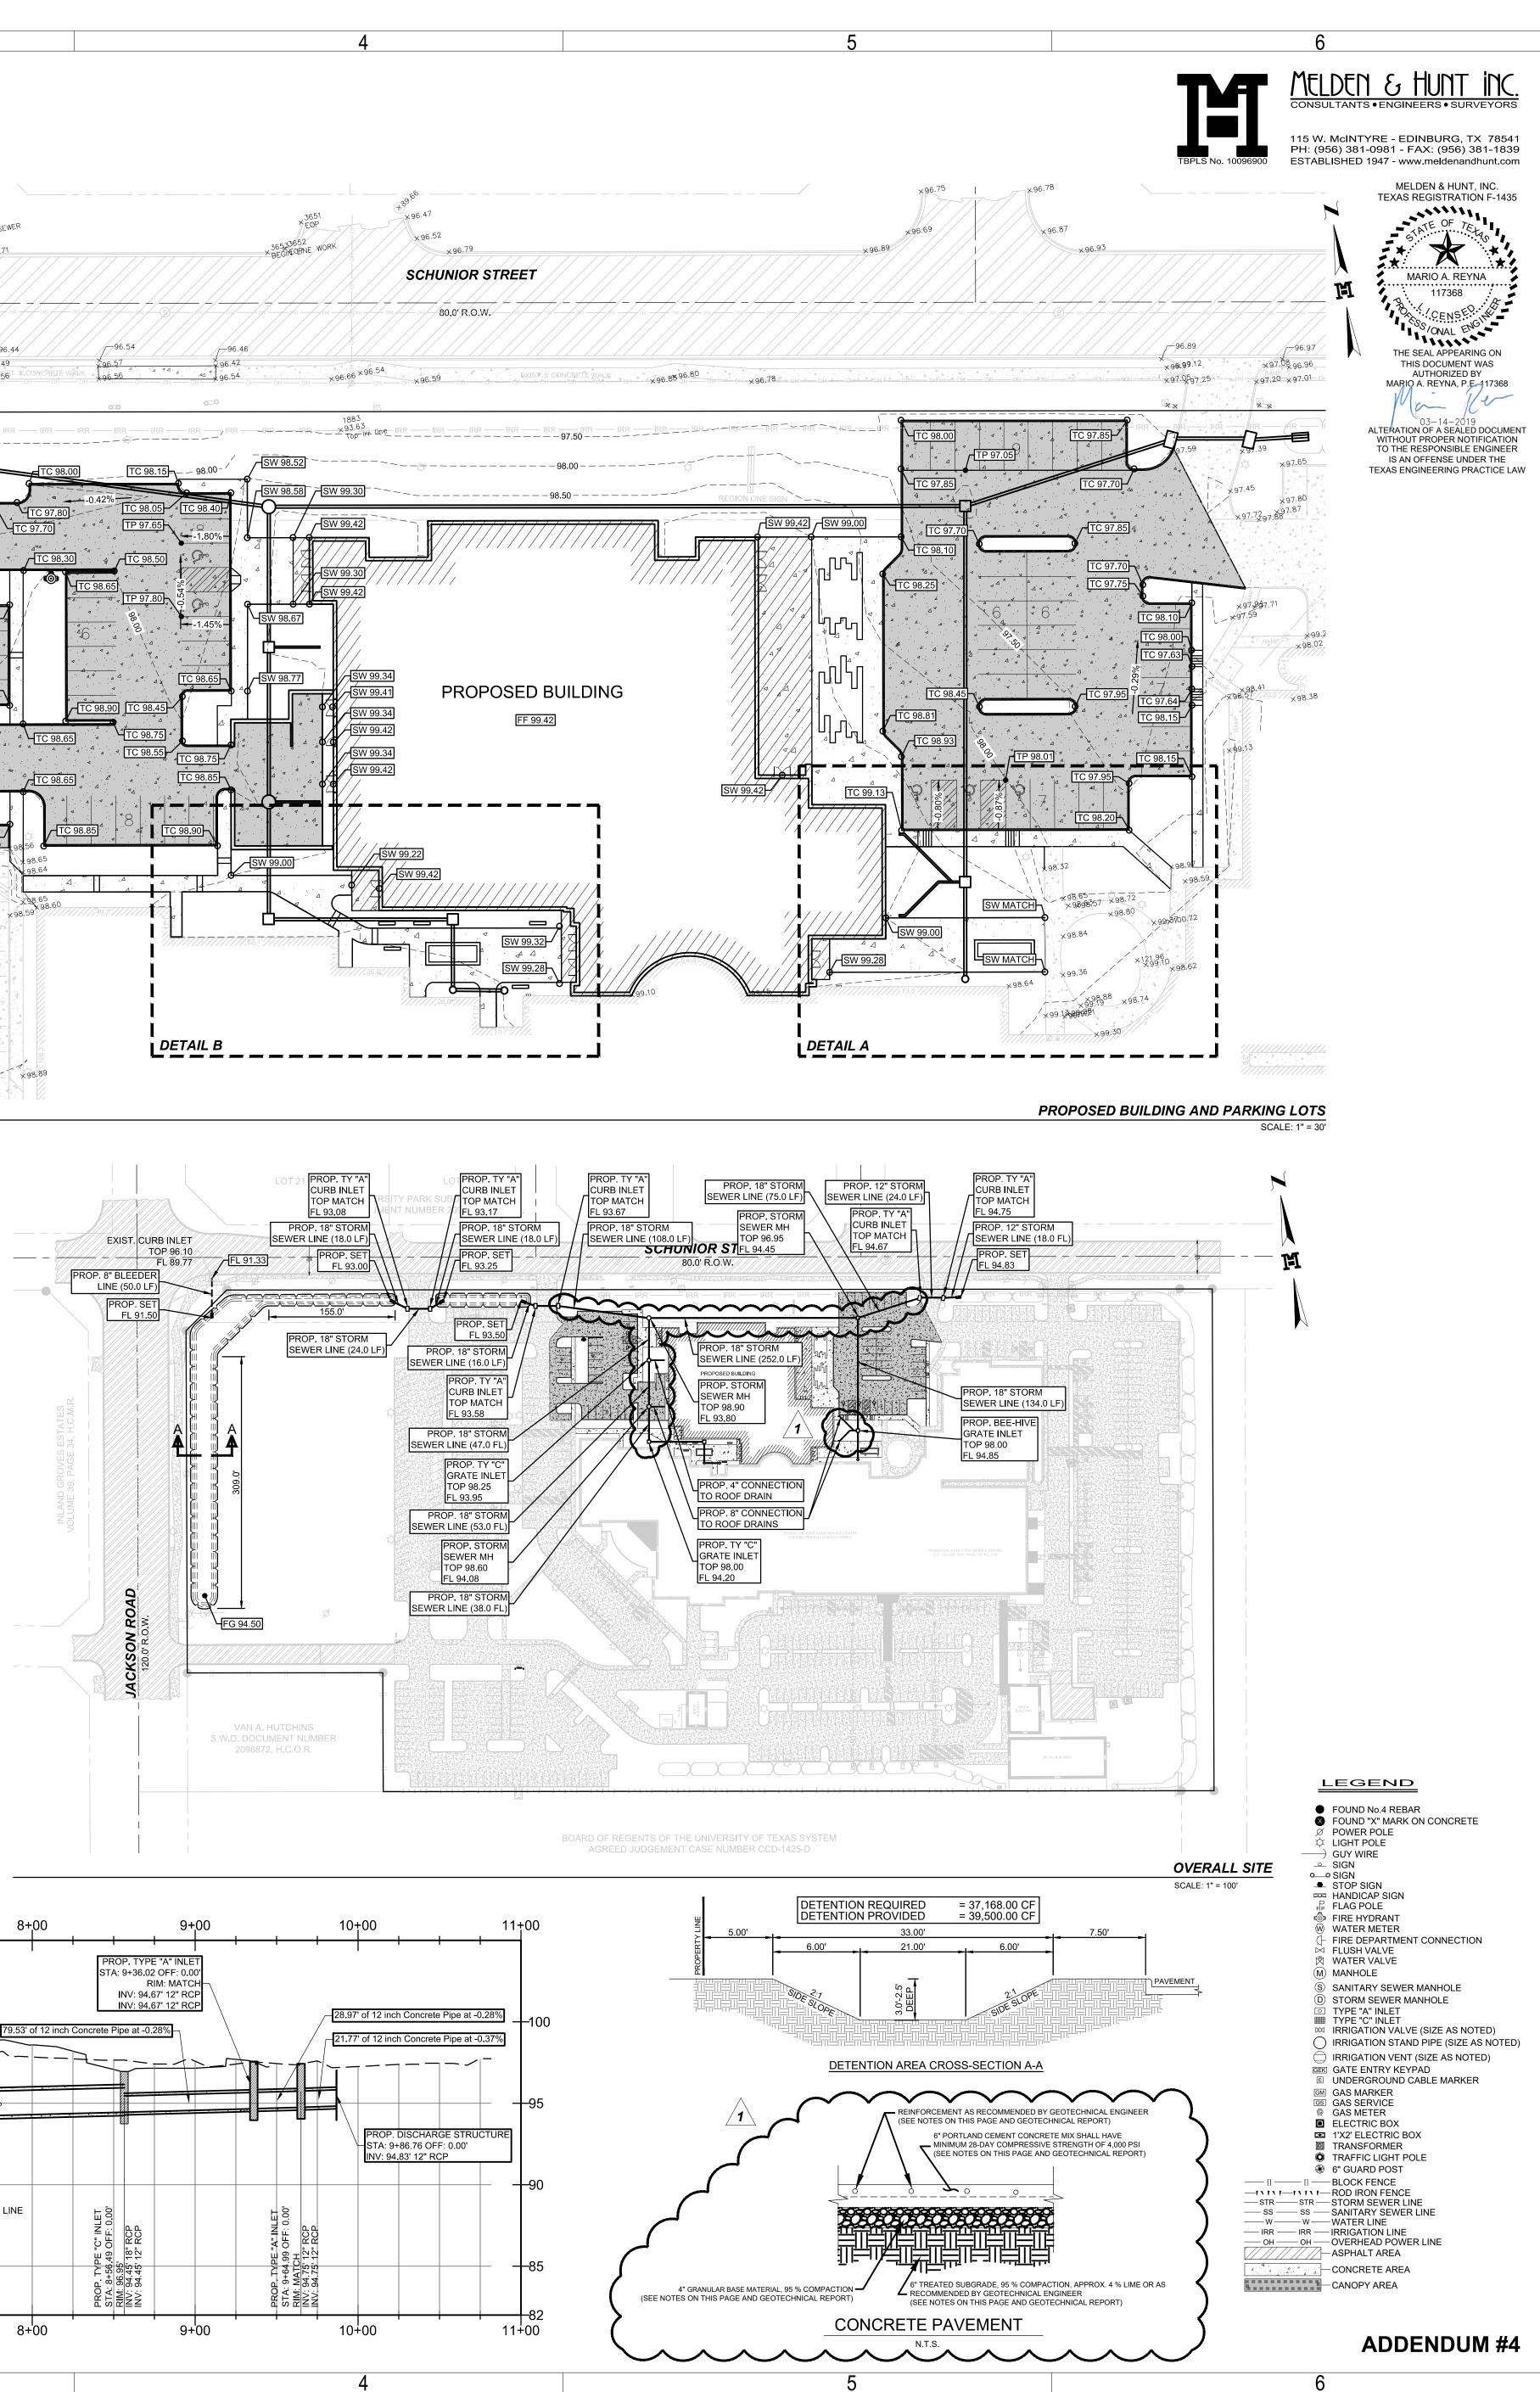



GIGNAC | ARCHITECTS 416 STARR STREET CORPUS CHRISTI, TEXAS 78401 T 361.884.2661 F 361.884.4232 222 E. VAN BUREN, SUITE 102 HARLINGEN, TEXAS 78550 T 956.365.4820 F 956.365.4822

CONSULTANTS CIVIL: **MELDEN & HUNT ENGINEERING** STRUCTURAL: **GREEN RUBIANO & ASSOCIATES** MEP: SIGMA ENGINEERING

REGION ON REGION 1900 W. SCH EDINBURG, TE

 \oplus \oplus PLAN TRUE NORTH NORTH


100% PERMIT SET


Project Number: Drawing Date: Drawn: Checked:


Revisions: Date No. Description ROOF DRAIN CONNECTIONS 03-14-19 / 1 🔪


Sheet Title: PAVING AND DRAINAGE PLAN




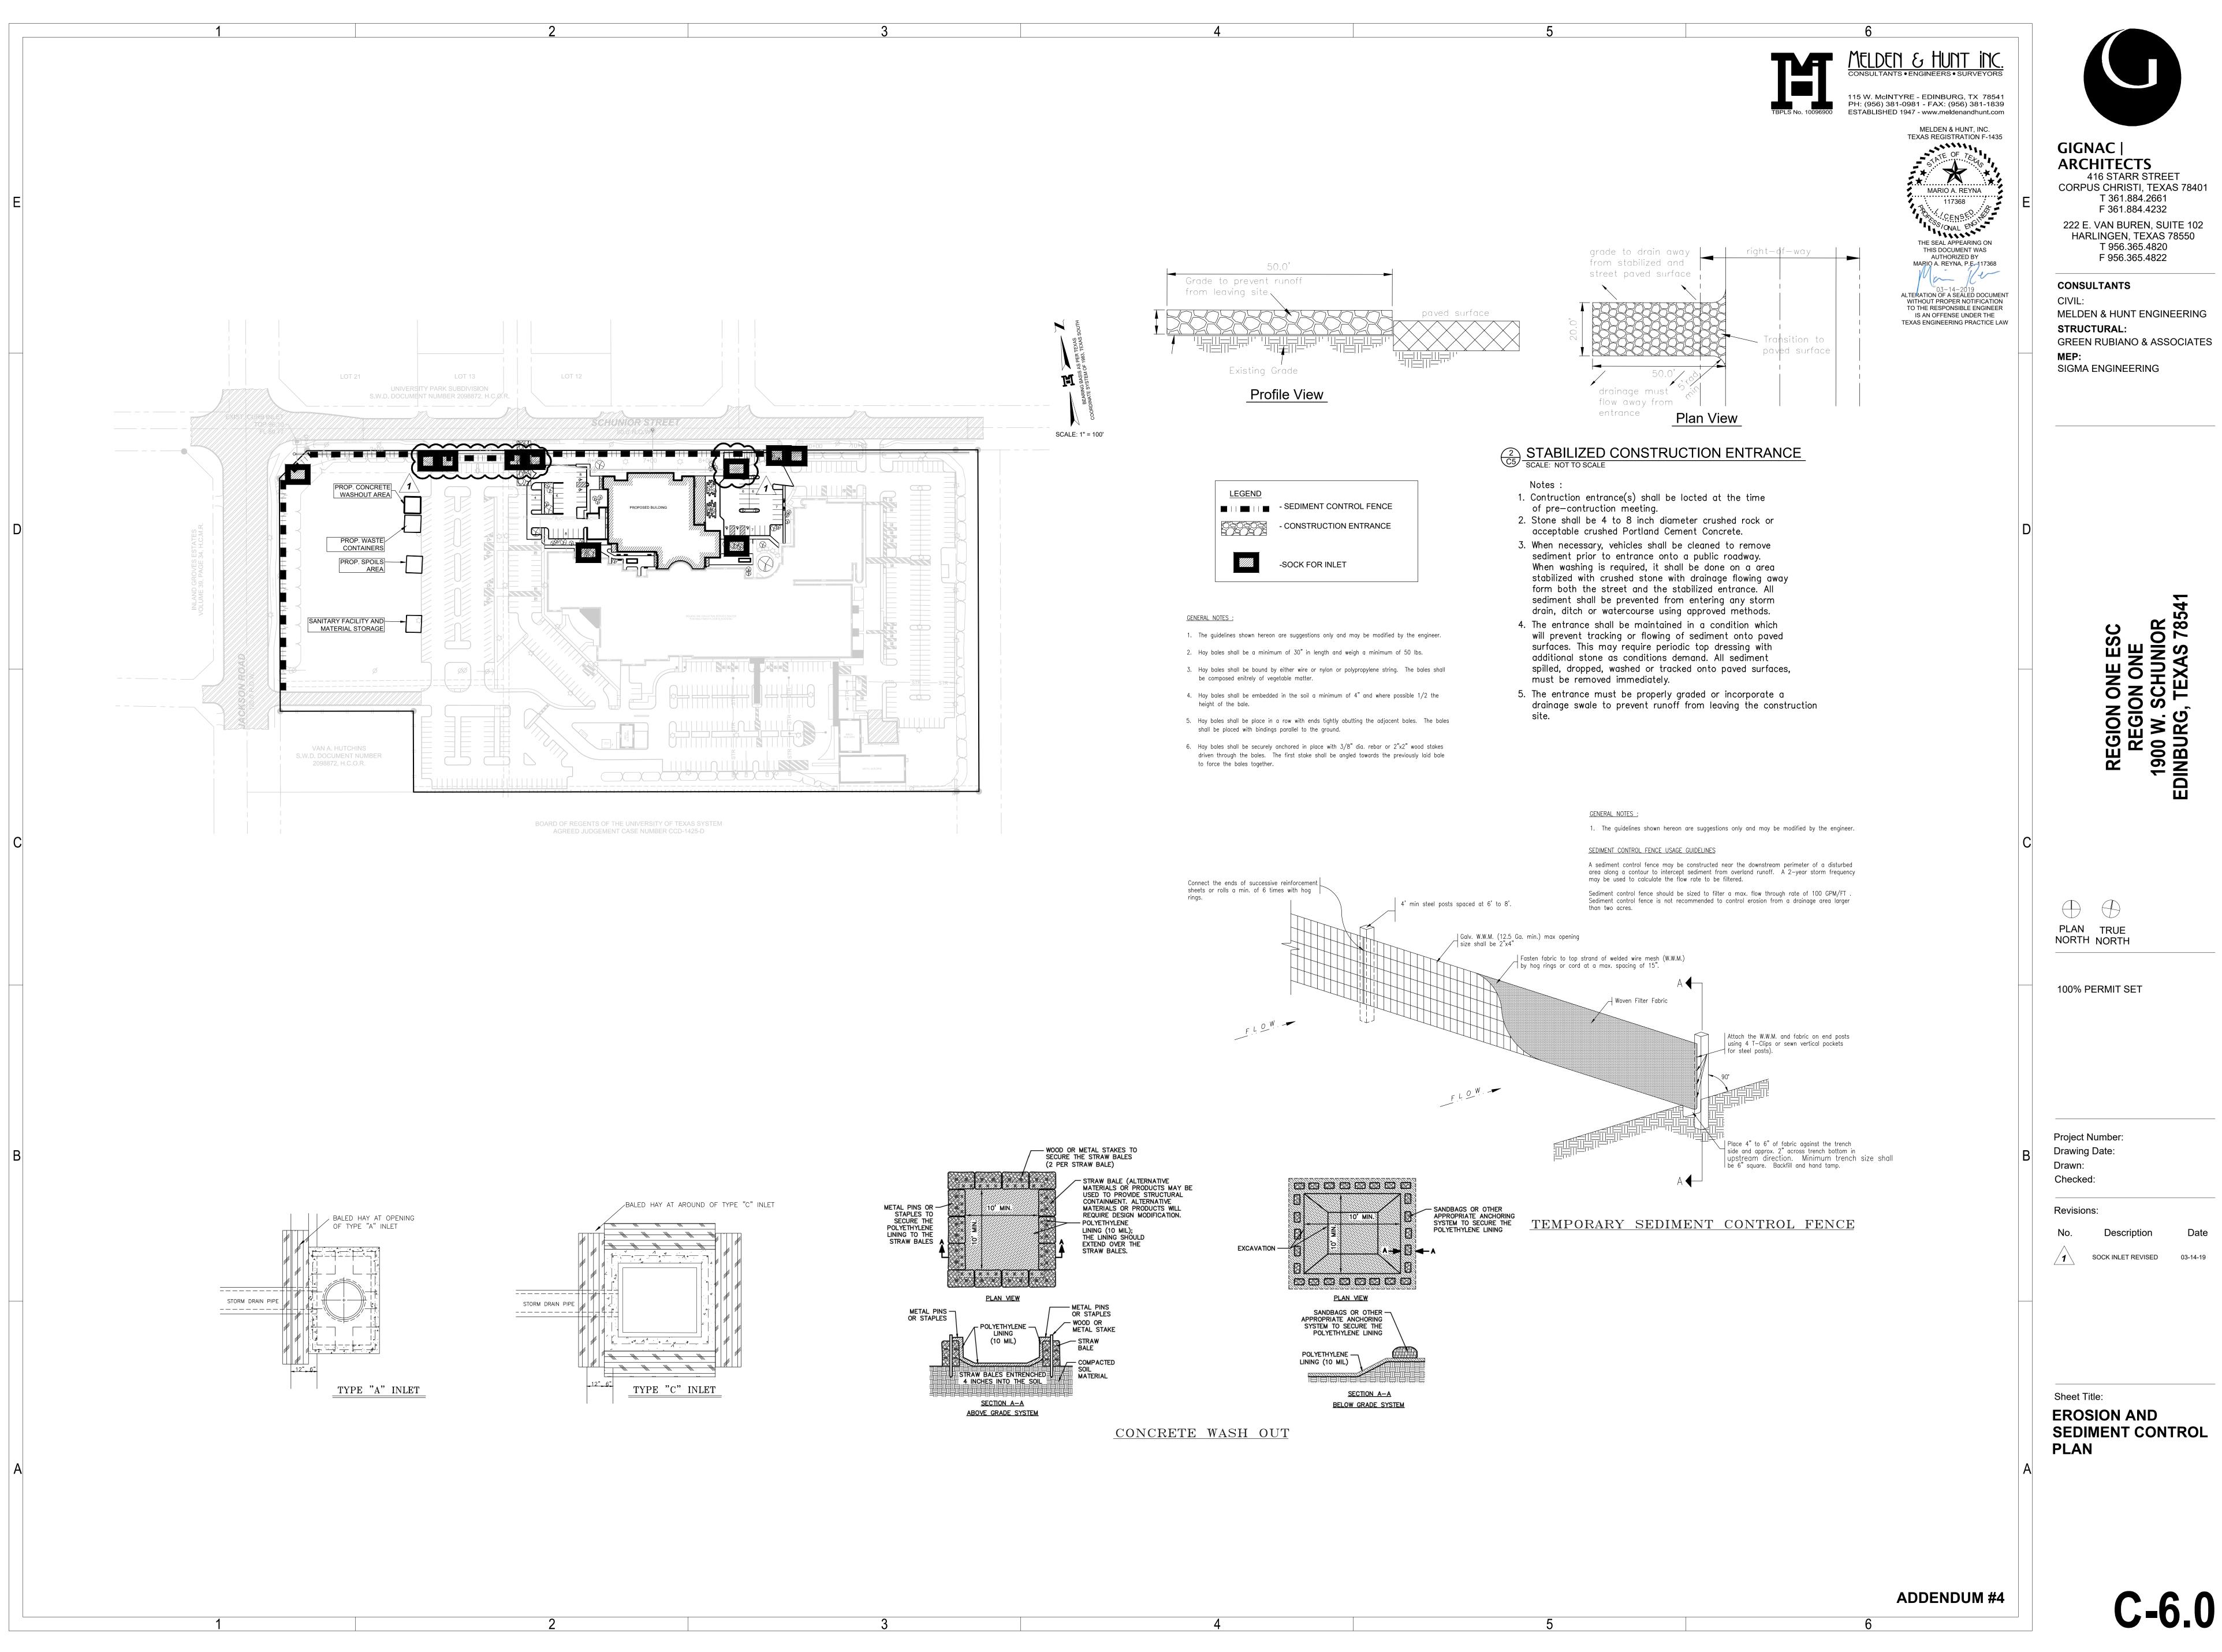

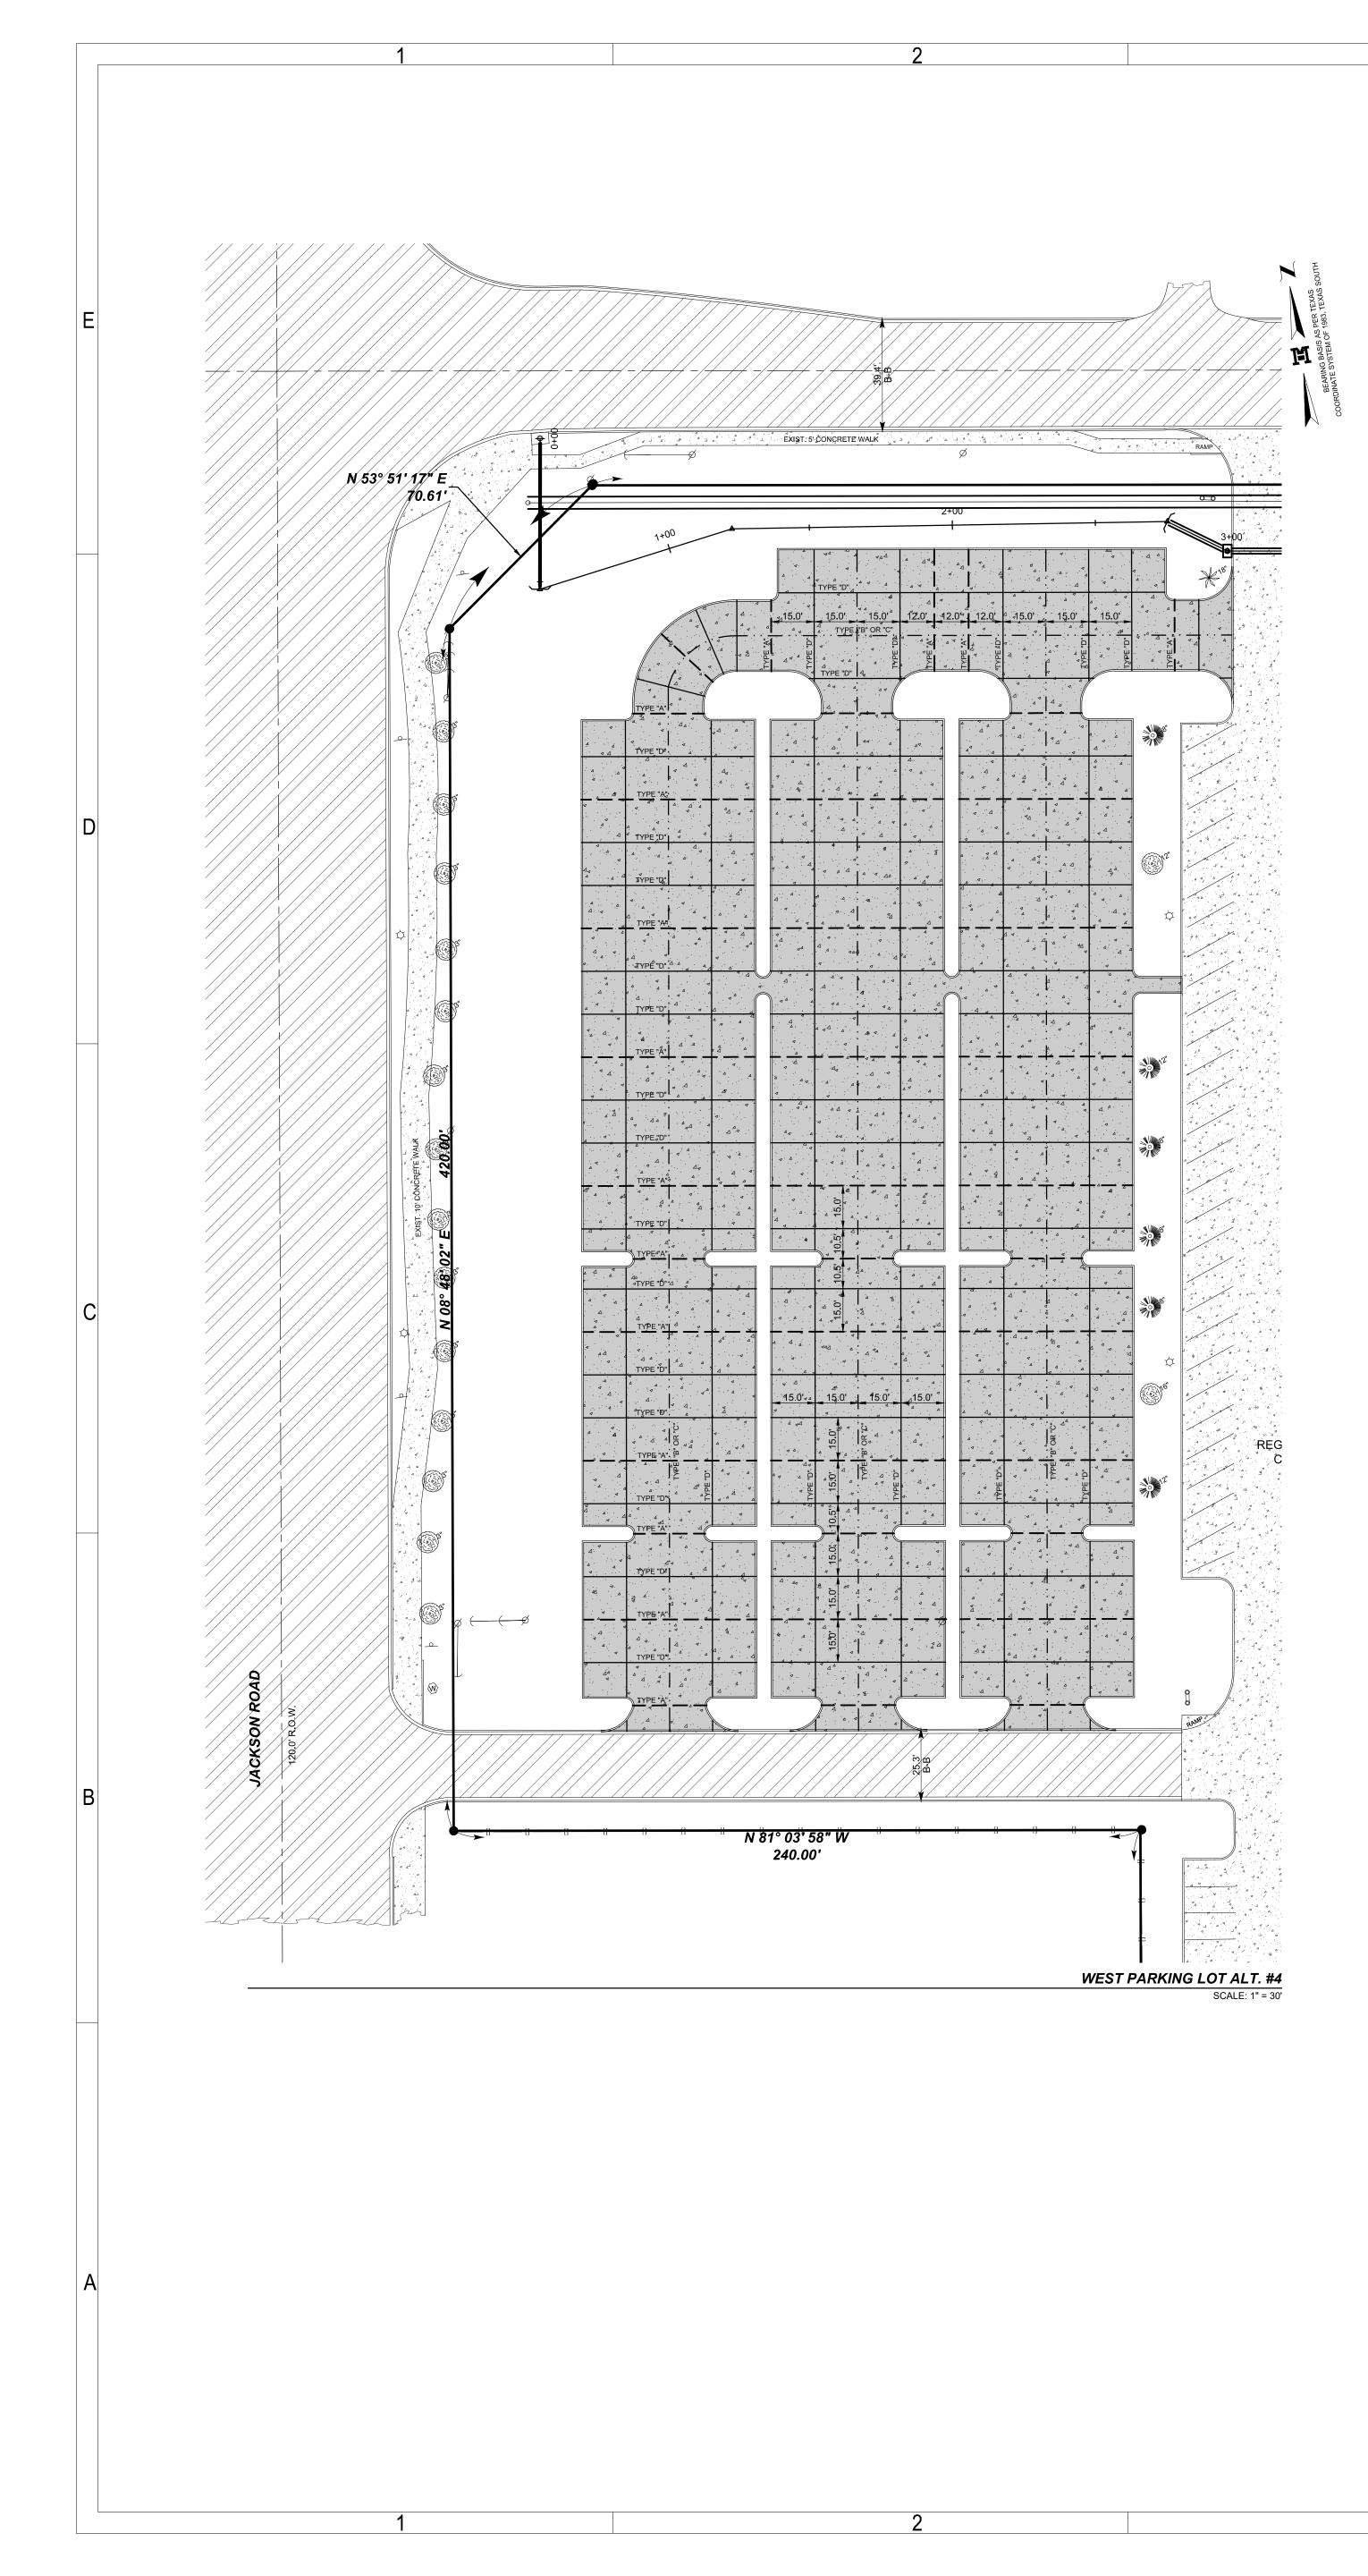

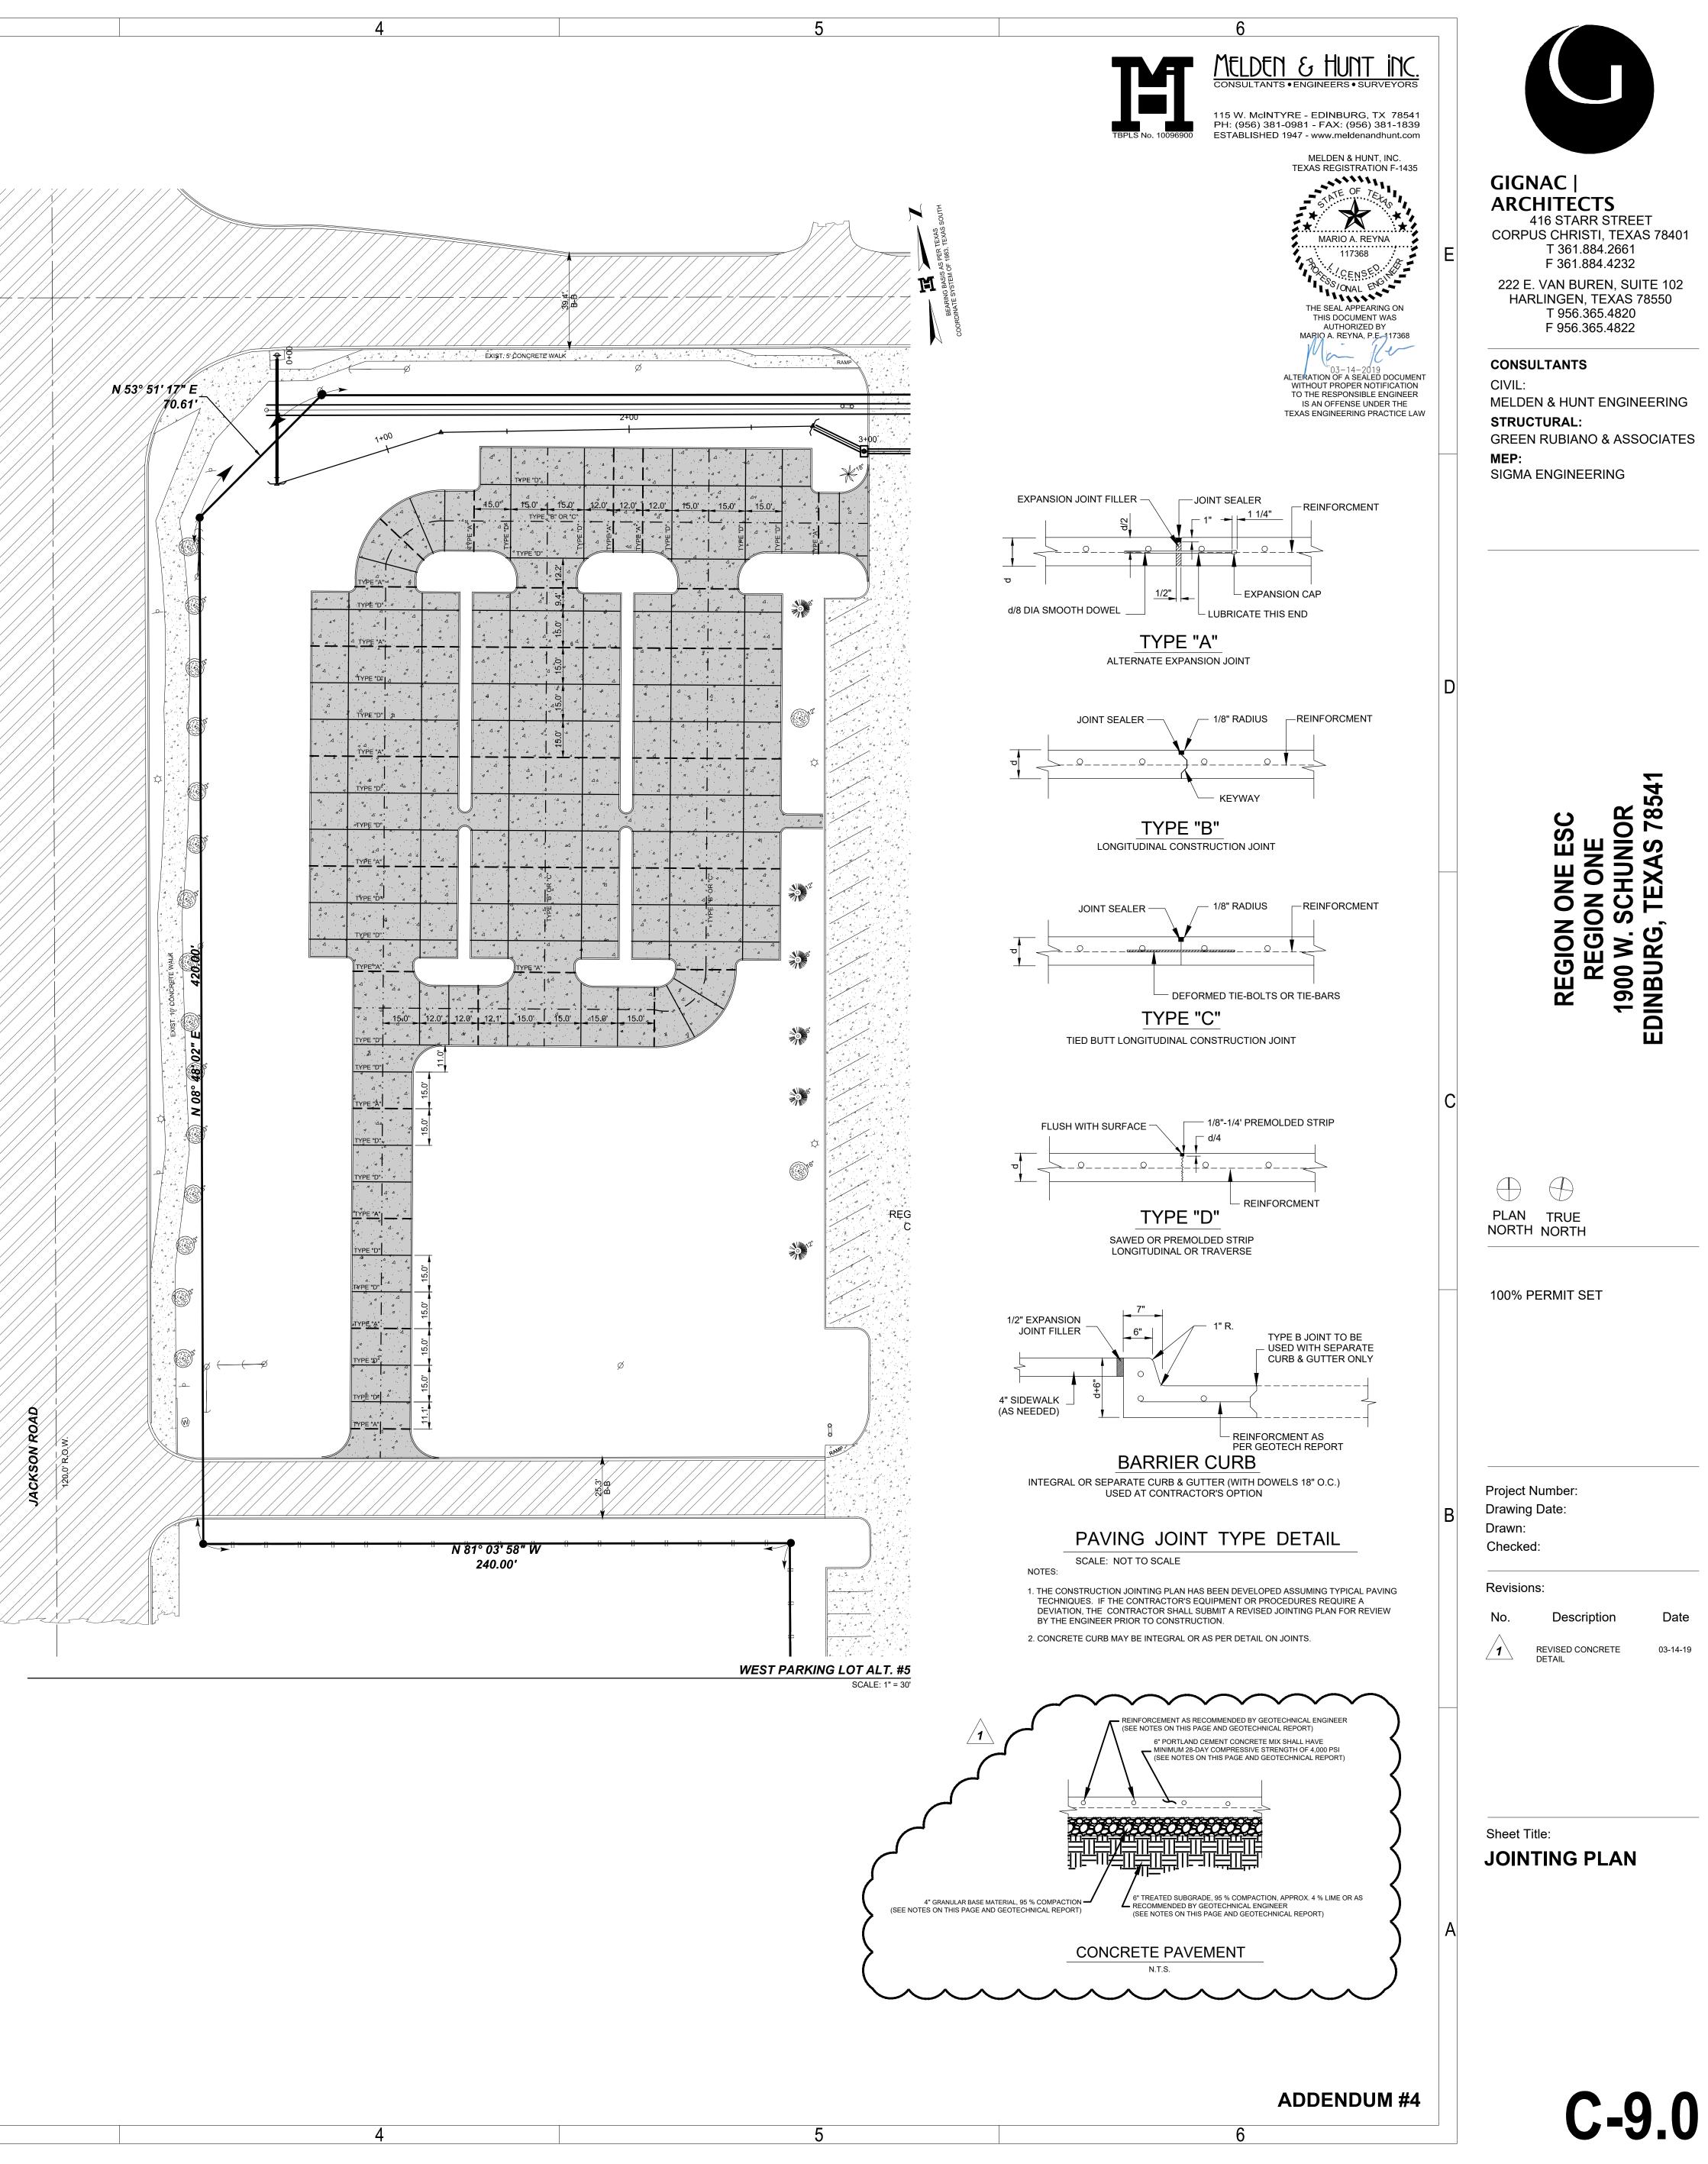


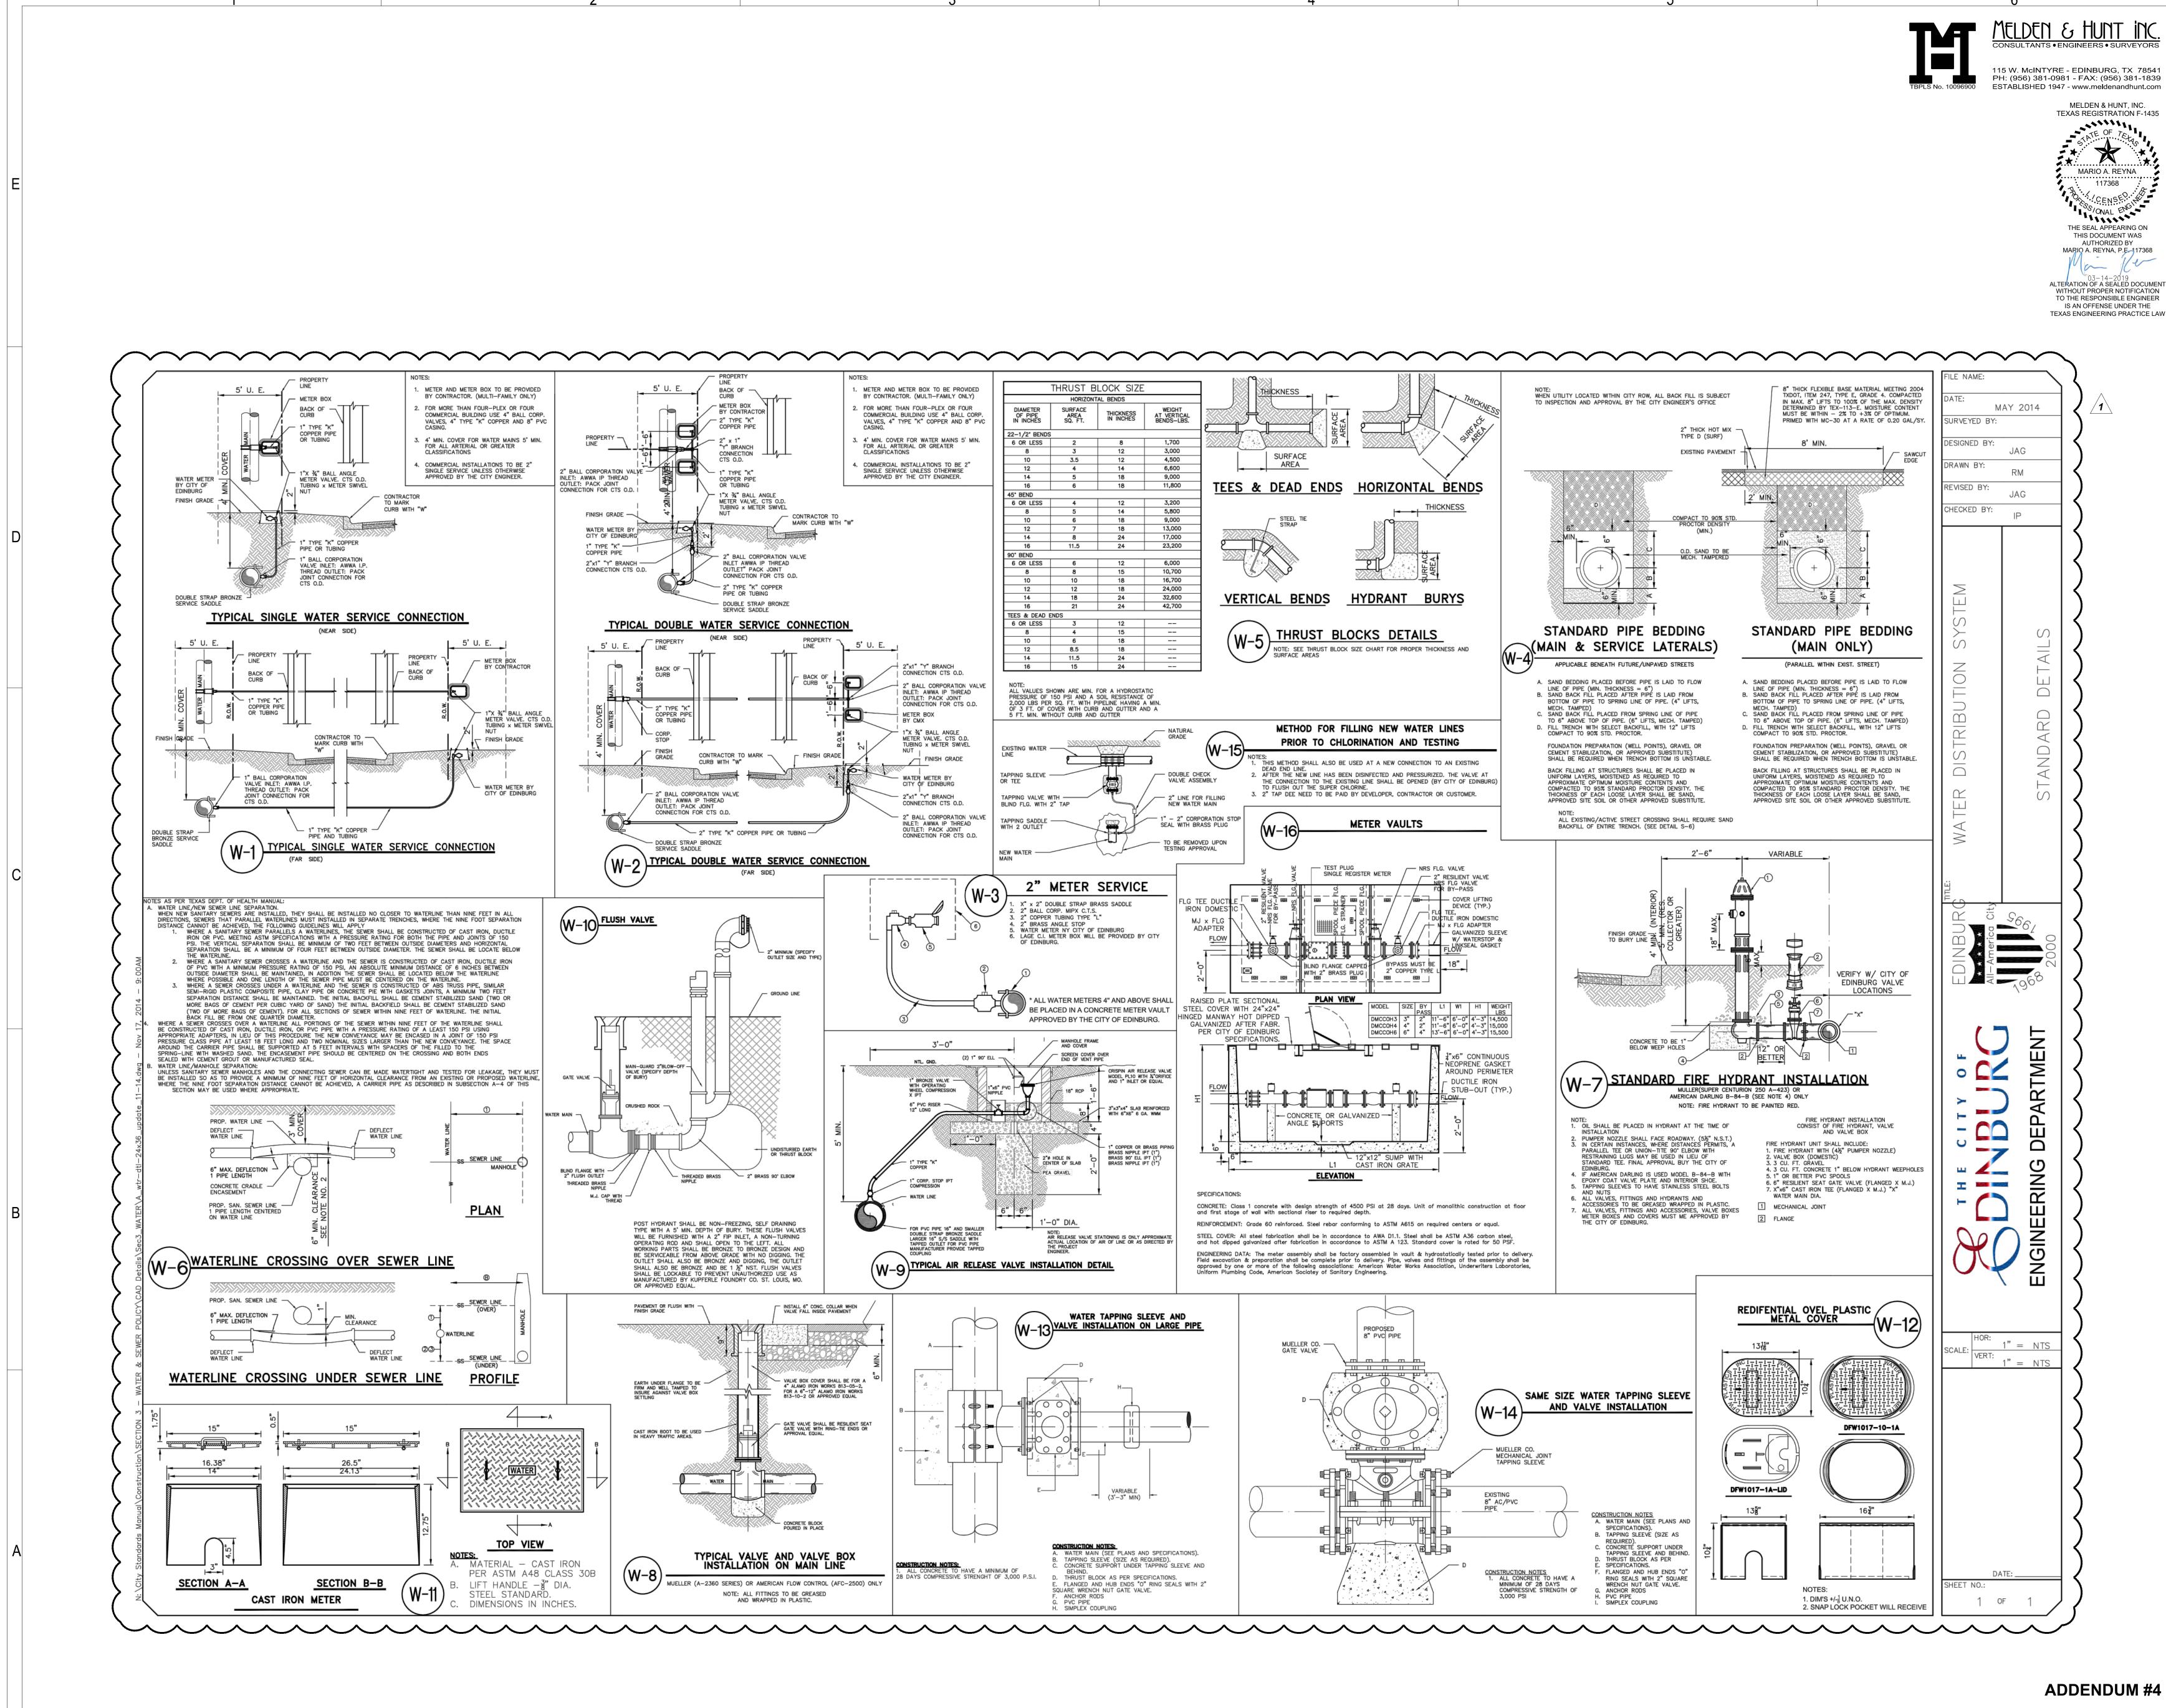


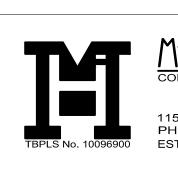


<u>Melden & Hunt inc.</u>


115 W. McINTYRE - EDINBURG, TX 78541 PH: (956) 381-0981 - FAX: (956) 381-1839

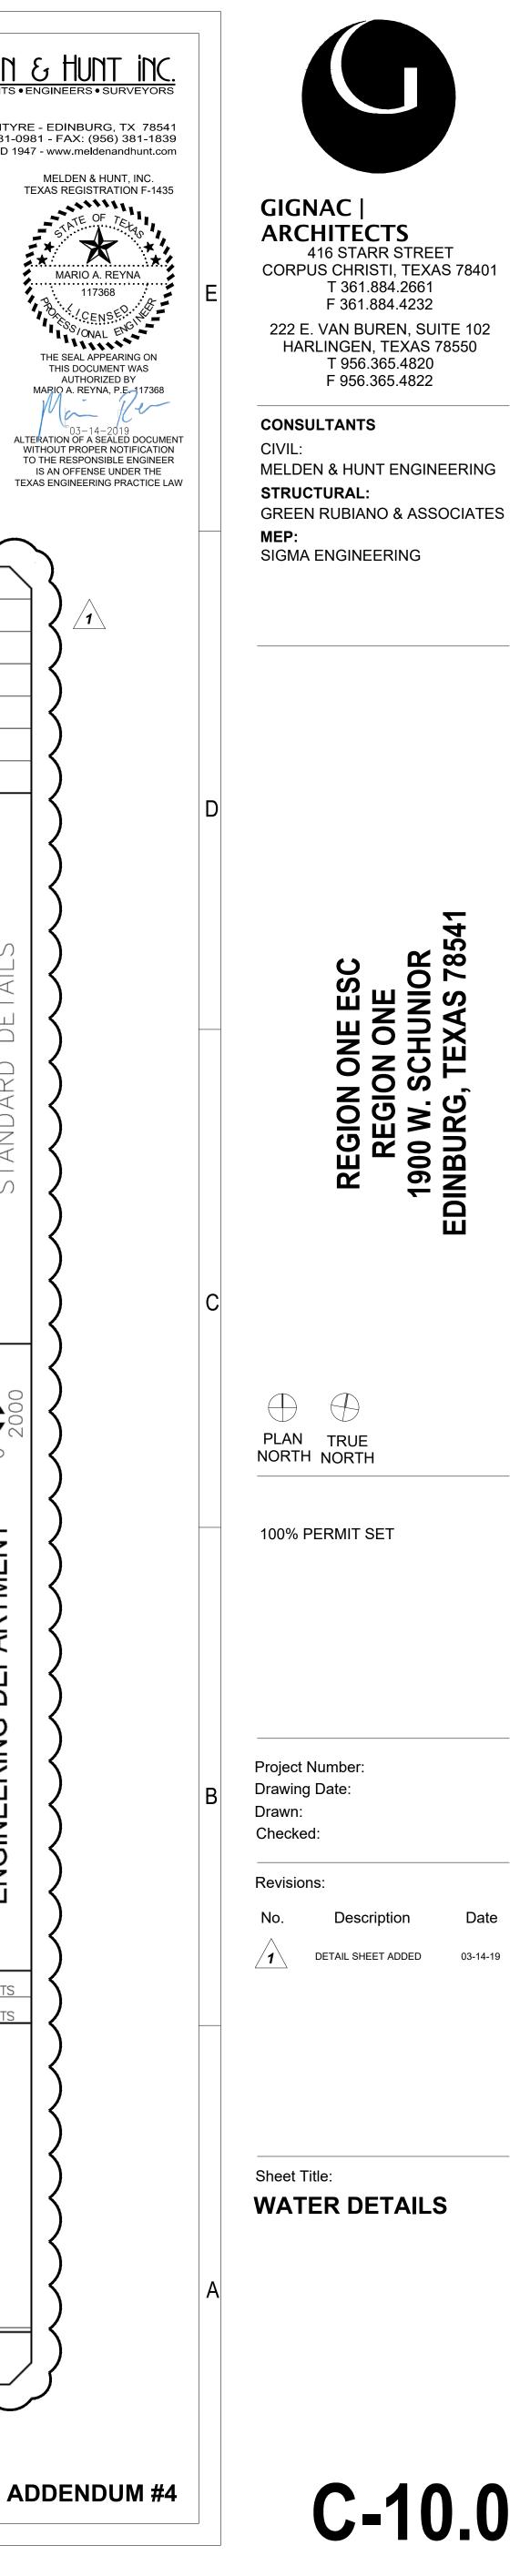

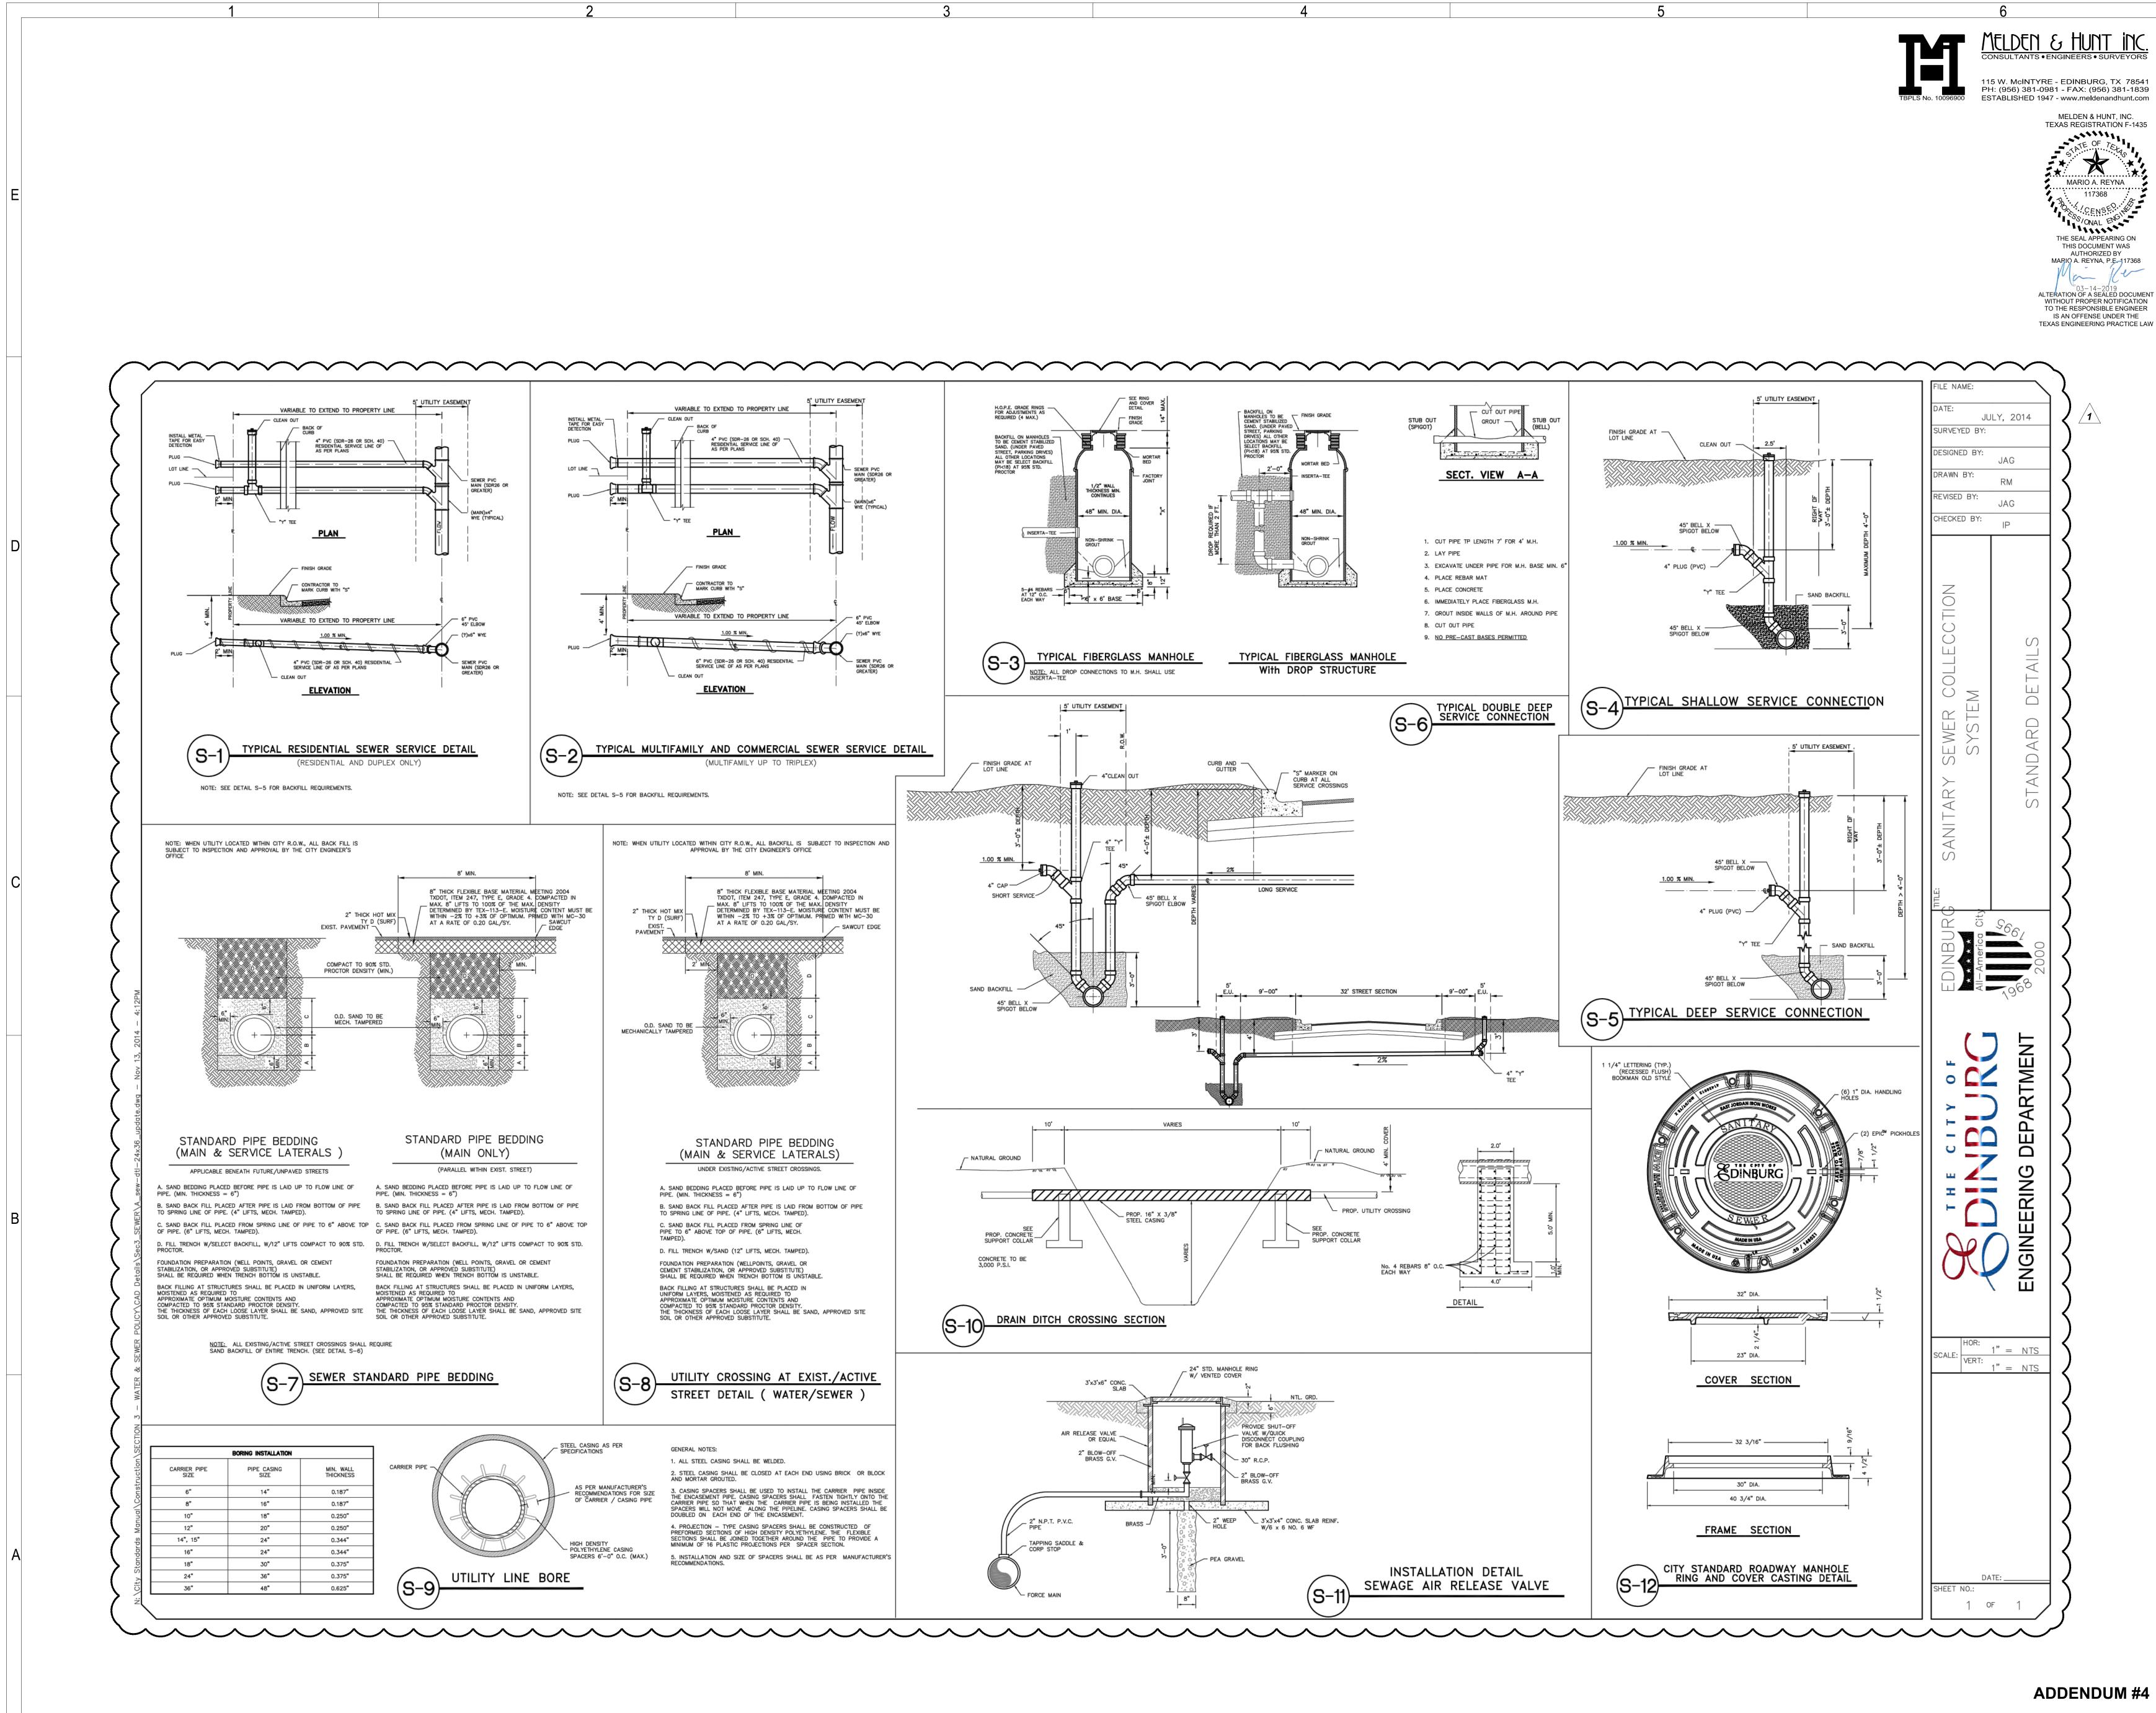



ADDENDUM #4

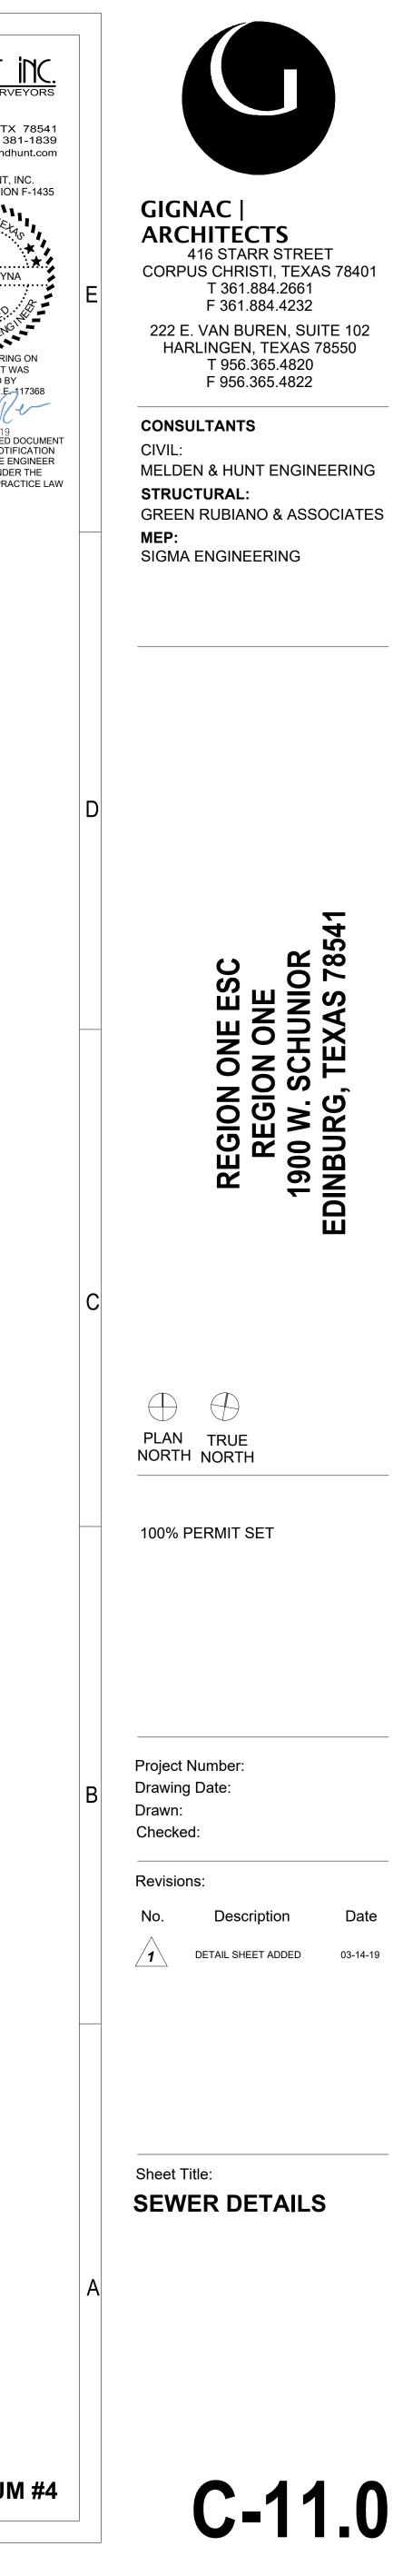


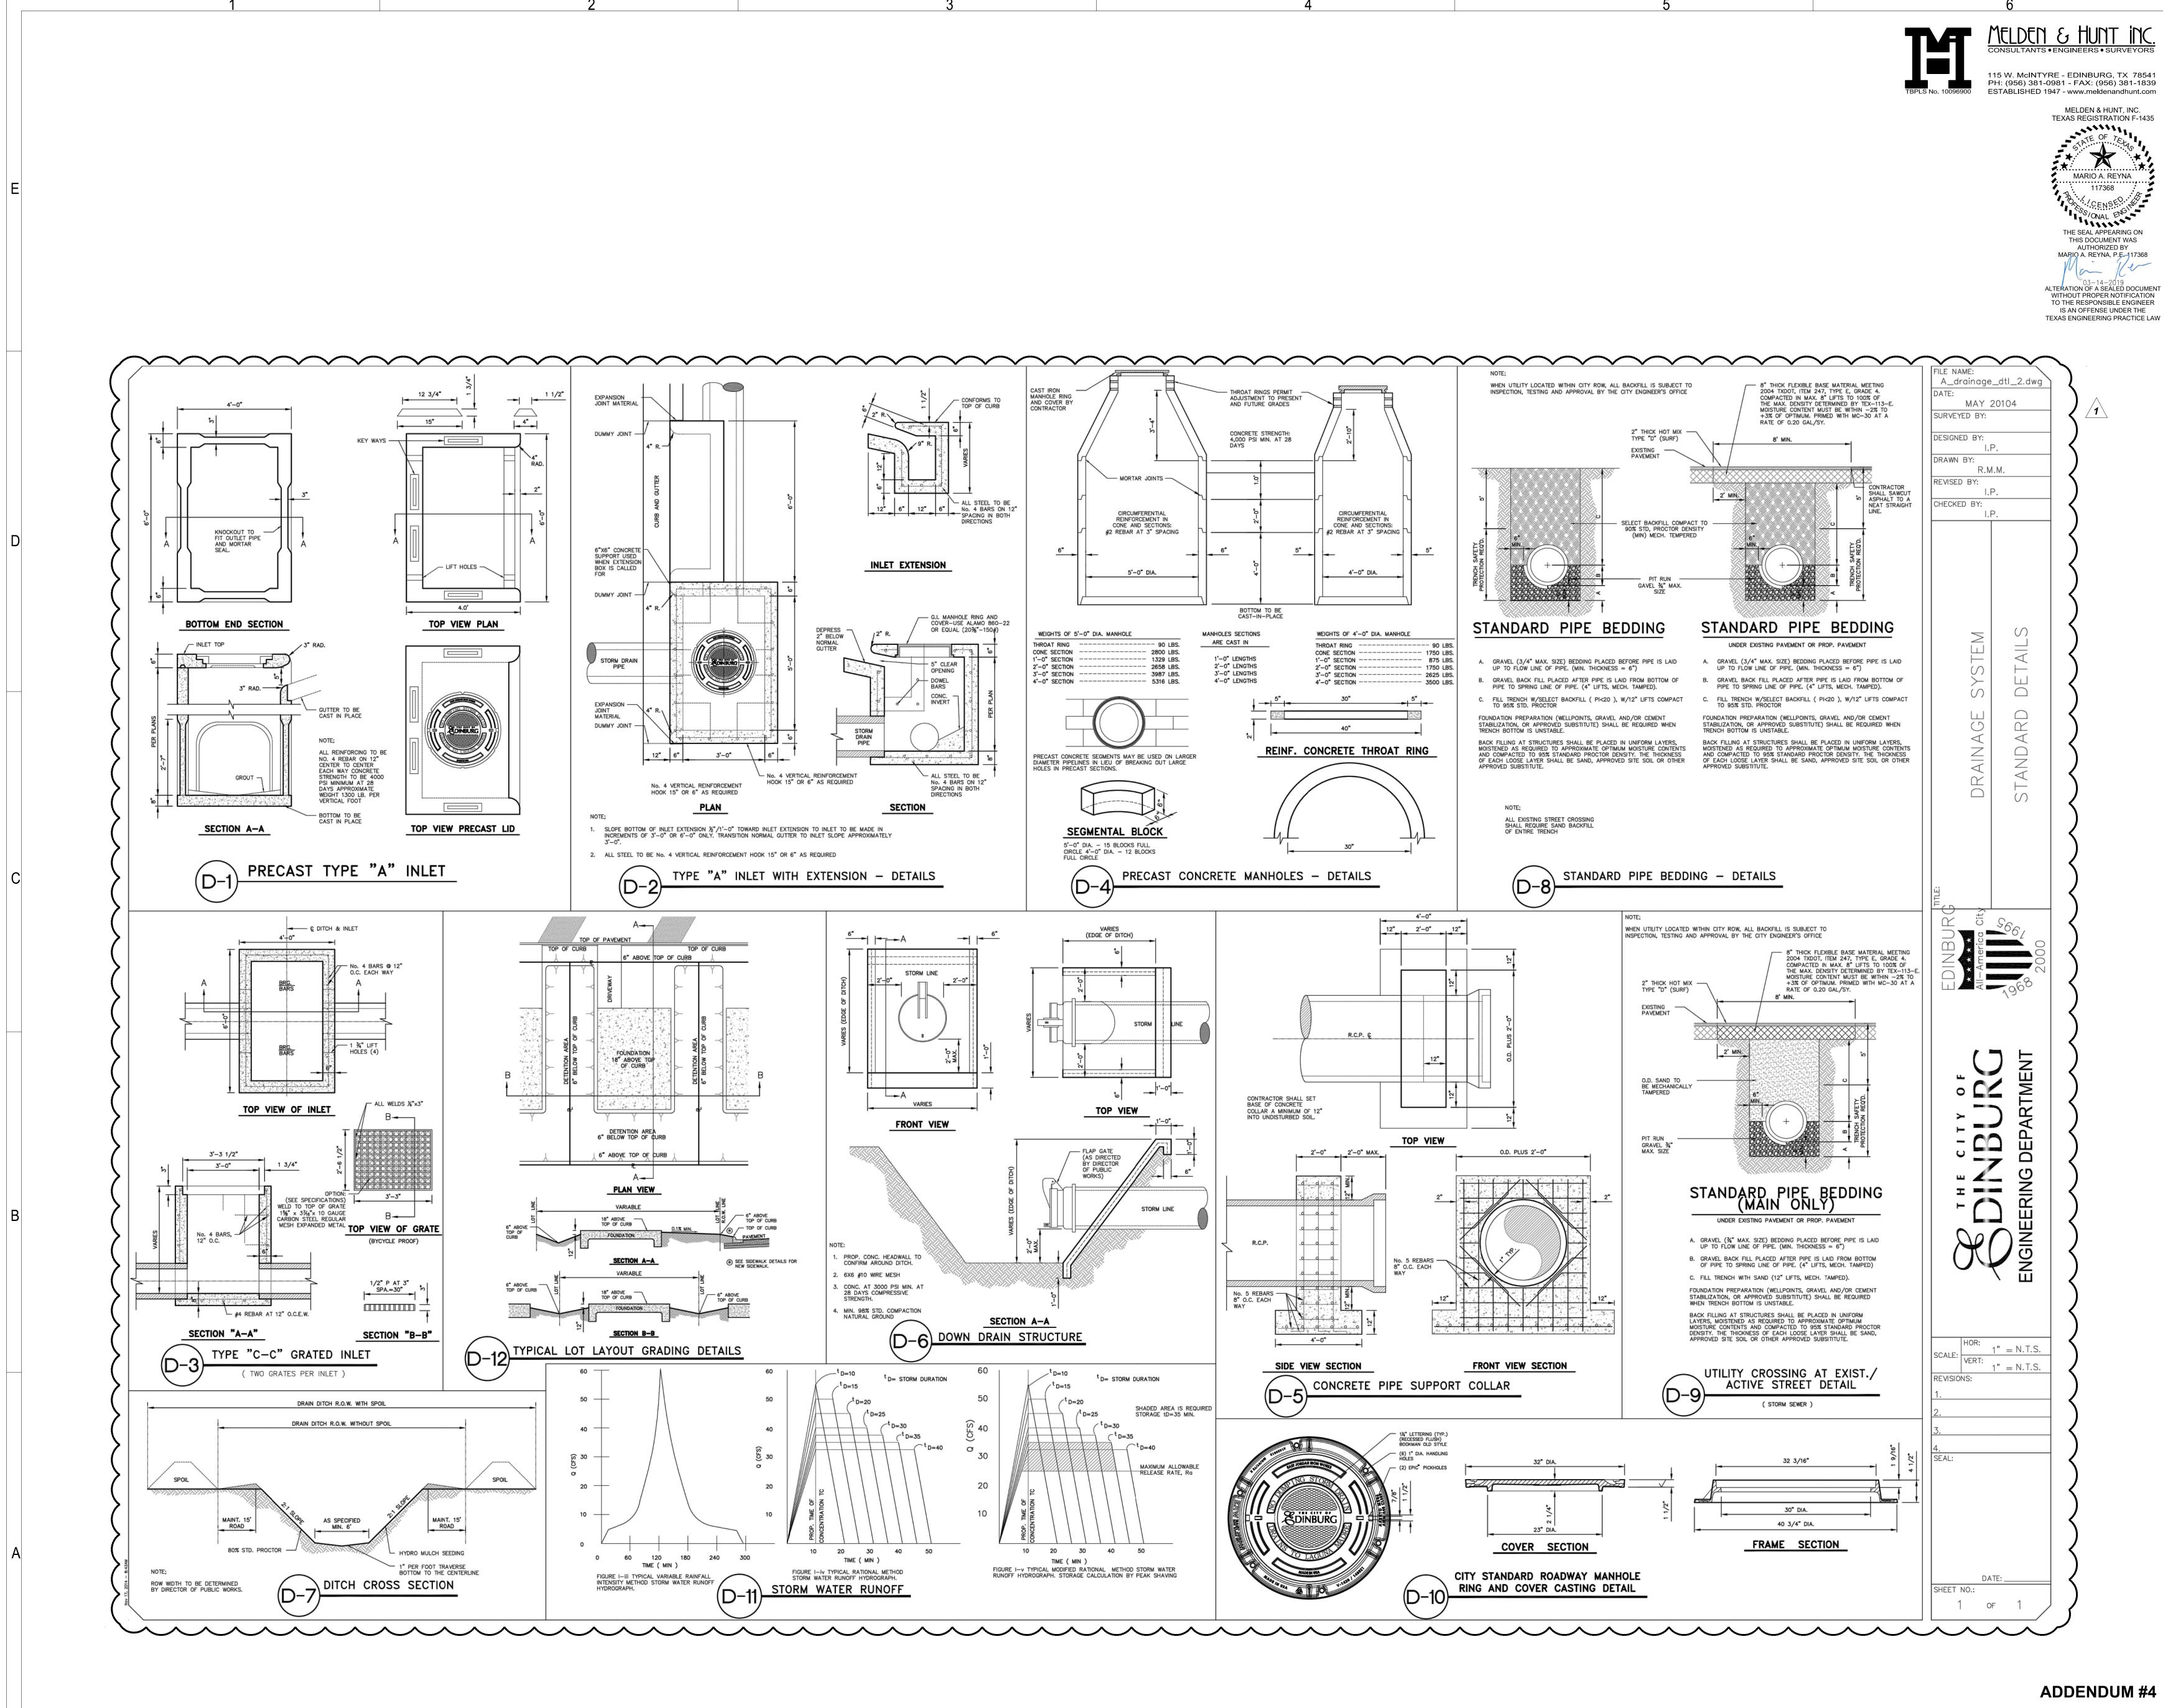


ADDENDUM #4

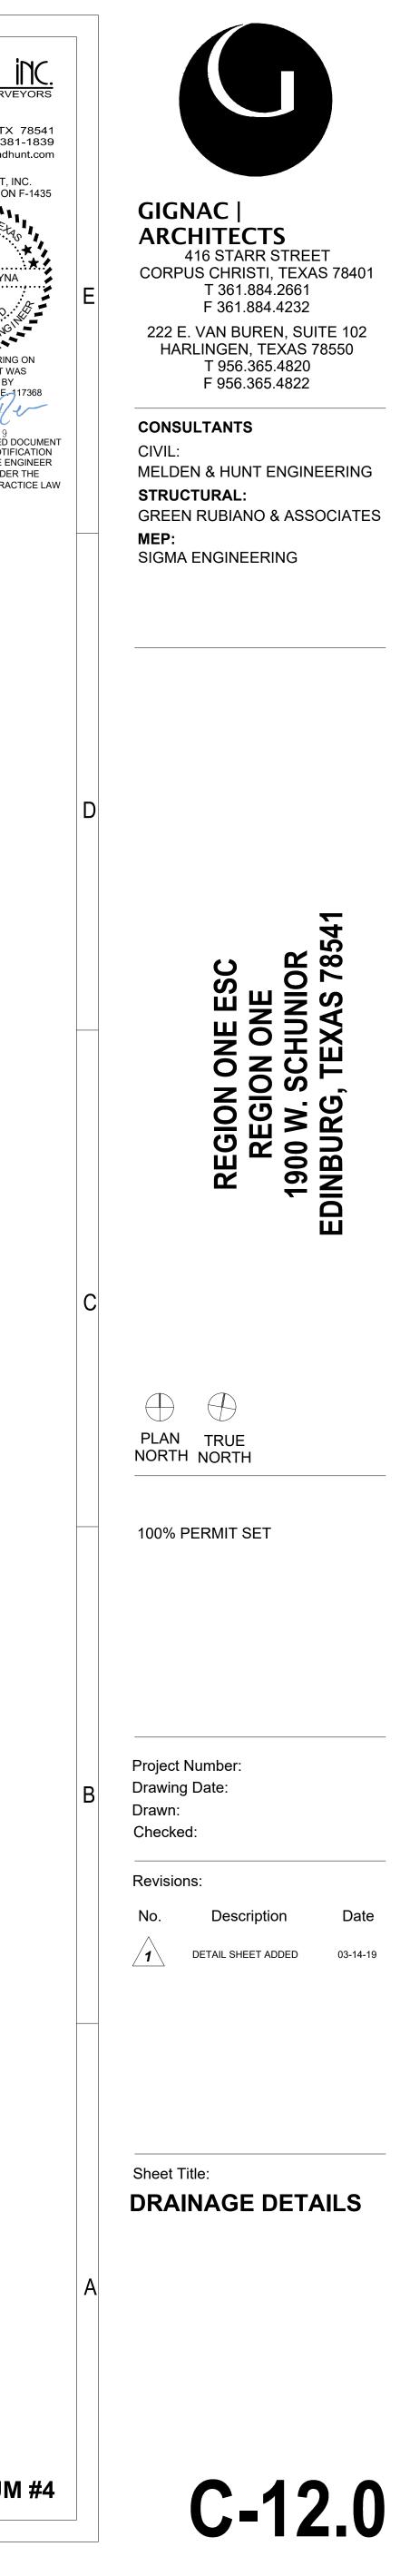

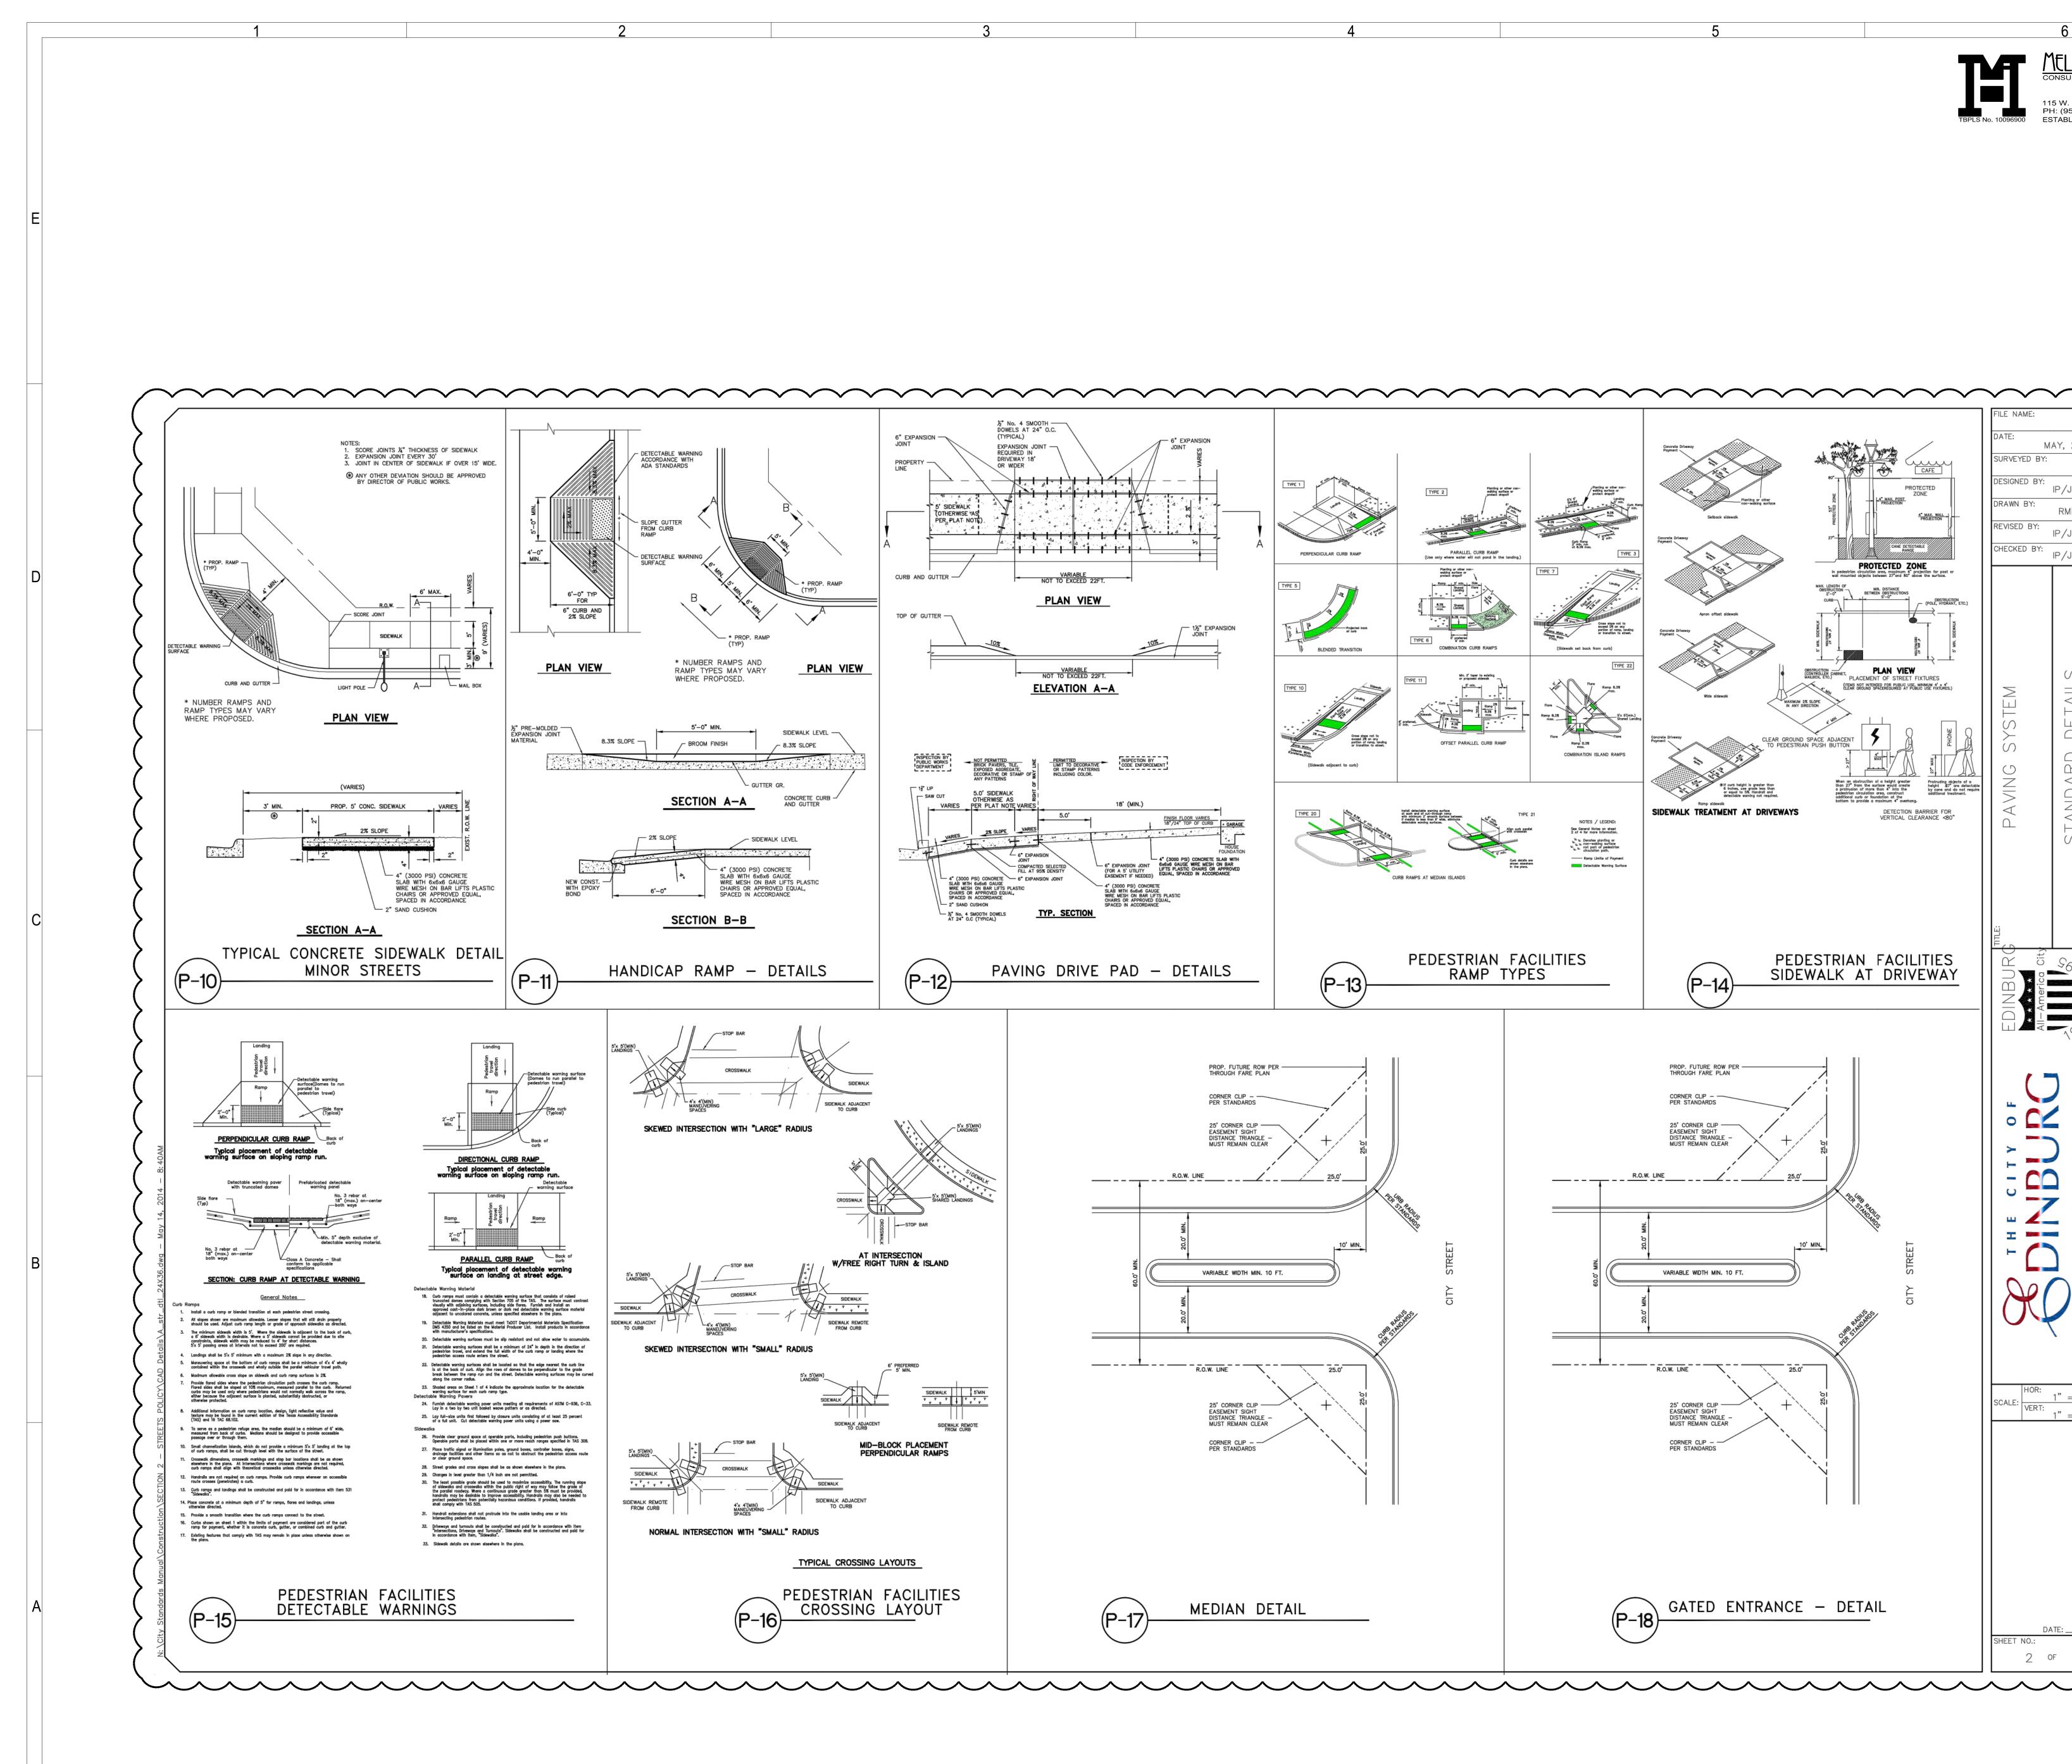


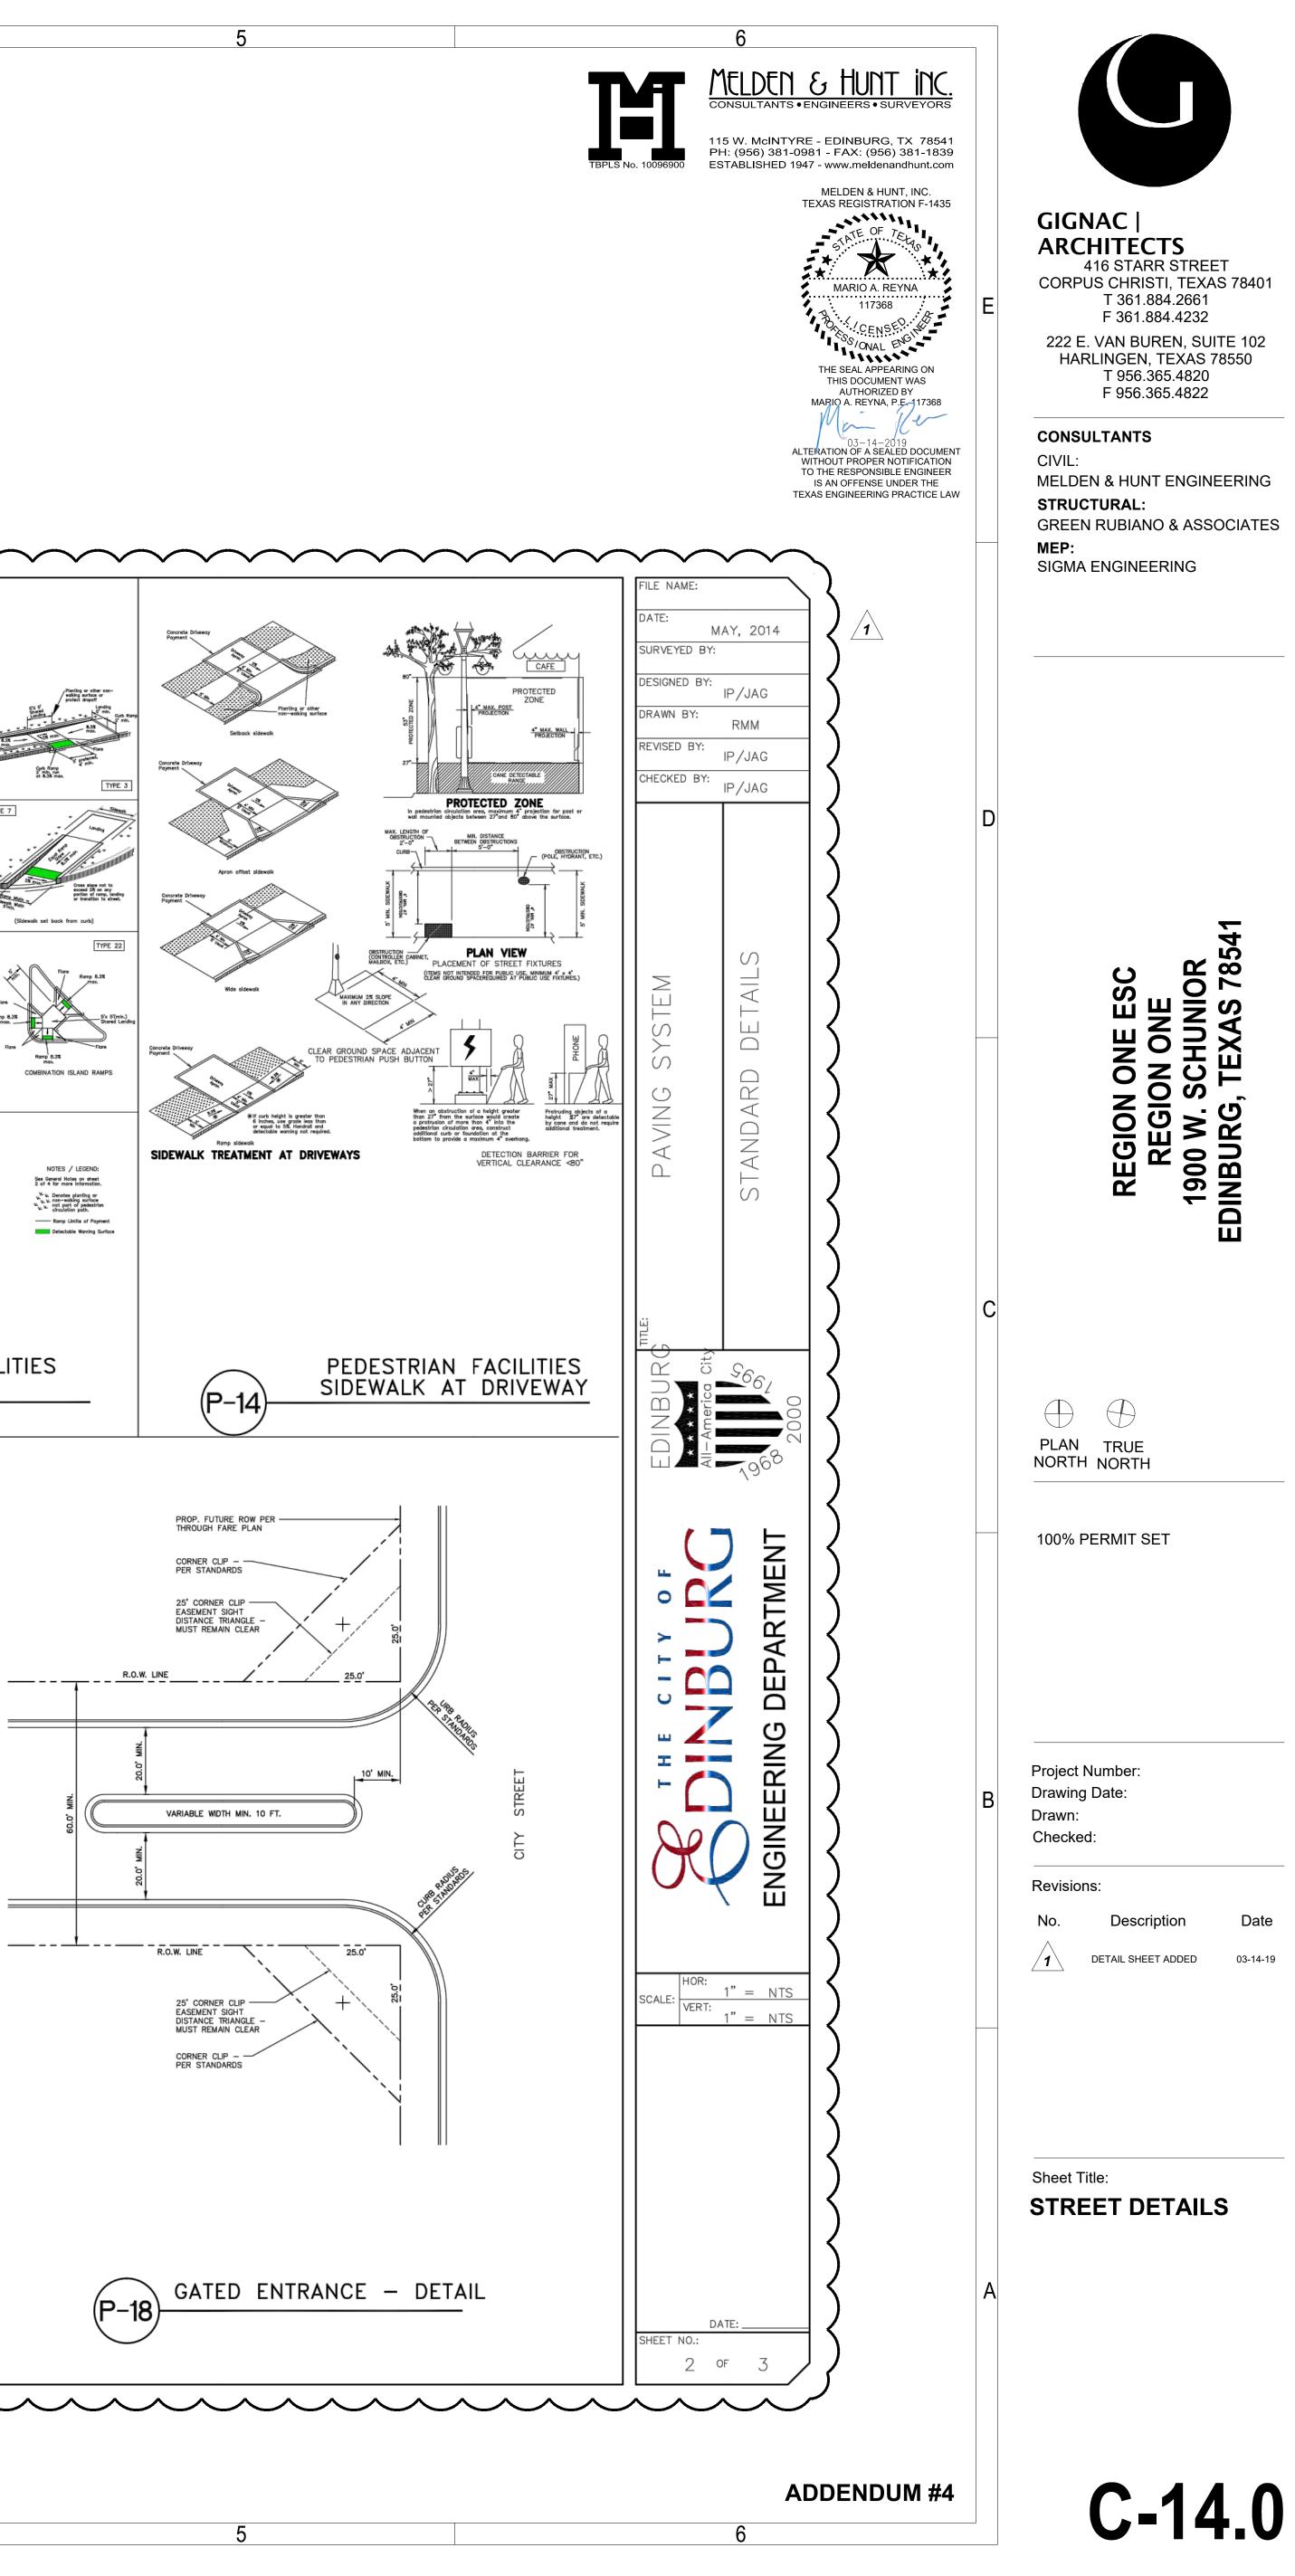



Sidespik Wath

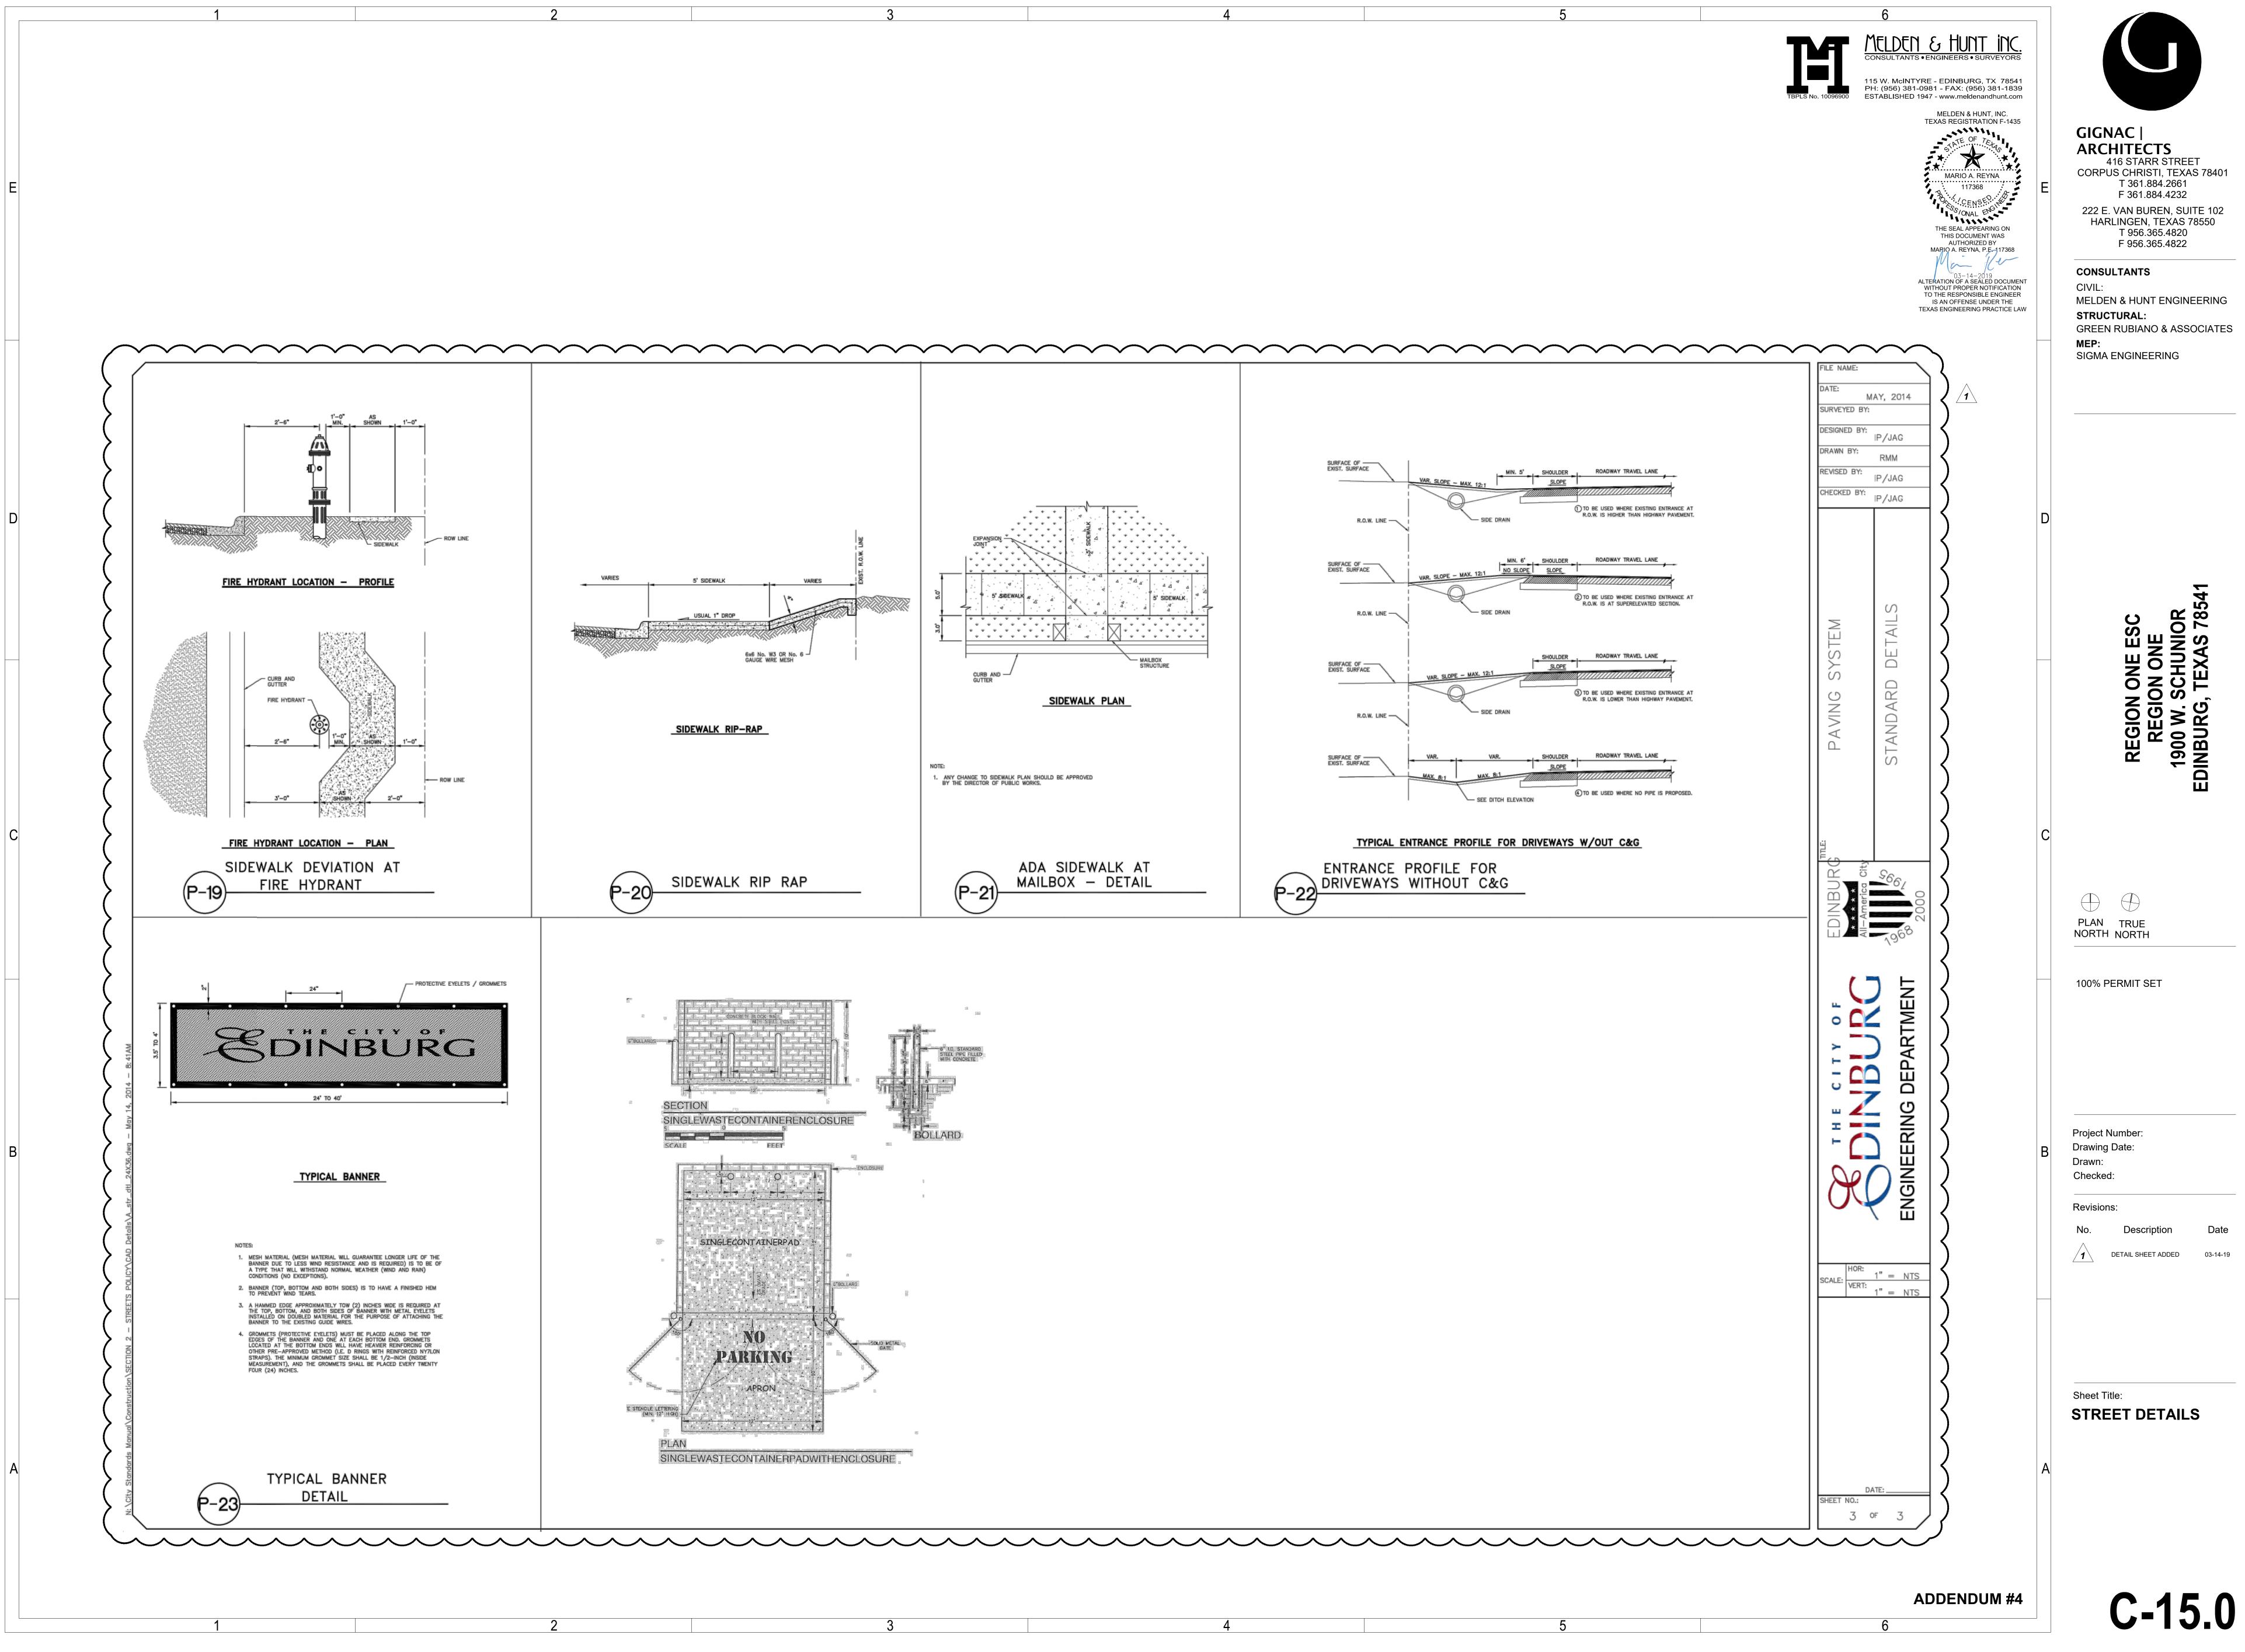




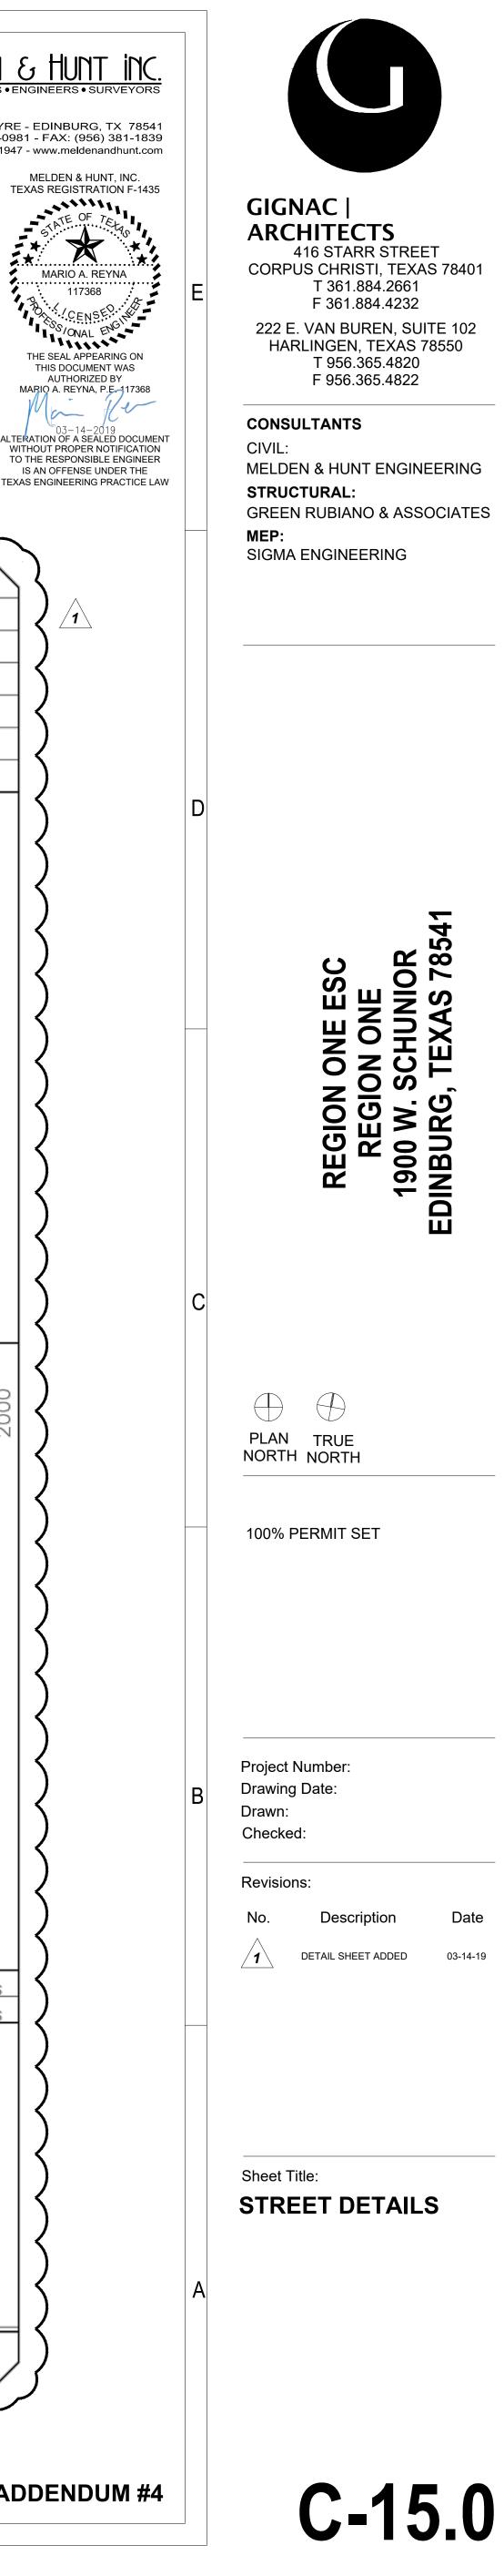

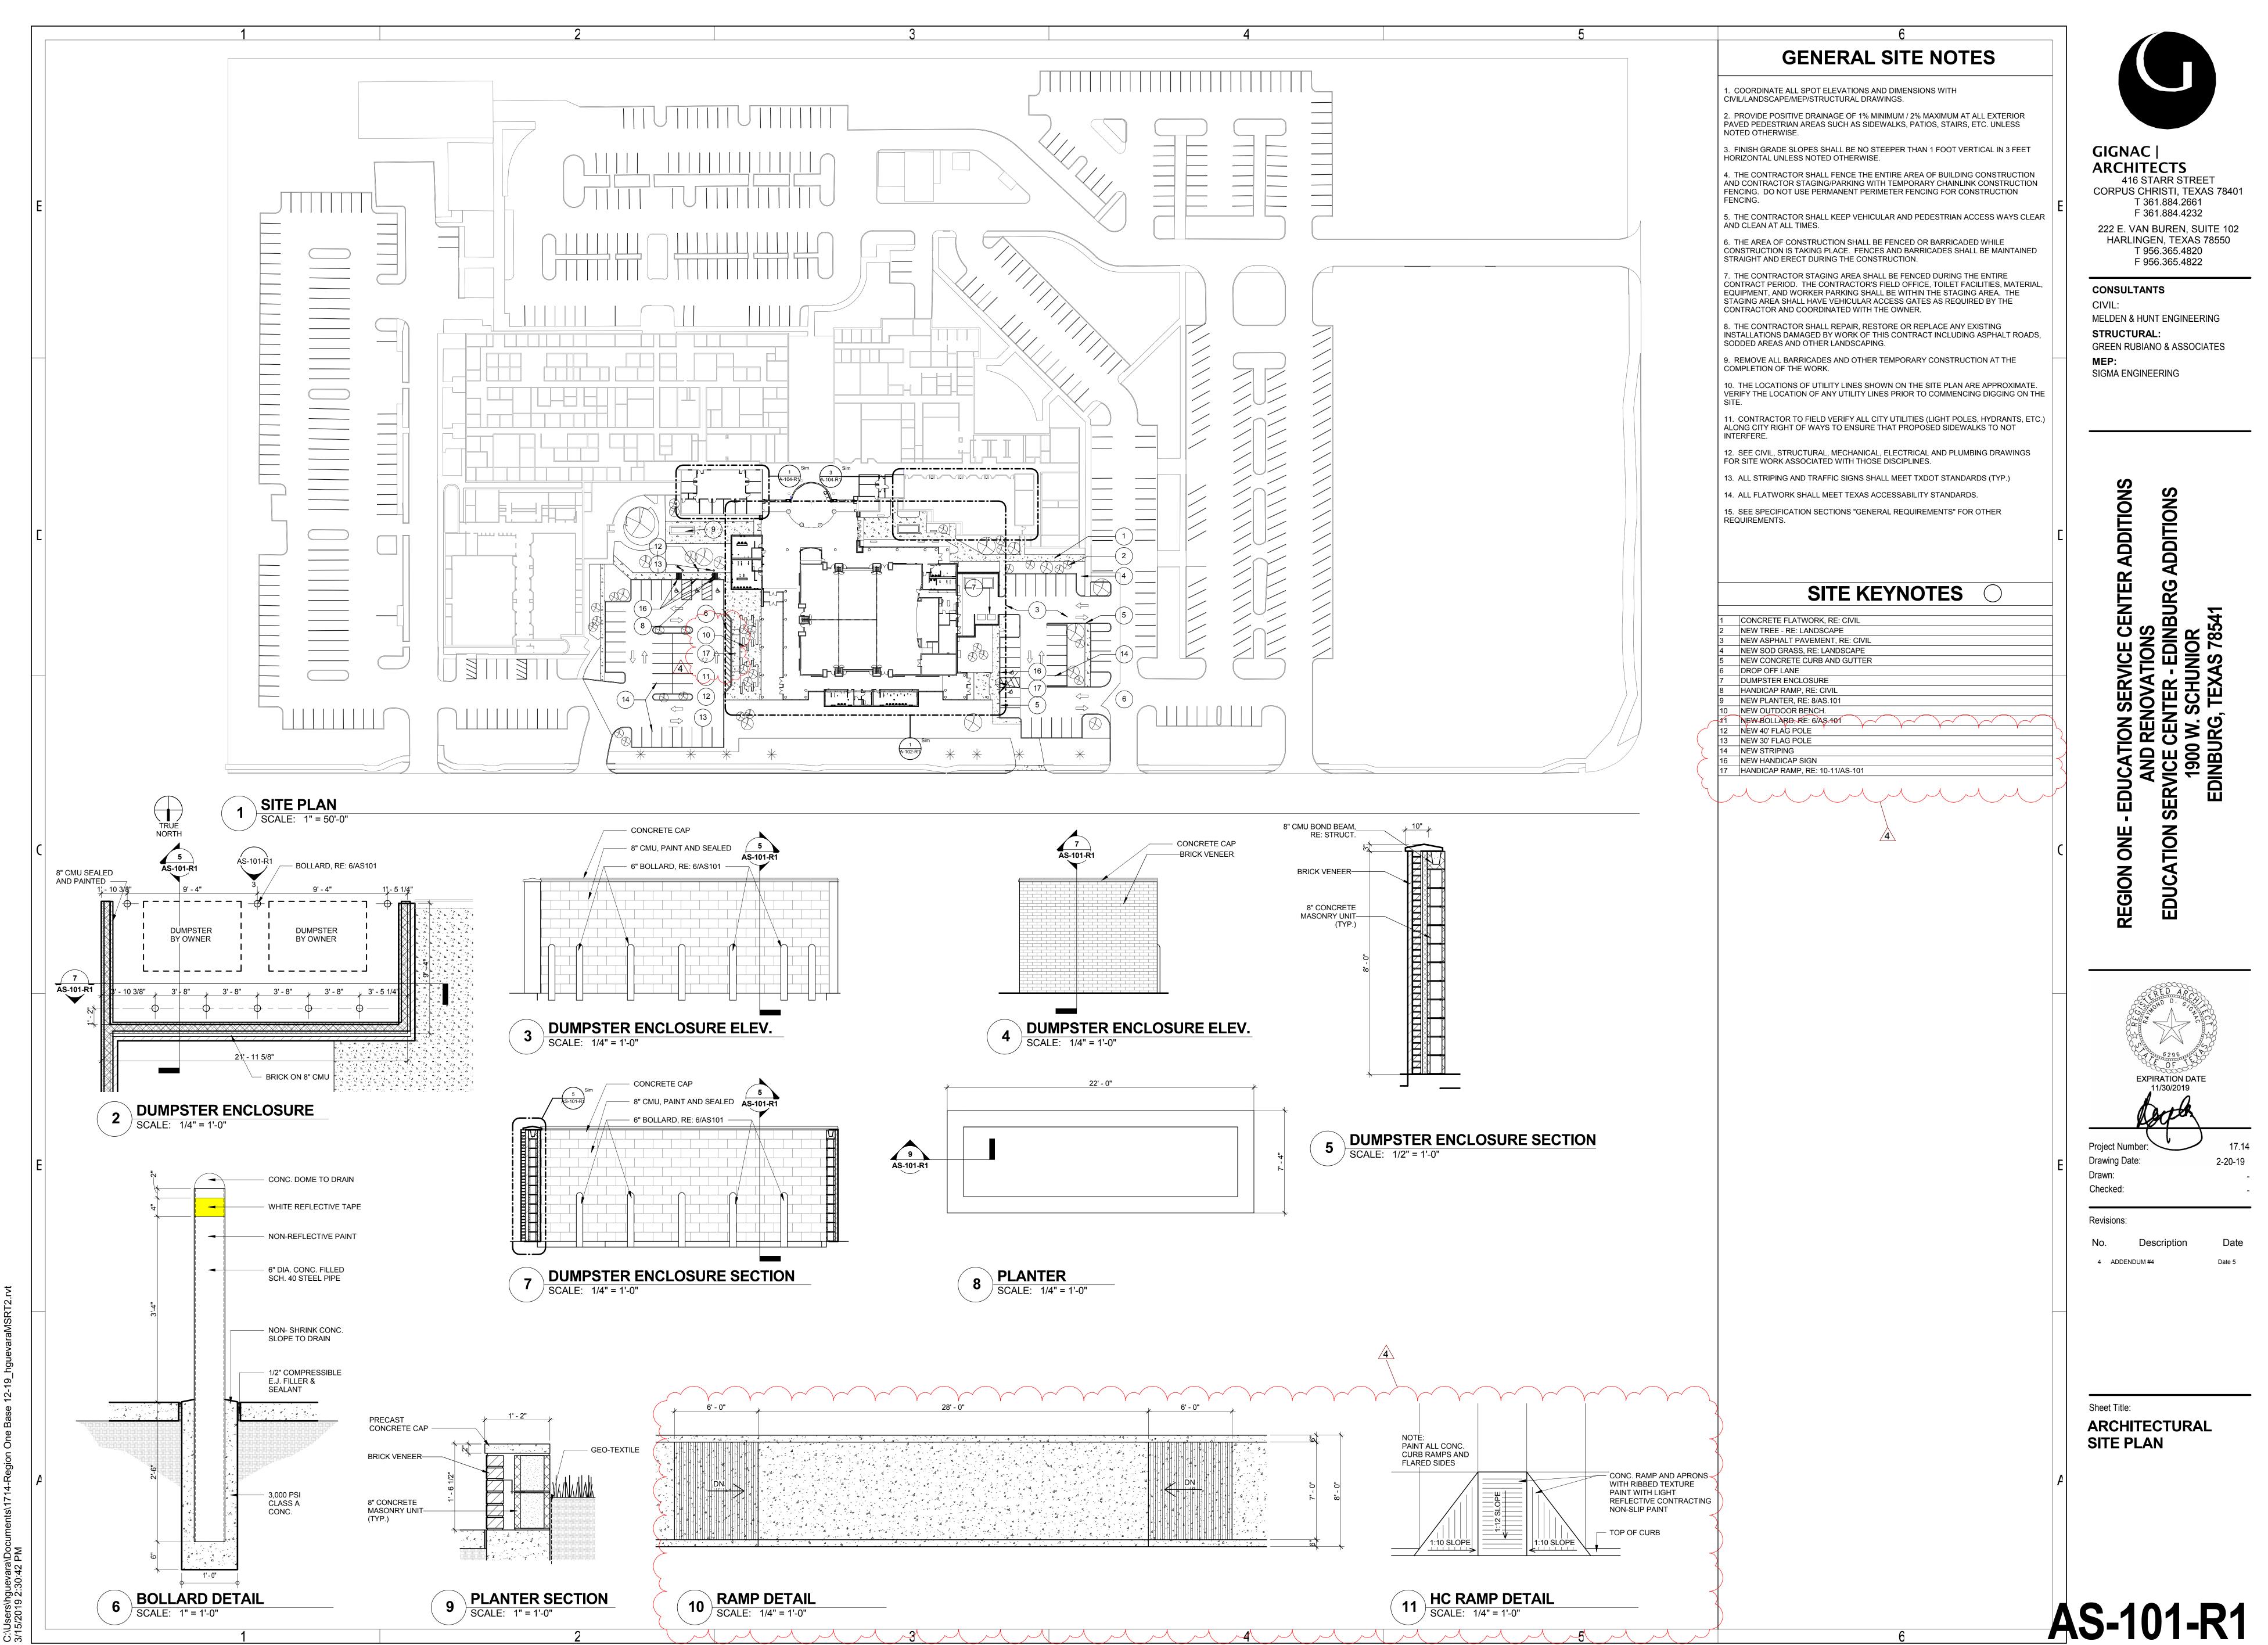

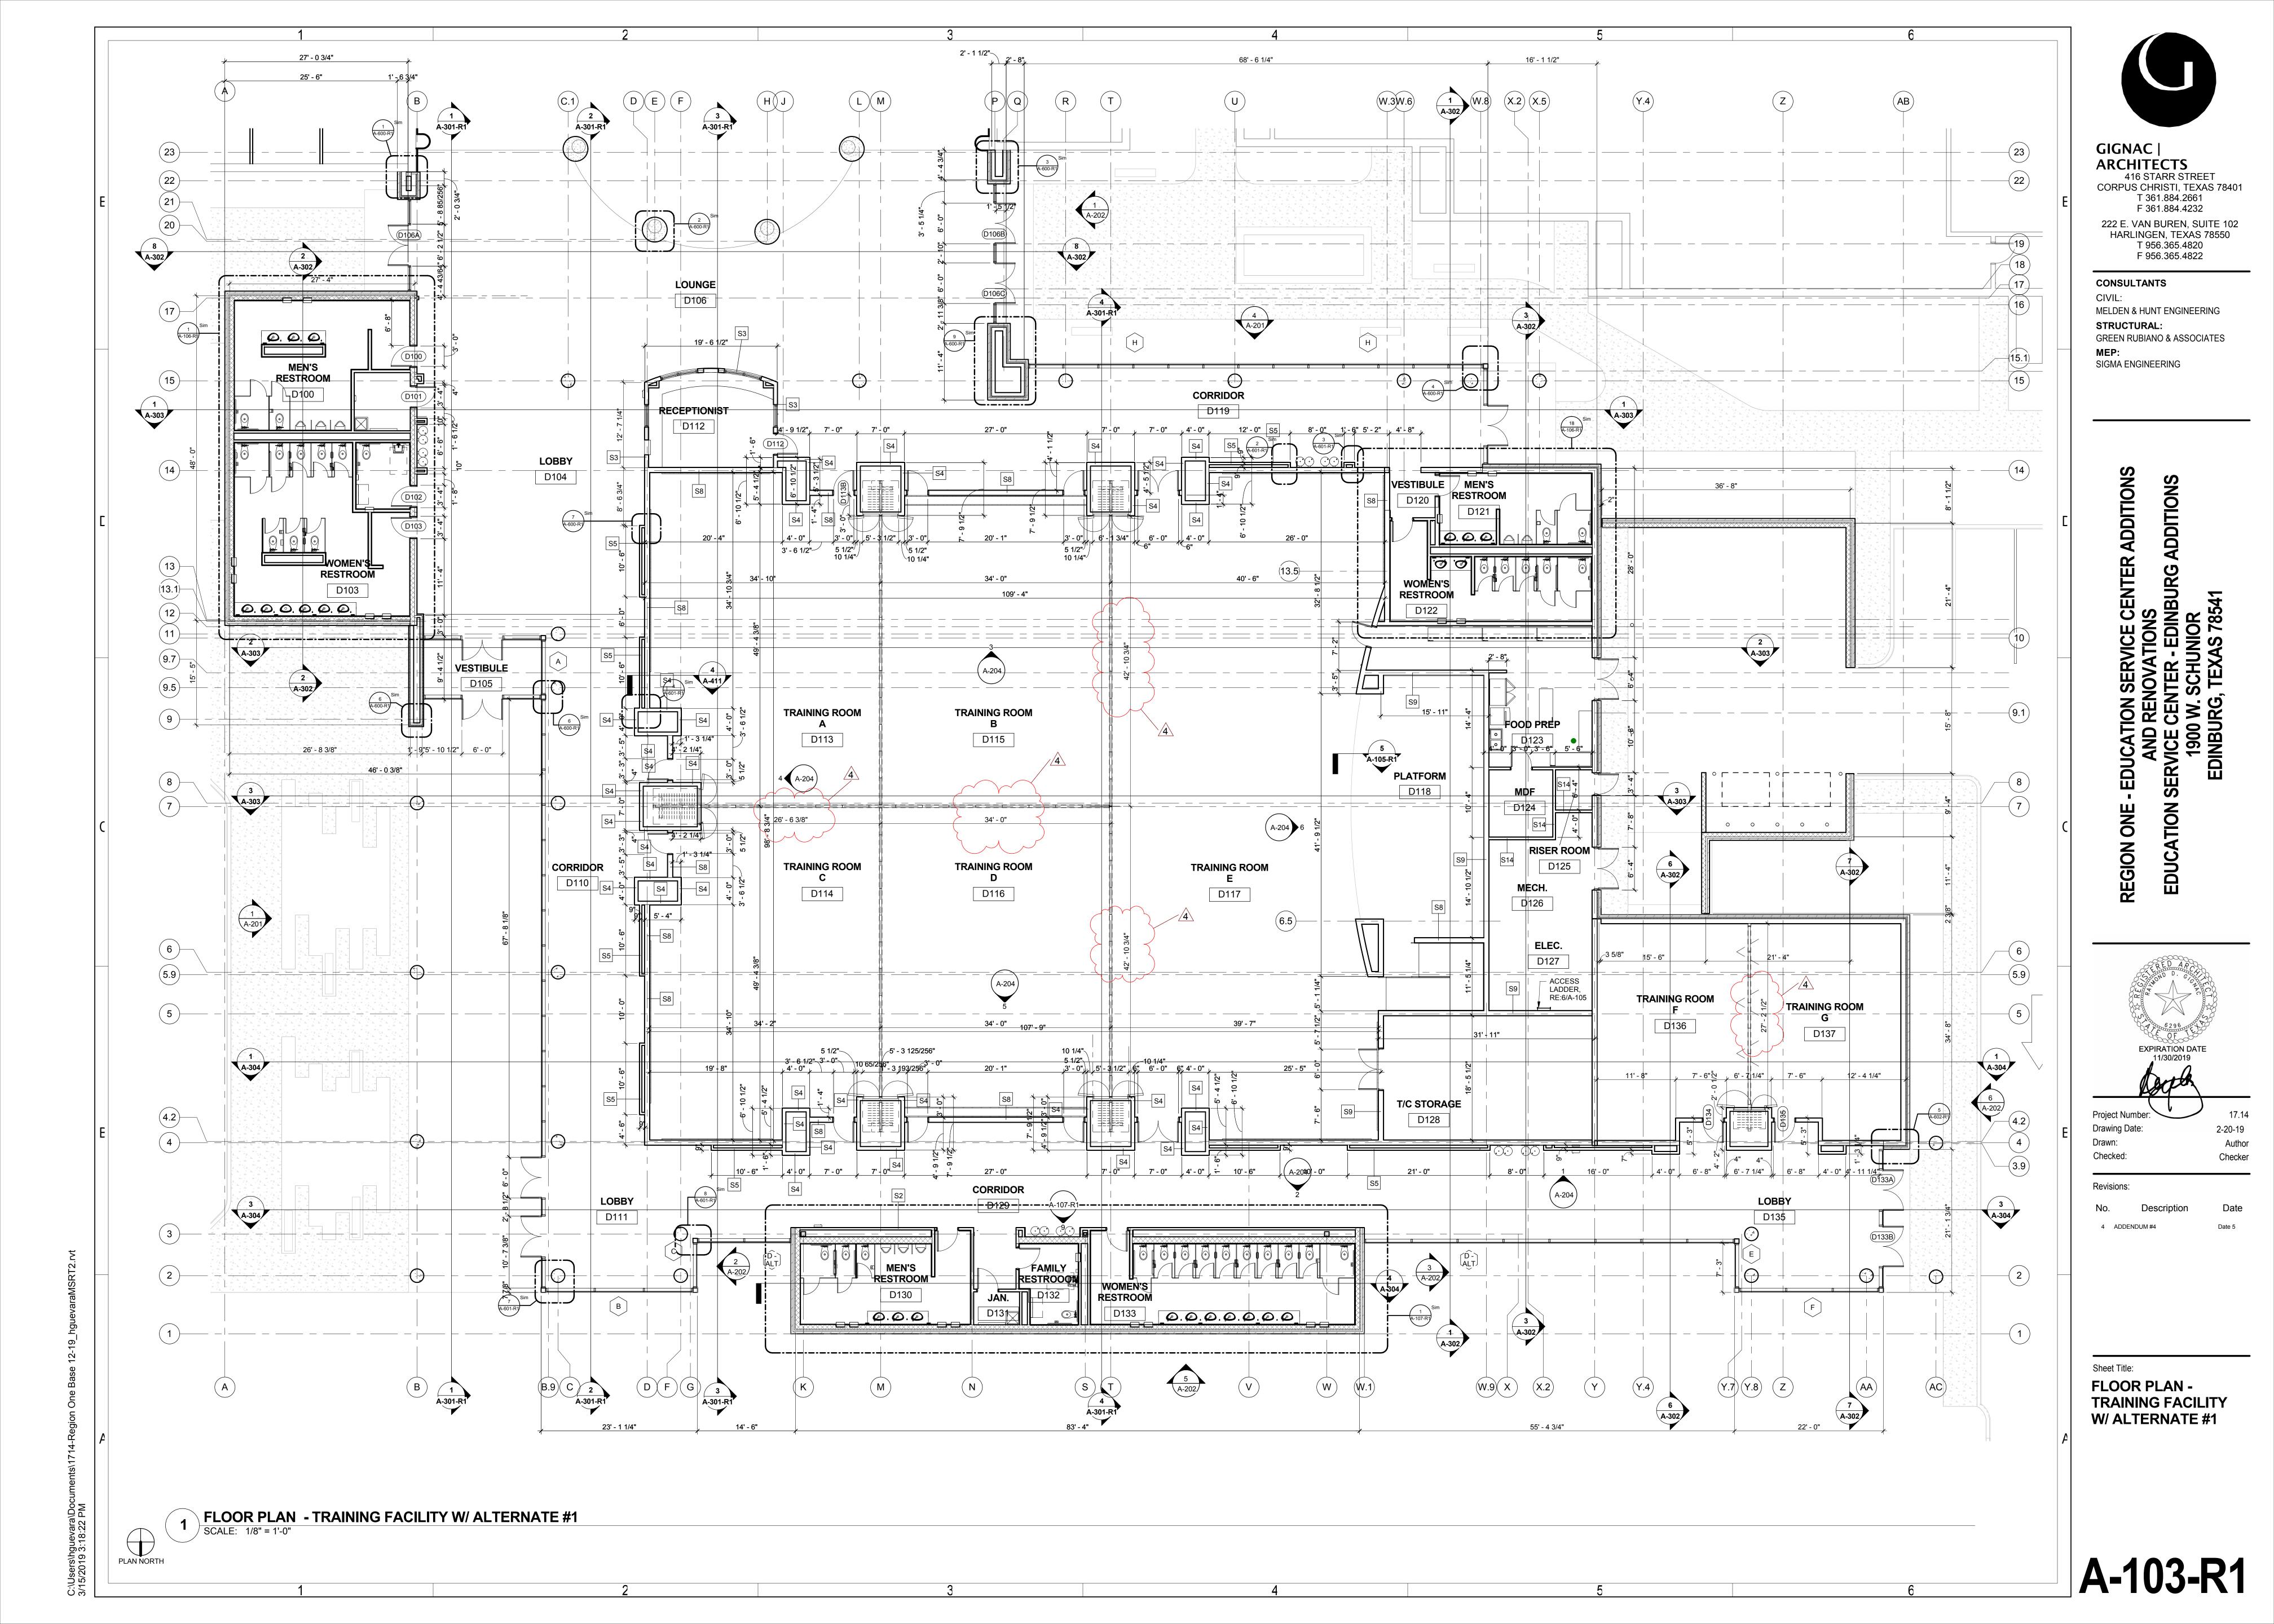

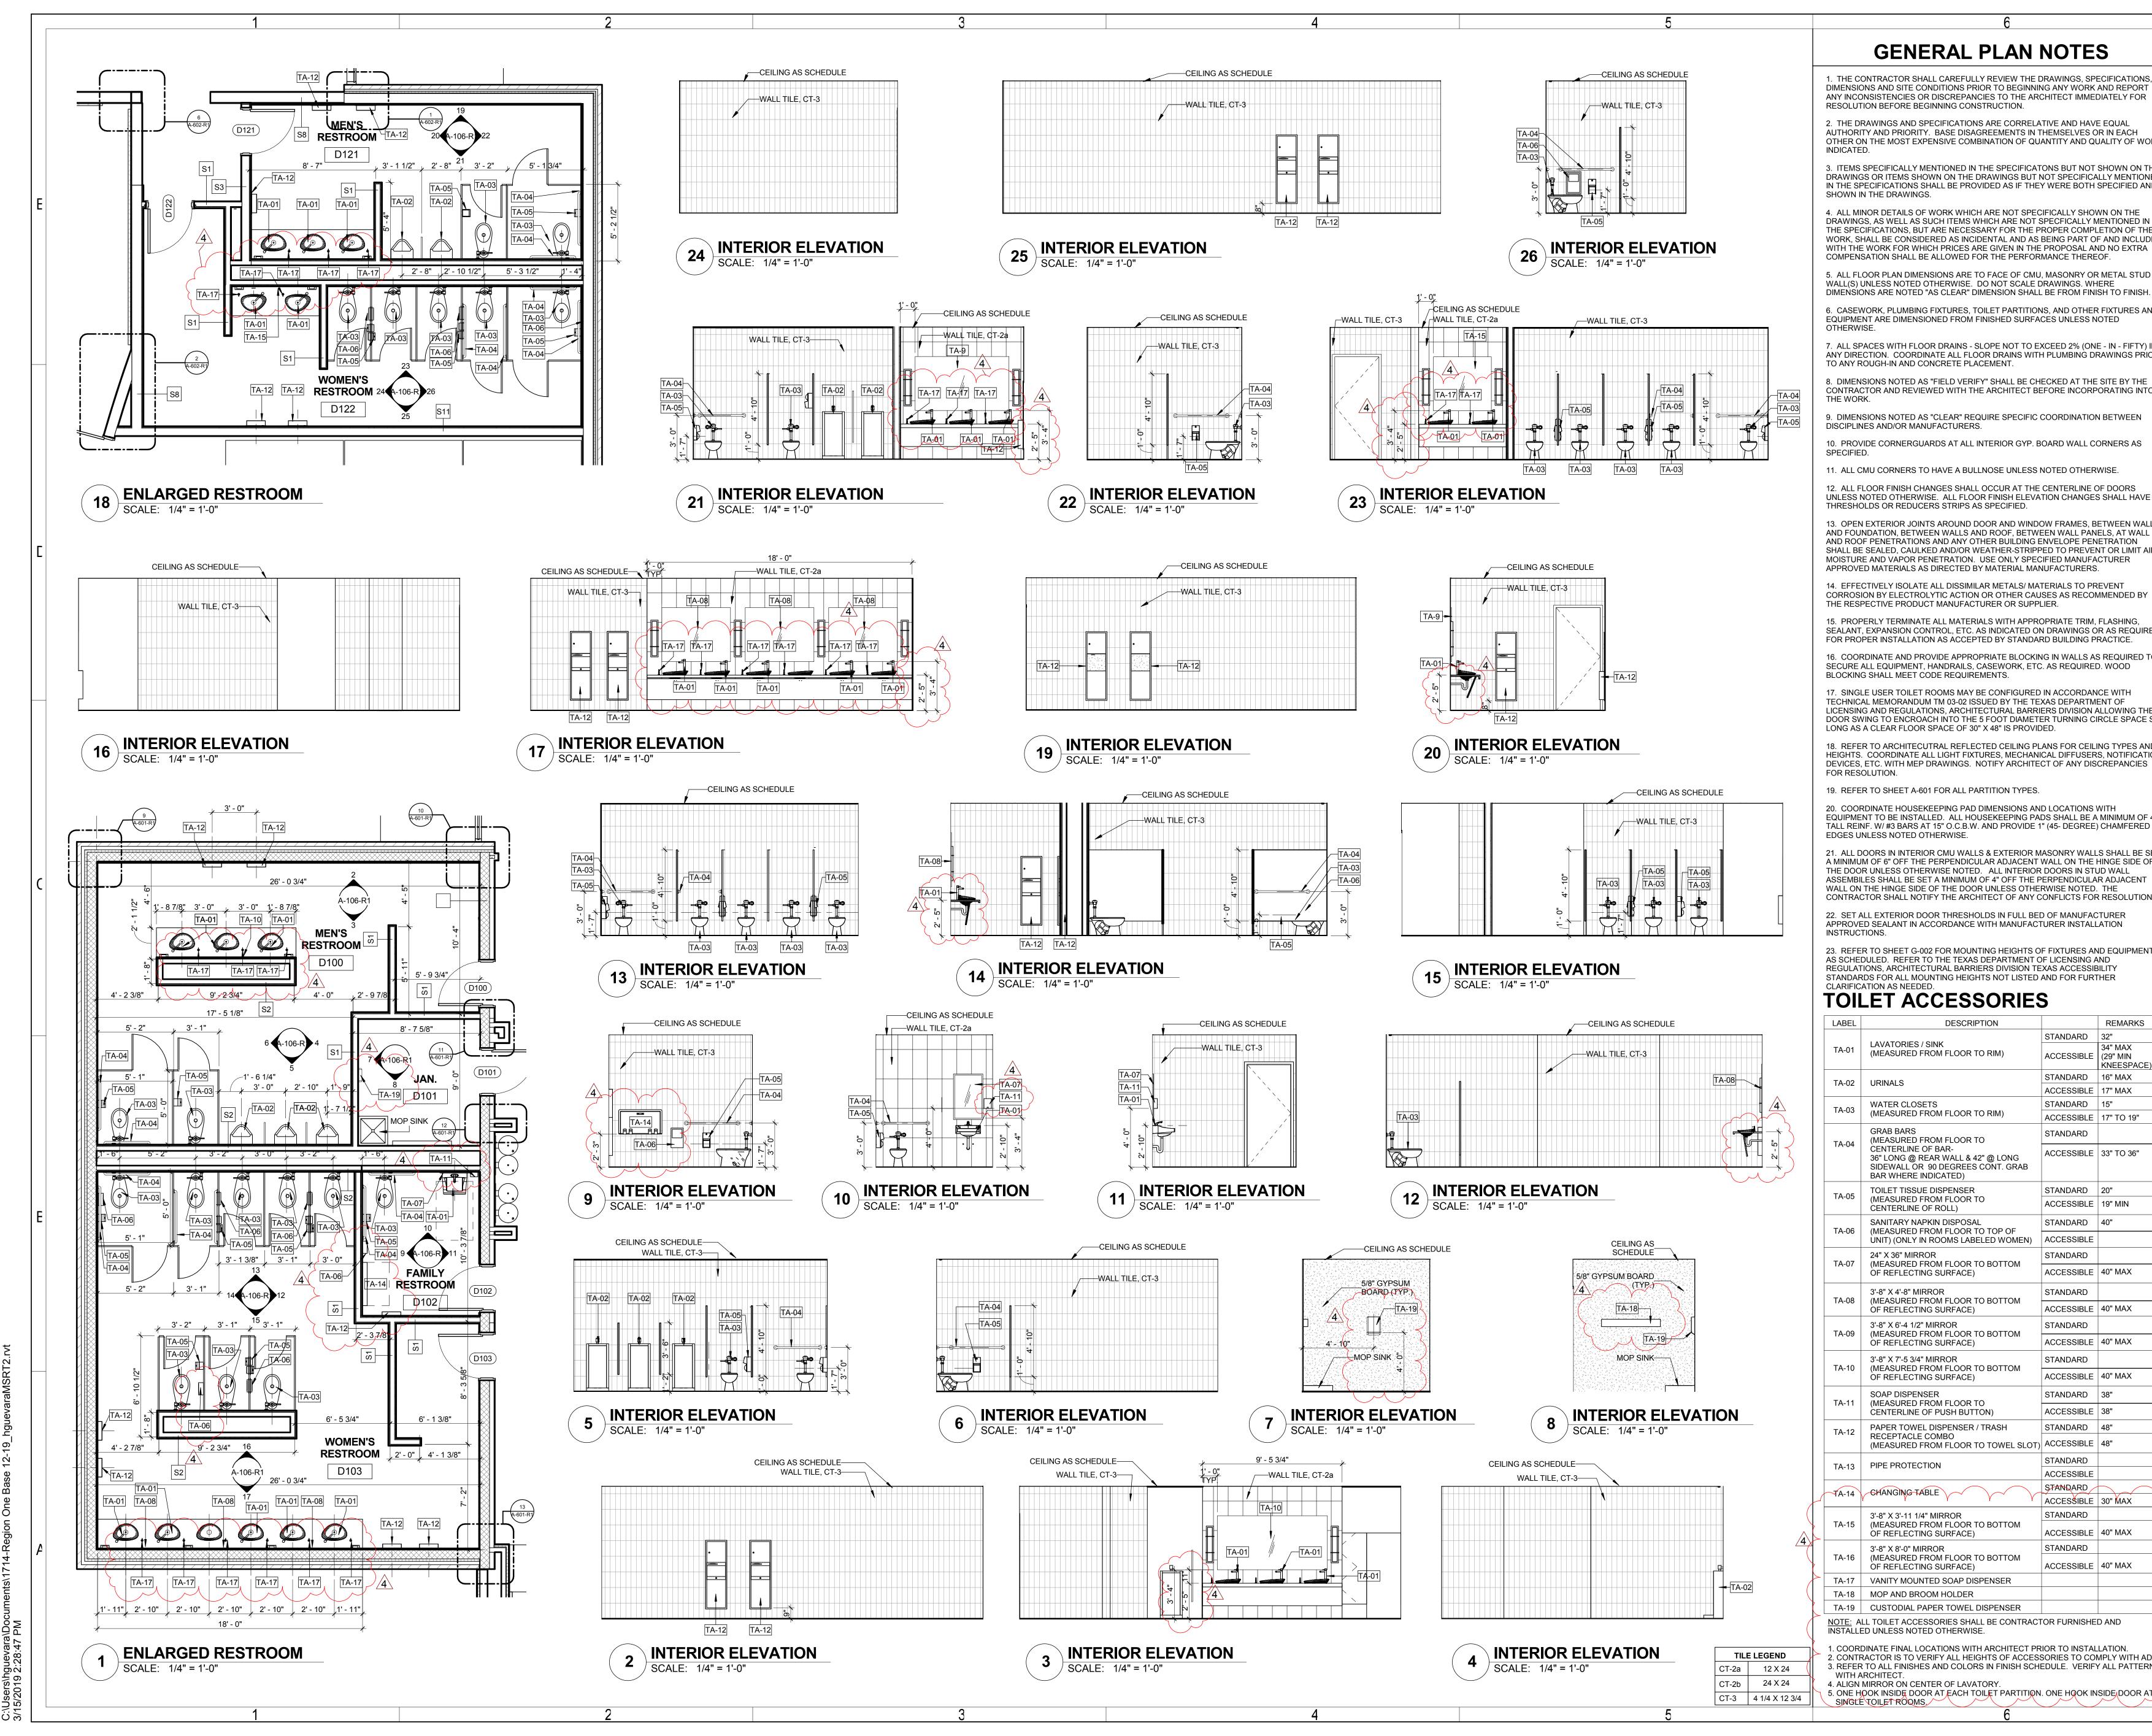

ara 47

GENERAL PLAN NOTES

I. THE CONTRACTOR SHALL CAREFULLY REVIEW THE DRAWINGS, SPECIFICATIONS, DIMENSIONS AND SITE CONDITIONS PRIOR TO BEGINNING ANY WORK AND REPORT ANY INCONSISTENCIES OR DISCREPANCIES TO THE ARCHITECT IMMEDIATELY FOR

2. THE DRAWINGS AND SPECIFICATIONS ARE CORRELATIVE AND HAVE EQUAL AUTHORITY AND PRIORITY. BASE DISAGREEMENTS IN THEMSELVES OR IN EACH OTHER ON THE MOST EXPENSIVE COMBINATION OF QUANTITY AND QUALITY OF WORK

3. ITEMS SPECIFICALLY MENTIONED IN THE SPECIFICATONS BUT NOT SHOWN ON THE DRAWINGS OR ITEMS SHOWN ON THE DRAWINGS BUT NOT SPECIFICALLY MENTIONED IN THE SPECIFICATIONS SHALL BE PROVIDED AS IF THEY WERE BOTH SPECIFIED AND

4. ALL MINOR DETAILS OF WORK WHICH ARE NOT SPECIFICALLY SHOWN ON THE DRAWINGS, AS WELL AS SUCH ITEMS WHICH ARE NOT SPECFICALLY MENTIONED IN THE SPECIFICATIONS, BUT ARE NECESSARY FOR THE PROPER COMPLETION OF THE WORK, SHALL BE CONSIDERED AS INCIDENTAL AND AS BEING PART OF AND INCLUDED WITH THE WORK FOR WHICH PRICES ARE GIVEN IN THE PROPOSAL AND NO EXTRA COMPENSATION SHALL BE ALLOWED FOR THE PERFORMANCE THEREOF.

5. ALL FLOOR PLAN DIMENSIONS ARE TO FACE OF CMU, MASONRY OR METAL STUD WALL(S) UNLESS NOTED OTHERWISE. DO NOT SCALE DRAWINGS. WHERE DIMENSIONS ARE NOTED "AS CLEAR" DIMENSION SHALL BE FROM FINISH TO FINISH.

6. CASEWORK, PLUMBING FIXTURES, TOILET PARTITIONS, AND OTHER FIXTURES AND EQUIPMENT ARE DIMENSIONED FROM FINISHED SURFACES UNLESS NOTED

7. ALL SPACES WITH FLOOR DRAINS - SLOPE NOT TO EXCEED 2% (ONE - IN - FIFTY) IN ANY DIRECTION. COORDINATE ALL FLOOR DRAINS WITH PLUMBING DRAWINGS PRIOR

8. DIMENSIONS NOTED AS "FIELD VERIFY" SHALL BE CHECKED AT THE SITE BY THE CONTRACTOR AND REVIEWED WITH THE ARCHITECT BEFORE INCORPORATING INTO

9. DIMENSIONS NOTED AS "CLEAR" REQUIRE SPECIFIC COORDINATION BETWEEN

10. PROVIDE CORNERGUARDS AT ALL INTERIOR GYP. BOARD WALL CORNERS AS

11. ALL CMU CORNERS TO HAVE A BULLNOSE UNLESS NOTED OTHERWISE.

12. ALL FLOOR FINISH CHANGES SHALL OCCUR AT THE CENTERLINE OF DOORS UNLESS NOTED OTHERWISE. ALL FLOOR FINISH ELEVATION CHANGES SHALL HAVE THRESHOLDS OR REDUCERS STRIPS AS SPECIFIED.

13. OPEN EXTERIOR JOINTS AROUND DOOR AND WINDOW FRAMES, BETWEEN WALLS AND FOUNDATION, BETWEEN WALLS AND ROOF, BETWEEN WALL PANELS, AT WALL AND ROOF PENETRATIONS AND ANY OTHER BUILDING ENVELOPE PENETRATION SHALL BE SEALED, CAULKED AND/OR WEATHER-STRIPPED TO PREVENT OR LIMIT AIR, MOISTURE AND VAPOR PENETRATION. USE ONLY SPECIFIED MANUFACTURER APPROVED MATERIALS AS DIRECTED BY MATERIAL MANUFACTURERS.

14. EFFECTIVELY ISOLATE ALL DISSIMILAR METALS/ MATERIALS TO PREVENT CORROSION BY ELECTROLYTIC ACTION OR OTHER CAUSES AS RECOMMENDED BY THE RESPECTIVE PRODUCT MANUFACTURER OR SUPPLIER.

15. PROPERLY TERMINATE ALL MATERIALS WITH APPROPRIATE TRIM, FLASHING, SEALANT, EXPANSION CONTROL, ETC. AS INDICATED ON DRAWINGS OR AS REQUIRED

FOR PROPER INSTALLATION AS ACCEPTED BY STANDARD BUILDING PRACTICE. 16. COORDINATE AND PROVIDE APPROPRIATE BLOCKING IN WALLS AS REQUIRED TO SECURE ALL EQUIPMENT, HANDRAILS, CASEWORK, ETC. AS REQUIRED. WOOD

17. SINGLE USER TOILET ROOMS MAY BE CONFIGURED IN ACCORDANCE WITH TECHNICAL MEMORANDUM TM 03-02 ISSUED BY THE TEXAS DEPARTMENT OF LICENSING AND REGULATIONS, ARCHITECTURAL BARRIERS DIVISION ALLOWING THE DOOR SWING TO ENCROACH INTO THE 5 FOOT DIAMETER TURNING CIRCLE SPACE SO LONG AS A CLEAR FLOOR SPACE OF 30" X 48" IS PROVIDED.

18. REFER TO ARCHITECUTRAL REFLECTED CEILING PLANS FOR CEILING TYPES AND HEIGHTS. COORDINATE ALL LIGHT FIXTURES, MECHANICAL DIFFUSERS, NOTIFICATION DEVICES, ETC. WITH MEP DRAWINGS. NOTIFY ARCHITECT OF ANY DISCREPANCIES

19. REFER TO SHEET A-601 FOR ALL PARTITION TYPES.

20. COORDINATE HOUSEKEEPING PAD DIMENSIONS AND LOCATIONS WITH EQUIPMENT TO BE INSTALLED. ALL HOUSEKEEPING PADS SHALL BE A MINIMUM OF 4" TALL REINF. W/ #3 BARS AT 15" O.C.B.W. AND PROVIDE 1" (45- DEGREE) CHAMFERED


21. ALL DOORS IN INTERIOR CMU WALLS & EXTERIOR MASONRY WALLS SHALL BE SET A MINIMUM OF 6" OFF THE PERPENDICULAR ADJACENT WALL ON THE HINGE SIDE OF THE DOOR UNLESS OTHERWISE NOTED. ALL INTERIOR DOORS IN STUD WALL ASSEMBILES SHALL BE SET A MINIMUM OF 4" OFF THE PERPENDICULAR ADJACENT WALL ON THE HINGE SIDE OF THE DOOR UNLESS OTHERWISE NOTED. THE CONTRACTOR SHALL NOTIFY THE ARCHITECT OF ANY CONFLICTS FOR RESOLUTION.


22. SET ALL EXTERIOR DOOR THRESHOLDS IN FULL BED OF MANUFACTURER APPROVED SEALANT IN ACCORDANCE WITH MANUFACTURER INSTALLATION

23. REFER TO SHEET G-002 FOR MOUNTING HEIGHTS OF FIXTURES AND EQUIPMENT AS SCHEDULED. REFER TO THE TEXAS DEPARTMENT OF LICENSING AND REGULATIONS, ARCHITECTURAL BARRIERS DIVISION TEXAS ACCESSIBILITY STANDARDS FOR ALL MOUNTING HEIGHTS NOT LISTED AND FOR FURTHER

		NEEDED.	
ΓΟΙ	LET	ACCESSORIES	3

LABEL	DESCRIPTION		REMARKS
		STANDARD	32"
TA-01	LAVATORIES / SINK (MEASURED FROM FLOOR TO RIM)	ACCESSIBLE	34" MAX (29" MIN KNEESPACE)
TA-02	URINALS	STANDARD	16" MAX
TA-02	URINALS	ACCESSIBLE	17" MAX
TA-03	WATER CLOSETS	STANDARD	15"
TA-05	(MEASURED FROM FLOOR TO RIM)	ACCESSIBLE	17" TO 19"
TA-04	GRAB BARS (MEASURED FROM FLOOR TO	STANDARD	
	CENTERLINE OF BAR- 36" LONG @ REAR WALL & 42" @ LONG SIDEWALL OR 90 DEGREES CONT. GRAB BAR WHERE INDICATED)	ACCESSIBLE	33" TO 36"
TA 65	TOILET TISSUE DISPENSER	STANDARD	20"
TA-05	(MEASURED FROM FLOOR TO CENTERLINE OF ROLL)	ACCESSIBLE	19" MIN
TA 00	SANITARY NAPKIN DISPOSAL	STANDARD	40"
TA-06	(MEASURED FROM FLOOR TO TOP OF UNIT) (ONLY IN ROOMS LABELED WOMEN)	ACCESSIBLE	
TA-07	24" X 36" MIRROR (MEASURED FROM FLOOR TO BOTTOM	STANDARD	
14-07	OF REFLECTING SURFACE)	ACCESSIBLE	40" MAX
TA 00	3'-8" X 4'-8" MIRROR	STANDARD	
TA-08	(MEASURED FROM FLOOR TO BOTTOM OF REFLECTING SURFACE)	ACCESSIBLE	40" MAX
TA-09	3'-8" X 6'-4 1/2" MIRROR (MEASURED FROM FLOOR TO BOTTOM	STANDARD	
177.00	OF REFLECTING SURFACE)	ACCESSIBLE	40" MAX
TA-10	3'-8" X 7'-5 3/4" MIRROR (MEASURED FROM FLOOR TO BOTTOM	STANDARD	
177 10	OF REFLECTING SURFACE)	ACCESSIBLE	40" MAX
TA-11	SOAP DISPENSER (MEASURED FROM FLOOR TO	STANDARD	38"
173 11	CENTERLINE OF PUSH BUTTON)	ACCESSIBLE	38"
TA-12	PAPER TOWEL DISPENSER / TRASH	STANDARD	48"
177 12	RECEPTACLE COMBO (MEASURED FROM FLOOR TO TOWEL SLOT)	ACCESSIBLE	48"
TA-13	PIPE PROTECTION	STANDARD	
IA-13		ACCESSIBLE	
TA-14	CHANGING TABLE	STANDARD	
MA-14		ACCESSIBLE	30" MAX
TA-15	3'-8" X 3'-11 1/4" MIRROR (MEASURED FROM FLOOR TO BOTTOM	STANDARD	
17(10	OF REFLECTING SURFACE)	ACCESSIBLE	40" MAX
	3'-8" X 8'-0" MIRROR	STANDARD	
TA-16	(MEASURED FROM FLOOR TO BOTTOM OF REFLECTING SURFACE)	ACCESSIBLE	40" MAX
TA-17	VANITY MOUNTED SOAP DISPENSER		-
TA-18	MOP AND BROOM HOLDER		
TA-19	CUSTODIAL PAPER TOWEL DISPENSER		
	ALL TOILET ACCESSORIES SHALL BE CONTRACT ED UNLESS NOTED OTHERWISE.	OR FURNISHE	D AND
2. CONT 3. REFE	DINATE FINAL LOCATIONS WITH ARCHITECT PR RACTOR IS TO VERIFY ALL HEIGHTS OF ACCESS R TO ALL FINISHES AND COLORS IN FINISH SCHI ARCHITECT.	SORIES TO COI	MPLY WITH ADA.

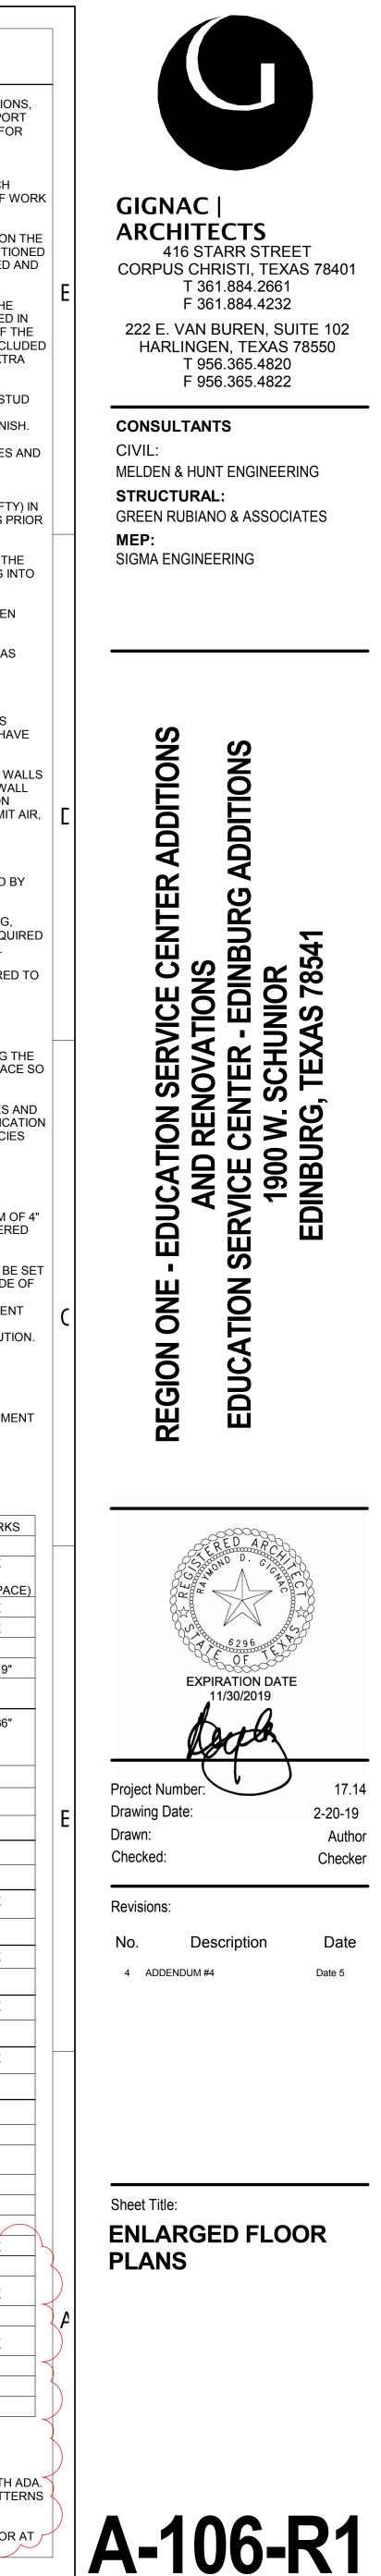

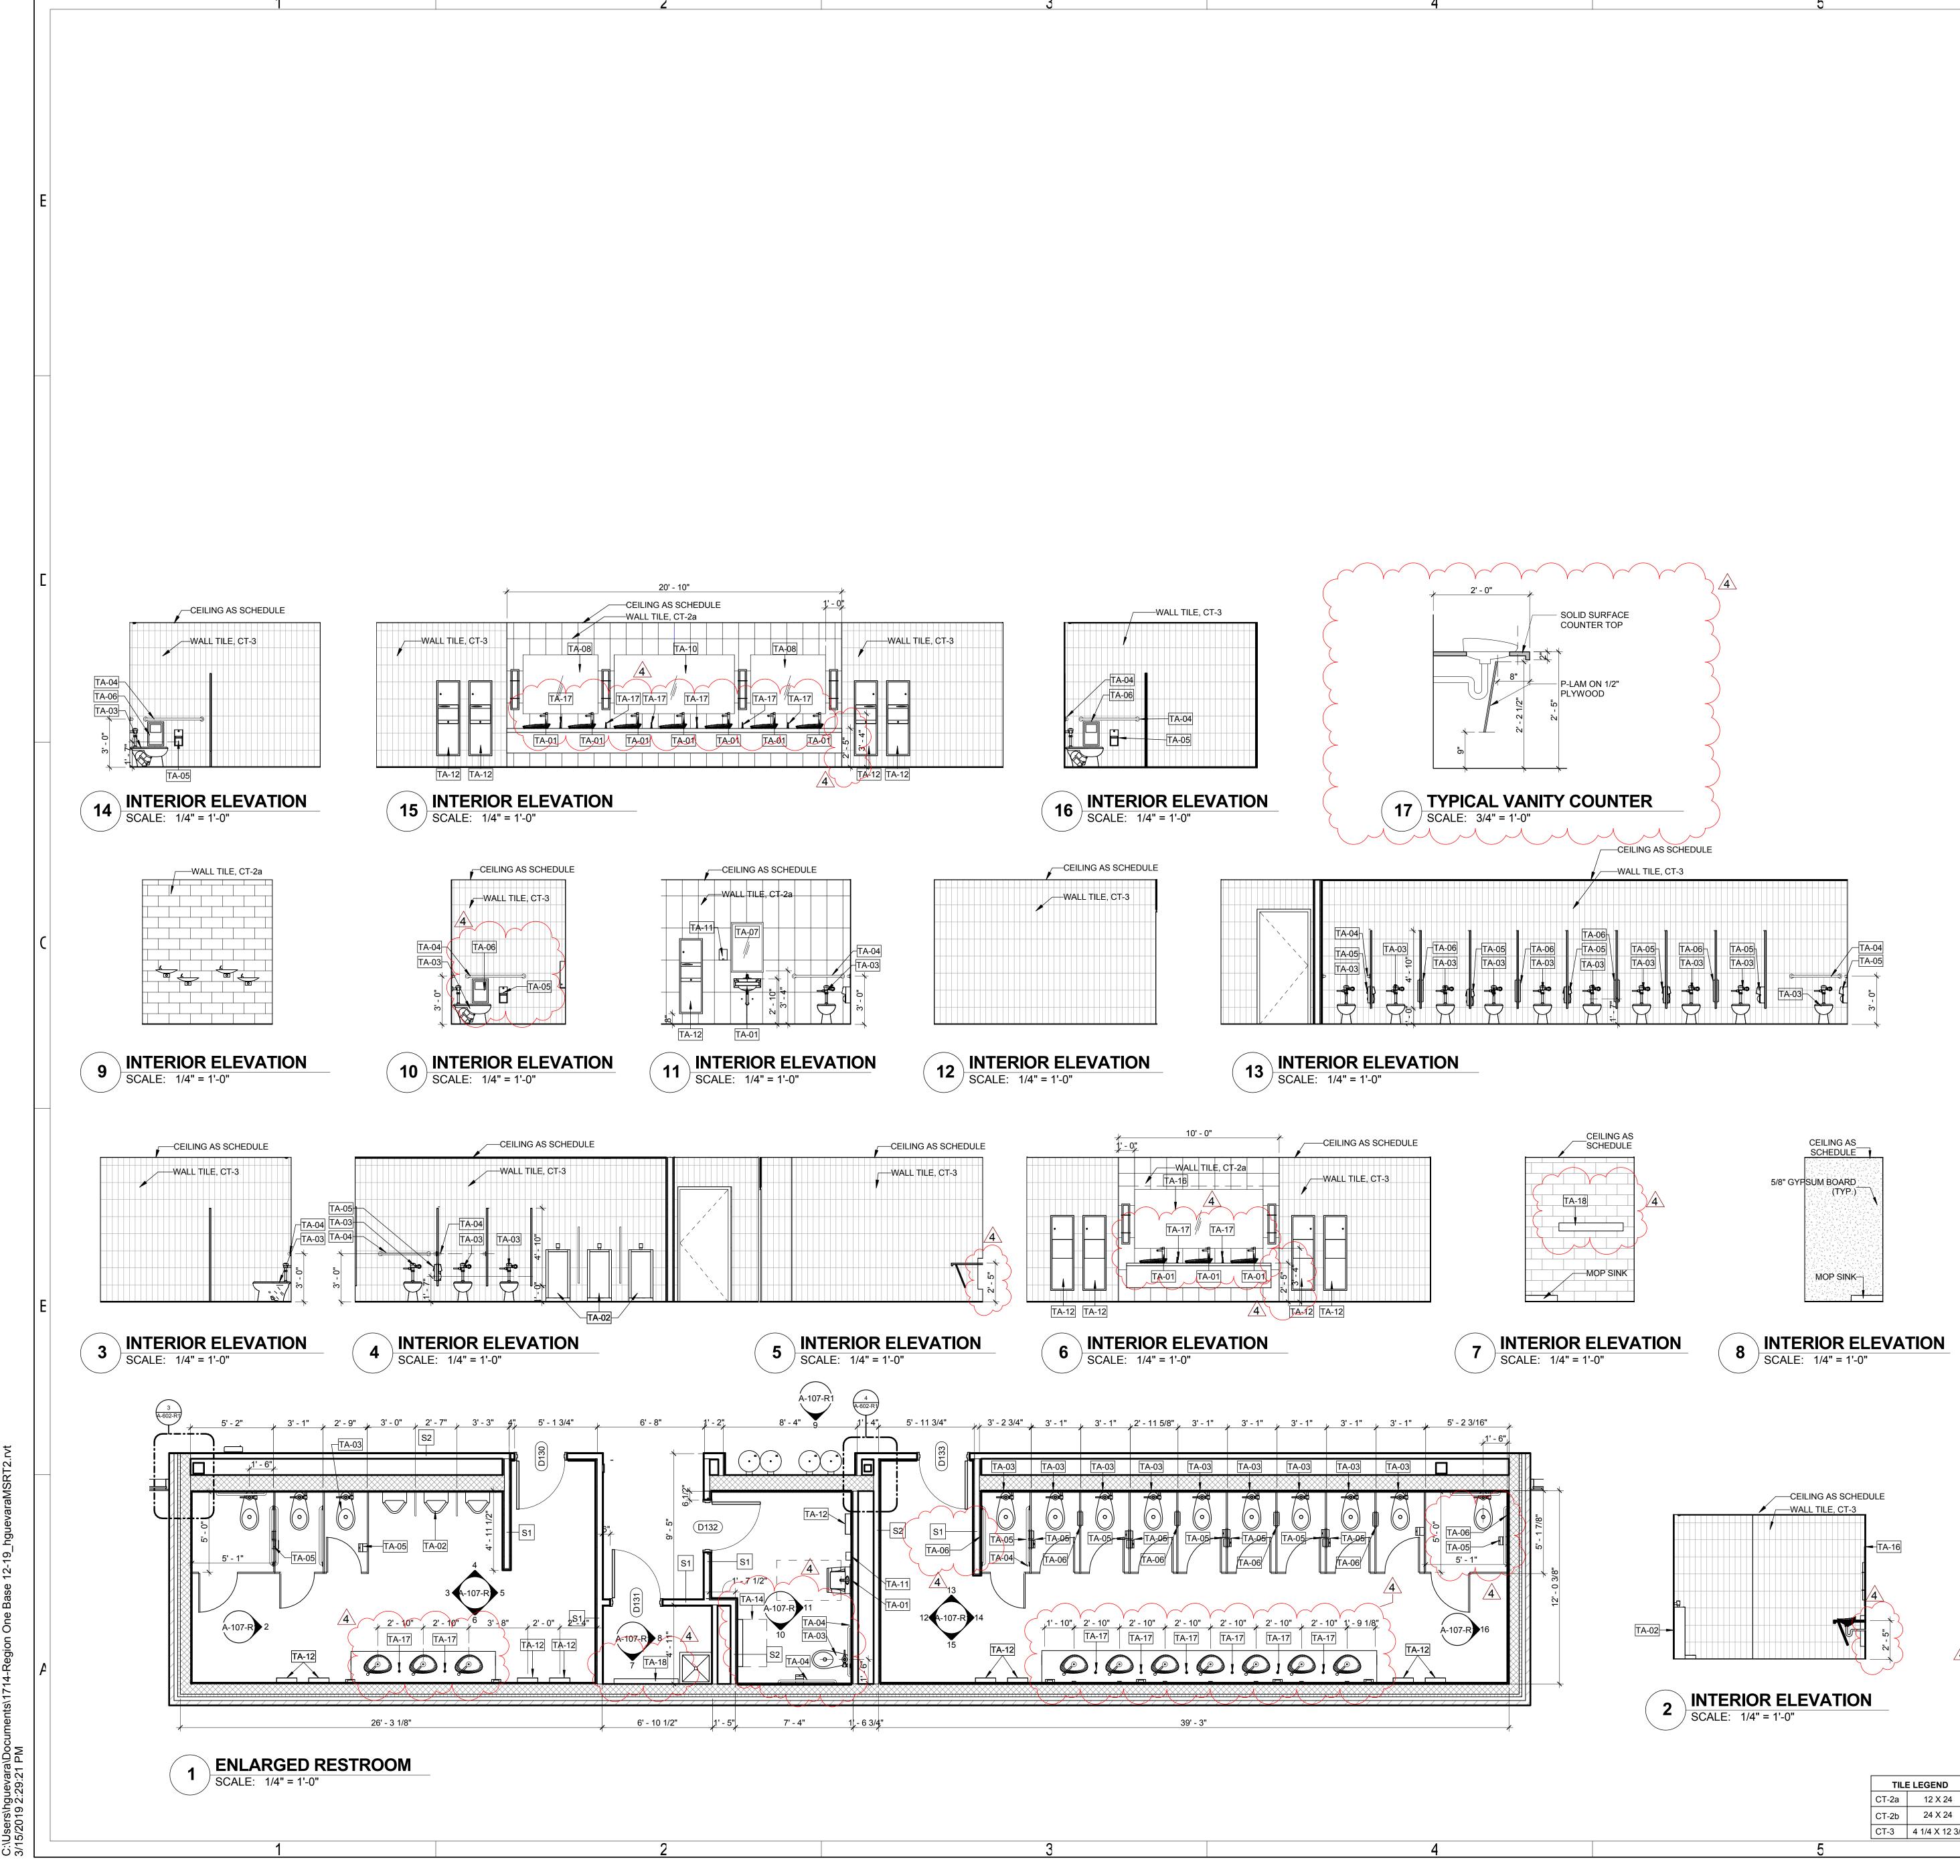

1. THE CONTRACTOR SHALL CAREFULLY REVIEW THE DRAWINGS, SPECIFICATIONS, DIMENSIONS AND SITE CONDITIONS PRIOR TO BEGINNING ANY WORK AND REPORT ANY INCONSISTENCIES OR DISCREPANCIES TO THE ARCHITECT IMMEDIATELY FOR RESOLUTION BEFORE BEGINNING CONSTRUCTION.

2. THE DRAWINGS AND SPECIFICATIONS ARE CORRELATIVE AND HAVE EQUAL AUTHORITY AND PRIORITY. BASE DISAGREEMENTS IN THEMSELVES OR IN EACH OTHER ON THE MOST EXPENSIVE COMBINATION OF QUANTITY AND QUALITY OF WORK INDICATED.

3. ITEMS SPECIFICALLY MENTIONED IN THE SPECIFICATONS BUT NOT SHOWN ON THE DRAWINGS OR ITEMS SHOWN ON THE DRAWINGS BUT NOT SPECIFICALLY MENTIONED IN THE SPECIFICATIONS SHALL BE PROVIDED AS IF THEY WERE BOTH SPECIFIED AND SHOWN IN THE DRAWINGS.

4. ALL MINOR DETAILS OF WORK WHICH ARE NOT SPECIFICALLY SHOWN ON THE DRAWINGS, AS WELL AS SUCH ITEMS WHICH ARE NOT SPECFICALLY MENTIONED IN THE SPECIFICATIONS, BUT ARE NECESSARY FOR THE PROPER COMPLETION OF THE WORK, SHALL BE CONSIDERED AS INCIDENTAL AND AS BEING PART OF AND INCLUDED WITH THE WORK FOR WHICH PRICES ARE GIVEN IN THE PROPOSAL AND NO EXTRA COMPENSATION SHALL BE ALLOWED FOR THE PERFORMANCE THEREOF.

5. ALL FLOOR PLAN DIMENSIONS ARE TO FACE OF CMU, MASONRY OR METAL STUD WALL(S) UNLESS NOTED OTHERWISE. DO NOT SCALE DRAWINGS. WHERE DIMENSIONS ARE NOTED "AS CLEAR" DIMENSION SHALL BE FROM FINISH TO FINISH.

6. CASEWORK, PLUMBING FIXTURES, TOILET PARTITIONS, AND OTHER FIXTURES AND EQUIPMENT ARE DIMENSIONED FROM FINISHED SURFACES UNLESS NOTED OTHERWISE.

7. ALL SPACES WITH FLOOR DRAINS - SLOPE NOT TO EXCEED 2% (ONE - IN - FIFTY) IN ANY DIRECTION. COORDINATE ALL FLOOR DRAINS WITH PLUMBING DRAWINGS PRIOR TO ANY ROUGH-IN AND CONCRETE PLACEMENT.

8. DIMENSIONS NOTED AS "FIELD VERIFY" SHALL BE CHECKED AT THE SITE BY THE CONTRACTOR AND REVIEWED WITH THE ARCHITECT BEFORE INCORPORATING INTO THE WORK.

9. DIMENSIONS NOTED AS "CLEAR" REQUIRE SPECIFIC COORDINATION BETWEEN DISCIPLINES AND/OR MANUFACTURERS.

10. PROVIDE CORNERGUARDS AT ALL INTERIOR GYP. BOARD WALL CORNERS AS SPECIFIED.

11. ALL CMU CORNERS TO HAVE A BULLNOSE UNLESS NOTED OTHERWISE. 12. ALL FLOOR FINISH CHANGES SHALL OCCUR AT THE CENTERLINE OF DOORS UNLESS NOTED OTHERWISE. ALL FLOOR FINISH ELEVATION CHANGES SHALL HAVE

THRESHOLDS OR REDUCERS STRIPS AS SPECIFIED. 13. OPEN EXTERIOR JOINTS AROUND DOOR AND WINDOW FRAMES, BETWEEN WALLS AND FOUNDATION, BETWEEN WALLS AND ROOF, BETWEEN WALL PANELS, AT WALL AND ROOF PENETRATIONS AND ANY OTHER BUILDING ENVELOPE PENETRATION SHALL BE SEALED, CAULKED AND/OR WEATHER-STRIPPED TO PREVENT OR LIMIT AIR, MOISTURE AND VAPOR PENETRATION. USE ONLY SPECIFIED MANUFACTURER APPROVED MATERIALS AS DIRECTED BY MATERIAL MANUFACTURERS.

14. EFFECTIVELY ISOLATE ALL DISSIMILAR METALS/ MATERIALS TO PREVENT CORROSION BY ELECTROLYTIC ACTION OR OTHER CAUSES AS RECOMMENDED BY THE RESPECTIVE PRODUCT MANUFACTURER OR SUPPLIER.

15. PROPERLY TERMINATE ALL MATERIALS WITH APPROPRIATE TRIM, FLASHING, SEALANT, EXPANSION CONTROL, ETC. AS INDICATED ON DRAWINGS OR AS REQUIRED FOR PROPER INSTALLATION AS ACCEPTED BY STANDARD BUILDING PRACTICE.

16. COORDINATE AND PROVIDE APPROPRIATE BLOCKING IN WALLS AS REQUIRED TO SECURE ALL EQUIPMENT, HANDRAILS, CASEWORK, ETC. AS REQUIRED. WOOD BLOCKING SHALL MEET CODE REQUIREMENTS.

17. SINGLE USER TOILET ROOMS MAY BE CONFIGURED IN ACCORDANCE WITH TECHNICAL MEMORANDUM TM 03-02 ISSUED BY THE TEXAS DEPARTMENT OF LICENSING AND REGULATIONS, ARCHITECTURAL BARRIERS DIVISION ALLOWING THE DOOR SWING TO ENCROACH INTO THE 5 FOOT DIAMETER TURNING CIRCLE SPACE SO LONG AS A CLEAR FLOOR SPACE OF 30" X 48" IS PROVIDED.

18. REFER TO ARCHITECUTRAL REFLECTED CEILING PLANS FOR CEILING TYPES AND HEIGHTS. COORDINATE ALL LIGHT FIXTURES, MECHANICAL DIFFUSERS, NOTIFICATION DEVICES, ETC. WITH MEP DRAWINGS. NOTIFY ARCHITECT OF ANY DISCREPANCIES FOR RESOLUTION.

19. REFER TO SHEET A-601 FOR ALL PARTITION TYPES.

20. COORDINATE HOUSEKEEPING PAD DIMENSIONS AND LOCATIONS WITH EQUIPMENT TO BE INSTALLED. ALL HOUSEKEEPING PADS SHALL BE A MINIMUM OF 4" TALL REINF. W/ #3 BARS AT 15" O.C.B.W. AND PROVIDE 1" (45- DEGREE) CHAMFERED EDGES UNLESS NOTED OTHERWISE.

21. ALL DOORS IN INTERIOR CMU WALLS & EXTERIOR MASONRY WALLS SHALL BE SET A MINIMUM OF 6" OFF THE PERPENDICULAR ADJACENT WALL ON THE HINGE SIDE OF THE DOOR UNLESS OTHERWISE NOTED. ALL INTERIOR DOORS IN STUD WALL ASSEMBILES SHALL BE SET A MINIMUM OF 4" OFF THE PERPENDICULAR ADJACENT WALL ON THE HINGE SIDE OF THE DOOR UNLESS OTHERWISE NOTED. THE CONTRACTOR SHALL NOTIFY THE ARCHITECT OF ANY CONFLICTS FOR RESOLUTION.

22. SET ALL EXTERIOR DOOR THRESHOLDS IN FULL BED OF MANUFACTURER APPROVED SEALANT IN ACCORDANCE WITH MANUFACTURER INSTALLATION INSTRUCTIONS.


23. REFER TO SHEET G-002 FOR MOUNTING HEIGHTS OF FIXTURES AND EQUIPMENT AS SCHEDULED. REFER TO THE TEXAS DEPARTMENT OF LICENSING AND REGULATIONS, ARCHITECTURAL BARRIERS DIVISION TEXAS ACCESSIBILITY STANDARDS FOR ALL MOUNTING HEIGHTS NOT LISTED AND FOR FURTHER CLARIFICATION AS NEEDED.


TOILET ACCESSORIES

LABEL	DESCRIPTION		REMARKS
TA-01	LAVATORIES / SINK (MEASURED FROM FLOOR TO RIM)	STANDARD	32" 34" MAX
		ACCESSIBLE	(29" MIN KNEESPACE)
TA-02	URINALS	STANDARD	16" MAX
		ACCESSIBLE	17" MAX
TA-03	WATER CLOSETS (MEASURED FROM FLOOR TO RIM)	STANDARD	15"
	· · ·	ACCESSIBLE	17" TO 19"
TA-04	GRAB BARS (MEASURED FROM FLOOR TO CENTERLINE OF BAR-	STANDARD	
	36" LONG @ REAR WALL & 42" @ LONG SIDEWALL OR 90 DEGREES CONT. GRAB BAR WHERE INDICATED)	ACCESSIBLE	33" TO 36"
TA-05	TOILET TISSUE DISPENSER	STANDARD	20"
TA-05	(MEASURED FROM FLOOR TO CENTERLINE OF ROLL)	ACCESSIBLE	19" MIN
TA 00	SANITARY NAPKIN DISPOSAL	STANDARD	40"
TA-06	(MEASURED FROM FLOOR TO TOP OF UNIT) (ONLY IN ROOMS LABELED WOMEN)	ACCESSIBLE	
TA 07	24" X 36" MIRROR	STANDARD	
TA-07	(MEASURED FROM FLOOR TO BOTTOM OF REFLECTING SURFACE)	ACCESSIBLE	40" MAX
TA-08	3'-8" X 4'-8" MIRROR (MEASURED FROM FLOOR TO BOTTOM OF REFLECTING SURFACE)	STANDARD	
17-00		ACCESSIBLE	40" MAX
TA-09	3'-8" X 6'-4 1/2" MIRROR (MEASURED FROM FLOOR TO BOTTOM	STANDARD	
17-00	OF REFLECTING SURFACE)	ACCESSIBLE	40" MAX
TA-10	3'-8" X 7'-5 3/4" MIRROR (MEASURED FROM FLOOR TO BOTTOM	STANDARD	
17-10	OF REFLECTING SURFACE)	ACCESSIBLE	40" MAX
	SOAP DISPENSER	STANDARD	38"
TA-11	(MEASURED FROM FLOOR TO CENTERLINE OF PUSH BUTTON)	ACCESSIBLE	38"
TA-12	PAPER TOWEL DISPENSER / TRASH	STANDARD	48"
1A-12	RECEPTACLE COMBO (MEASURED FROM FLOOR TO TOWEL SLOT)	ACCESSIBLE	48"
TA-13	PIPE PROTECTION	STANDARD	
TA-13		ACCESSIBLE	
TA-14	CHANGING TABLE	STANDARD	
1717		ACCESSIBLE	30" MAX
~	3'-8" X 3'-11 1/4" MIRROR	STANDARD	
TA-15	(MEASURED FROM FLOOR TO BOTTOM OF REFLECTING SURFACE)	ACCESSIBLE	40" MAX
TA 40	3'-8" X 8'-0" MIRROR	STANDARD	
TA-16	(MEASURED FROM FLOOR TO BOTTOM OF REFLECTING SURFACE)	ACCESSIBLE	40" MAX
TA-17	VANITY MOUNTED SOAP DISPENSER		
TA-18	MOP AND BROOM HOLDER		
TA-19	CUSTODIAL PAPER TOWEL DISPENSER		
	LL TOILET ACCESSORIES SHALL BE CONTRACT ED UNLESS NOTED OTHERWISE.	OR FURNISHE	D AND
2. CONTE 3. REFEF WITH A	DINATE FINAL LOCATIONS WITH ARCHITECT PR RACTOR IS TO VERIFY ALL HEIGHTS OF ACCESS TO ALL FINISHES AND COLORS IN FINISH SCHI RCHITECT. MIRROR ON CENTER OF LAVATORY.	SORIES TO CO	MPLY WITH AD


 CT-2b
 24 X 24
 4. ALIGN MIRROR ON CENTER OF LAVATORY.


 CT-3
 4 1/4 X 12 3/4
 5. ONE HOOK INSIDE DOOR AT EACH TOILET PARTITION. ONE HOOK INSIDE DOOR AT EACH TOILET PARTITION.

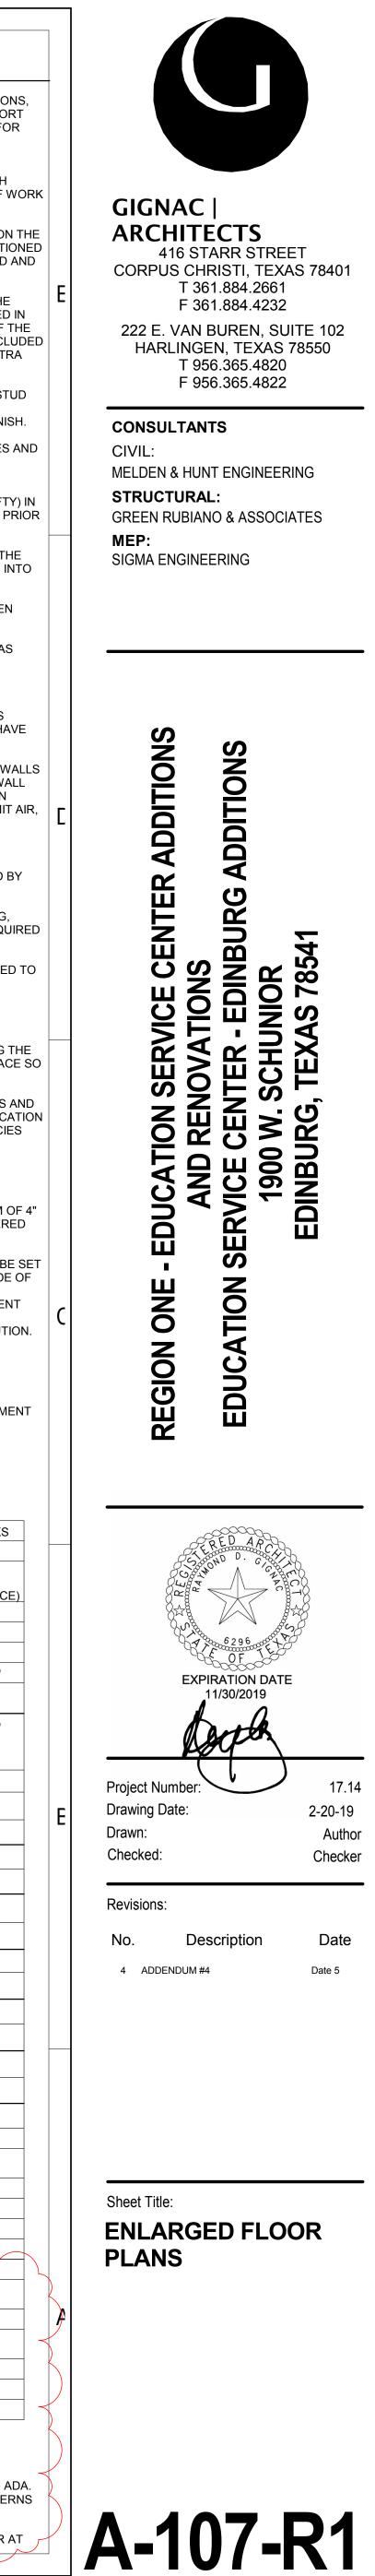

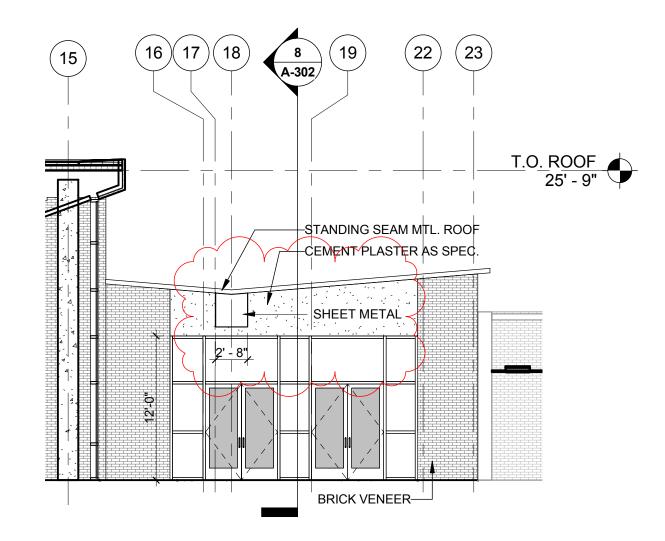



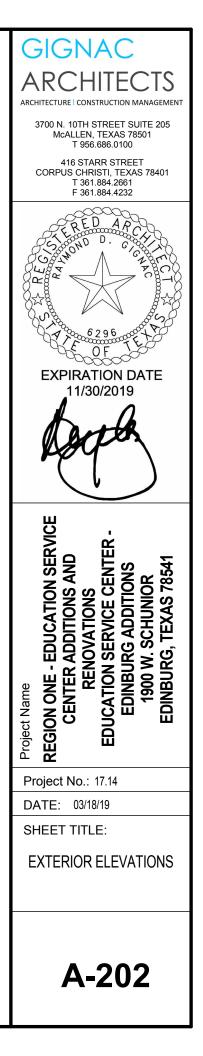

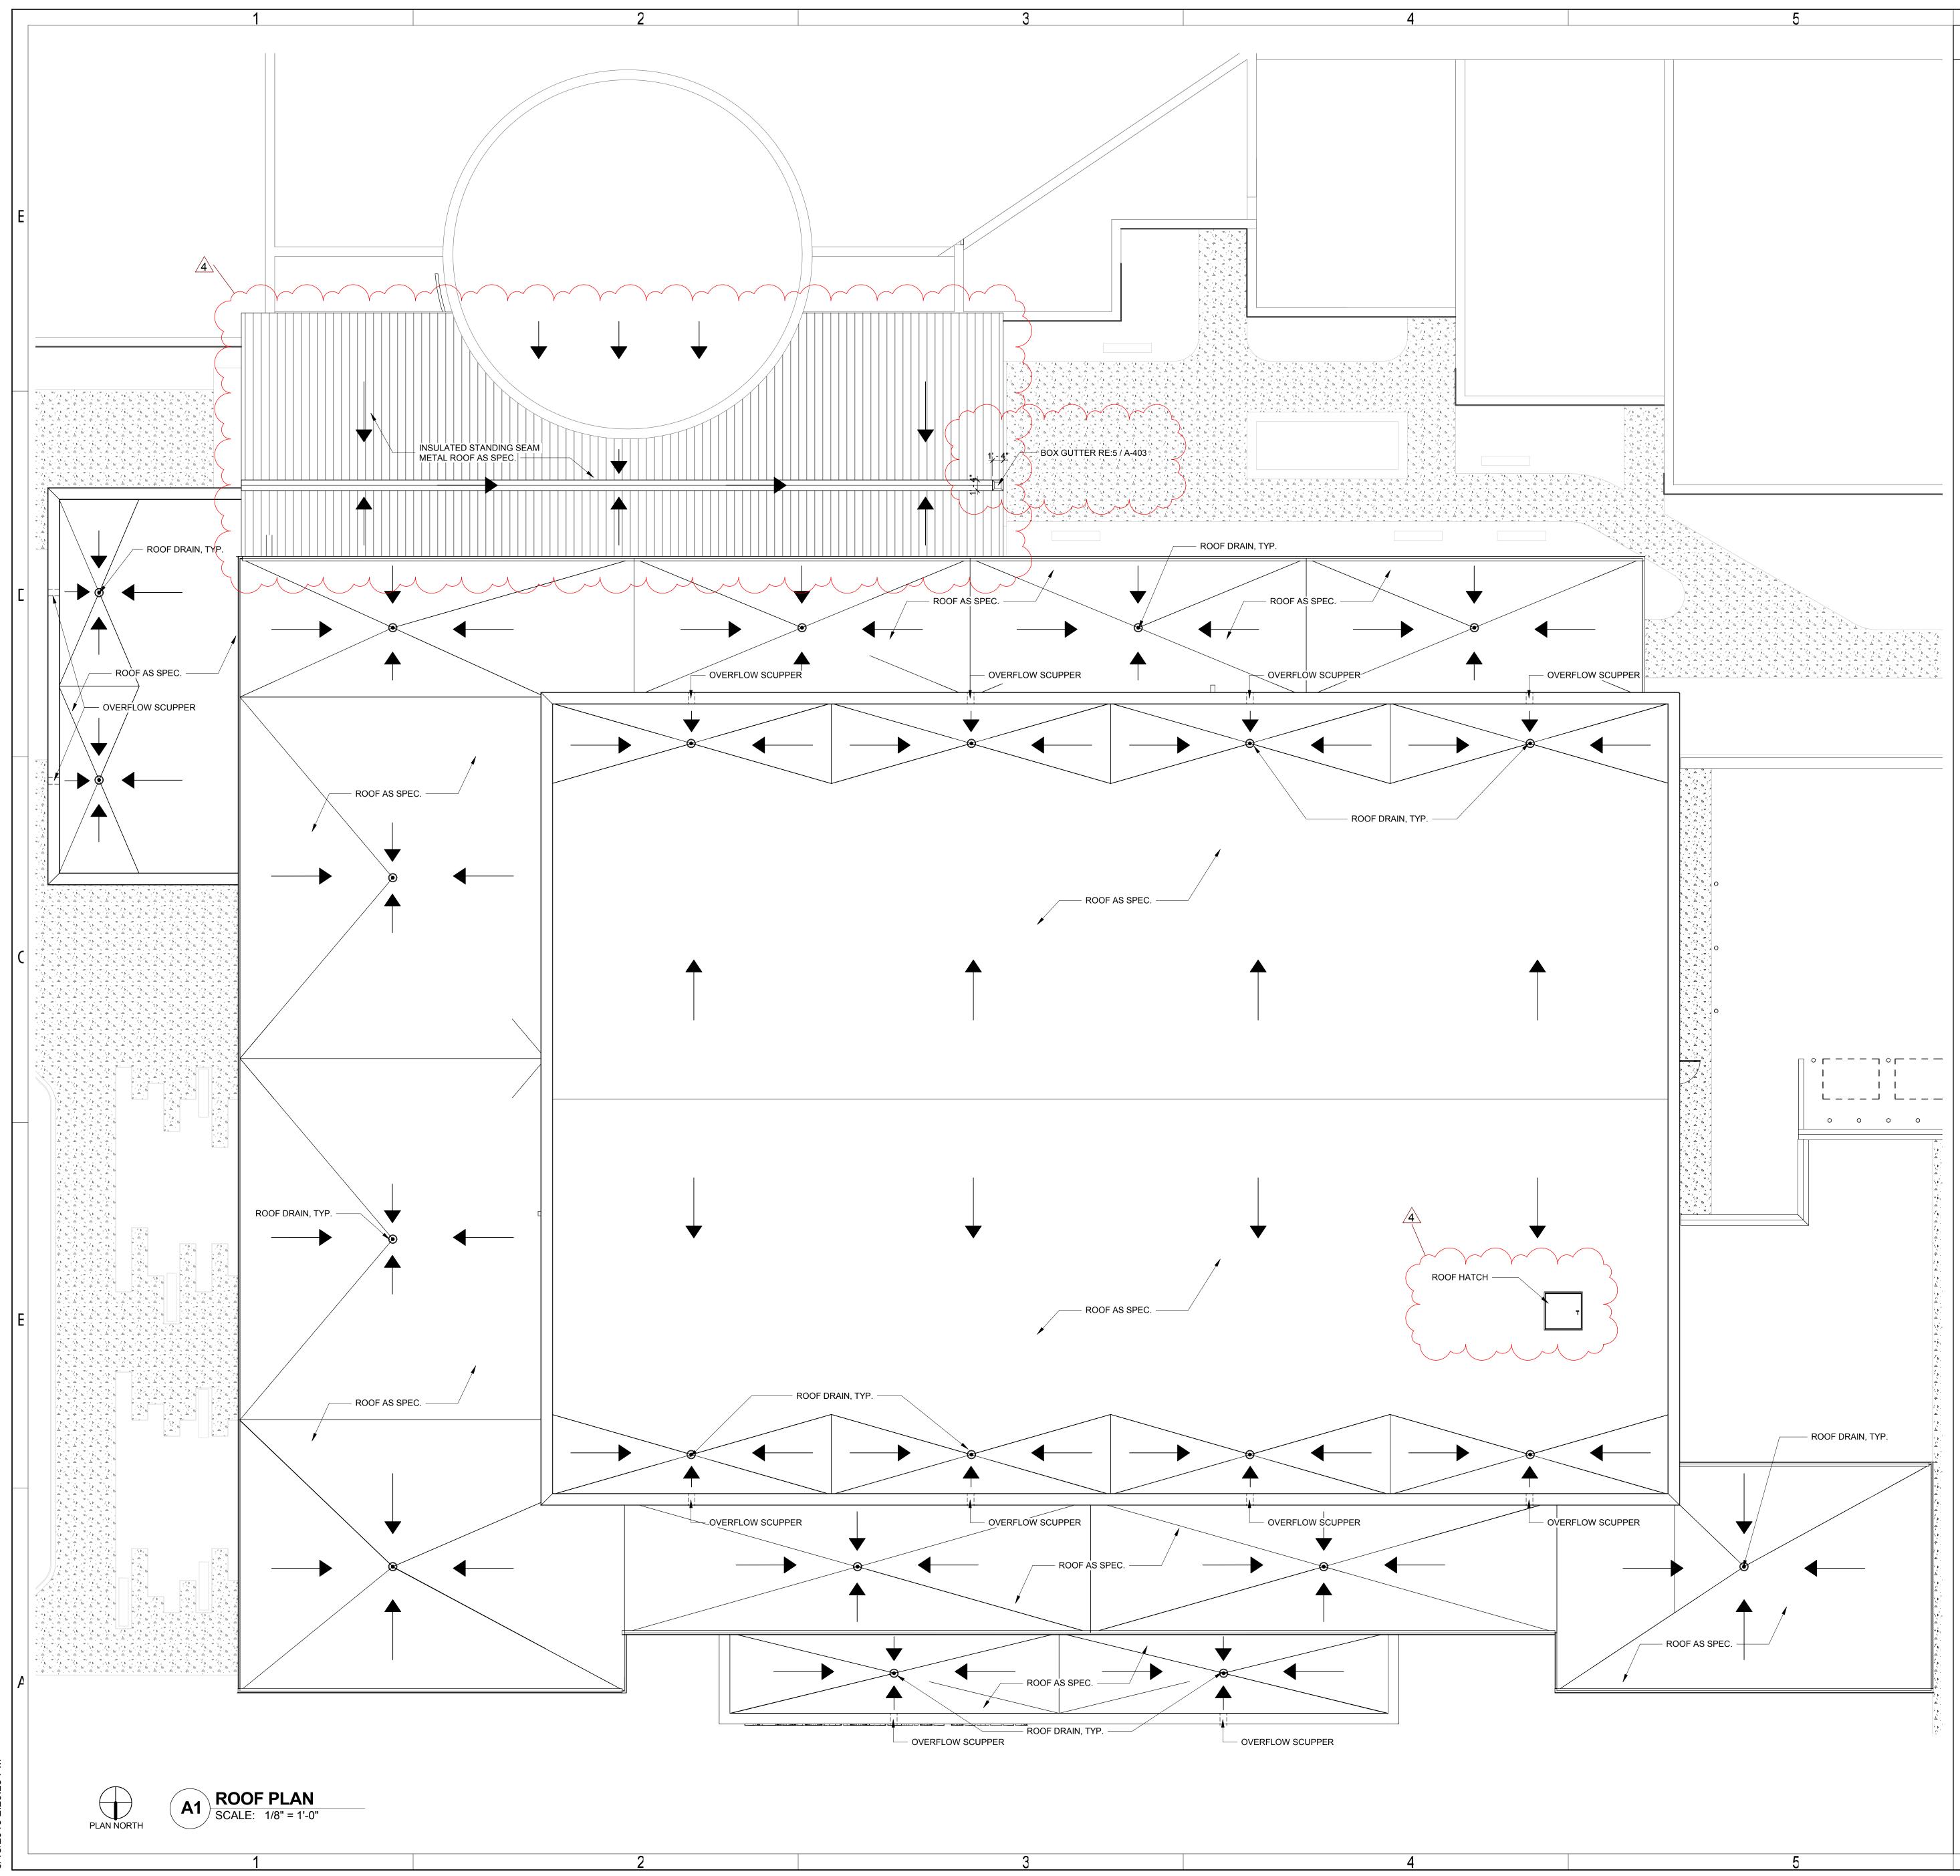

C:\Users\hguevara\Documents\1714-Region One Base 12-19_hguevaraMSRT2.rvt 3/15/2019 2:29:23 PM

GENERAL NOTES

GENERAL PLAN NOTES

1. CONTRACTOR SHALL REVIEW AND COORDINATE WITH ARCHITECTURAL, MEP, & STRUCTURAL PLANS TO ASCERTAIN EXACT CONDITIONS AND COMPONENTS RELATED TO THE WORK DESCRIBED BY THESE DOCUMENTS. ALL WORK SHALL BE IN ACCORDANCE WITH ACCEPTED MANUFACTURER'S PRINTED INSTRUCTIONS AND NRCA STANDARDS.

2. DIMENSIONS, DETAILS, EQUIPMENT SIZE AND LOCATION SHOWN ON THESE ROOF PLAN AND ROOF DETAILS ARE FOR INFORMATION AND REFERENCE ONLY. EXACT SIZE, LOCATION, TYPE OF MATERIAL AND TYPE OF CONSTRUCTION ARE THE RESPONSIBILITY OF THE SUBCONTRACTOR TO CONFIRM AND GENERAL CONTRACTOR TO COORDINATE.

3. REFER TO NOMENCLATURE FOR TYPE OF ROOF SYSTEM. AREAS ARE MARKED WITH DESIGNATED LETTER, SEE ROOF PLAN AND NOMENCLATURE.

4. MINIMUM SLOPE ALLOWABLE ON THE ROOF SHALL BE NO LESS THAN 1/4" PER FOOT. CRICKET THE UP SLOPE SIDE OF ALL SQUARE CURBS AND PROJECTIONS OVER 20" IN WIDTH.

 5. ALL NEW CRICKET AND TAPERED INSULATION SHALL BE INSTALLED WITH A FINISH 1/4" PER FOOT MIN. SLOPE. CRICKET THE UP SLOPE SIDE OF ALL SQUARE CURBS AND PROJECTIONS.
 6. ALL PIPING/ CONDUITS/ ETC. SHALL BE A MIN. 10" ABOVE ROOF

SURFACE. PROVIDE PORTABLE PIPE HANGERS WITH PROTECTION PADS. (RE:07721) - MEP CONTRACTOR SHALL PROVIDE SUPPORTS FOR NEW LINES.

 PROVIDE 22 ga. STAINLESS STEEL, 2D FINISH, TREATED WOOD CURB AND BOX HOOD AT ALL GAS LINE AND WATER LINE ROOF PENETRATIONS (RE: GENERAL DETAILS).
 ISOLATE ALL HEAT PIPES/FLUES AS RECOMMENDED & OUTLINED IN THE

NRCA MANUAL FOR ISOLATED STACK FLASHING. (RE: GENERAL DETAILS.) 9. REFER TO MEP DRAWINGS FOR SIZE AND LOCATION OF NEW DECK PENETRATIONS AND ROOF TOP EQUIPMENT.

10. PROVIDE WALKWAY PROTECTION PADS (RE:SPECS) AROUND ALL ROOF HATCHES, A/C UNITS, AND AT ALL ROOF TOP ACCESS DOORS AND LADDERS (TOP & BOTTOM)

 11. REFER TO GENERAL DETAILS FOR TYPICAL SPLASH PAN, ROOF DRAIN AND OVERFLOW DRAIN DETAILS.
 12. GENERAL CONTRACTOR TO ENSURE ALL ROOFTOP PENETRATIONS


(EQUIP, SOIL STACKS, ETC.) ARE INSTALLED MIN. 2'-0" FROM OTHER DECK PENETRATIONS, RISE WALLS, AND ROOF EDGE.
13. THROUGH WALL BASE FLASHING MIN. HEIGHT 10" AND MAX. HEIGHT 20" FROM FINISH DECK. DO NOT STEP THROUGH WALL FLASHING CLOSER


THAN 5'-0" FROM CORNERS. 14. LOCATE PERIMETER DRAINS MAX. 6'-0" FROM EDGE TYPICAL UNLESS SHOWN OTHERWISE. (GENERAL CONTRACTOR TO COORDINATE WITH ROOFING AND PLUMBING CONTRACTOR.)


15. GENERAL CONTRACTOR TO COORDINATE LOCATION AND ORIENTATION ON ROOF HATCH AND ACCESS LADDER, WHERE APPLICABLE.


16. UPON SUBSTANTIAL COMPLETION THE GENERAL CONTRACTOR SHALL EXAMINE AND ENSURE DRAIN LINES, GUTTERS AND DOWNSPOUTS ARE FREE OF DEBRIS AND BLOCKAGE, FLUSH WITH WATER TO ENSURE THAT DRAINS FLOW FREELY, WHERE APPLICABLE.


SLOPE INDICATES INTENDED DIRECTION OF WATER DRAINAGE

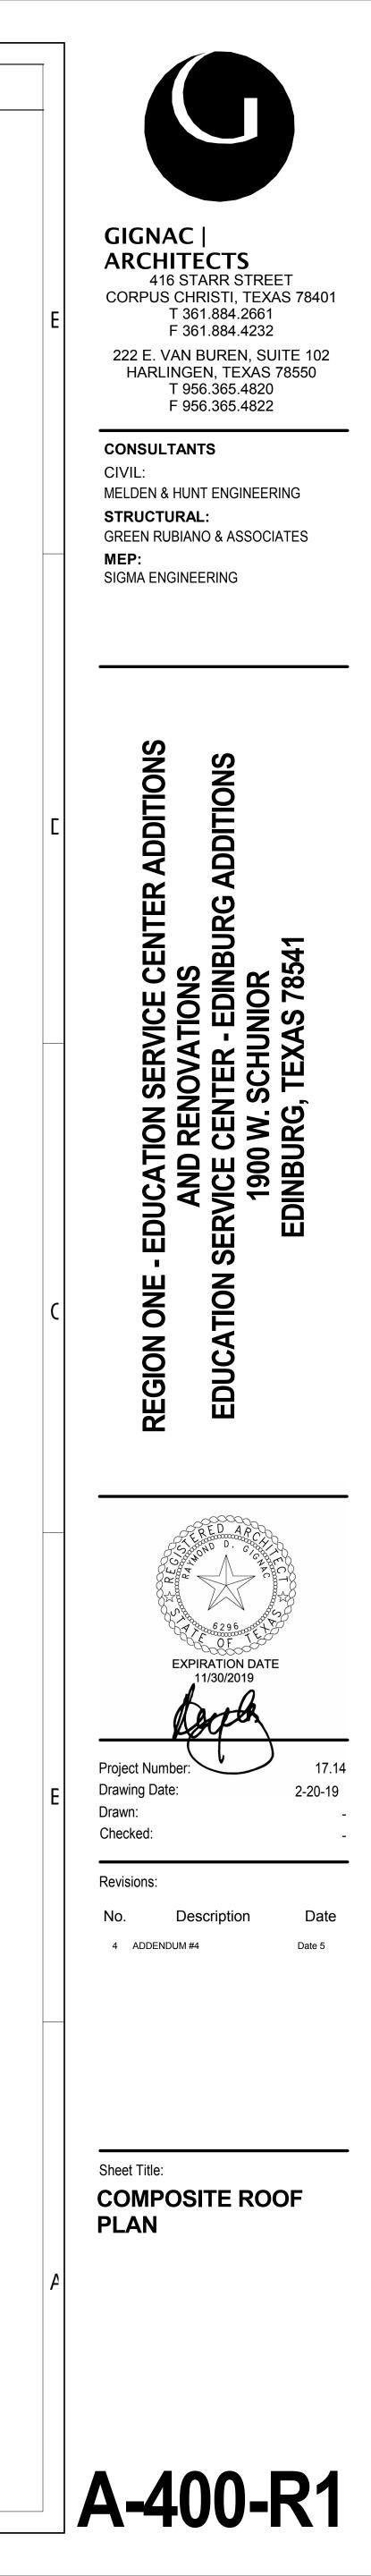


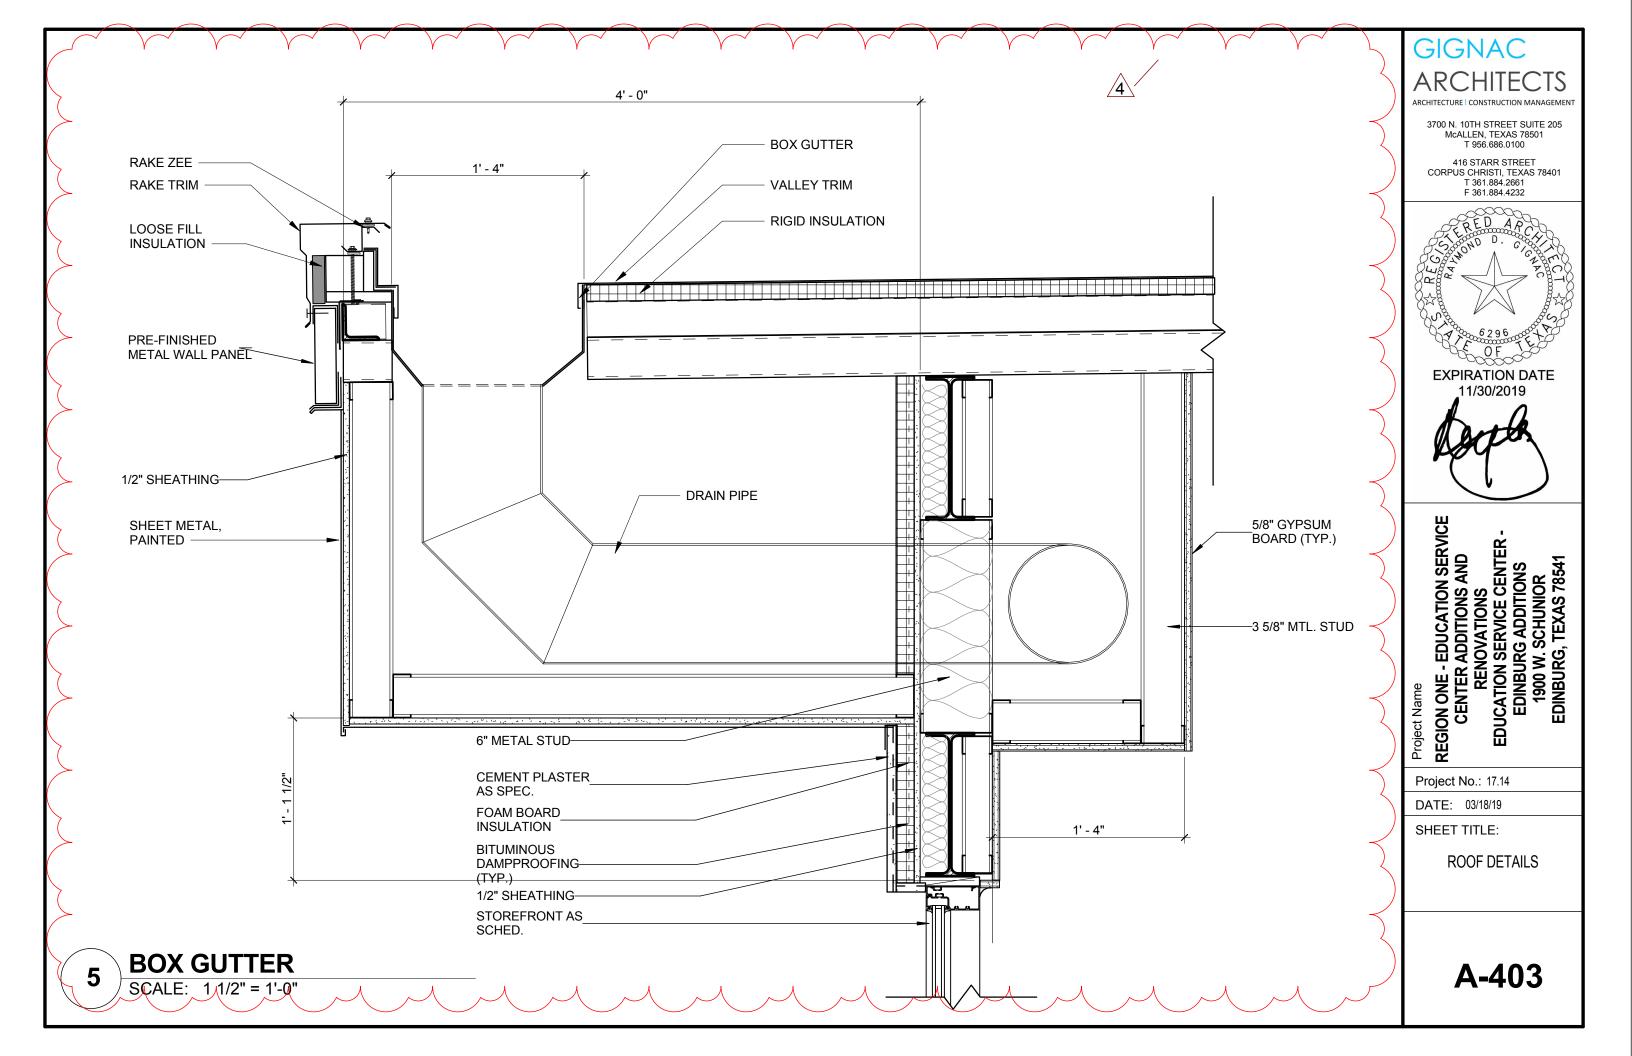


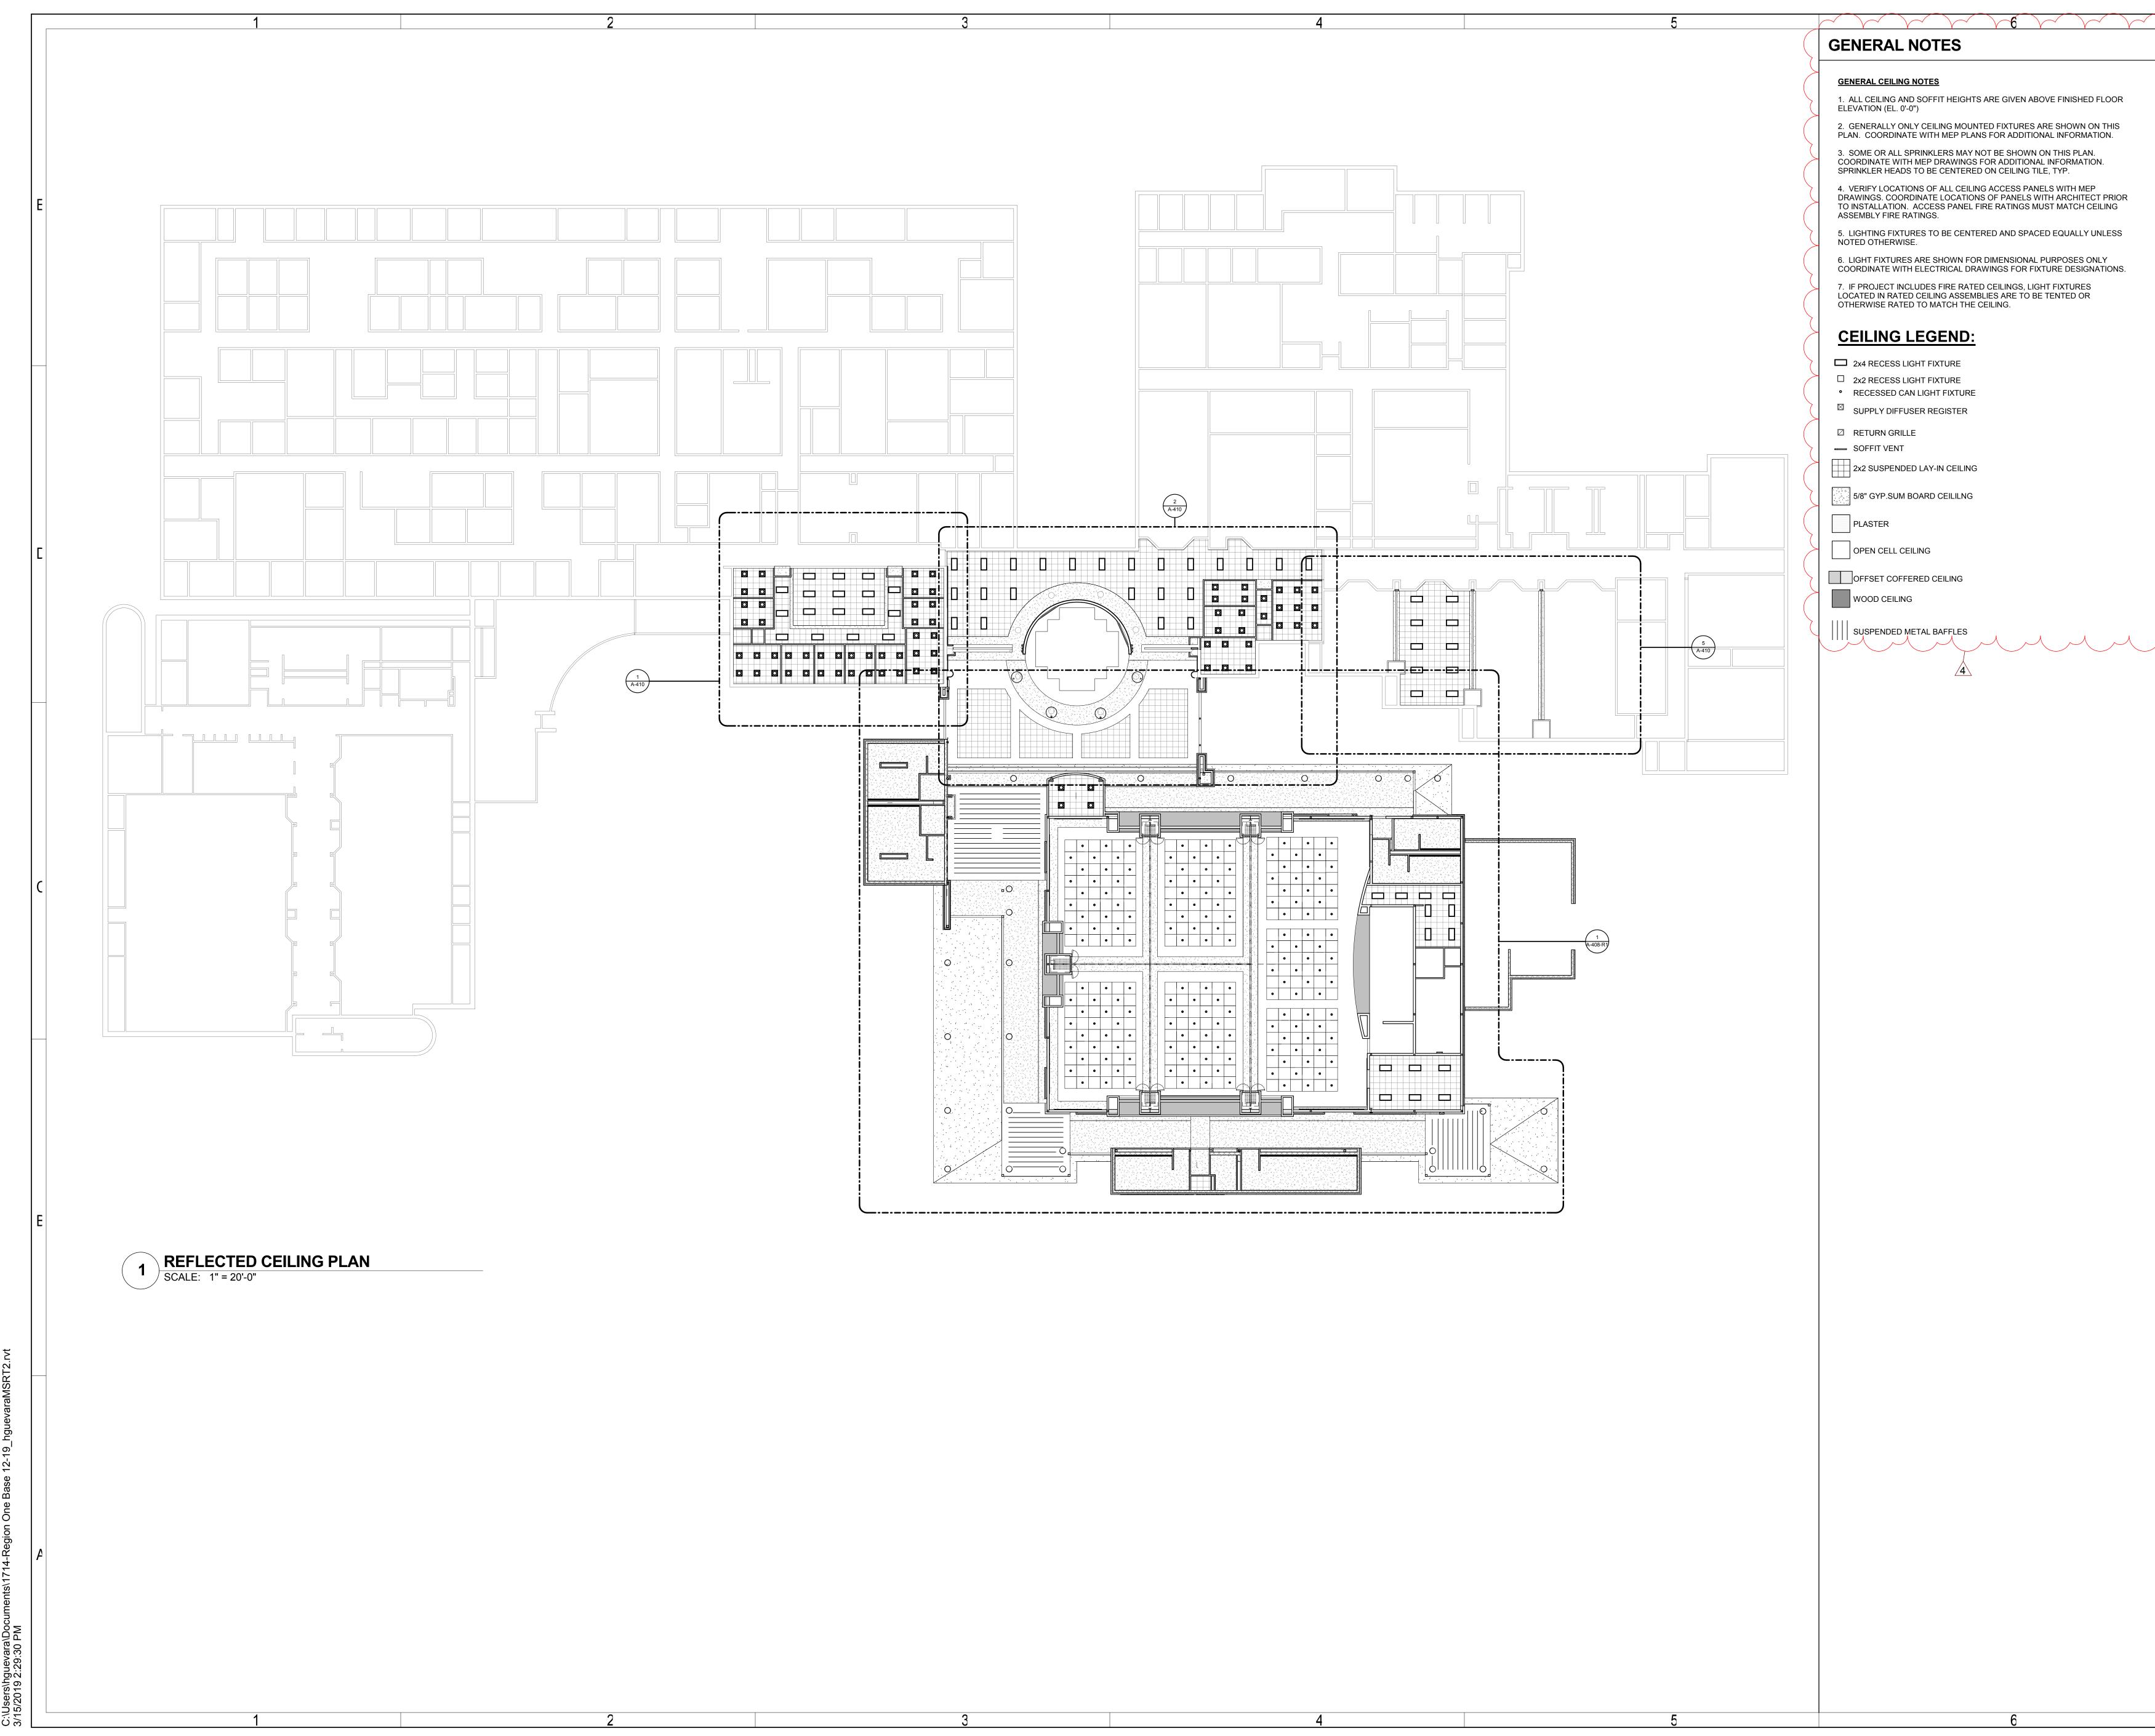


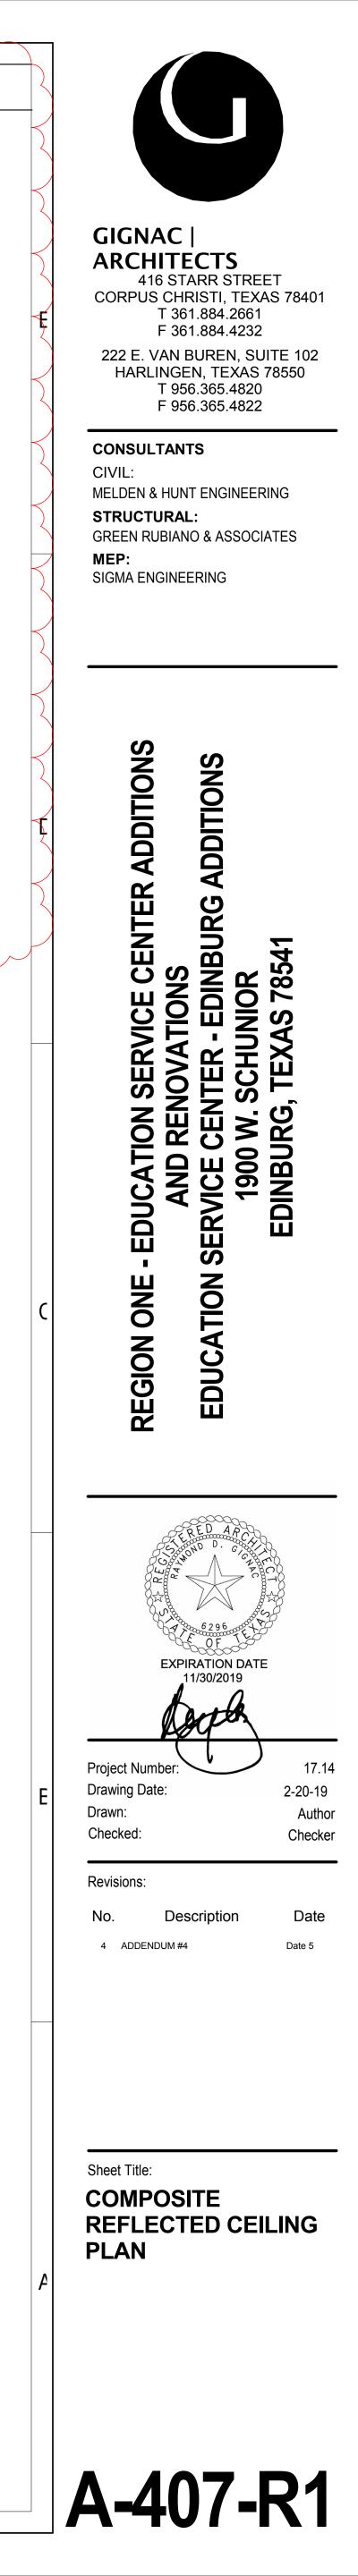

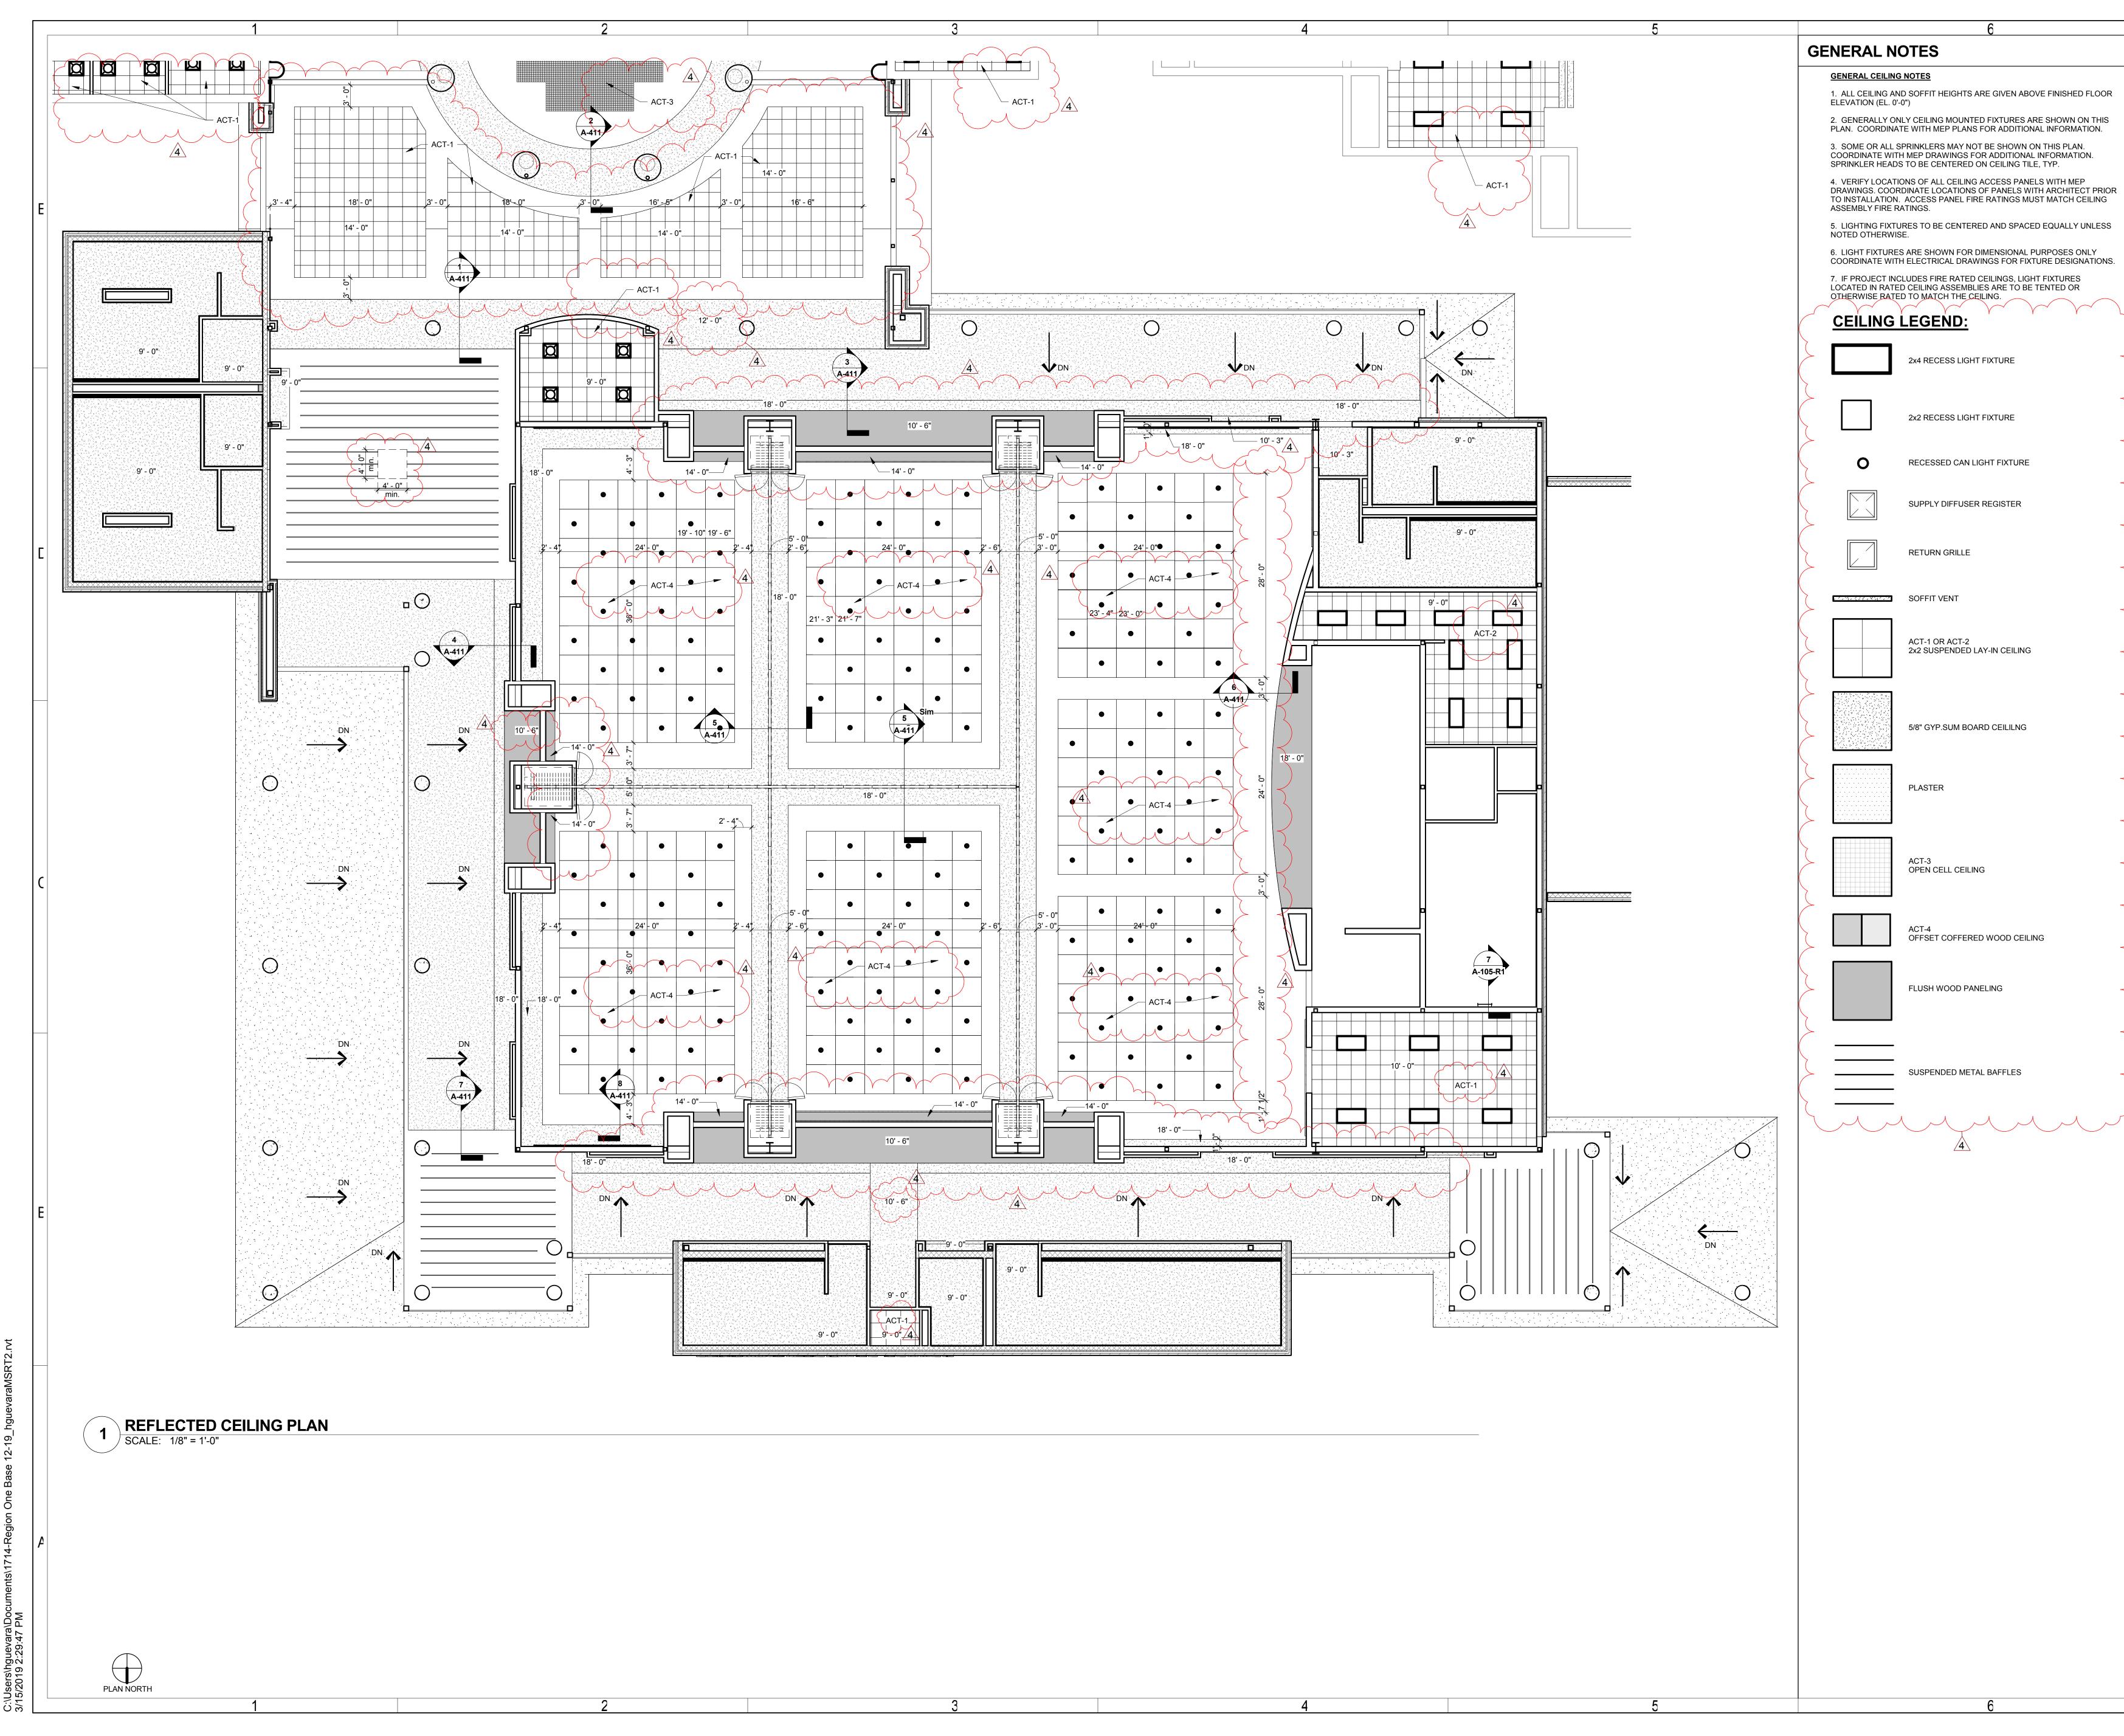


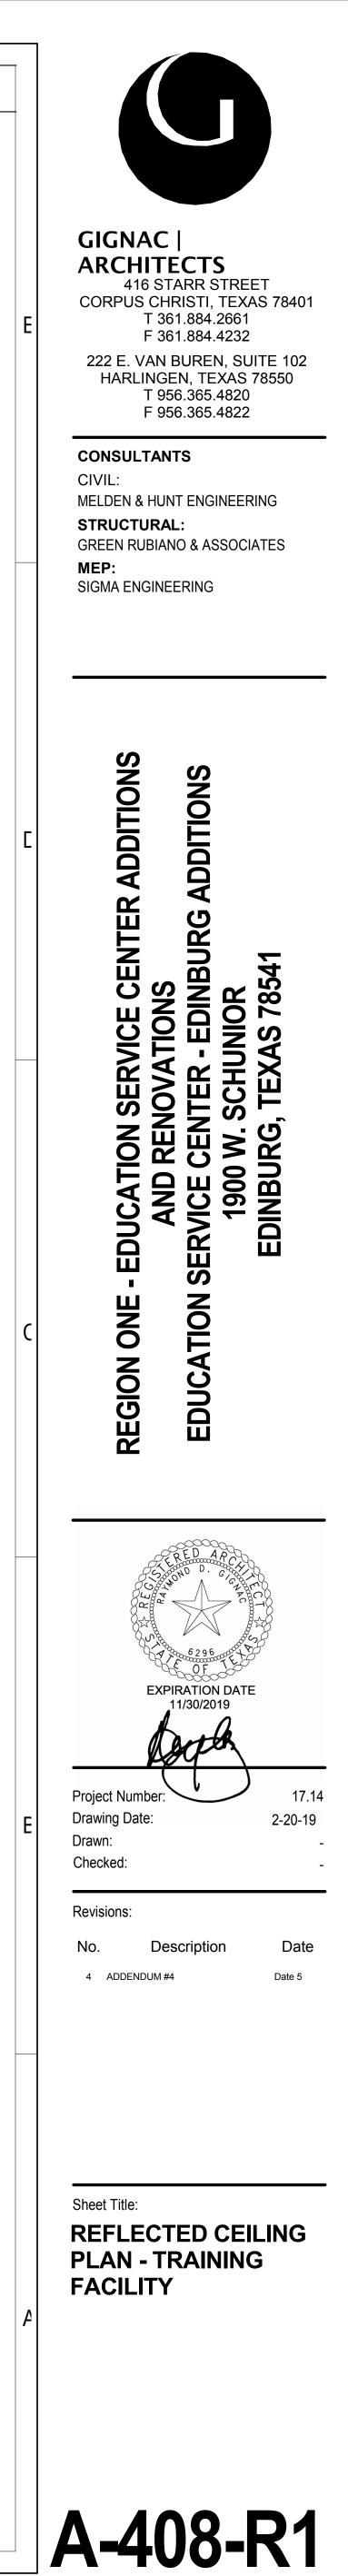


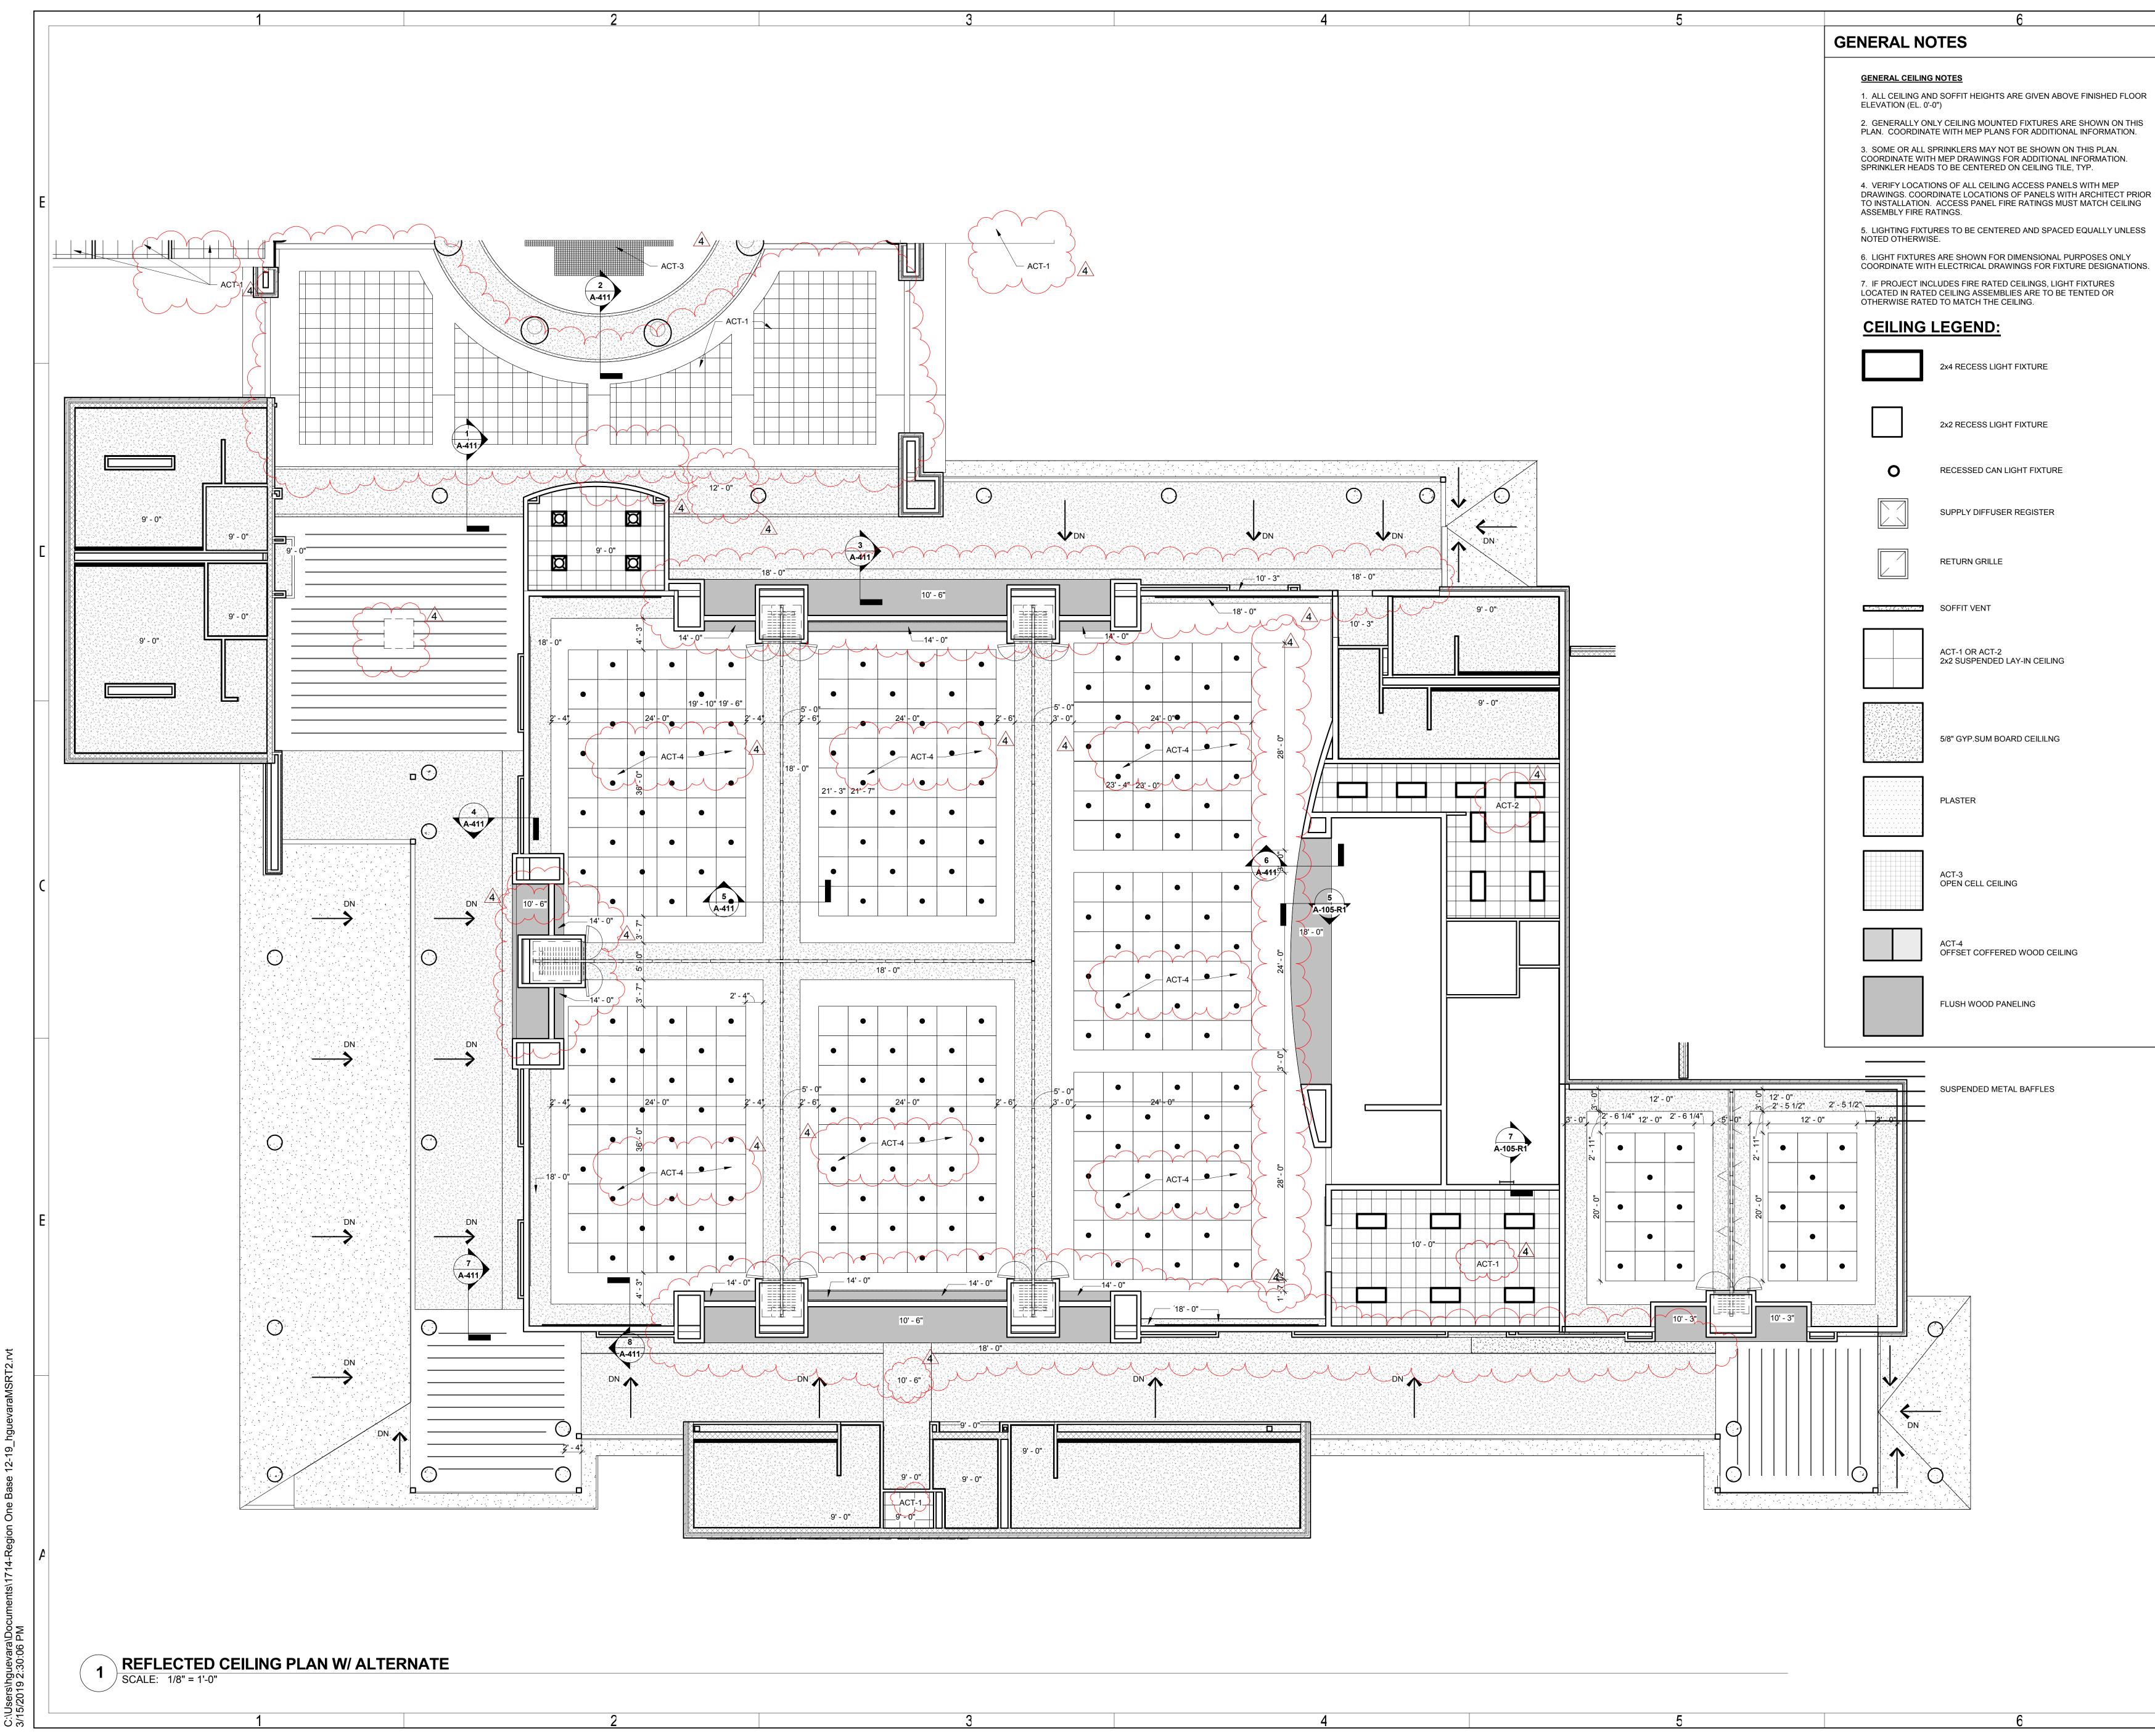

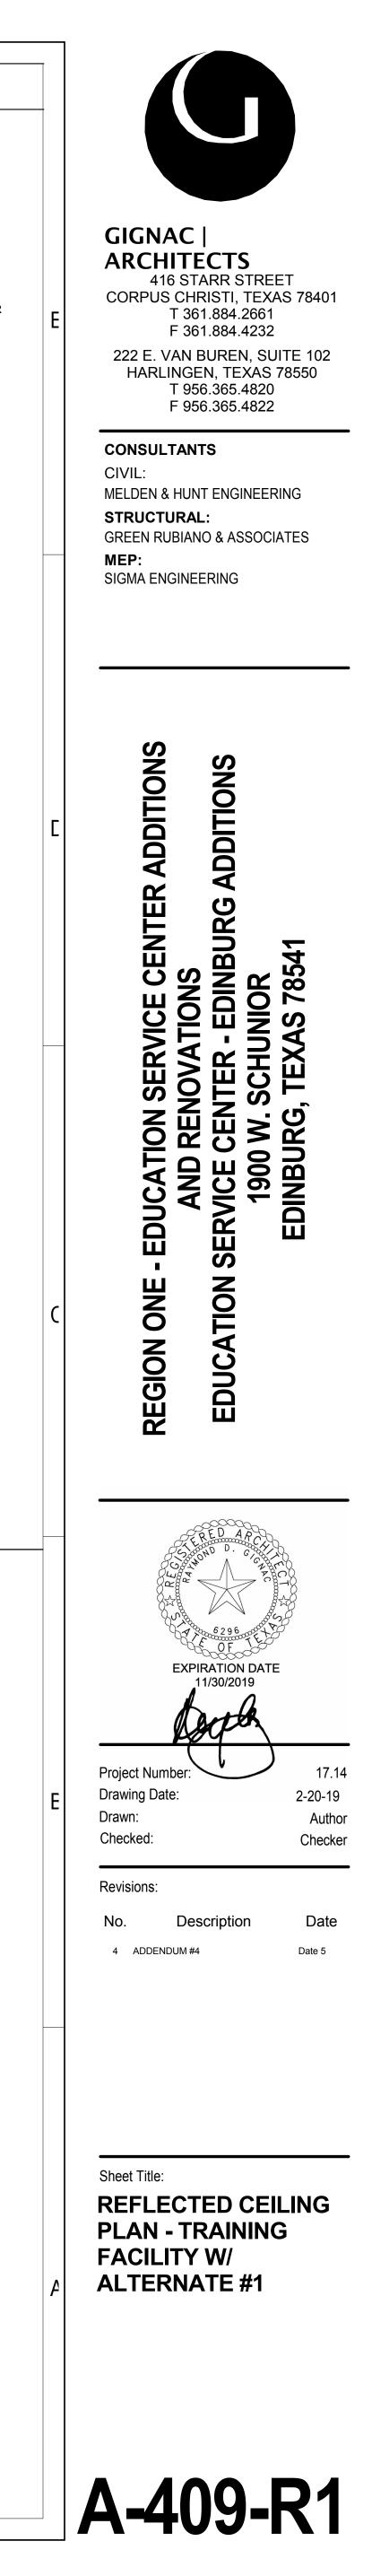



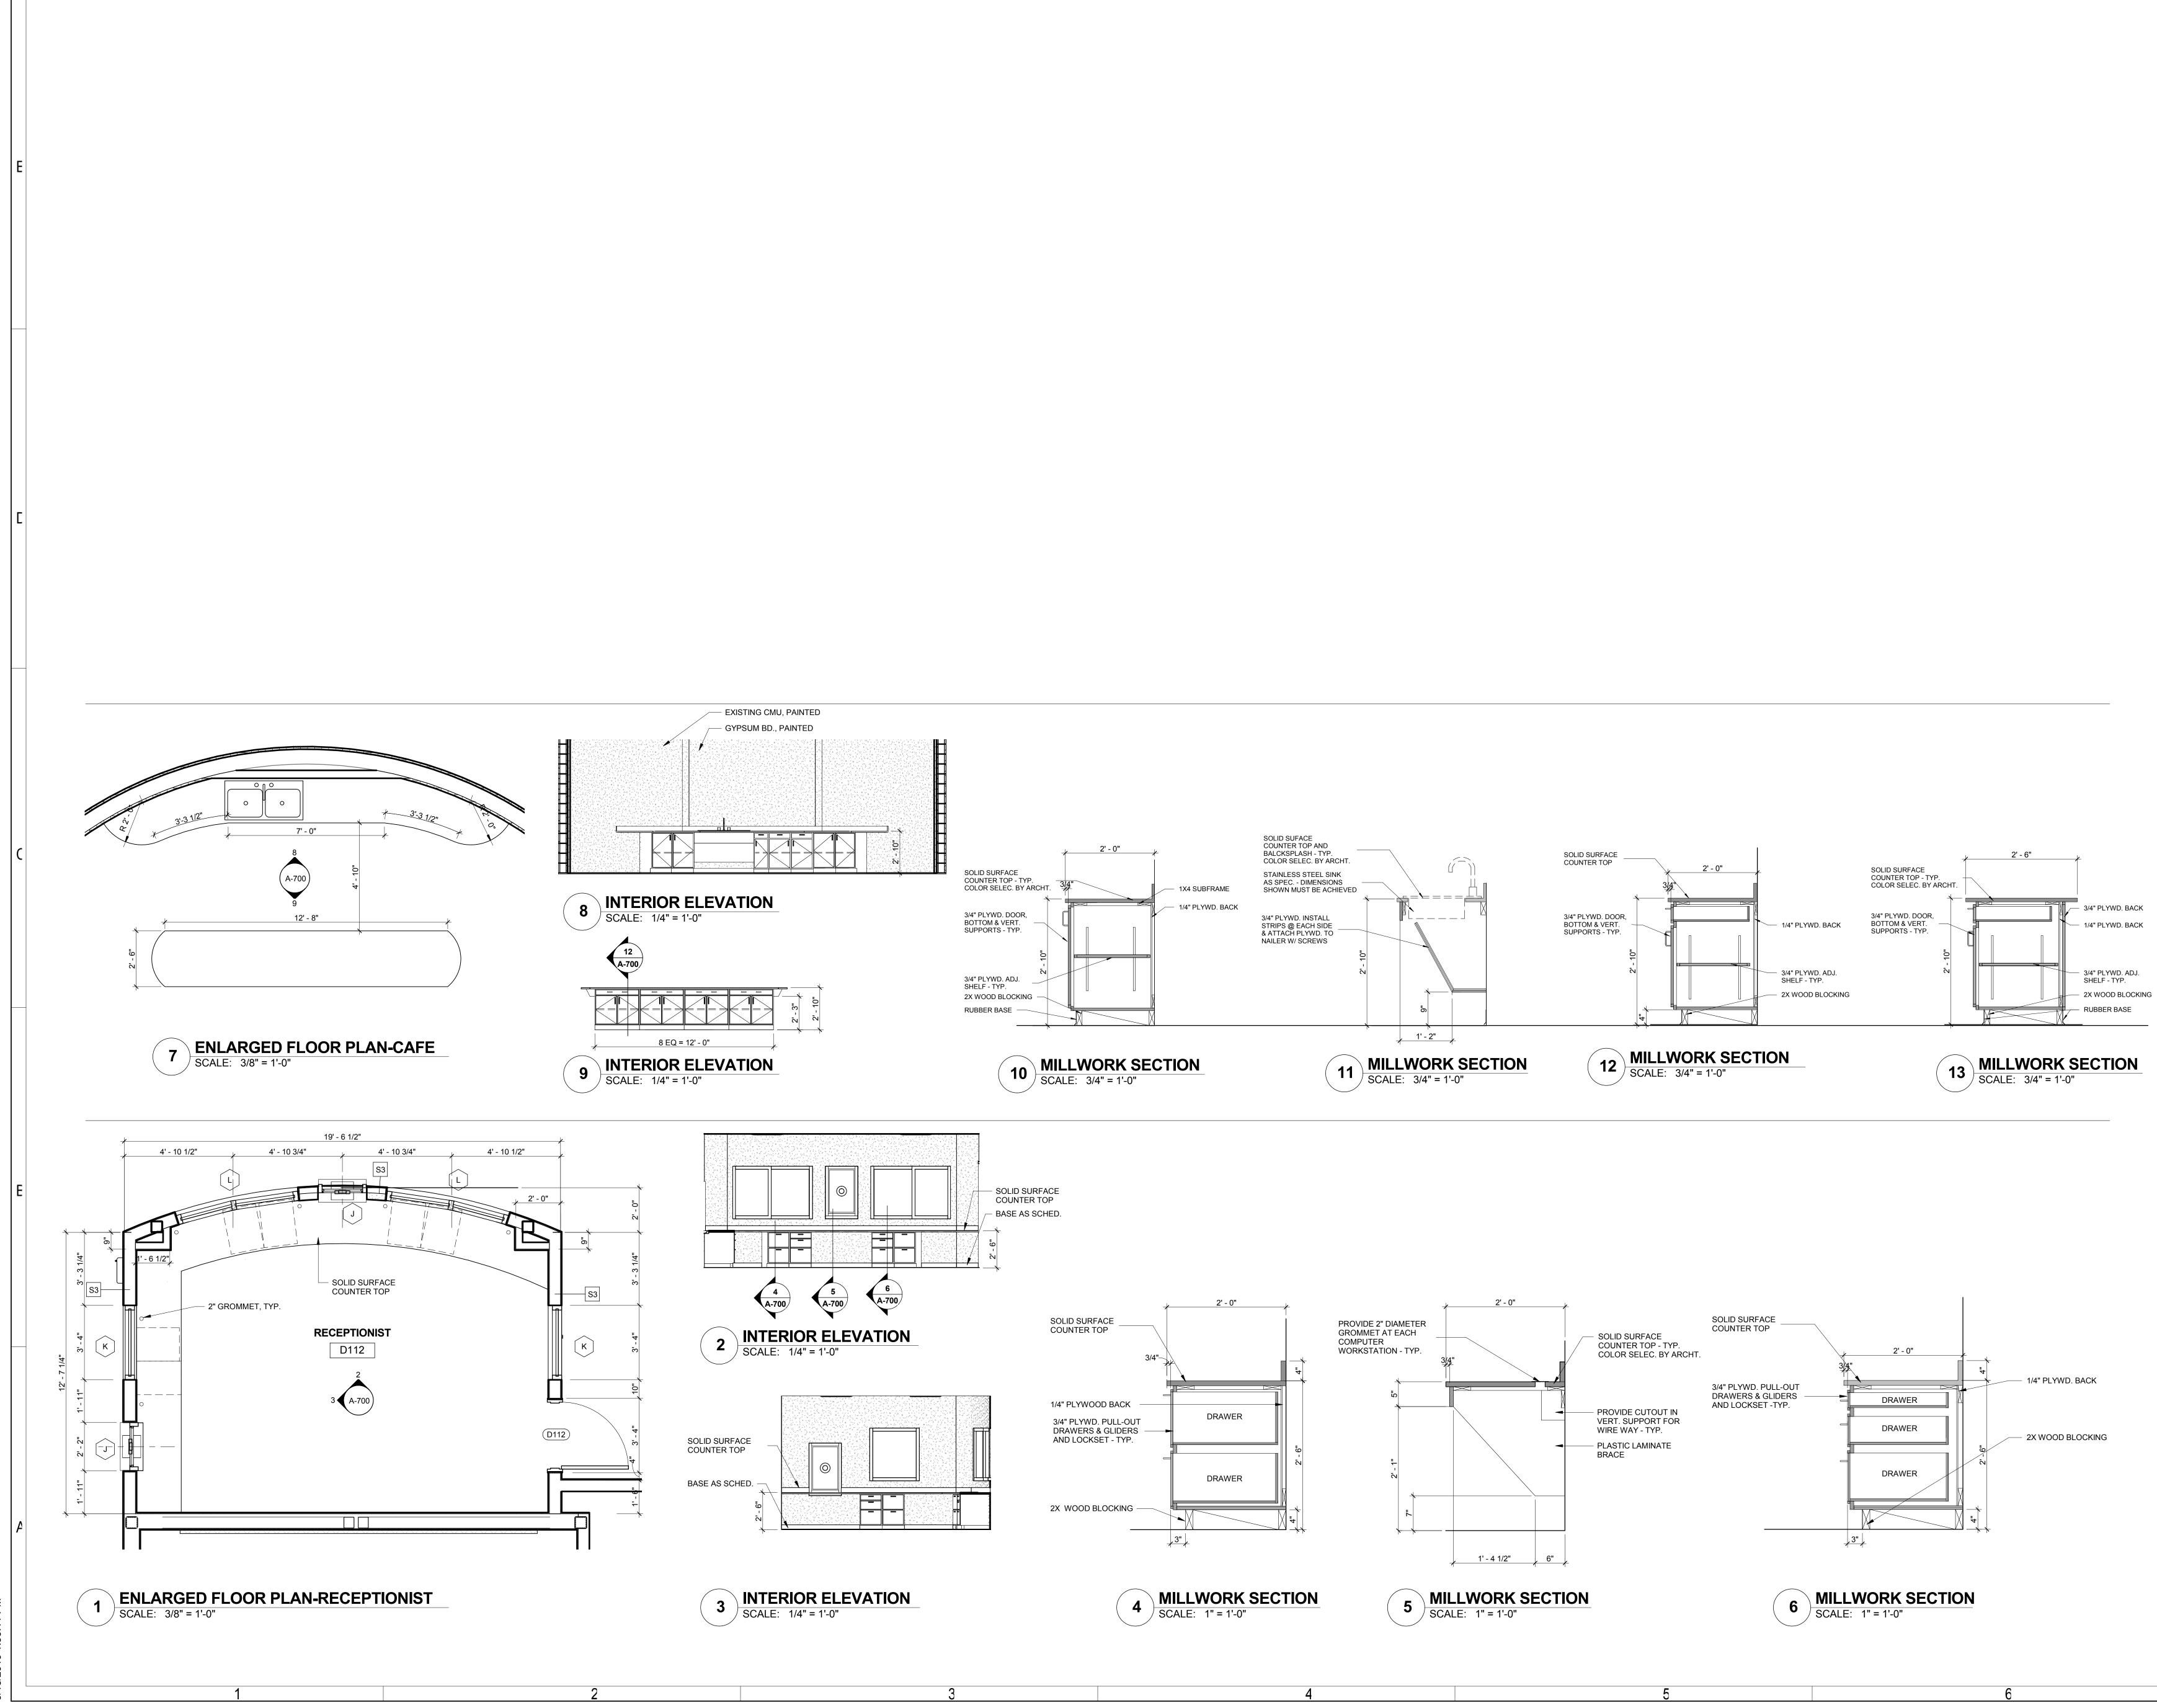


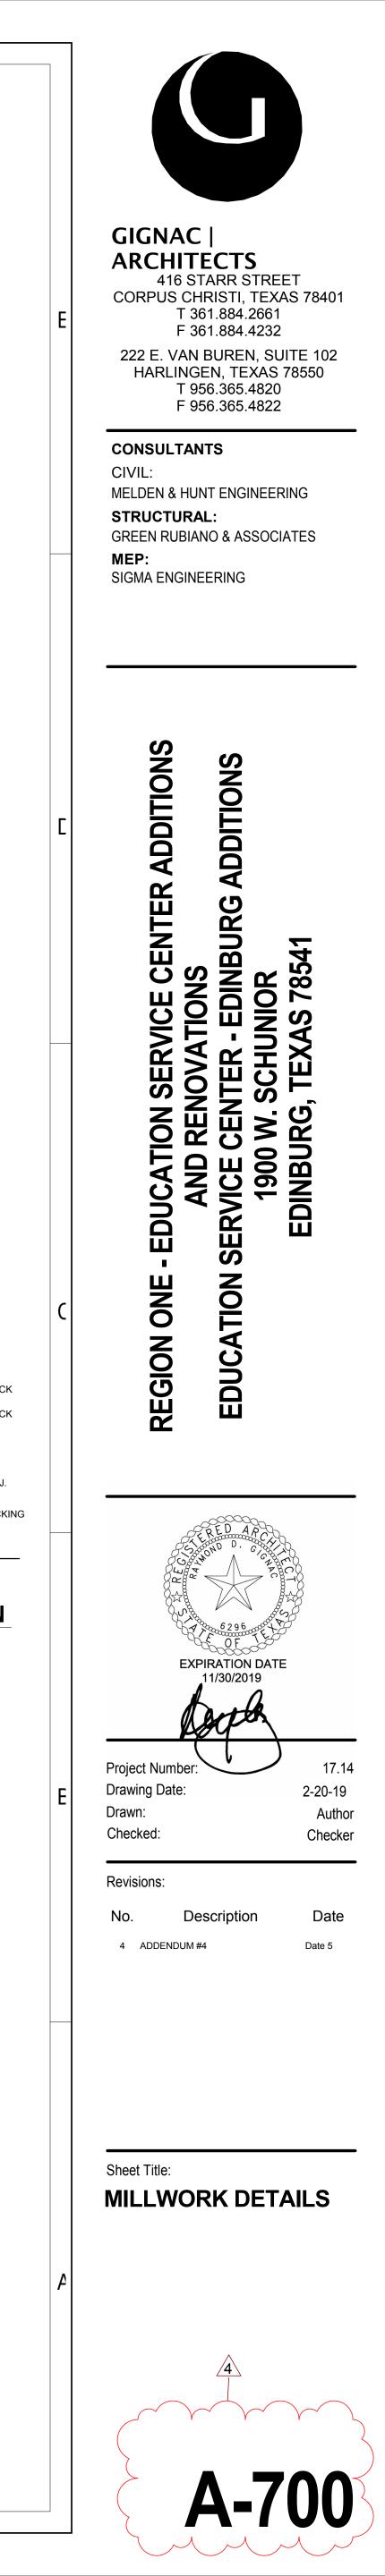


			ROC	DM FINIS	H <u>S</u> CHF					
DOOM					WALL FI					
ROOM NUMBER	ROOM NAME	FLOOR FINISH	BASE FINISH	NORTH	EAST	SOUTH	WEST	CEILING FINISH	CEILING HEIGHT	REMAR
A100	OFFICE	CARPET	RUBBER BASE	PAINT	PAINT	PAINT	PAINT	ACT	9'-0"	
A100	OFFICE	CARPET	RUBBER BASE	PAINT	PAINT	PAINT	PAINT	ACT	9'-0"	
A101 A102	STOR.	LVT	RUBBER BASE	PAINT	PAINT	PAINT	PAINT	ACT	9'-0"	
A102	STOR.	LVT	RUBBER BASE	PAINT	PAINT	PAINT	PAINT	ACT	9'-0"	
A104	OFFICE	CARPET	RUBBER BASE	PAINT	PAINT	PAINT	PAINT	ACT	9'-0"	
A105	OFFICE	CARPET	RUBBER BASE	PAINT	PAINT	PAINT	PAINT	ACT	9'-0"	
A106	OFFICE	CARPET	RUBBER BASE	PAINT	PAINT	PAINT	PAINT	ACT	9'-0"	
A107	OFFICE	CARPET	RUBBER BASE	PAINT	PAINT	PAINT	PAINT	ACT	9'-0"	
A108	OFFICE	CARPET	RUBBER BASE	PAINT	PAINT	PAINT	PAINT	ACT	9'-0"	
A109	OFFICE	CARPET	RUBBER BASE	PAINT	PAINT	PAINT	PAINT	ACT	9'-0"	
A110	COPY ROOM	CARPET	RUBBER BASE	PAINT	PAINT	PAINT	PAINT	ACT	9'-0"	
A111	FILE ROOM	CARPET	RUBBER BASE	PAINT	PAINT	PAINT	PAINT	ACT	9'-0"	
A112	P/A	CARPET	RUBBER BASE	PAINT	PAINT	PAINT	PAINT	ACT	9'-0"	
B100	CAFE	LVT	RUBBER BASE	PAINT	PAINT	PAINT	PAINT	OPEN CELL GRID	13'-0"	
B101	VESTIBULE	STAINED CONCRETE	RUBBER BASE	PAINT	PAINT	PAINT	PAINT	ACT	11'-0"	
C100	OFFICE	CARPET	RUBBER BASE	PAINT	PAINT	PAINT	PAINT	ACT	9'-0"	
C100	L.P. ASSIST.	CARPET	RUBBER BASE	PAINT	PAINT	PAINT	PAINT	ACT	9'-0"	
C101	OPERATIONS	CARPET	RUBBER BASE	PAINT	PAINT	PAINT	PAINT	ACT	9'-0"	
C102	CORRIDOR	LVT	RUBBER BASE	PAINT	PAINT	PAINT	PAINT	ACT	9'-0"	
C104	STR.		RUBBER BASE	PAINT	PAINT			ACT	9'-0"	
C105		CARPET	RUBBER BASE	PAINT	PAINT	PAINT	PAINT	ACT	9'-0"	
C106	TRAINING ROOM A1	CARPET	RUBBER BASE	PAINT	PAINT	PAINT	PAINT	ACT	10'-0"	
C107	TRAINING ROOM B1	CARPET	RUBBER BASE	PAINT	PAINT	PAINT	PAINT	ACT	12'-0"	
C108	TRAINING ROOM C1	CARPET	RUBBER BASE	PAINT	PAINT	PAINT	PAINT	ACT	14'-0"	
C109	TRAINING ROOM D1	CARPET	RUBBER BASE	PAINT	PAINT	PAINT	PAINT	ACT	14'-0"	
D100	MEN'S RESTROOM	CERAMIC TILE	TILE BASE	CERAMIC TILE	CERAMIC	CERAMIC	CERAMIC TILE	GYP.	9'-0"	
					TILE	TILE				
D101	JAN.	SEALED CONCRETE	RUBBER BASE	PAINT	PAINT	PAINT	PAINT	GYP.	9'-0"	
D102	FAMILY RESTROOM	CERAMIC TILE	TILE BASE	CERAMIC TILE	CERAMIC	CERAMIC TILE	CERAMIC TILE	GYP.	9'-0"	
D103	WOMEN'S RESTROOM	CERAMIC TILE	TILE BASE	CERAMIC TILE	CERAMIC	CERAMIC	CERAMIC TILE	GYP.	9'-0"	
D 404					TILE	TILE				
D104	LOBBY	STAINED CONCRETE	RUBBER BASE	PAINT/WOOD	PAINT/WOOD			GYP./BAFFLES	VARIES	
D105	VESTIBULE	STAINED CONCRETE	RUBBER BASE	PAINT	PAINT	PAINT	PAINT	GYP.	VARIES	
D106	LOUNGE	STAINED CONCRETE	RUBBER BASE	PAINT	PAINT	PAINT	PAINT	ACT	14'-0"	
D110	CORRIDOR	STAINED CONCRETE	RUBBER BASE	PAINT/WOOD	PAINT/WOOD	PAINT/WOOD	PAINT/WOOD	ACT	VARIES	
D111	LOBBY	STAINED CONCRETE	RUBBER BASE	PAINT/WOOD	PAINT/WOOD	PAINT/WOOD	PAINT/WOOD	ACT/BAFFLES	VARIES	
D112	RECEPTIONIST	STAINED CONCRETE	RUBBER BASE	PAINT	PAINT	PAINT	PAINT	ACT	9'-0"	
D113	TRAINING ROOM A	CARPET	RUBBER BASE	PAINT/WOOD	PAINT/WOOD	PAINT/WOOD	PAINT/WOOD	COFFERED CEILING	VARIES	
D114	TRAINING ROOM C	CARPET	RUBBER BASE	PAINT/WOOD	PAINT/WOOD	PAINT/WOOD	PAINT/WOOD	COFFERED CEILING	VARIES	
D115	TRAINING ROOM B	CARPET	RUBBER BASE	PAINT/WOOD	PAINT/WOOD	PAINT/WOOD	PAINT/WOOD	COFFERED	VARIES	
D440		0400ET						CEILING		
D116	TRAINING ROOM D	CARPET	RUBBER BASE	PAINT/WOOD		PAINT/WOOD		COFFERED CEILING	VARIES	
D117	TRAINING ROOM E	CARPET	RUBBER BASE	PAINT/WOOD	PAINT/WOOD	PAINT/WOOD	PAINT/WOOD	COFFERED CEILING	VARIES	
D118	PLATFORM	WOOD	RUBBER BASE	PAINT	PAINT	PAINT	PAINT	OPEN		
D119	CORRIDOR	STAINED CONCRETE	RUBBER BASE	PAINT/WOOD	PAINT/WOOD	PAINT/WOOD	PAINT/WOOD	GYP.	VARIES	
D120	VESTIBULE	CARPET	RUBBER BASE	PAINT	PAINT	PAINT	PAINT	GYP.	9'-0"	
D120	MEN'S RESTROOM	CERAMIC TILE	TILE BASE	CERAMIC TILE	CERAMIC	CERAMIC	CERAMIC TILE	GYP.	9'-0"	
D122	WOMEN'S RESTROOM	CERAMIC TILE	TILE BASE	CERAMIC TILE	CERAMIC	CERAMIC	CERAMIC TILE	GYP.	9'-0"	
D 100					TILE	TILE			<u></u>	
D123	FOOD PREP	LVT	RUBBER BASE	PAINT	PAINT	PAINT	PAINT	ACT	9'-0"	
D124	MDF	LVT	RUBBER BASE	PAINT	PAINT	PAINT	PAINT	OPEN		
D125	RISER ROOM	SEALED CONCRETE	RUBBER BASE	PAINT	PAINT	PAINT	PAINT	OPEN		
D126	MECH.	SEALED CONCRETE	RUBBER BASE	PAINT	PAINT	PAINT	PAINT	OPEN		
D127	ELEC.	SEALED CONCRETE	RUBBER BASE	PAINT	PAINT	PAINT	PAINT	OPEN		
D128	T/C STORAGE	LVT	RUBBER BASE	PAINT	PAINT	PAINT	PAINT	ACT	10'-0"	
D130	MEN'S RESTROOM	CERAMIC TILE	TILE BASE	CERAMIC TILE	CERAMIC	CERAMIC	CERAMIC TILE	GYP.	9'-0"	
D131	JAN.	SEALED CONCRETE	RUBBER BASE	PAINT	PAINT	PAINT	PAINT	ACT	9'-0"	
D132	FAMILY RESTROOOM		TILE BASE		CERAMIC	CERAMIC		GYP.	9'-0"	
D133	WOMEN'S RESTROOM	CERAMIC TILE	TILE BASE	CERAMIC TILE	CERAMIC TILE	CERAMIC TILE	CERAMIC TILE	GYP.	9'-0"	
D134	LOBBY	STAINED CONCRETE	RUBBER BASE	PAINT/WOOD	PAINT/WOOD		PAINT/WOOD	GYP./BAFFLES	VARIES	





	ROOM FINISH SCHEDULE W/ ALTERNATE 1									
ROOM					WALL FI				CEILING	
NUMBER		FLOOR FINISH	BASE FINISH	NORTH	EAST	SOUTH	WEST		HEIGHT	REMARI
A100 A101	OFFICE OFFICE	CARPET CARPET	RUBBER BASE	PAINT PAINT	PAINT	PAINT PAINT	PAINT PAINT	ACT ACT	9'-0" 9'-0"	
A101 A102	STOR.	LVT	RUBBER BASE	PAINT	PAINT	PAINT	PAINT	ACT	9'-0"	
A102	STOR.	LVT	RUBBER BASE	PAINT	PAINT	PAINT	PAINT	ACT	9'-0"	
A103 A104	OFFICE	CARPET	RUBBER BASE	PAINT	PAINT	PAINT	PAINT	ACT	9'-0"	
	OFFICE	CARPET	RUBBER BASE		PAINT	PAINT	PAINT	ACT	9'-0"	
A105				PAINT						
A106	OFFICE	CARPET	RUBBER BASE	PAINT	PAINT	PAINT	PAINT	ACT	9'-0"	
A107	OFFICE	CARPET	RUBBER BASE	PAINT	PAINT	PAINT	PAINT	ACT	9'-0"	
A108	OFFICE	CARPET	RUBBER BASE	PAINT	PAINT	PAINT	PAINT	ACT	9'-0"	
A109	OFFICE	CARPET	RUBBER BASE	PAINT	PAINT	PAINT	PAINT	ACT	9'-0"	
A110	COPY ROOM	CARPET	RUBBER BASE	PAINT	PAINT	PAINT	PAINT	ACT	9'-0"	
A111	FILE ROOM	CARPET	RUBBER BASE	PAINT	PAINT	PAINT	PAINT	ACT	9'-0"	
A112	P/A	CARPET	RUBBER BASE	PAINT	PAINT	PAINT	PAINT	ACT	9'-0"	
B100	CAFE	LVT	RUBBER BASE	PAINT	PAINT	PAINT	PAINT	OPEN CELL GRID	13'-0"	
B101	VESTIBULE	STAINED CONCRETE	RUBBER BASE	PAINT	PAINT	PAINT	PAINT	ACT	11'-0"	
C100	OFFICE	CARPET	RUBBER BASE	PAINT	PAINT	PAINT	PAINT	ACT	9'-0"	
C101	L.P. ASSIST.	CARPET	RUBBER BASE	PAINT	PAINT	PAINT	PAINT	ACT	9'-0"	
C102	OPERATIONS	CARPET	RUBBER BASE	PAINT	PAINT	PAINT	PAINT	ACT	9'-0"	
C103	CORRIDOR	LVT	RUBBER BASE	PAINT	PAINT	PAINT	PAINT	ACT	9'-0"	
C104	STR.	LVT	RUBBER BASE	PAINT	PAINT	PAINT	PAINT	ACT	9'-0"	
C105	OFFICE	CARPET	RUBBER BASE	PAINT	PAINT	PAINT	PAINT	ACT	9'-0"	
C106	TRAINING ROOM A1	CARPET	RUBBER BASE	PAINT	PAINT	PAINT	PAINT	ACT	10'-0"	
C107	TRAINING ROOM B1	CARPET	RUBBER BASE	PAINT	PAINT	PAINT	PAINT	ACT	12'-0"	
C108	TRAINING ROOM C1	CARPET	RUBBER BASE	PAINT	PAINT	PAINT	PAINT	ACT	14'-0"	
C100	TRAINING ROOM D1	CARPET	RUBBER BASE	PAINT	PAINT	PAINT	PAINT	ACT	14'-0"	
D100	MEN'S RESTROOM	CERAMIC TILE	TILE BASE		CERAMIC TILE		CERAMIC TILE	GYP.	9'-0"	
D100	MENS RESTROOM	CERAIVIIC TILE	TILE DAGE			TILE	CERAIVIC TILE	GTP.	9-0	
D101	JAN.	SEALED CONCRETE	RUBBER BASE	PAINT	PAINT	PAINT	PAINT	GYP.	9'-0"	
D101	FAMILY RESTROOM	CERAMIC TILE			CERAMIC TILE		CERAMIC TILE	GYP.	9'-0"	
D102	FAMILI RESTRUCIM	CERAIVIIC TILE	TILE BASE	CERAIVIIC TILE		TILE	CERAIVIC TILE	GTP.	9-0	
D103	WOMEN'S RESTROOM	CERAMIC TILE	TILE BASE	CERAMIC TILE	CERAMIC TILE		CERAMIC TILE	GYP.	9'-0"	
D104	LOBBY	STAINED CONCRETE	RUBBER BASE	PAINT/WOOD			PAINT/WOOD	GYP./BAFFLES	VARIES	
D104	VESTIBULE	STAINED CONCRETE	RUBBER BASE	PAINT	PAINT	PAINT	PAINT	GYP.	VARIES	
	LOUNGE	STAINED CONCRETE			PAINT	PAINT	PAINT		14'-0"	
D106			RUBBER BASE	PAINT				ACT		
D110	CORRIDOR	STAINED CONCRETE	RUBBER BASE	PAINT/WOOD			PAINT/WOOD		VARIES	
D111	LOBBY	STAINED CONCRETE	RUBBER BASE	PAINT/WOOD			PAINT/WOOD	ACT/BAFFLES	VARIES	
D112	RECEPTIONIST	STAINED CONCRETE	RUBBER BASE	PAINT	PAINT	PAINT	PAINT	ACT	9'-0"	
D113		CARPET	RUBBER BASE	PAINT/WOOD			PAINT/WOOD	COFFERED CEILING	VARIES	
D114	TRAINING ROOM C	CARPET	RUBBER BASE	PAINT/WOOD PAINT/WOOD			PAINT/WOOD PAINT/WOOD	COFFERED CEILING COFFERED	VARIES	
D116	TRAINING ROOM B	CARPET	RUBBER BASE	PAINT/WOOD			PAINT/WOOD	CEILING	VARIES	
D110	TRAINING ROOM D	CARPET	RUBBER BASE		PAINT/WOOD			CEILING	VARIES	
								CEILING		
D118	PLATFORM	WOOD	RUBBER BASE	PAINT	PAINT	PAINT	PAINT	OPEN		
D119	CORRIDOR	STAINED CONCRETE	RUBBER BASE	PAINT/WOOD			PAINT/WOOD	GYP.	VARIES	
D120	VESTIBULE	CARPET	RUBBER BASE	PAINT	PAINT	PAINT	PAINT	GYP.	9'-0"	
D121	MEN'S RESTROOM	CERAMIC TILE	TILE BASE		CERAMIC TILE		CERAMIC TILE	GYP.	9'-0"	
D122	WOMEN'S RESTROOM	CERAMIC TILE	TILE BASE	CERAMIC TILE	CERAMIC TILE		CERAMIC TILE	GYP.	9'-0"	
D123	FOOD PREP	LVT	RUBBER BASE	PAINT	PAINT	PAINT	PAINT	ACT	9'-0"	
D123	MDF	LVT	RUBBER BASE	PAINT	PAINT	PAINT	PAINT	OPEN	~ ~ ~	
D124	RISER ROOM	SEALED CONCRETE	RUBBER BASE	PAINT	PAINT	PAINT	PAINT	OPEN		
D125	MECH.	SEALED CONCRETE	RUBBER BASE	PAINT	PAINT	PAINT	PAINT	OPEN		
D126	ELEC.	SEALED CONCRETE	RUBBER BASE	PAINT	PAINT	PAINT	PAINT	OPEN		
									10'-0"	
D128 D130	T/C STORAGE MEN'S RESTROOM	LVT CERAMIC TILE	RUBBER BASE TILE BASE	PAINT CERAMIC TILE	PAINT CERAMIC TILE	PAINT CERAMIC TILE	PAINT CERAMIC TILE	ACT GYP.	9'-0"	
D131	JAN.	SEALED CONCRETE	RUBBER BASE			PAINT		ACT	9'-0"	
D132	FAMILY RESTROOOM	CERAMIC TILE	TILE BASE		CERAMIC TILE	TILE		GYP.	9'-0"	
D133	WOMEN'S RESTROOM					TILE	CERAMIC TILE		9'-0"	
D134	LOBBY	STAINED CONCRETE	RUBBER BASE	PAINT/WOOD			PAINT/WOOD	GYP./BAFFLES	VARIES	
D135 D136	LOBBY TRAINING ROOM F	STAINED CONCRETE CARPET	RUBBER BASE RUBBER BASE	PAINT/WOOD PAINT/WOOD			PAINT/WOOD PAINT/WOOD	GYP./BAFFLES COFFERED	VARIES VARIES	
D137	TRAINING ROOM G	CARPET	RUBBER BASE	PAINT/WOOD	PAINT/WOOD	PAINT/WOOD	PAINT/WOOD	CEILING COFFERED	VARIES	

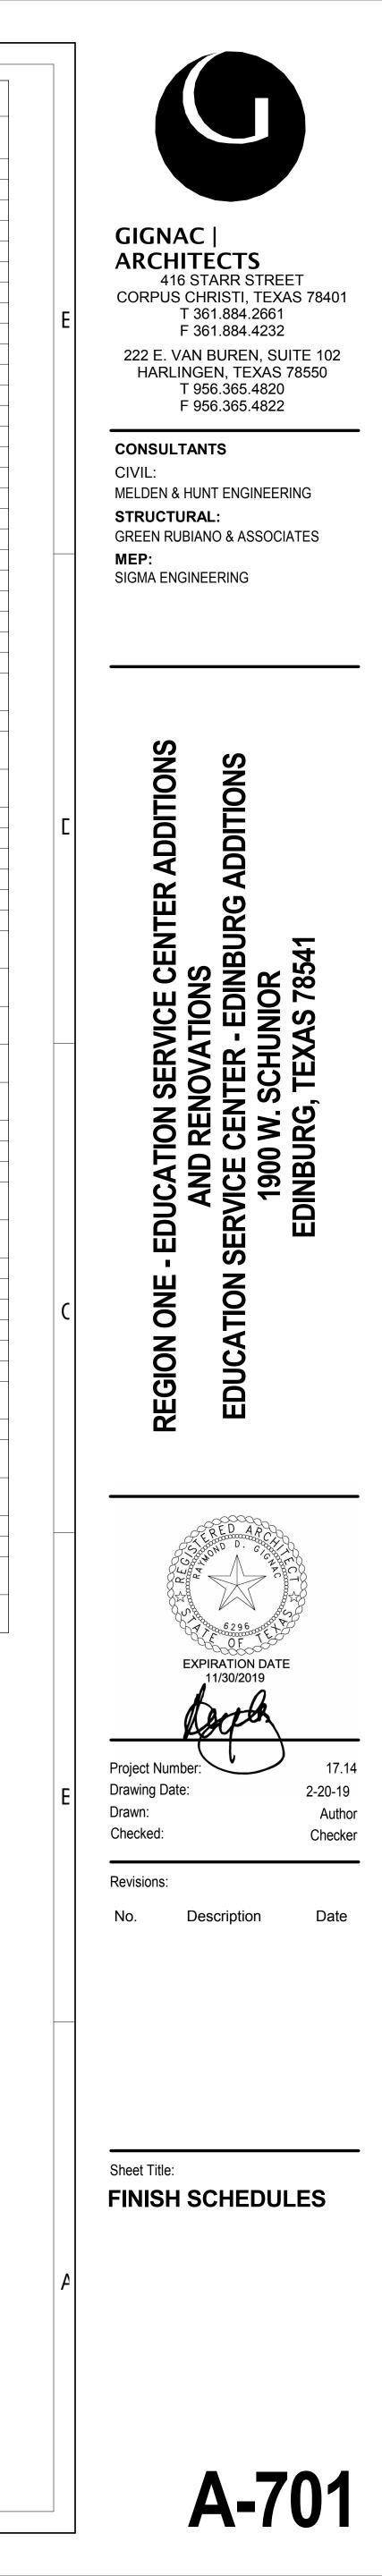




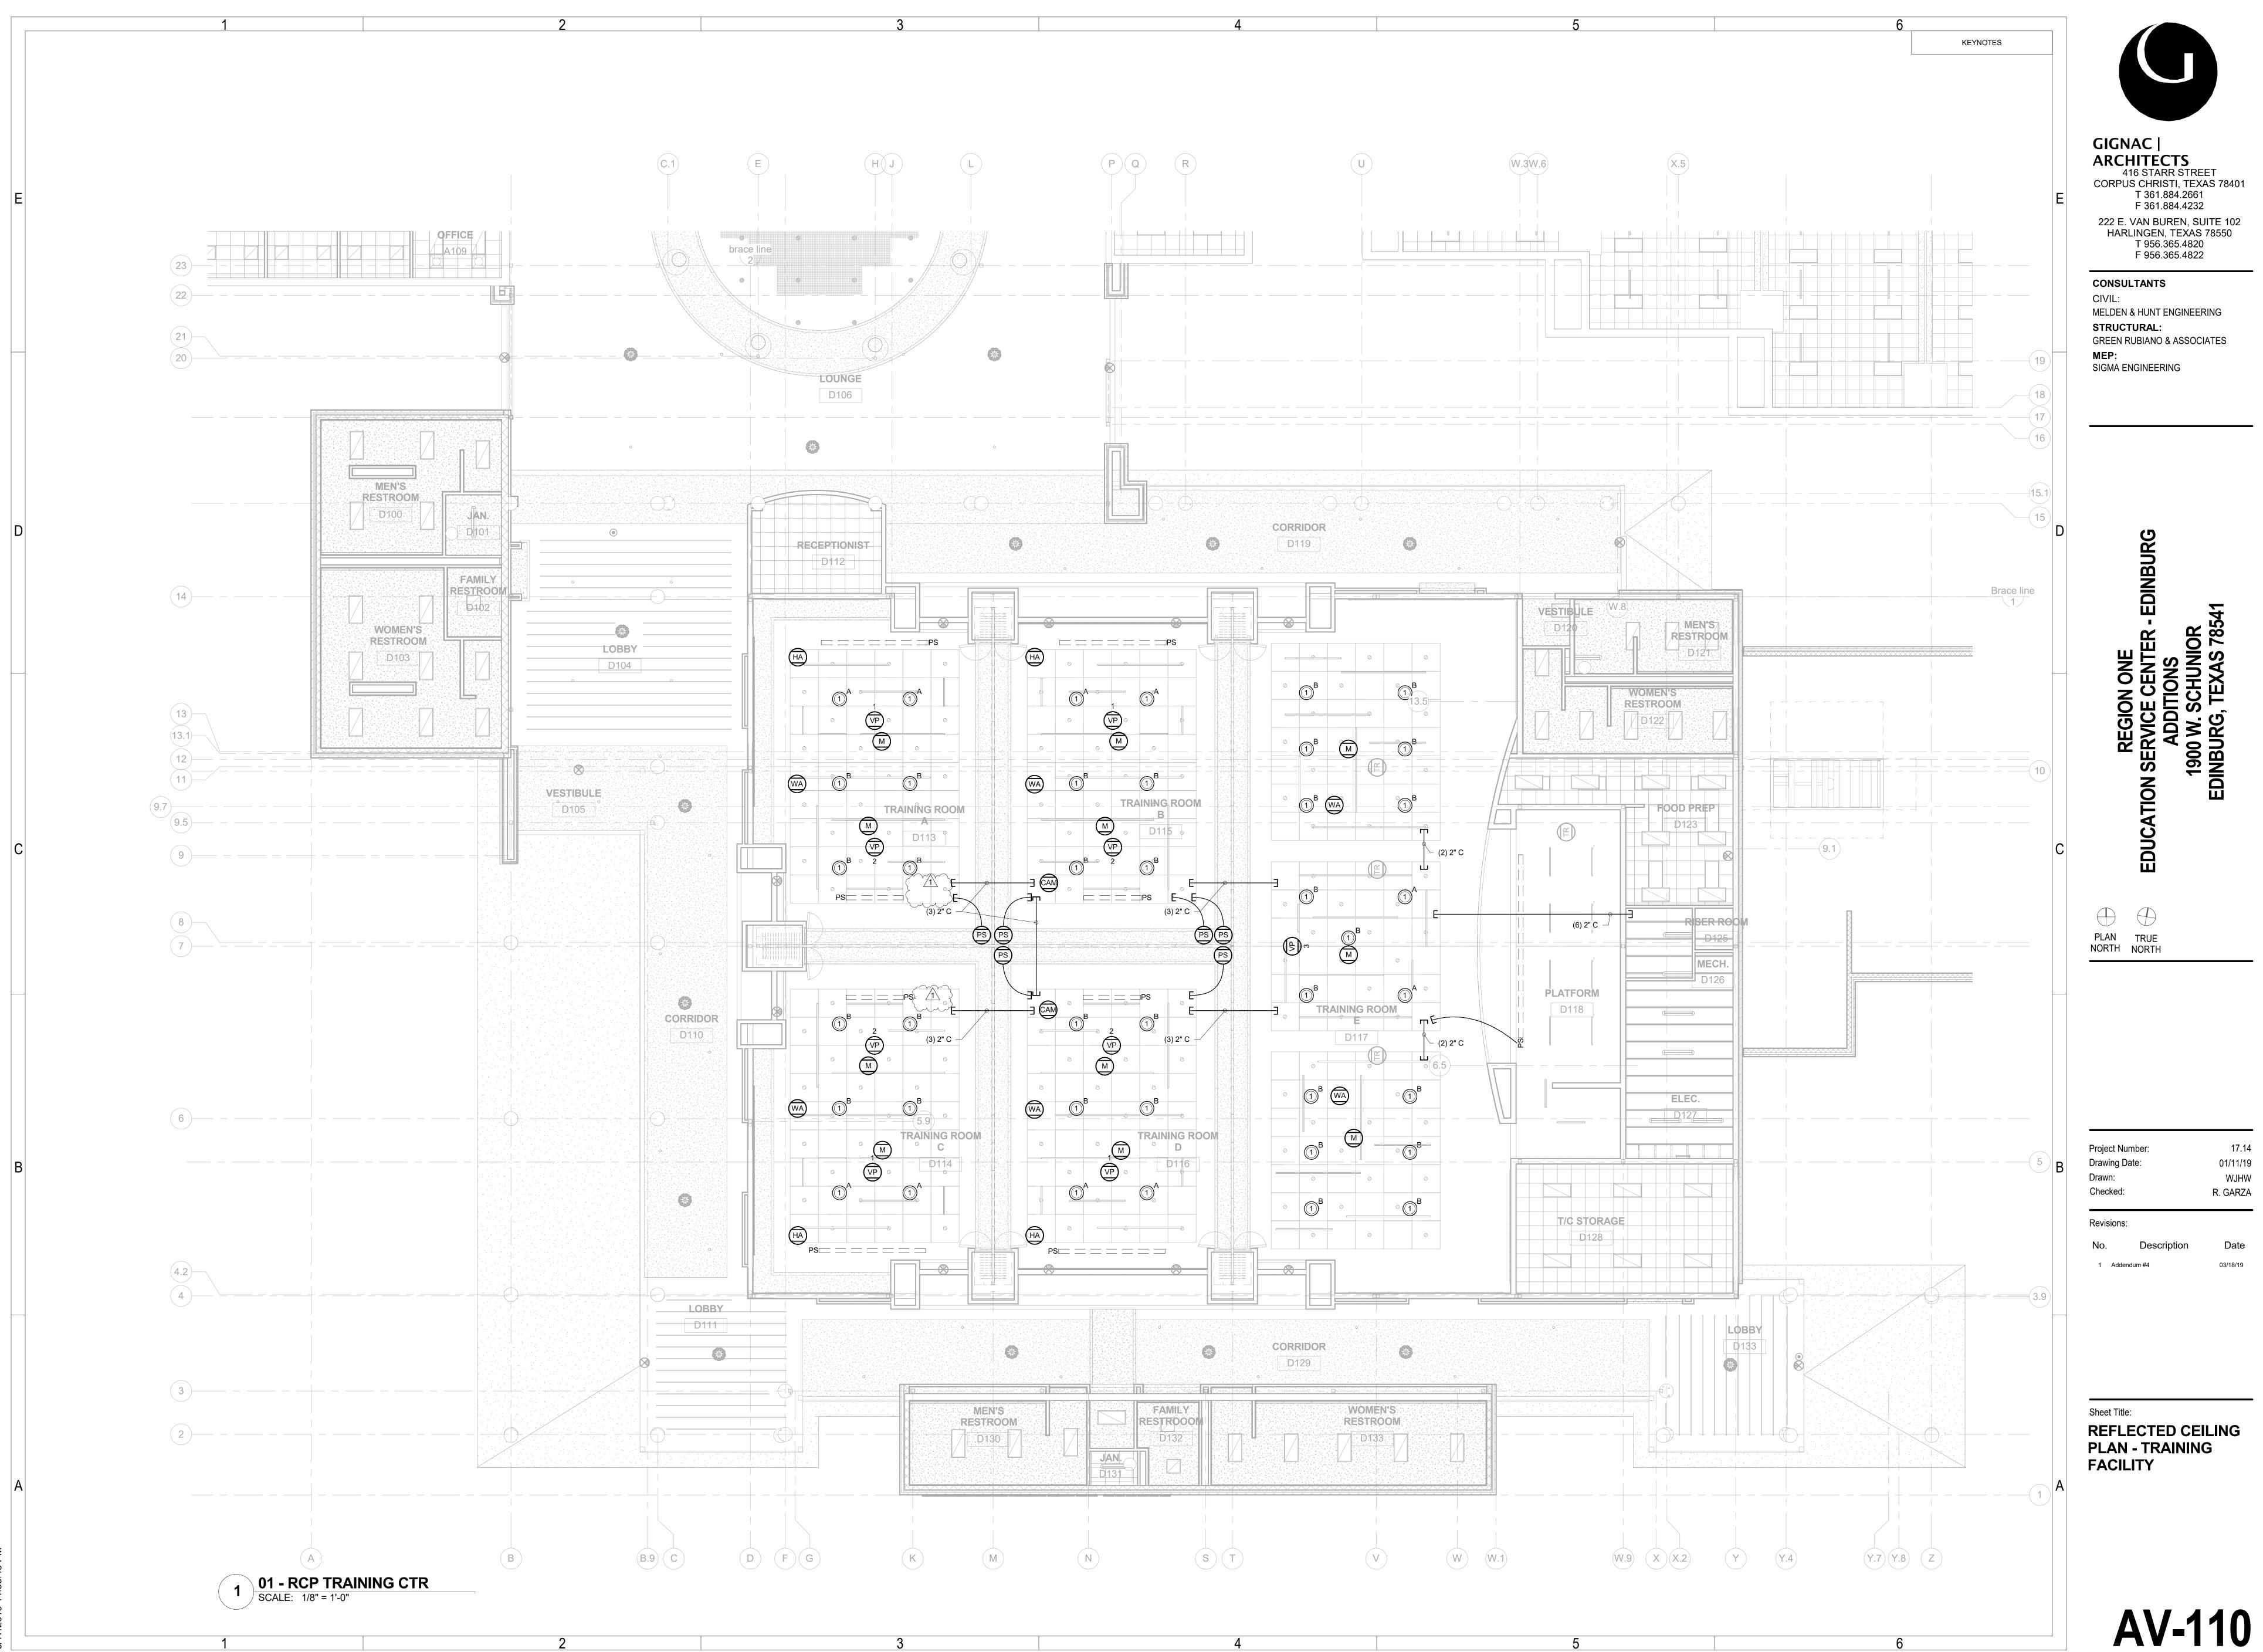

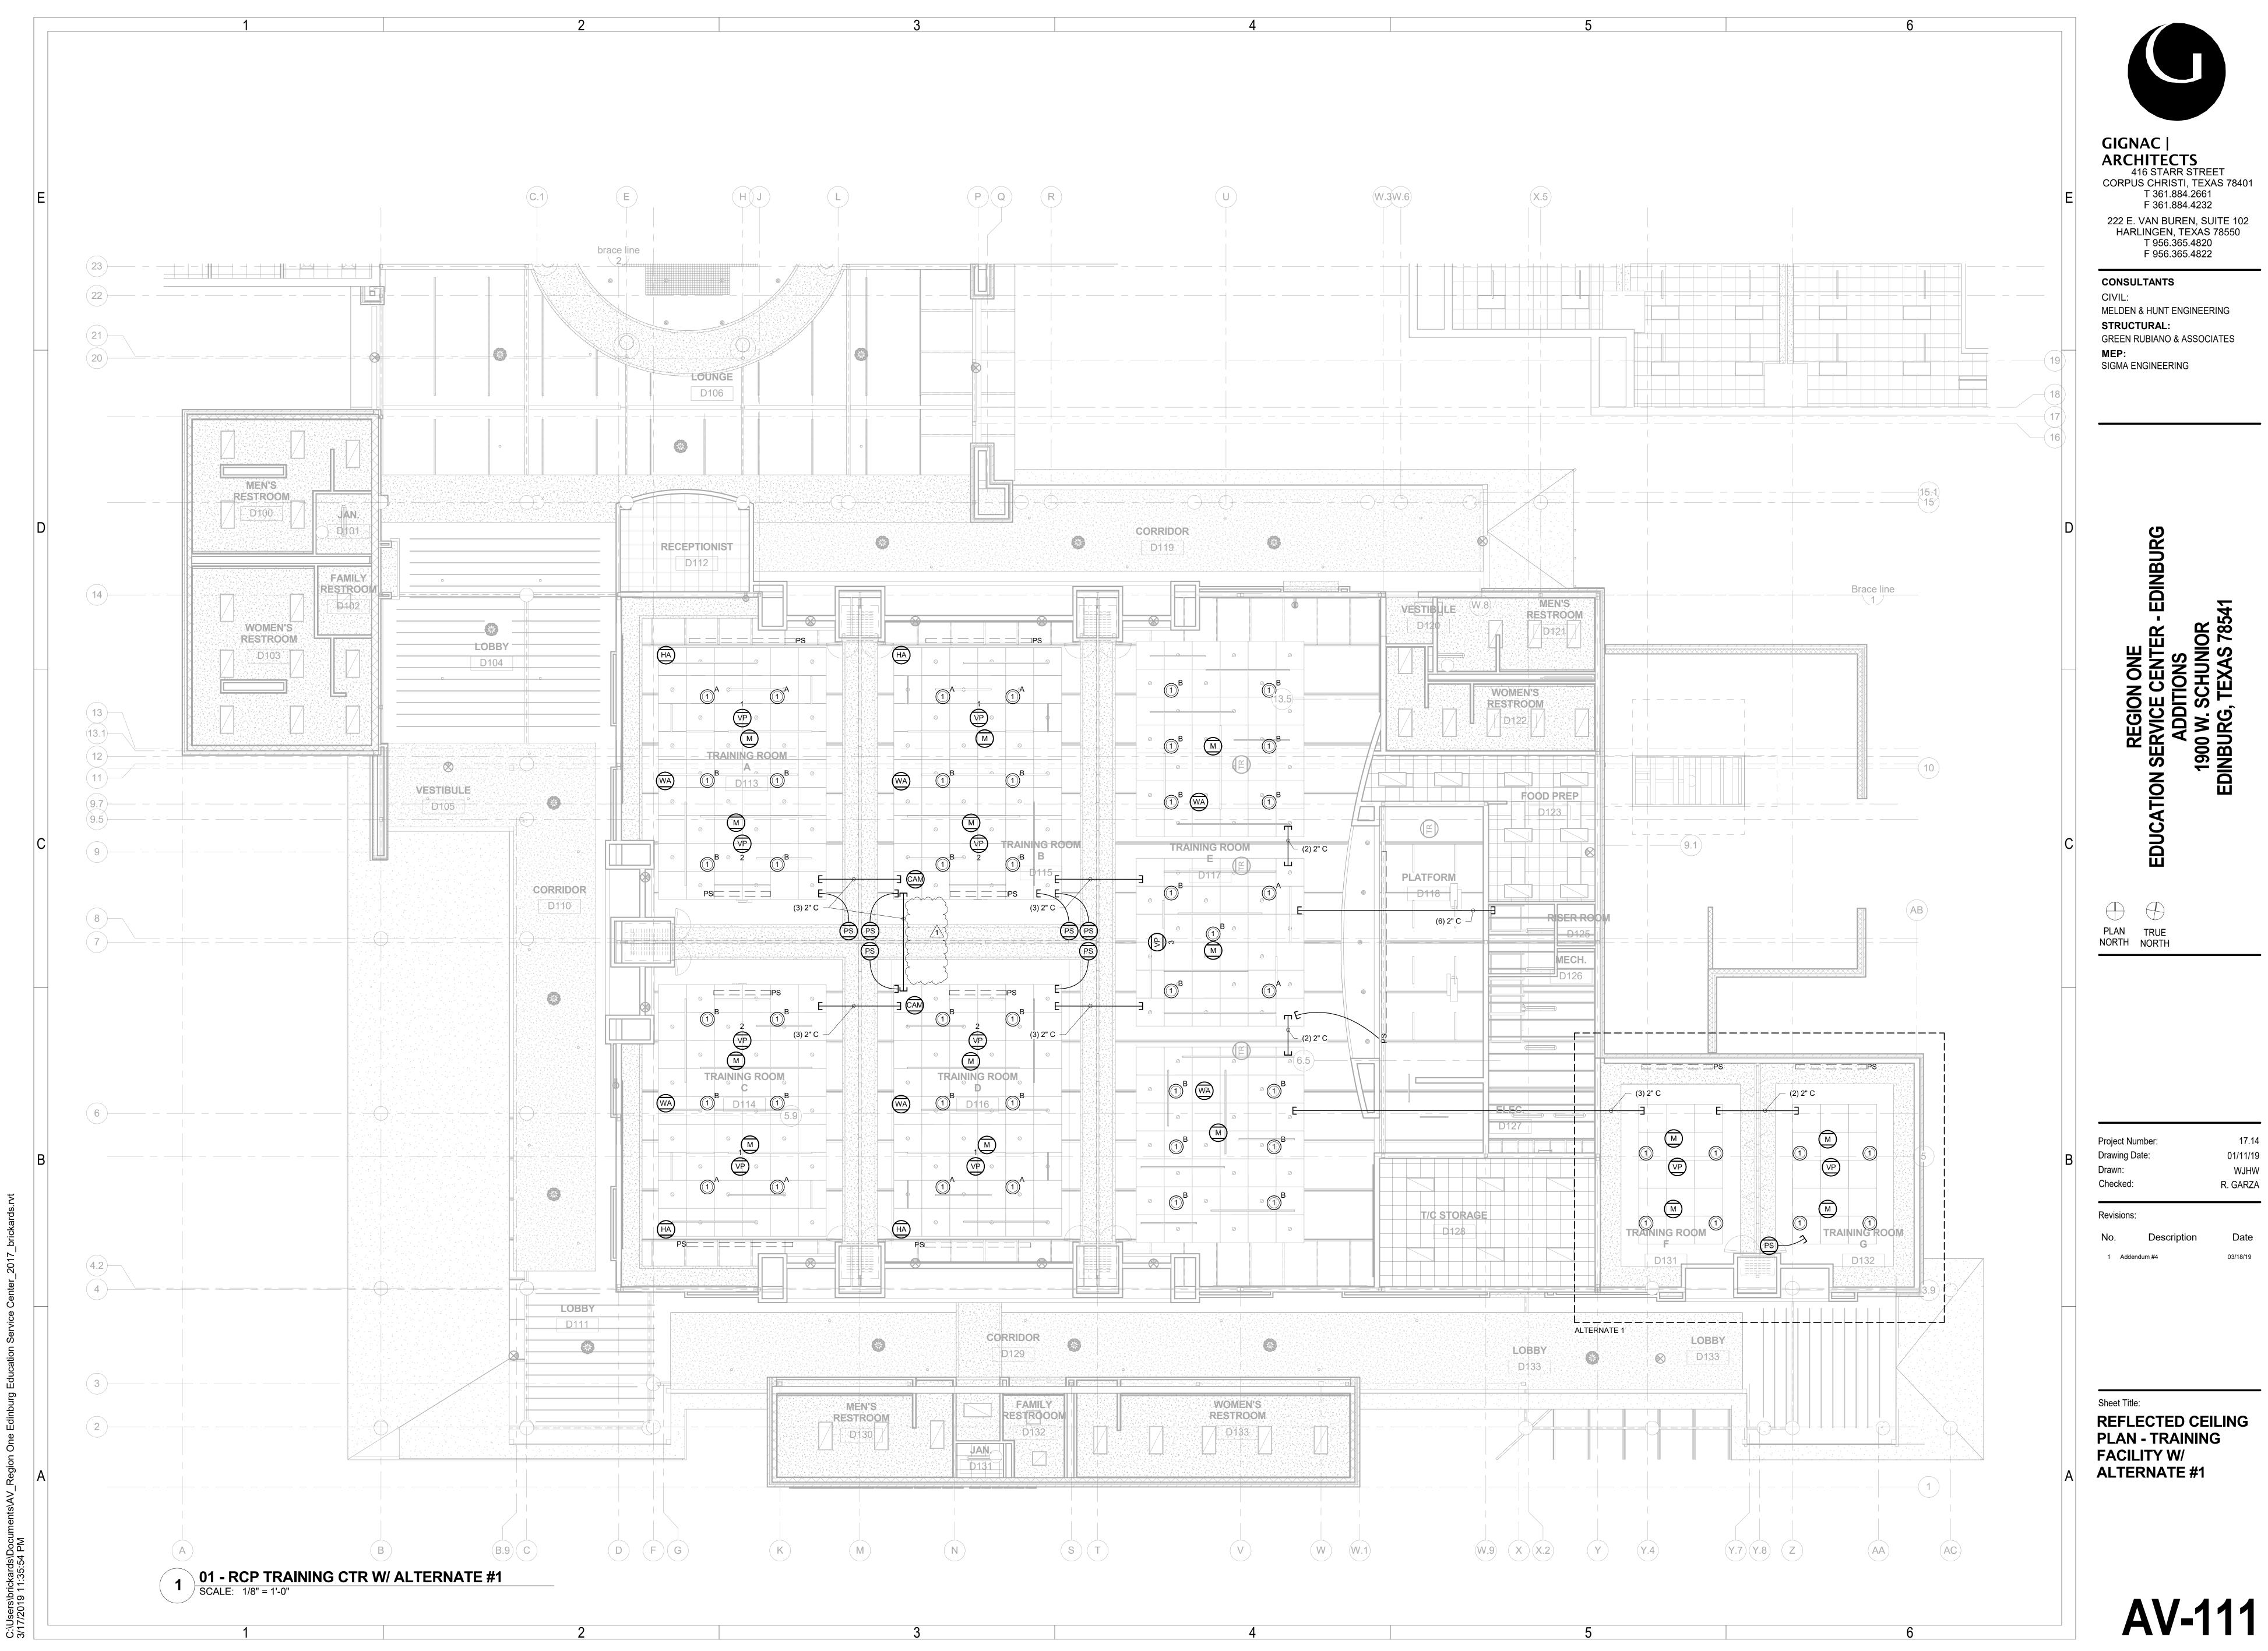

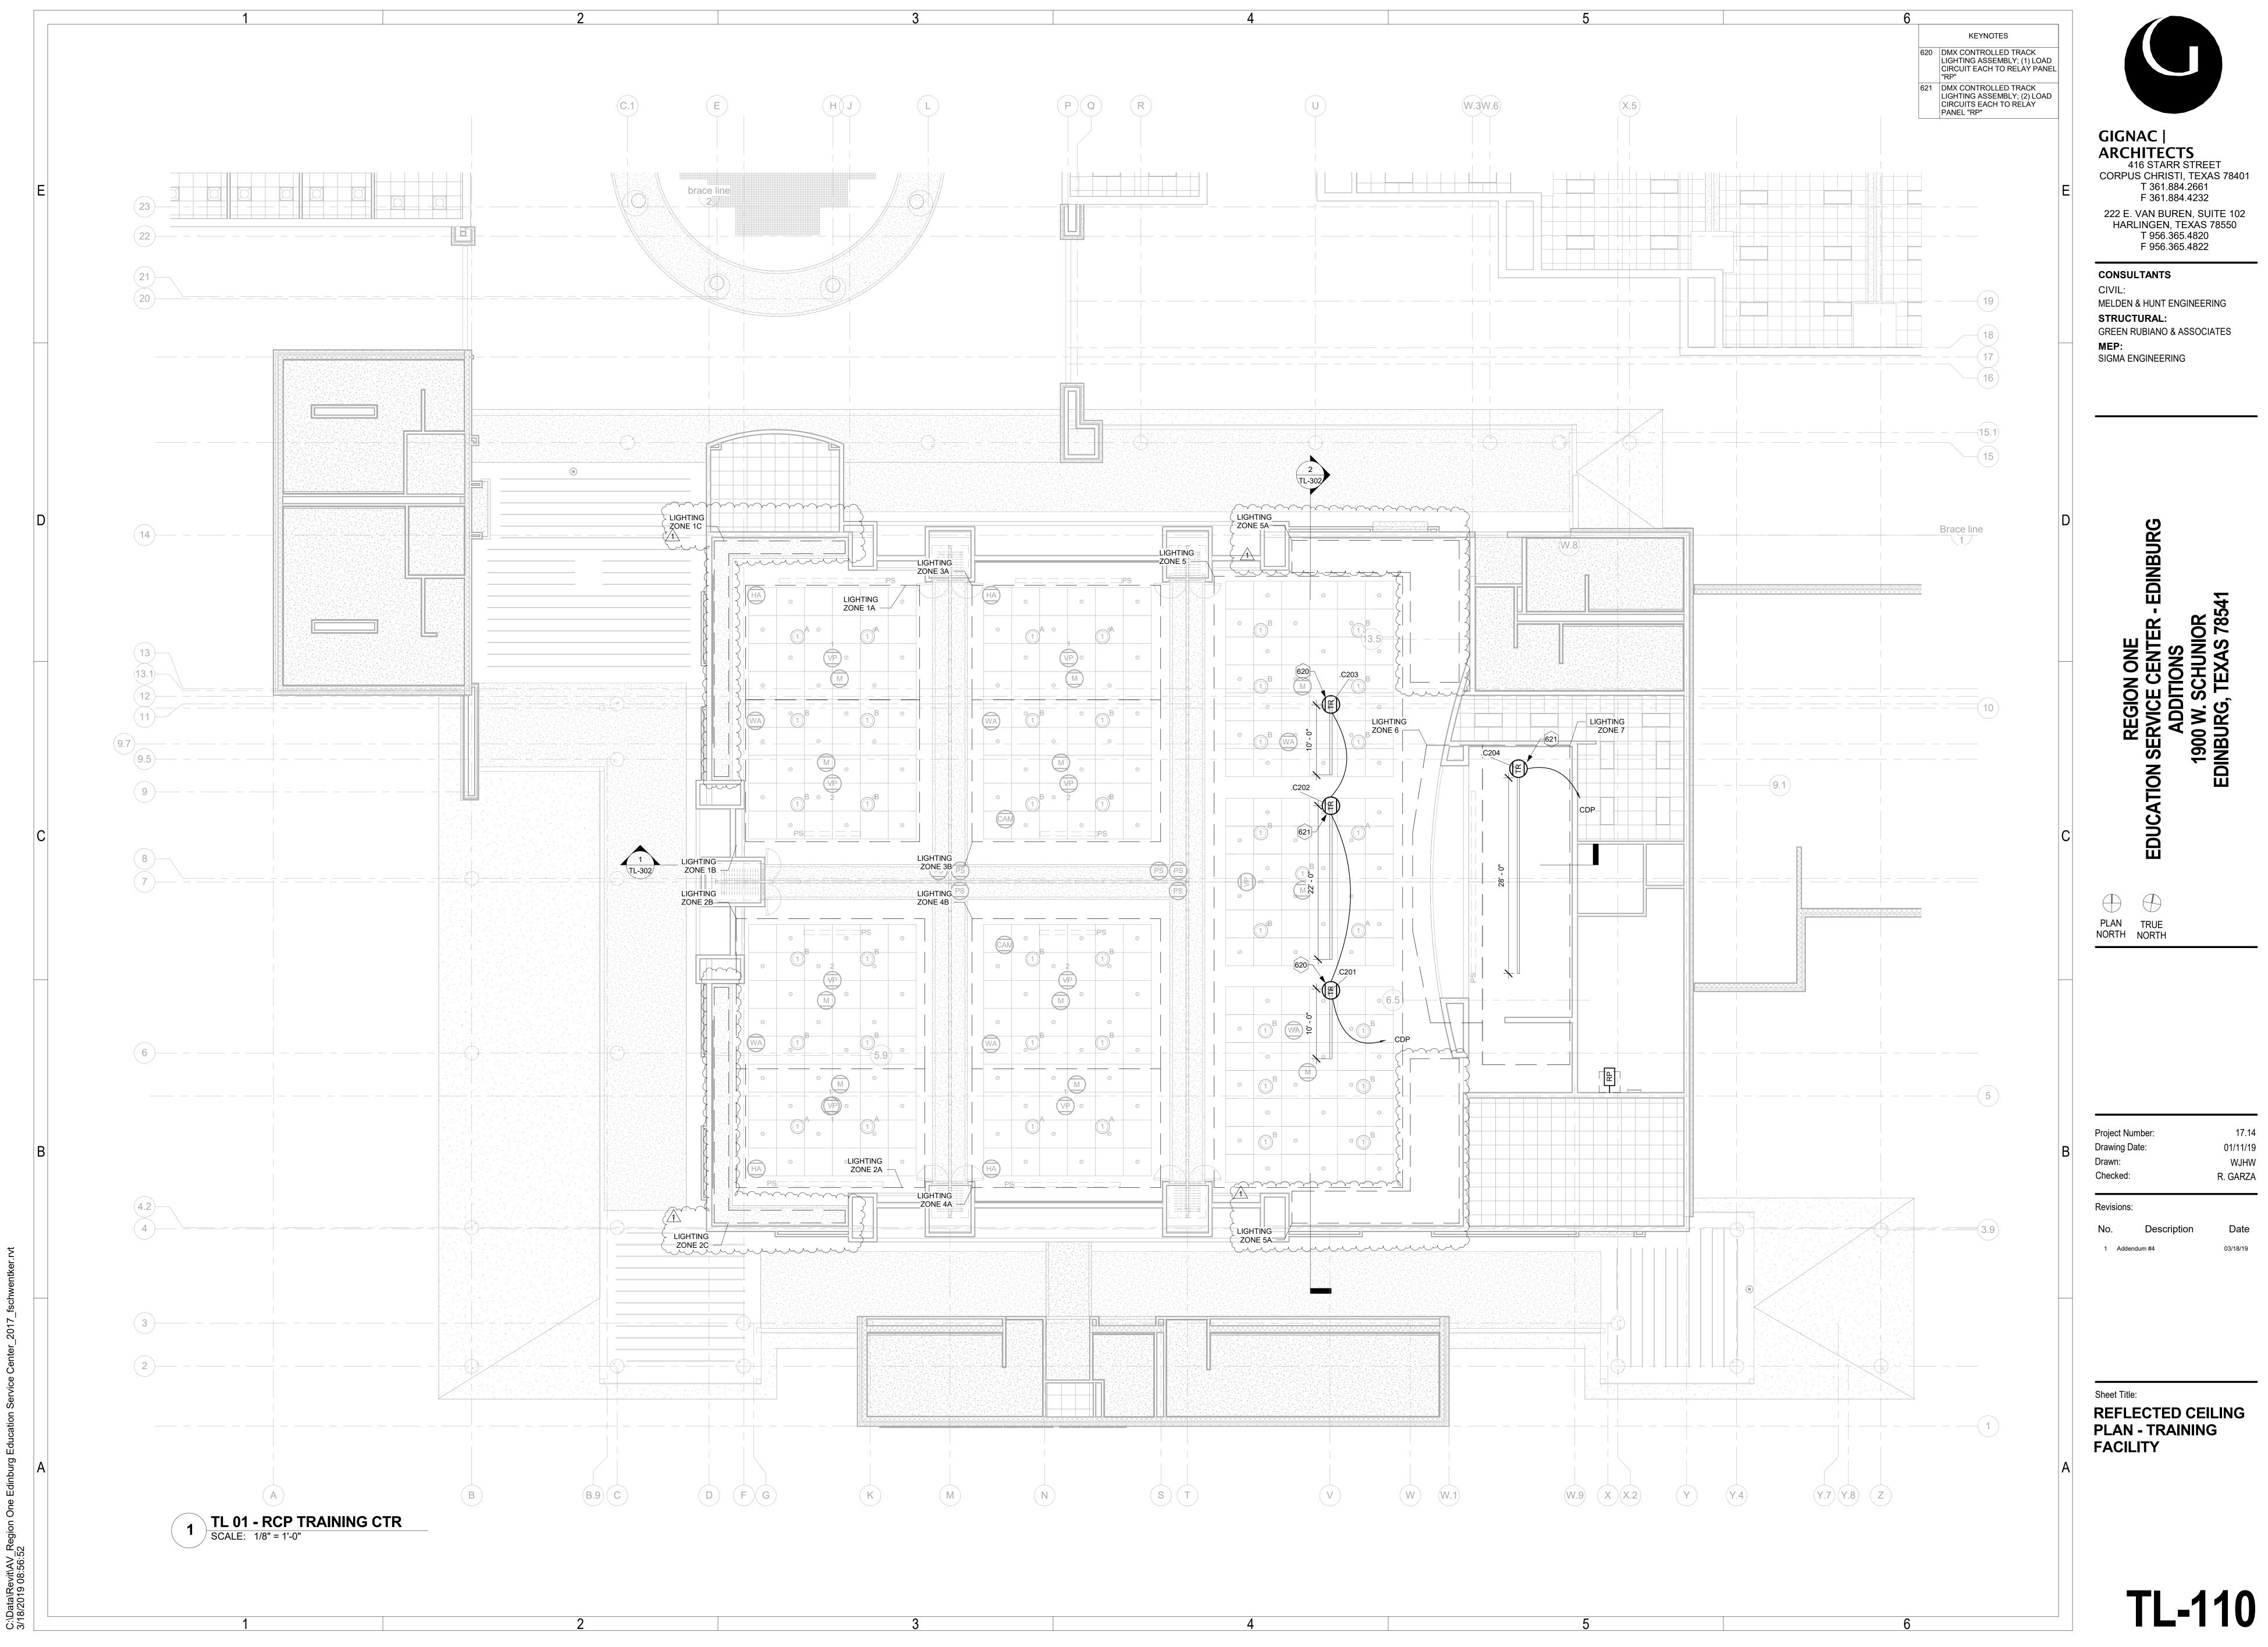

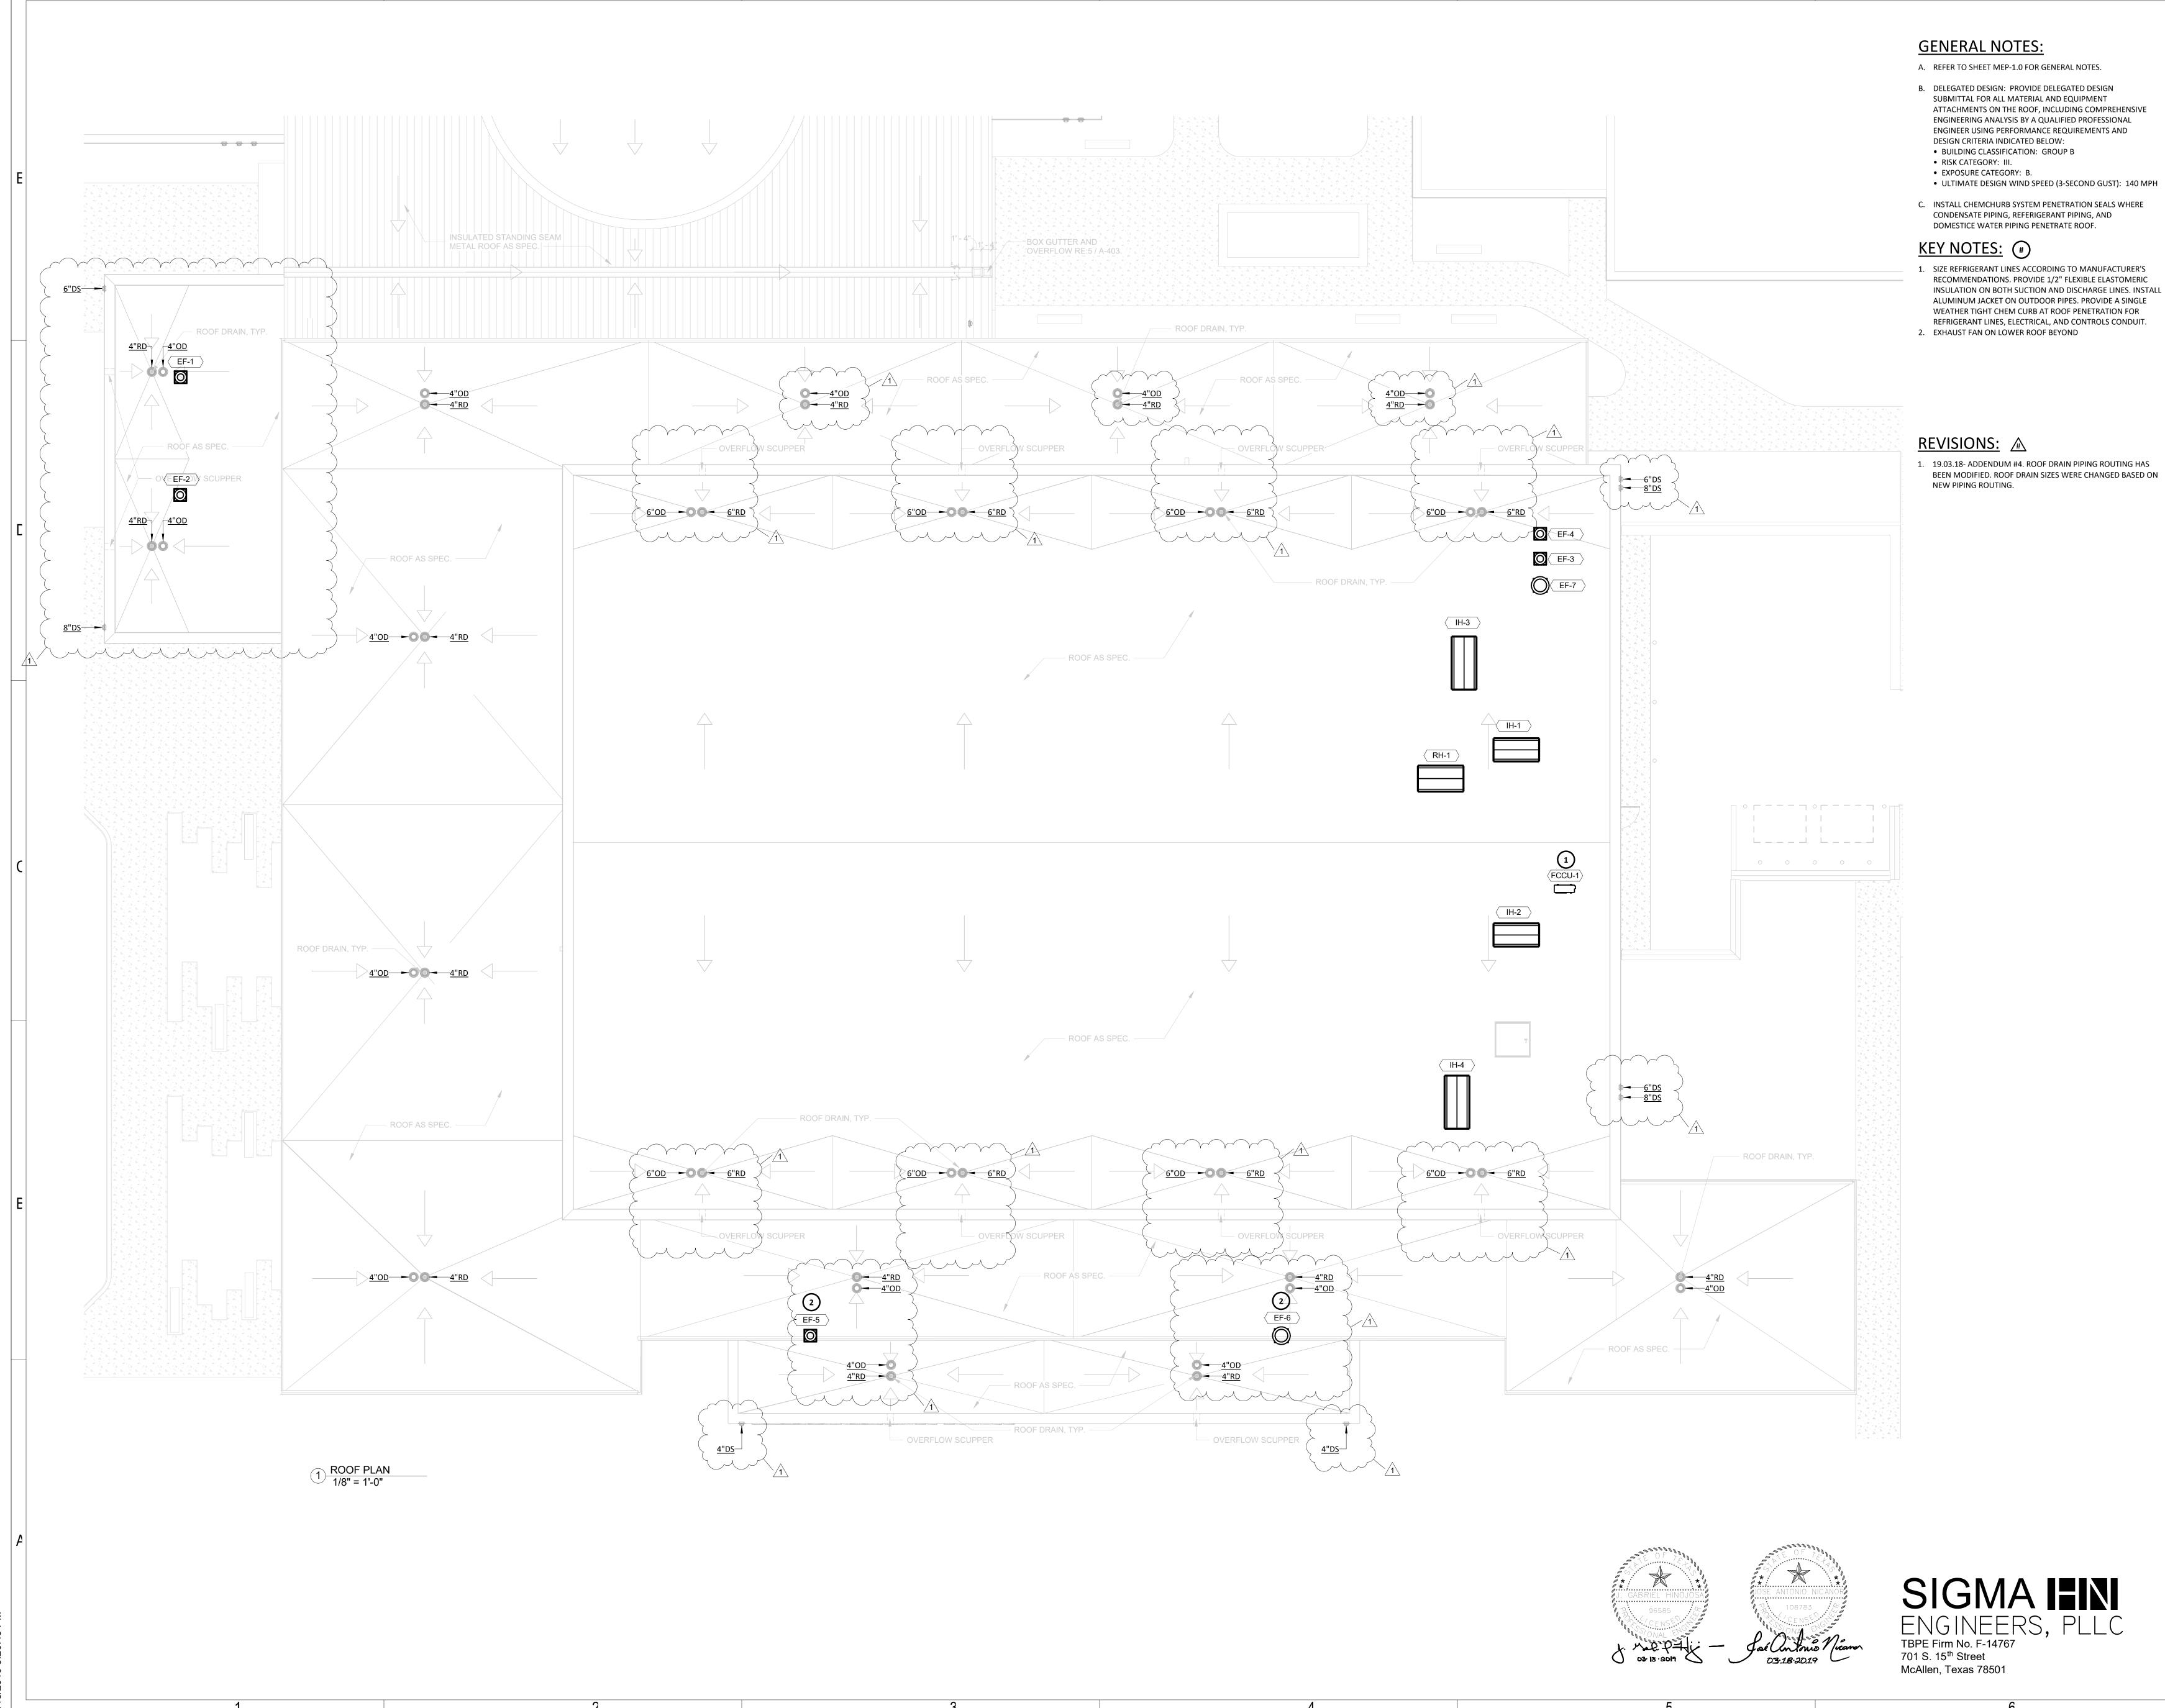



C:\Users\SigmaHNe_K 3/18/2019 5:26:45 PM

- ATTACHMENTS ON THE ROOF, INCLUDING COMPREHENSIVE ENGINEERING ANALYSIS BY A QUALIFIED PROFESSIONAL ENGINEER USING PERFORMANCE REQUIREMENTS AND


RECOMMENDATIONS. PROVIDE 1/2" FLEXIBLE ELASTOMERIC INSULATION ON BOTH SUCTION AND DISCHARGE LINES. INSTALL ALUMINUM JACKET ON OUTDOOR PIPES. PROVIDE A SINGLE WEATHER TIGHT CHEM CURB AT ROOF PENETRATION FOR REFRIGERANT LINES, ELECTRICAL, AND CONTROLS CONDUIT.


BEEN MODIFIED. ROOF DRAIN SIZES WERE CHANGED BASED ON

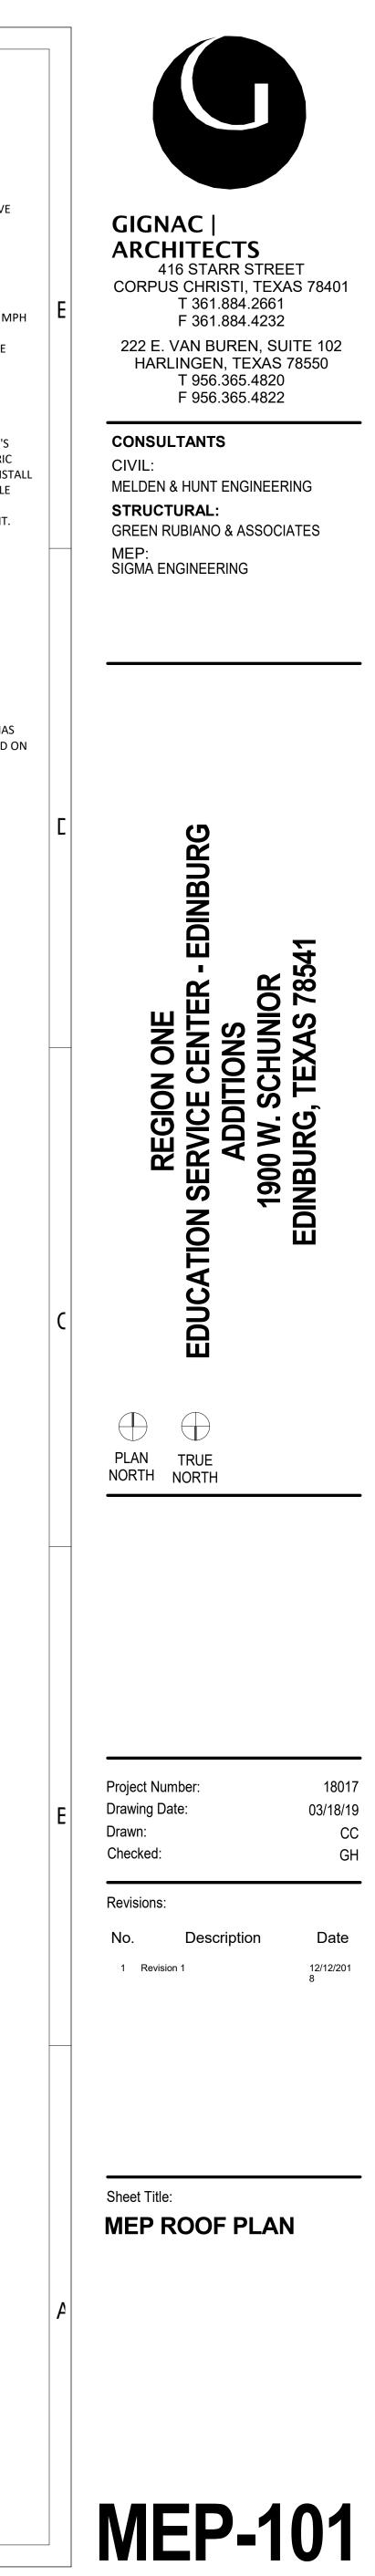

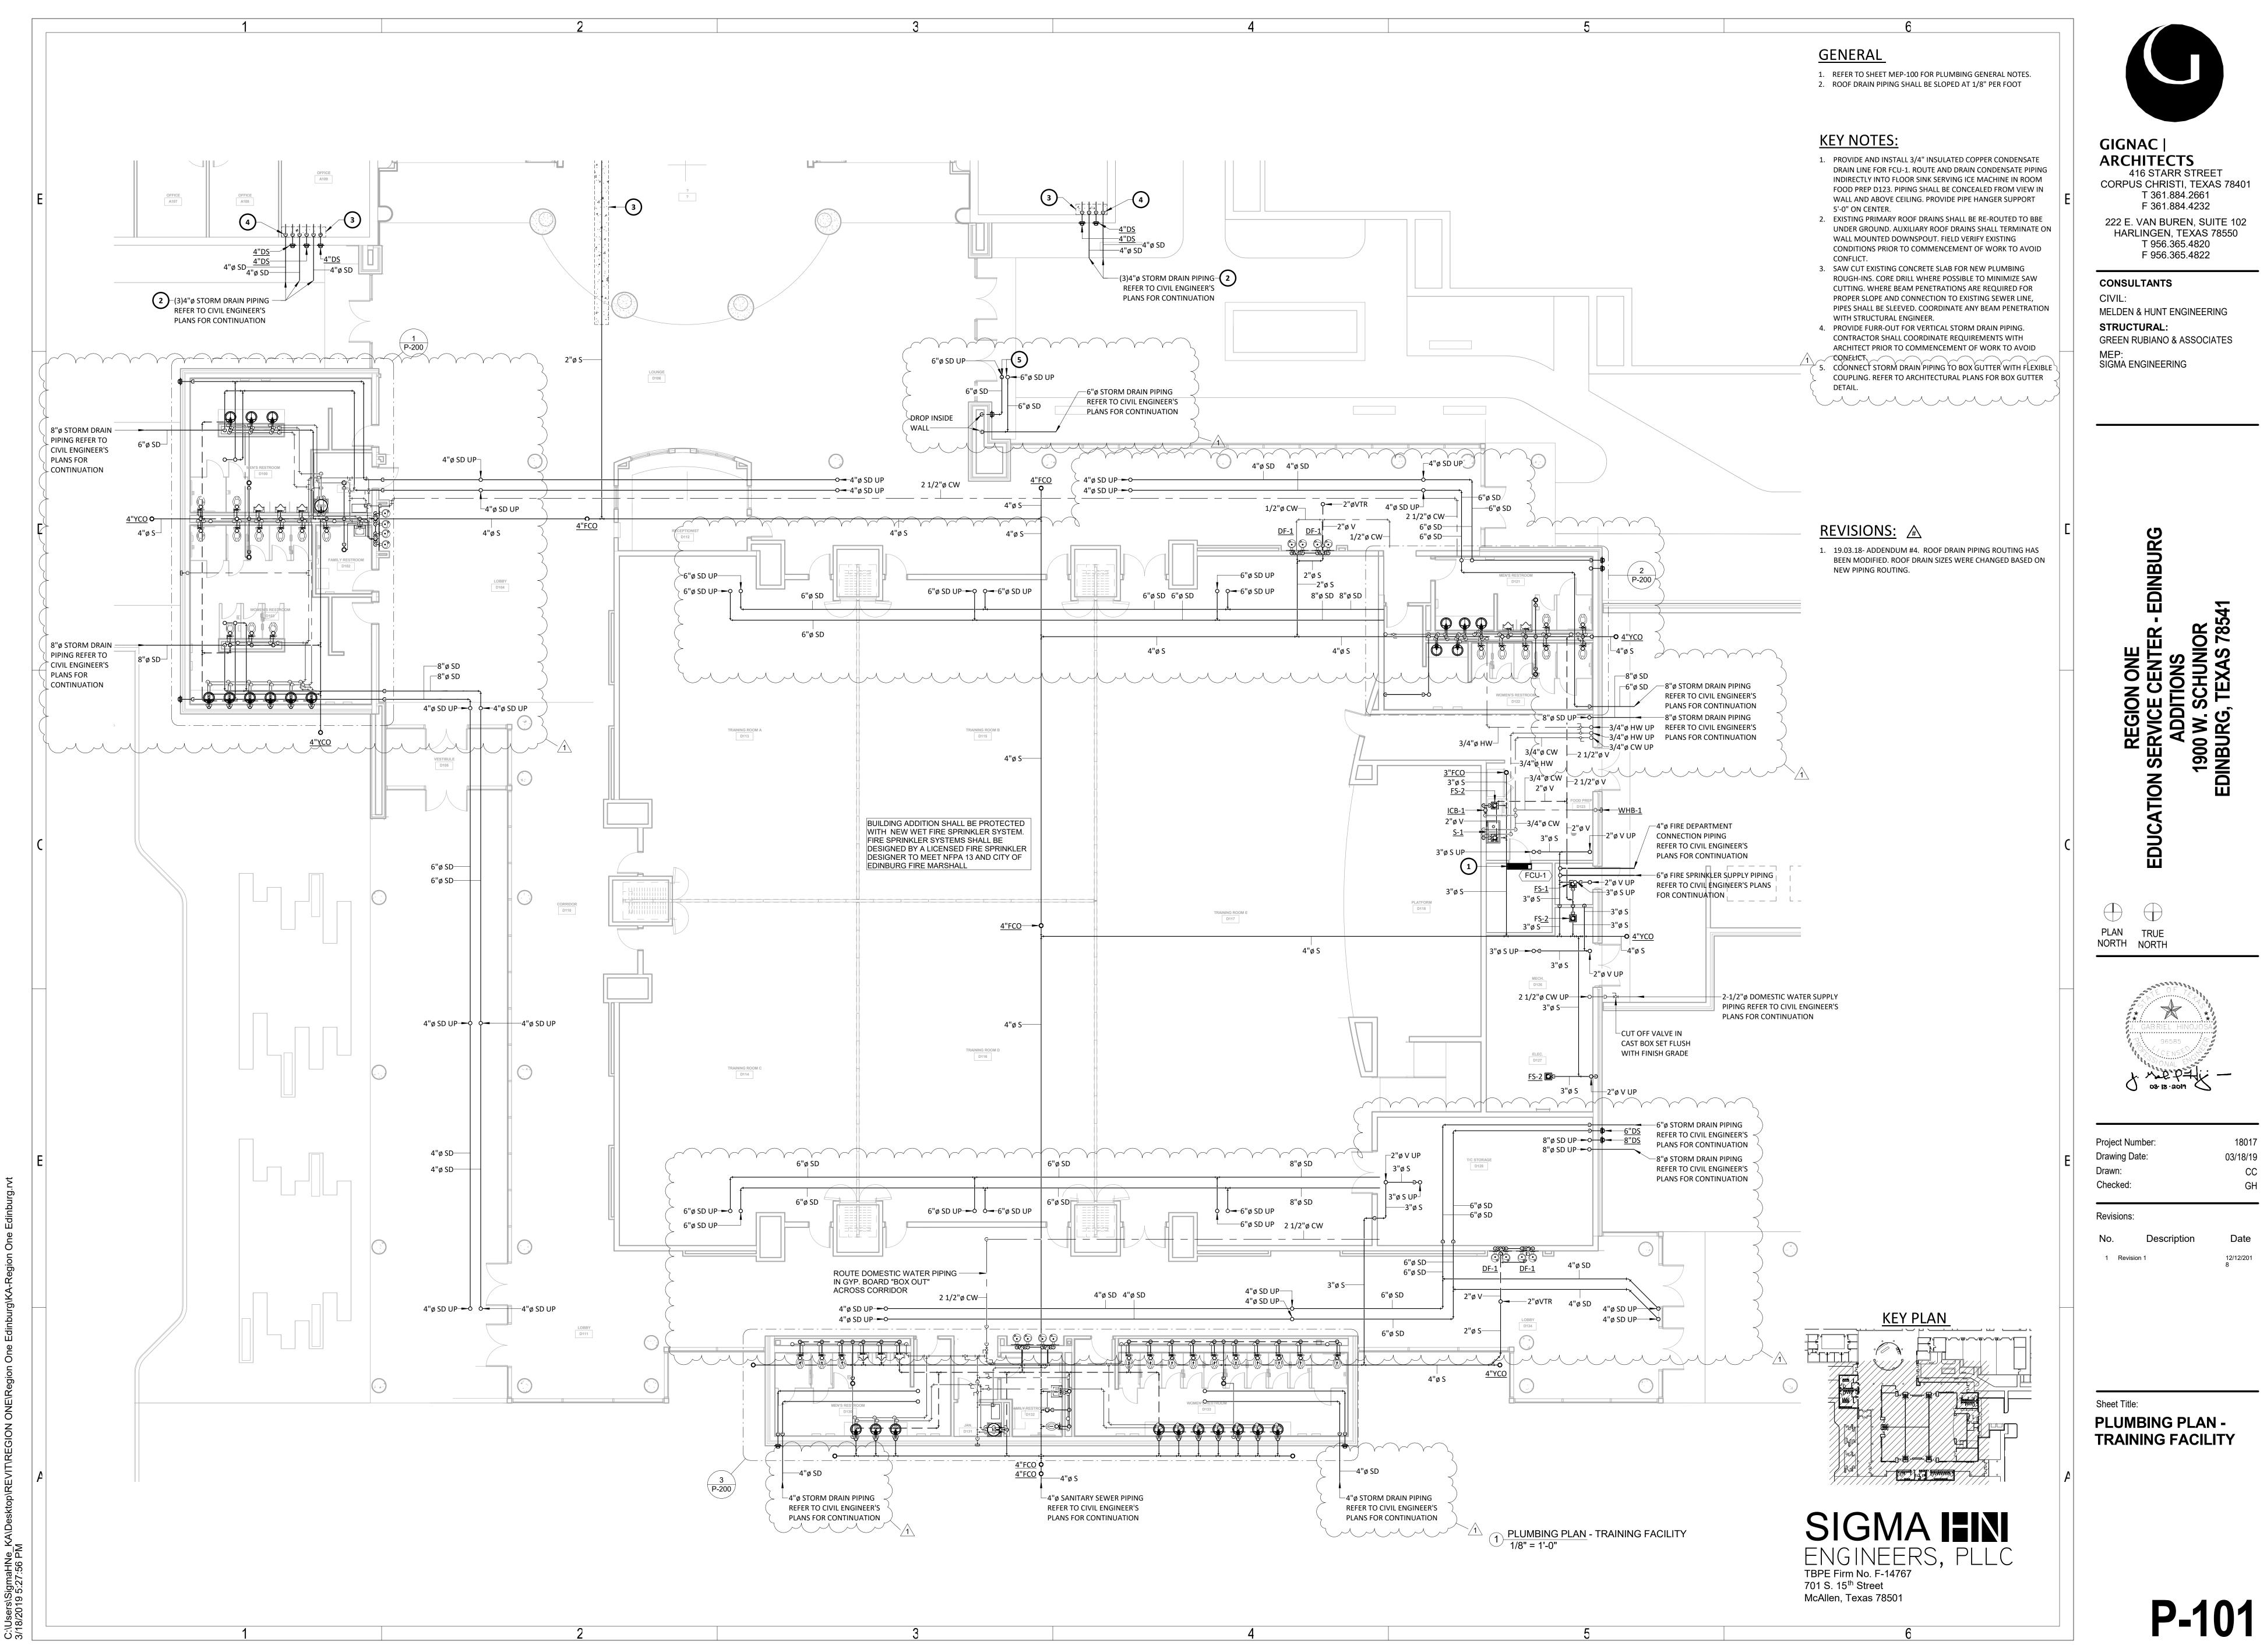



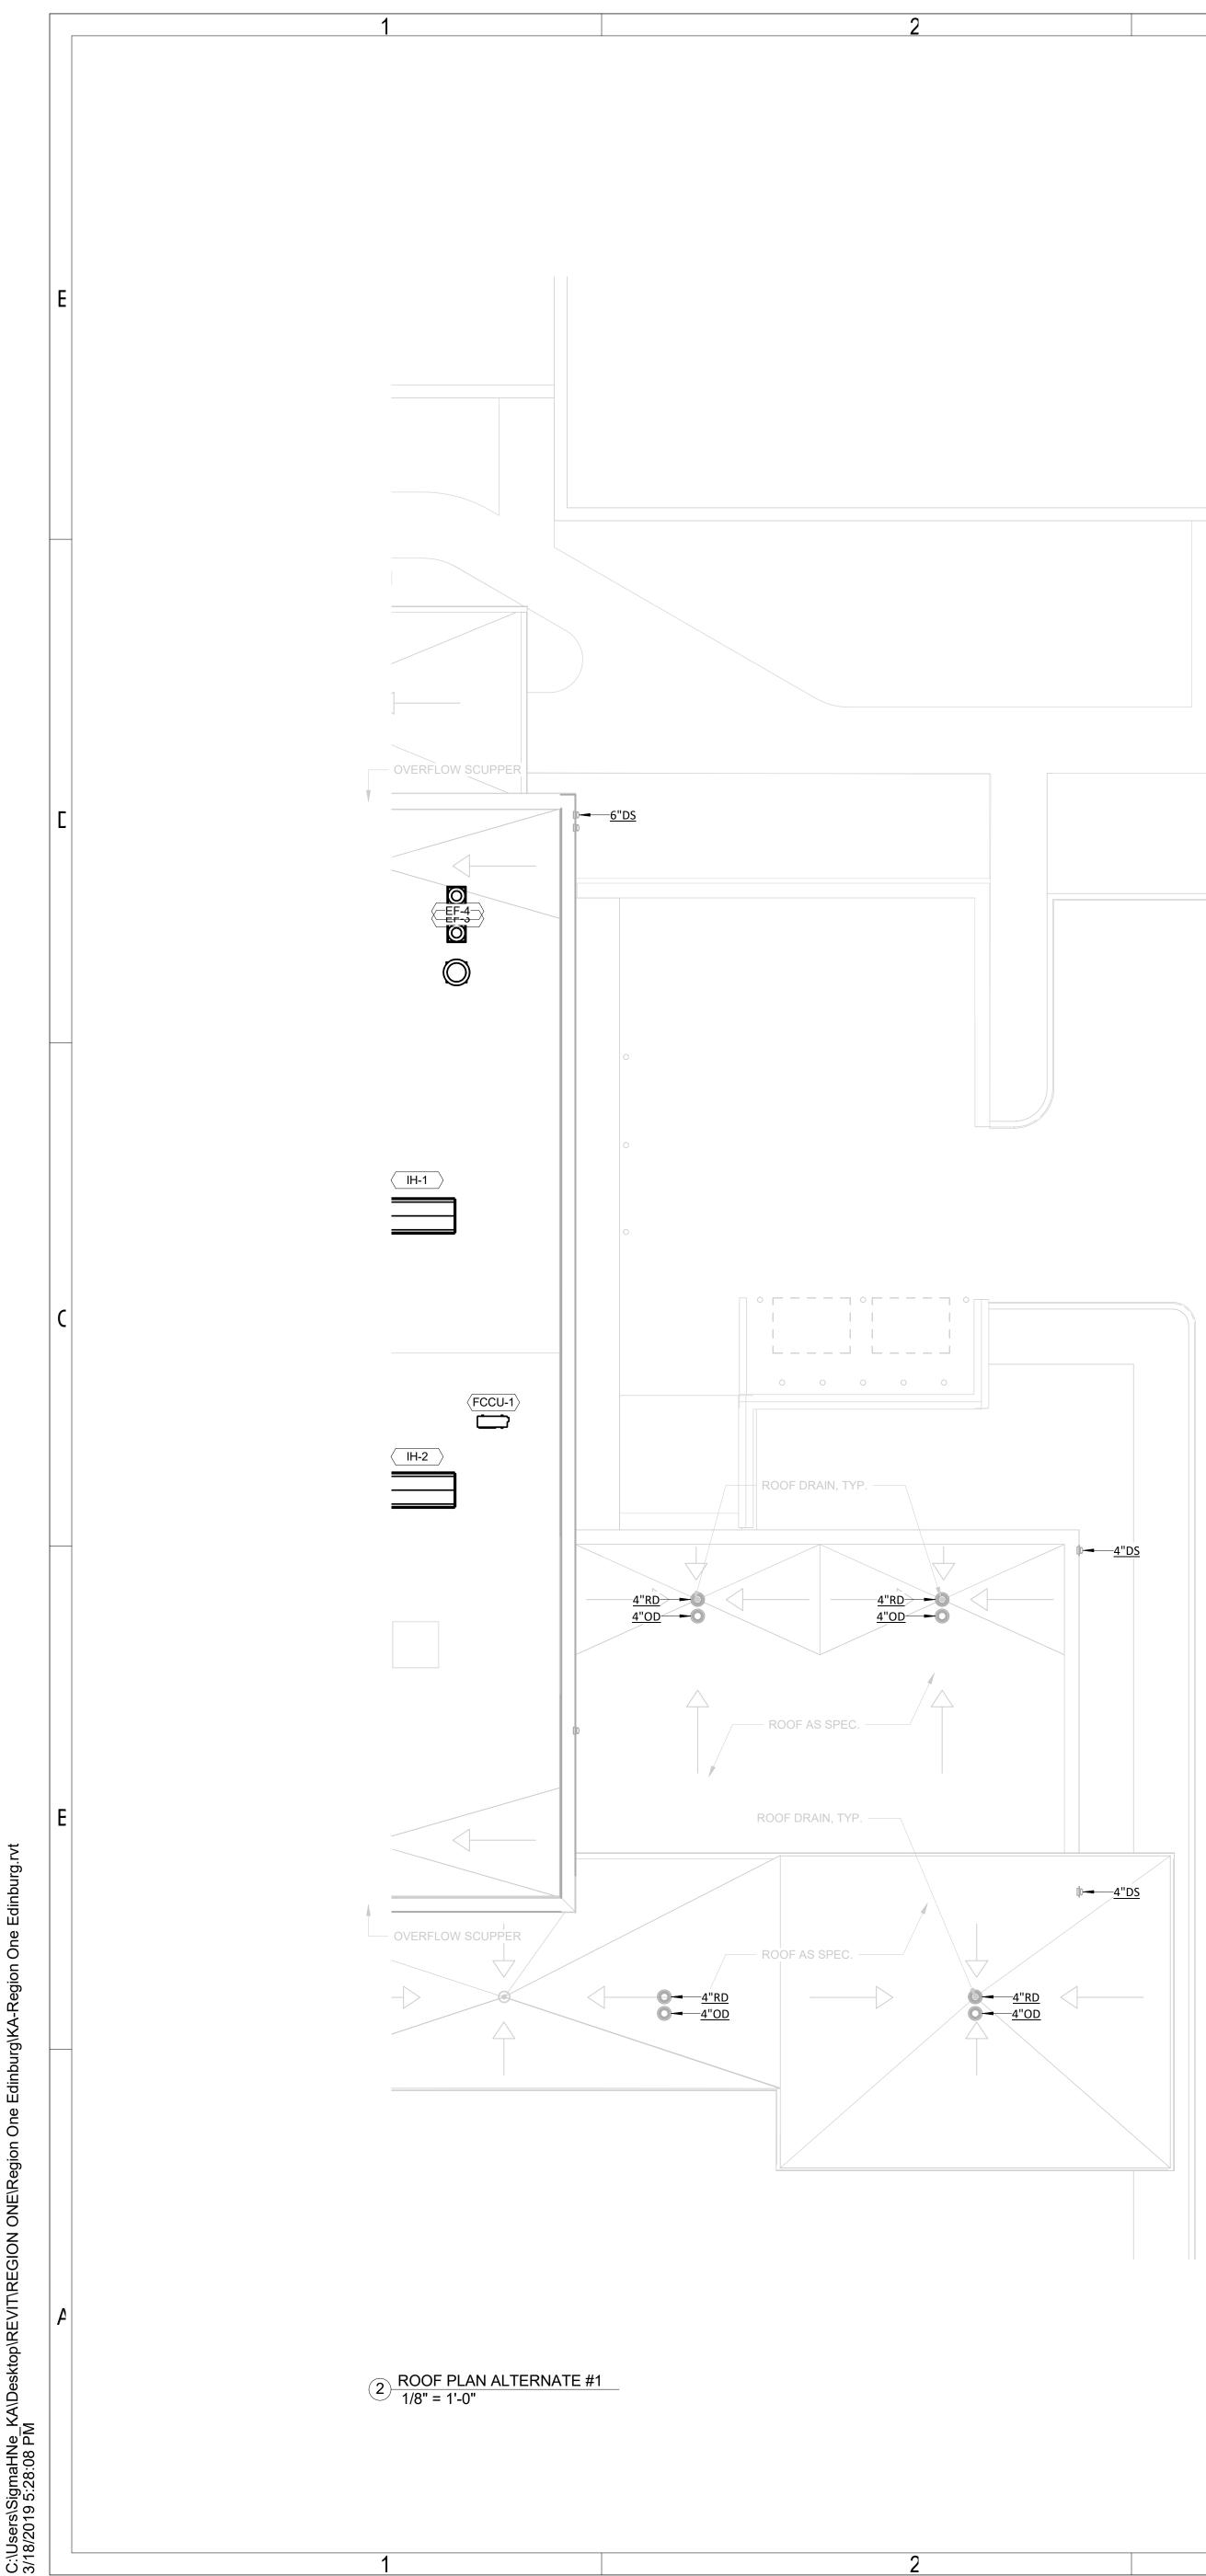

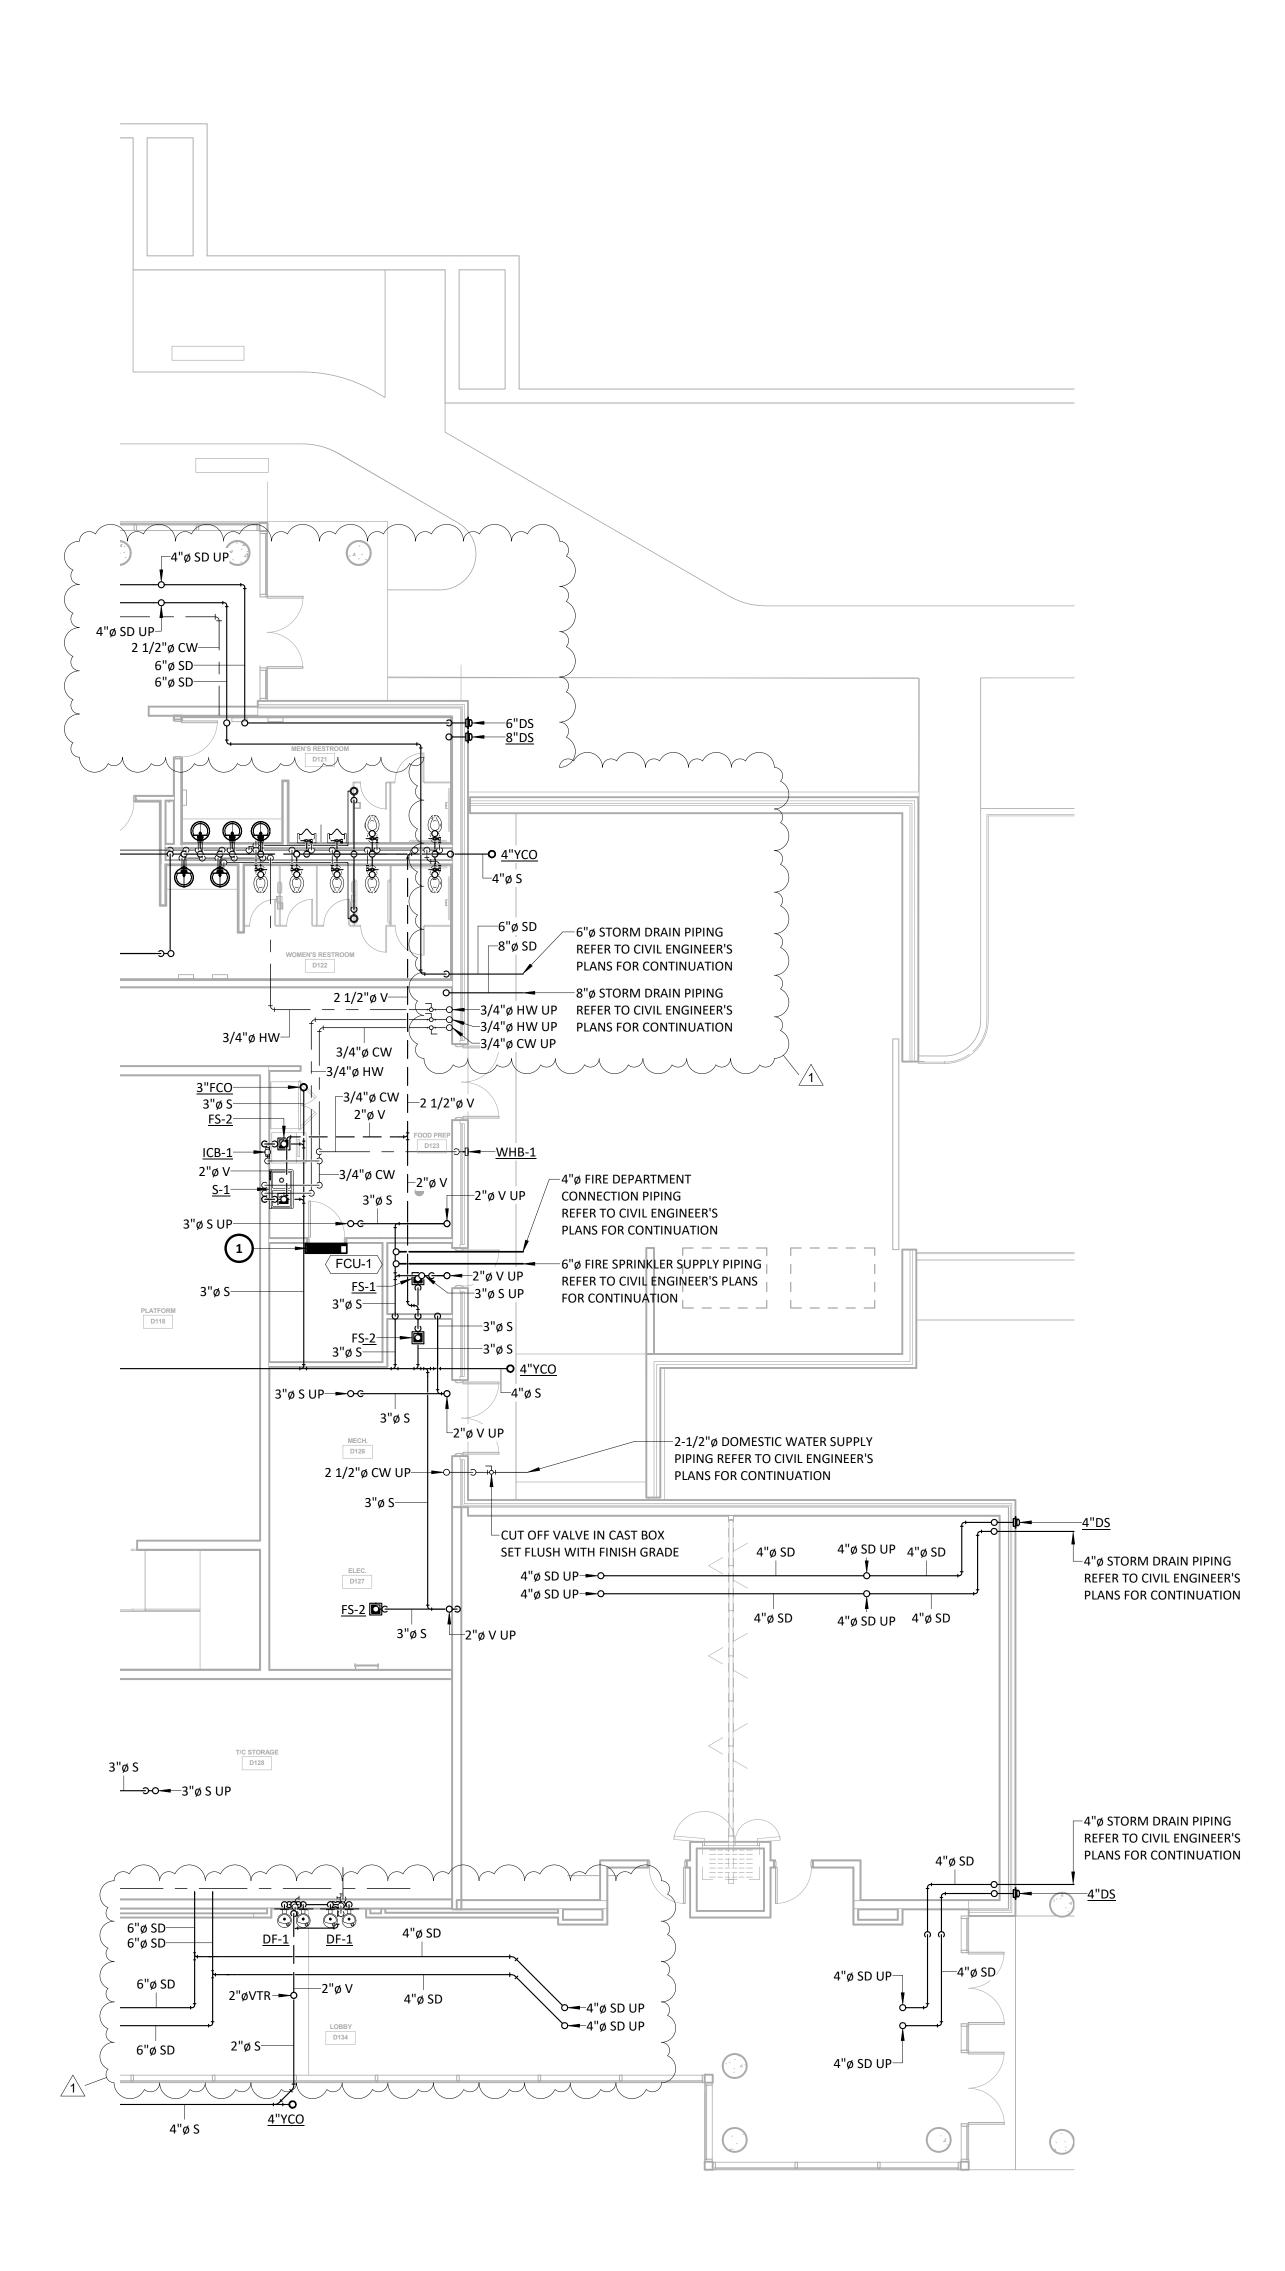

PLUMBING PLAN - TRAINING FACILITY $1 \frac{W/ALTERNATE #1}{1/8" = 1'-0"}$


<u>GENERAL</u>


1. REFER TO SHEET MEP-100 FOR PLUMBING GENERAL NOTES. 2. ROOF DRAIN PIPING SHALL BE SLOPED AT 1/8" PER FOOT


<u>REVISIONS:</u>


1. 19.03.18- ADDENDUM #4. ROOF DRAIN PIPING ROUTING HAS BEEN MODIFIED. ROOF DRAIN SIZES WERE CHANGED BASED ON NEW PIPING ROUTING.



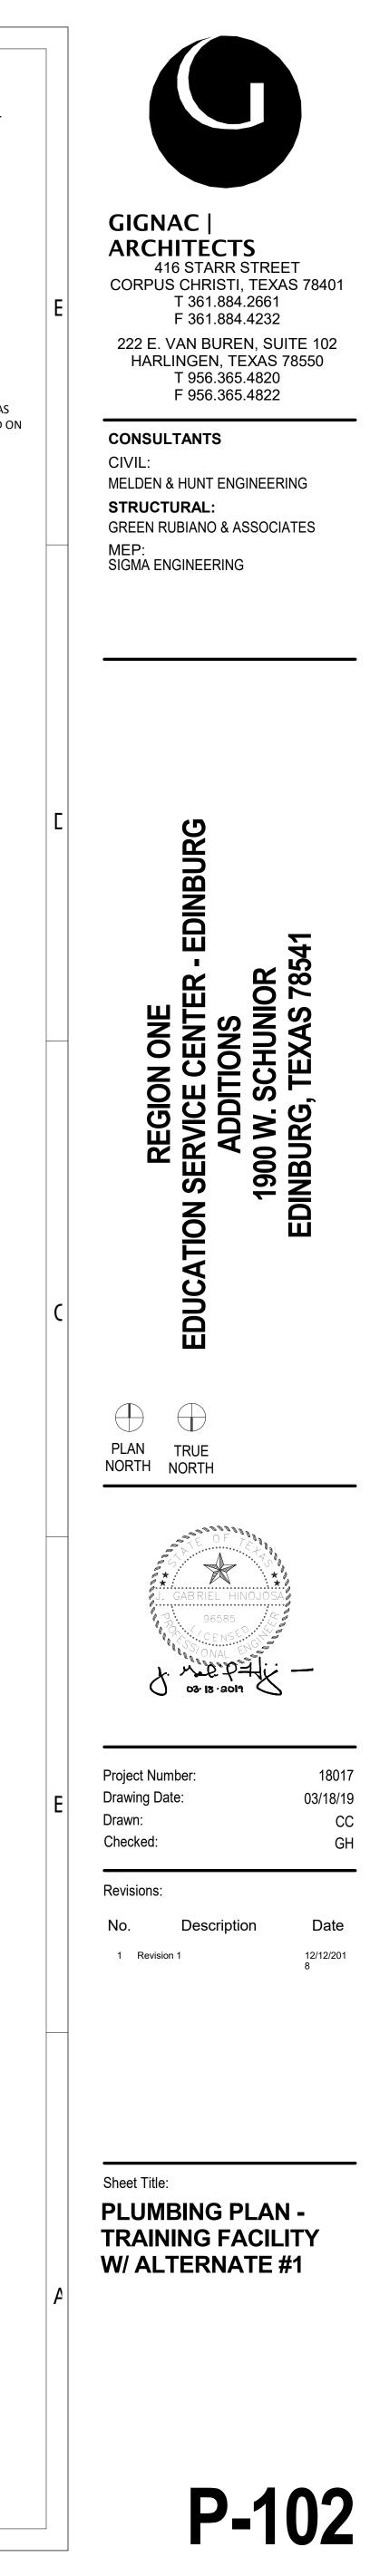


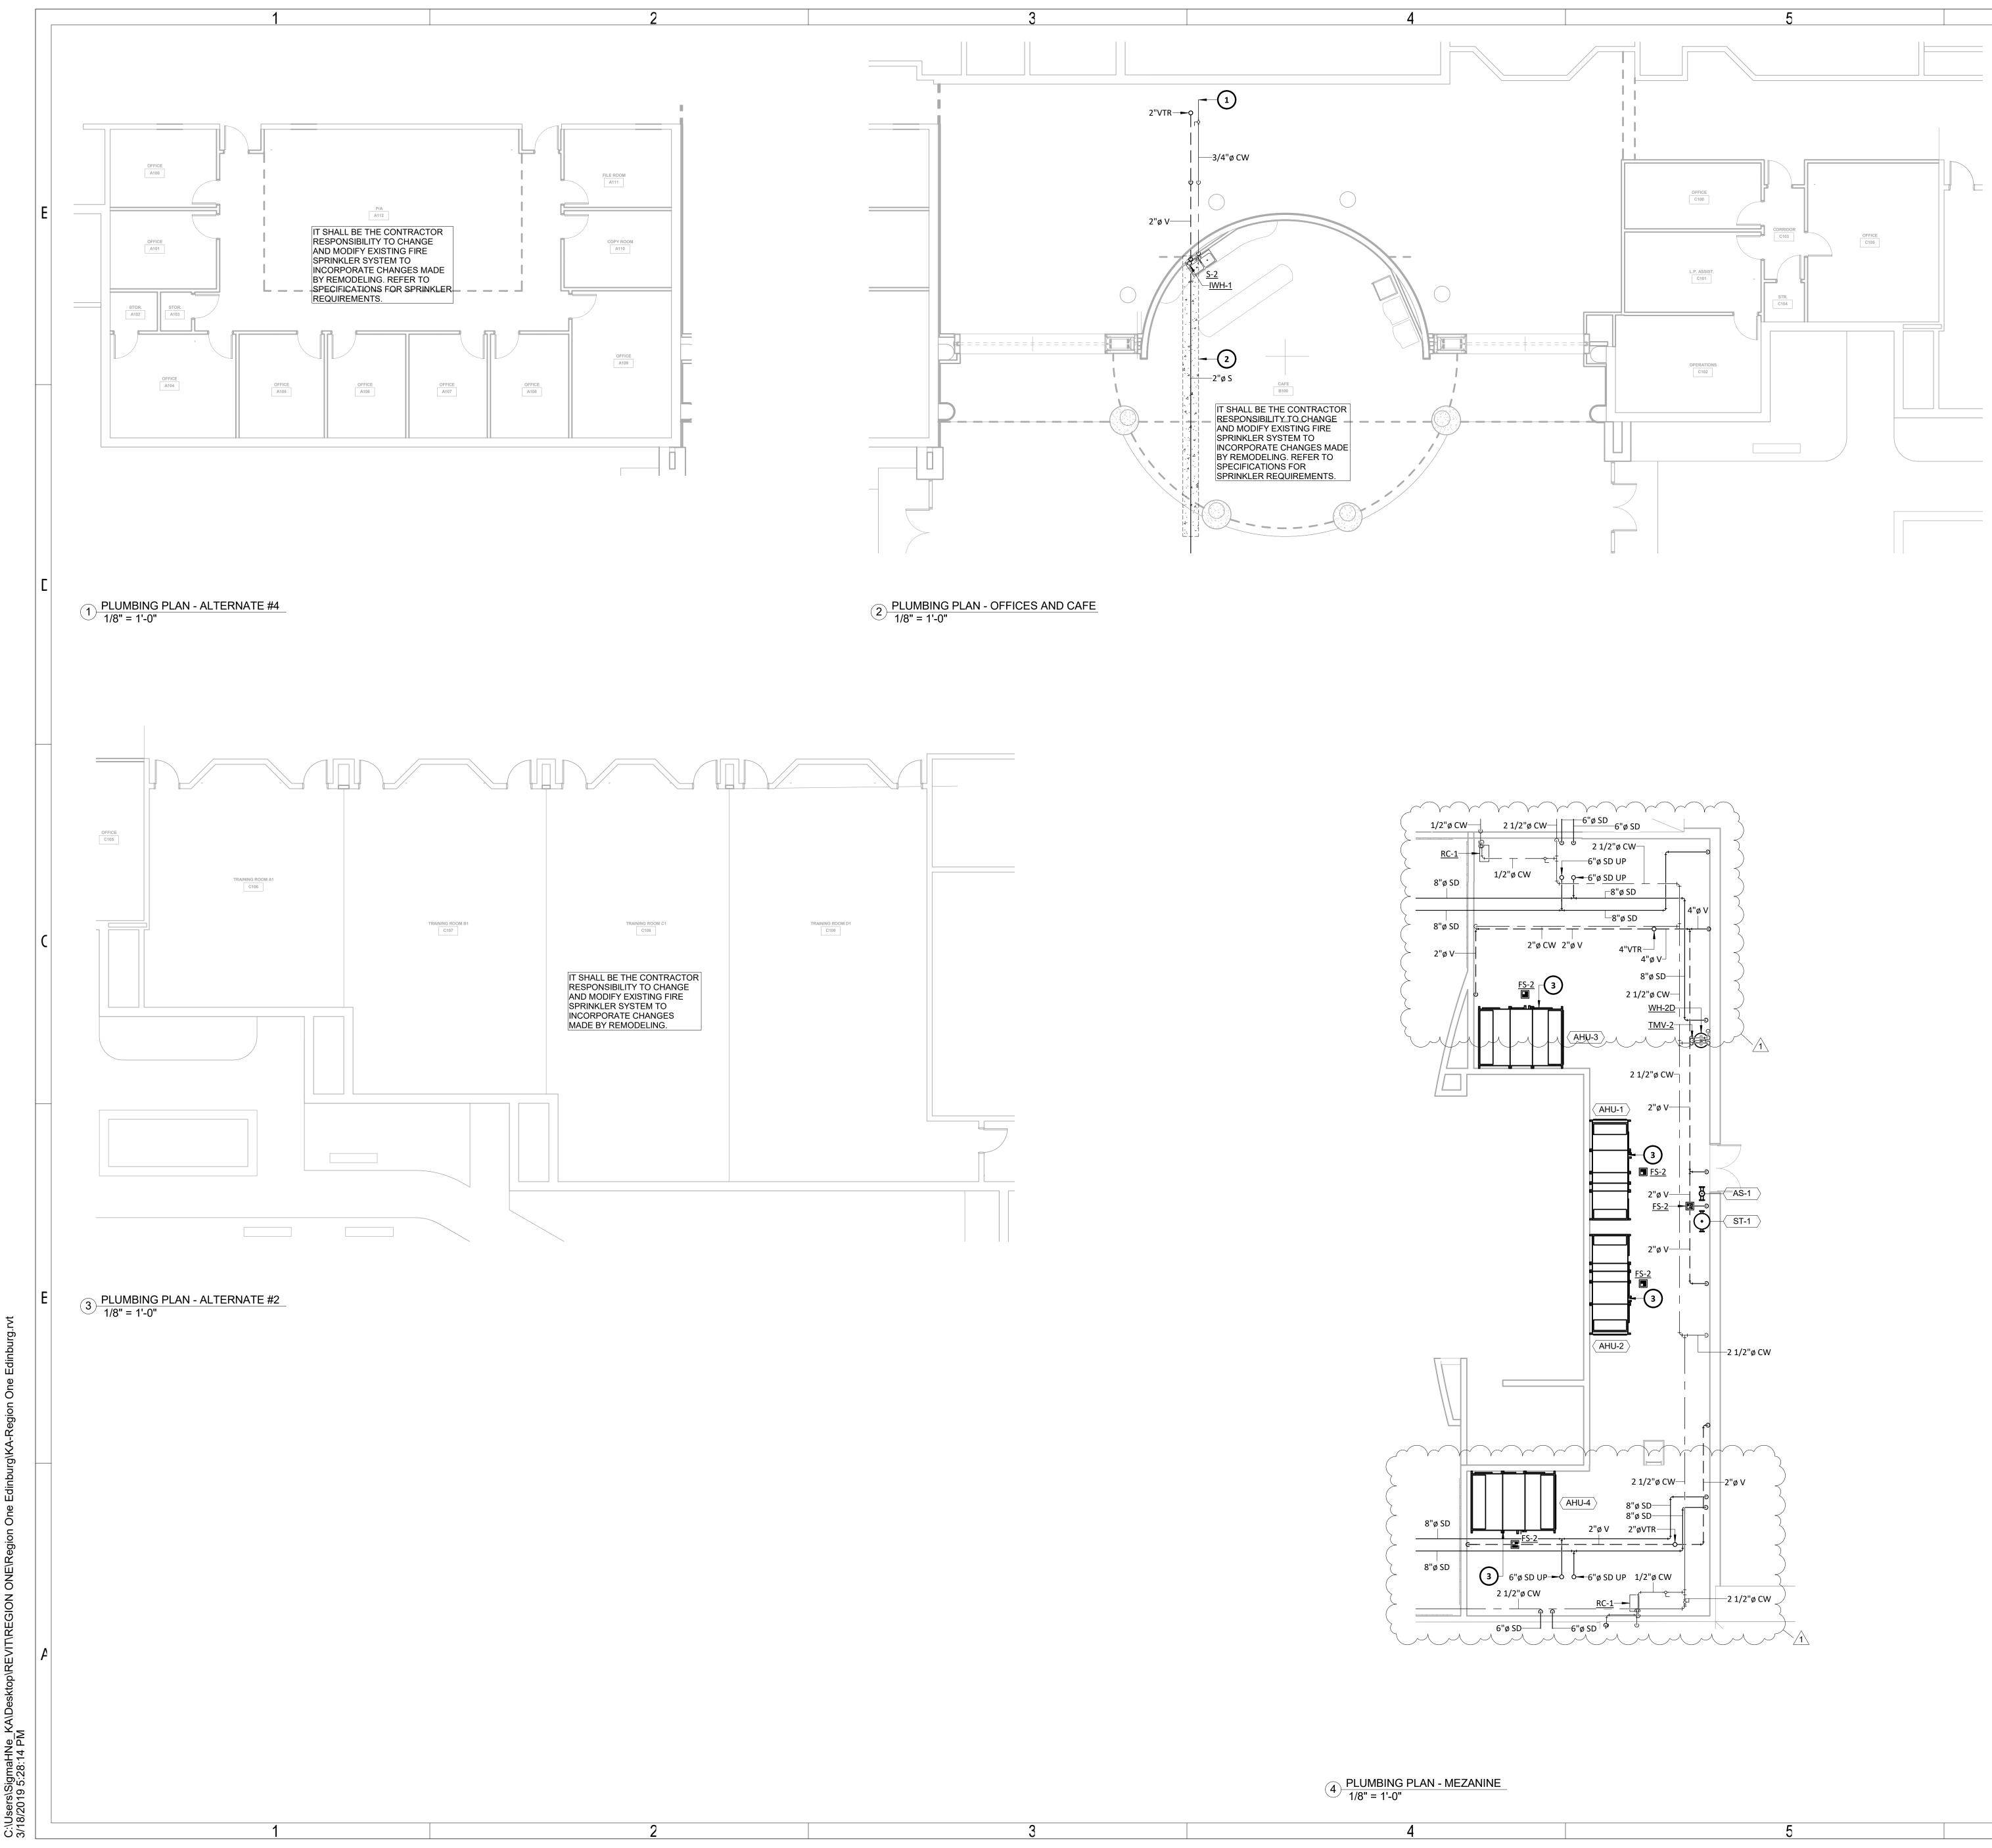

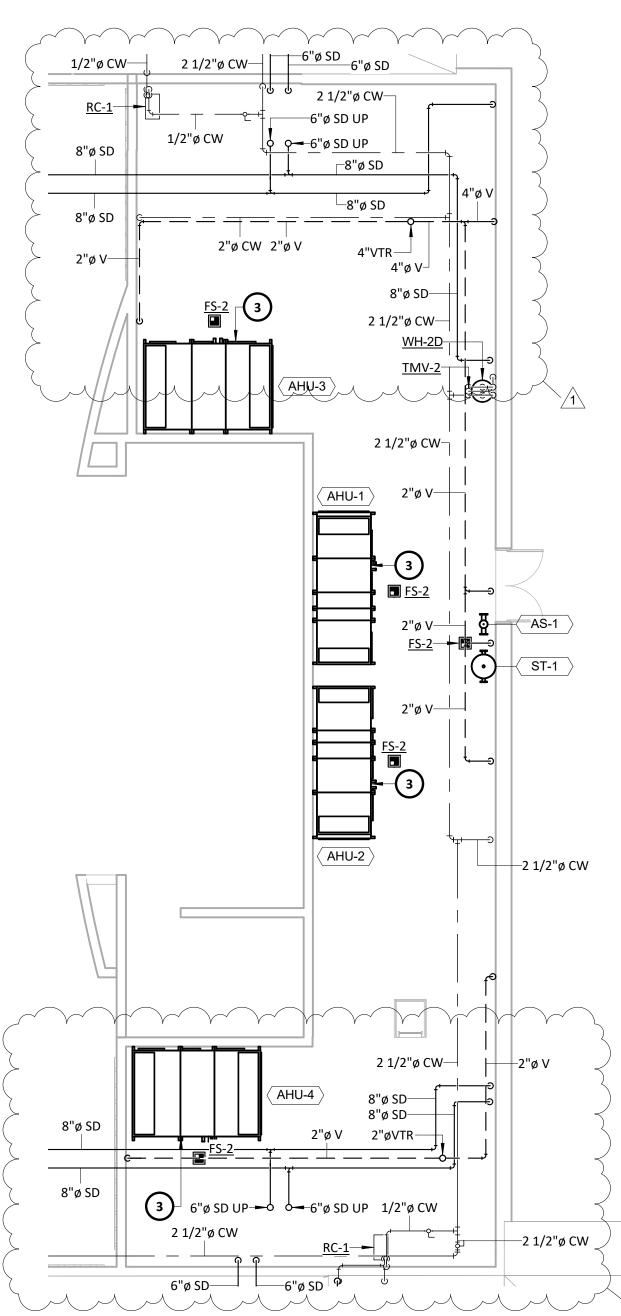

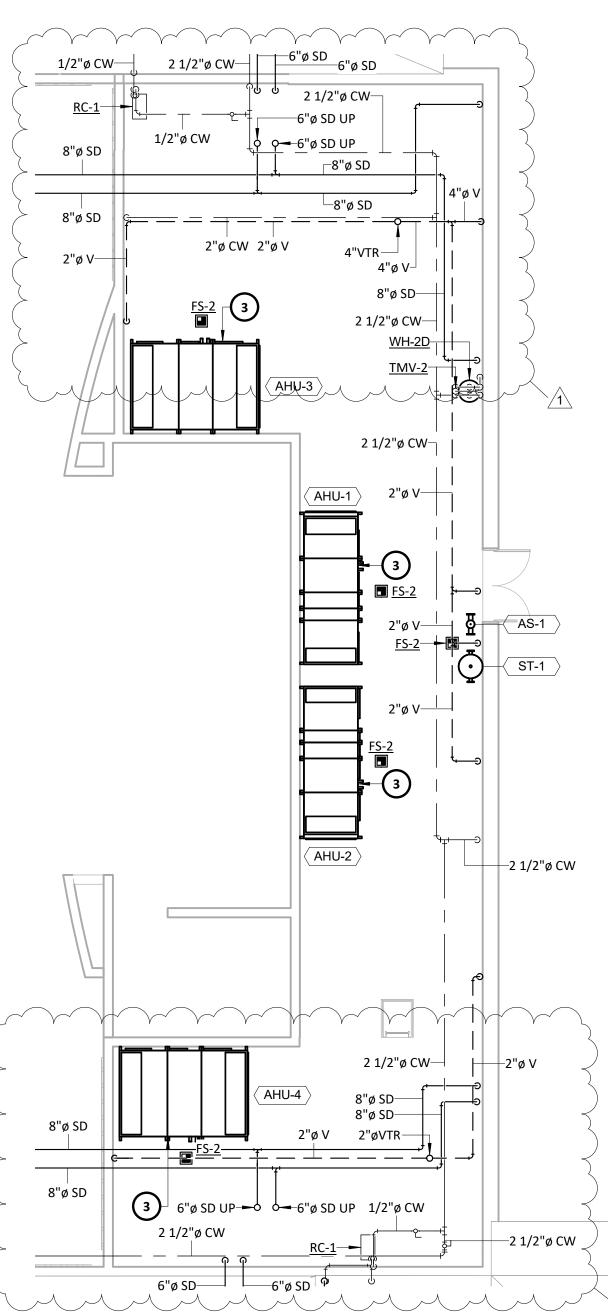

NEW PIPING ROUTING.

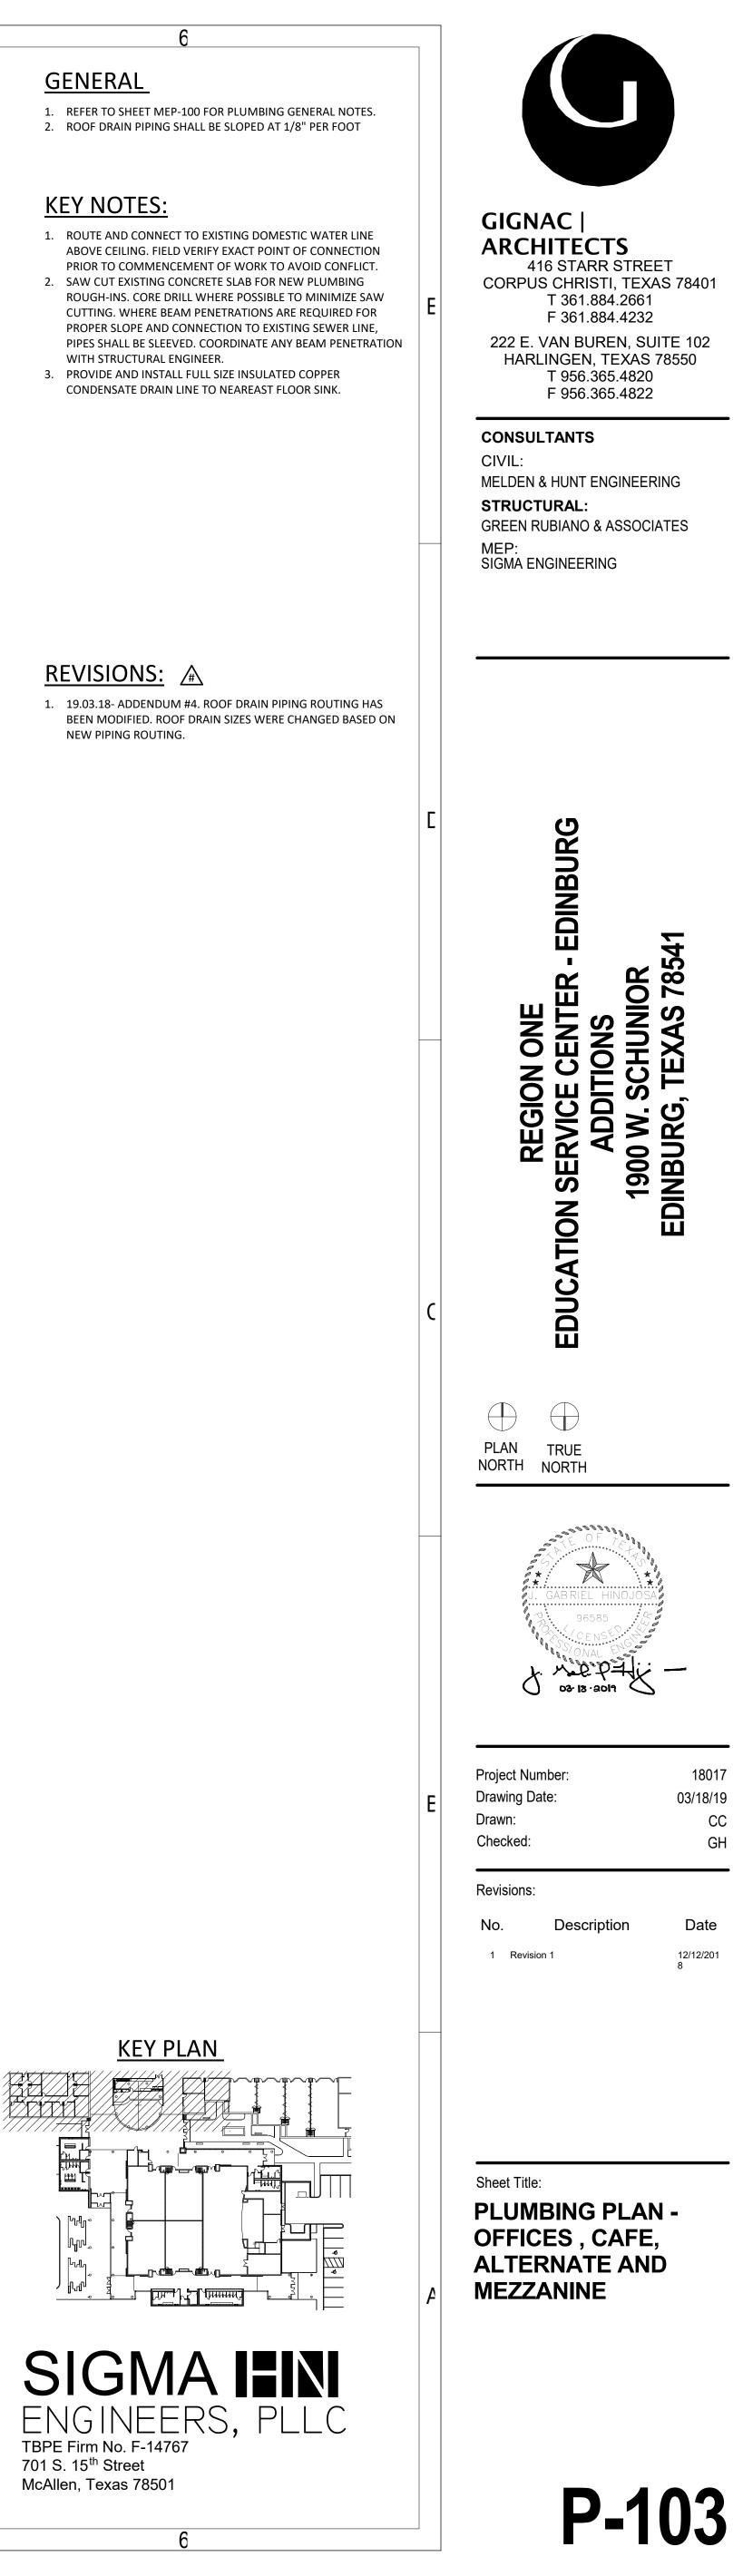


C:\Users\SigmaHNe_KA\Desktop\REVIT\REGION ONE\Region One Edinburg\KA-Region One Edinburg.rvt 3/18/2019 5:28:17 PM

E	
С	
C	
E	
Ą	
	1 2

1


2

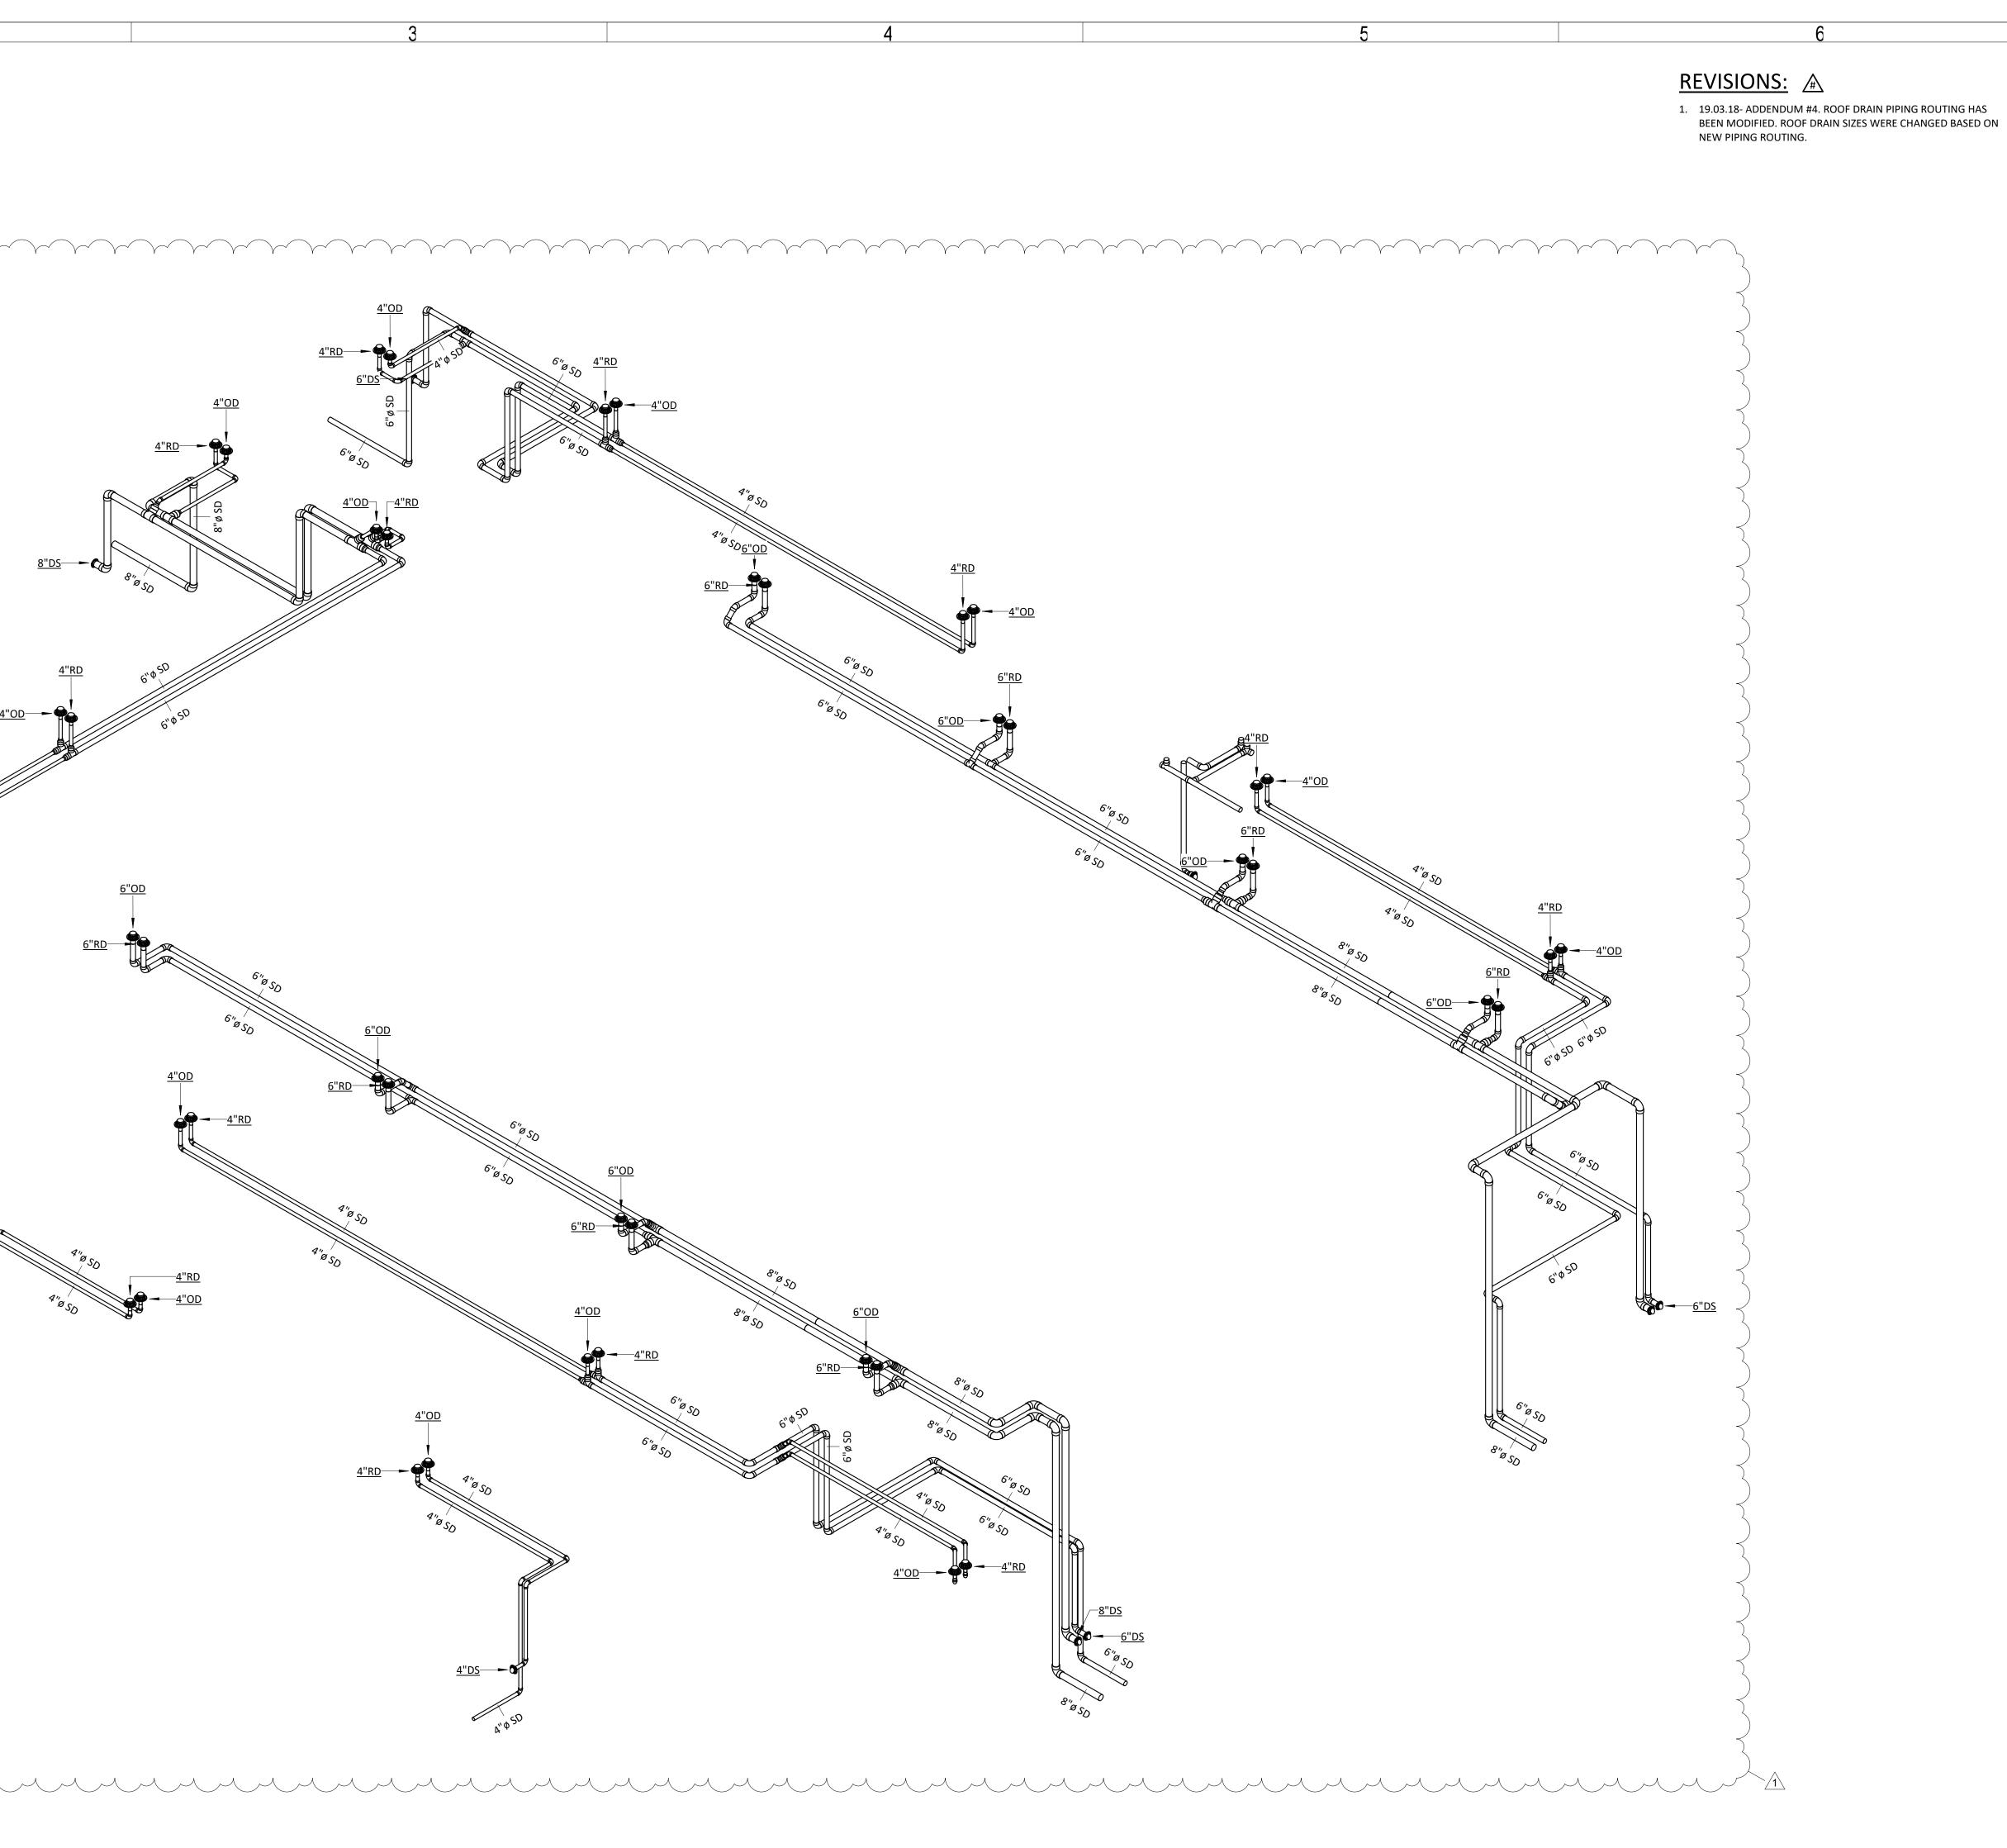

3


1 PLUMBING STORM SEWER RISER N.T.S.



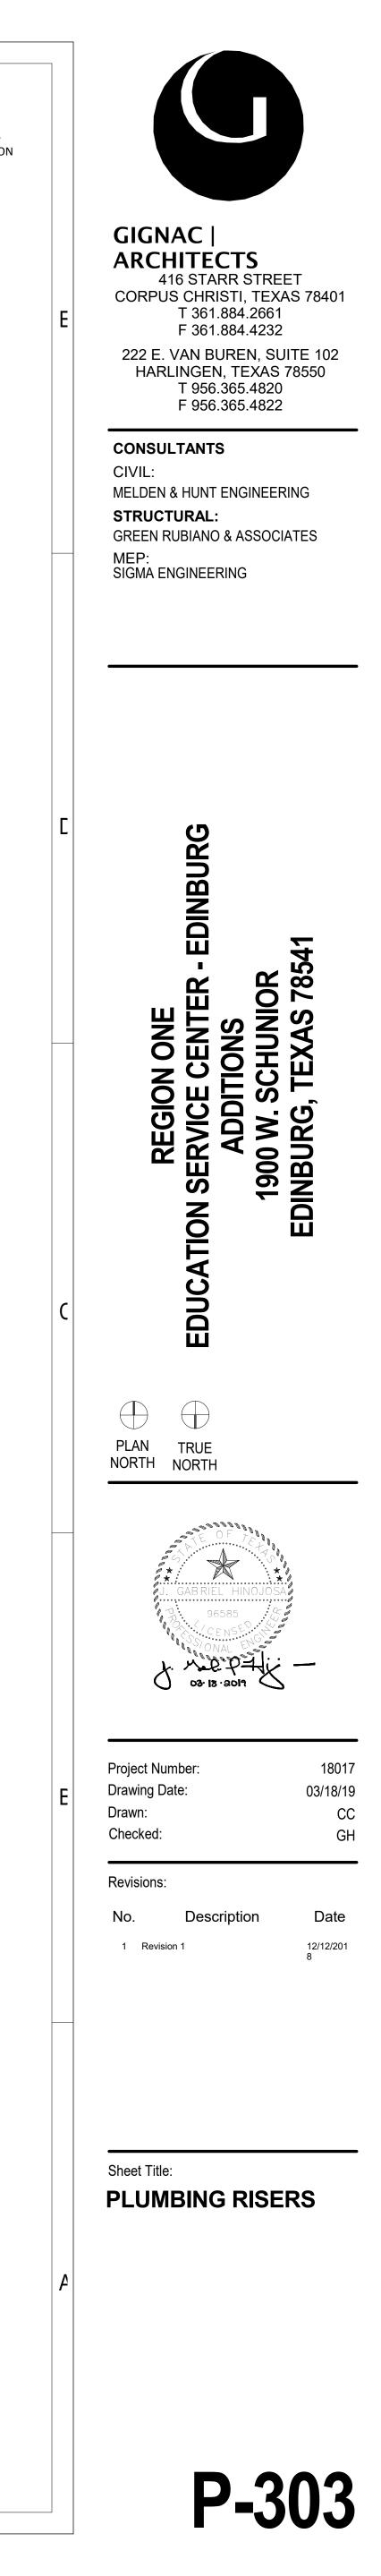




r	1 2
E	
С	ALTERNATE #3
 C	A125 G125 G125 <t< th=""></t<>
E	(1) MECHANICAL PLAN. 1/8" = 1'-0"
A	

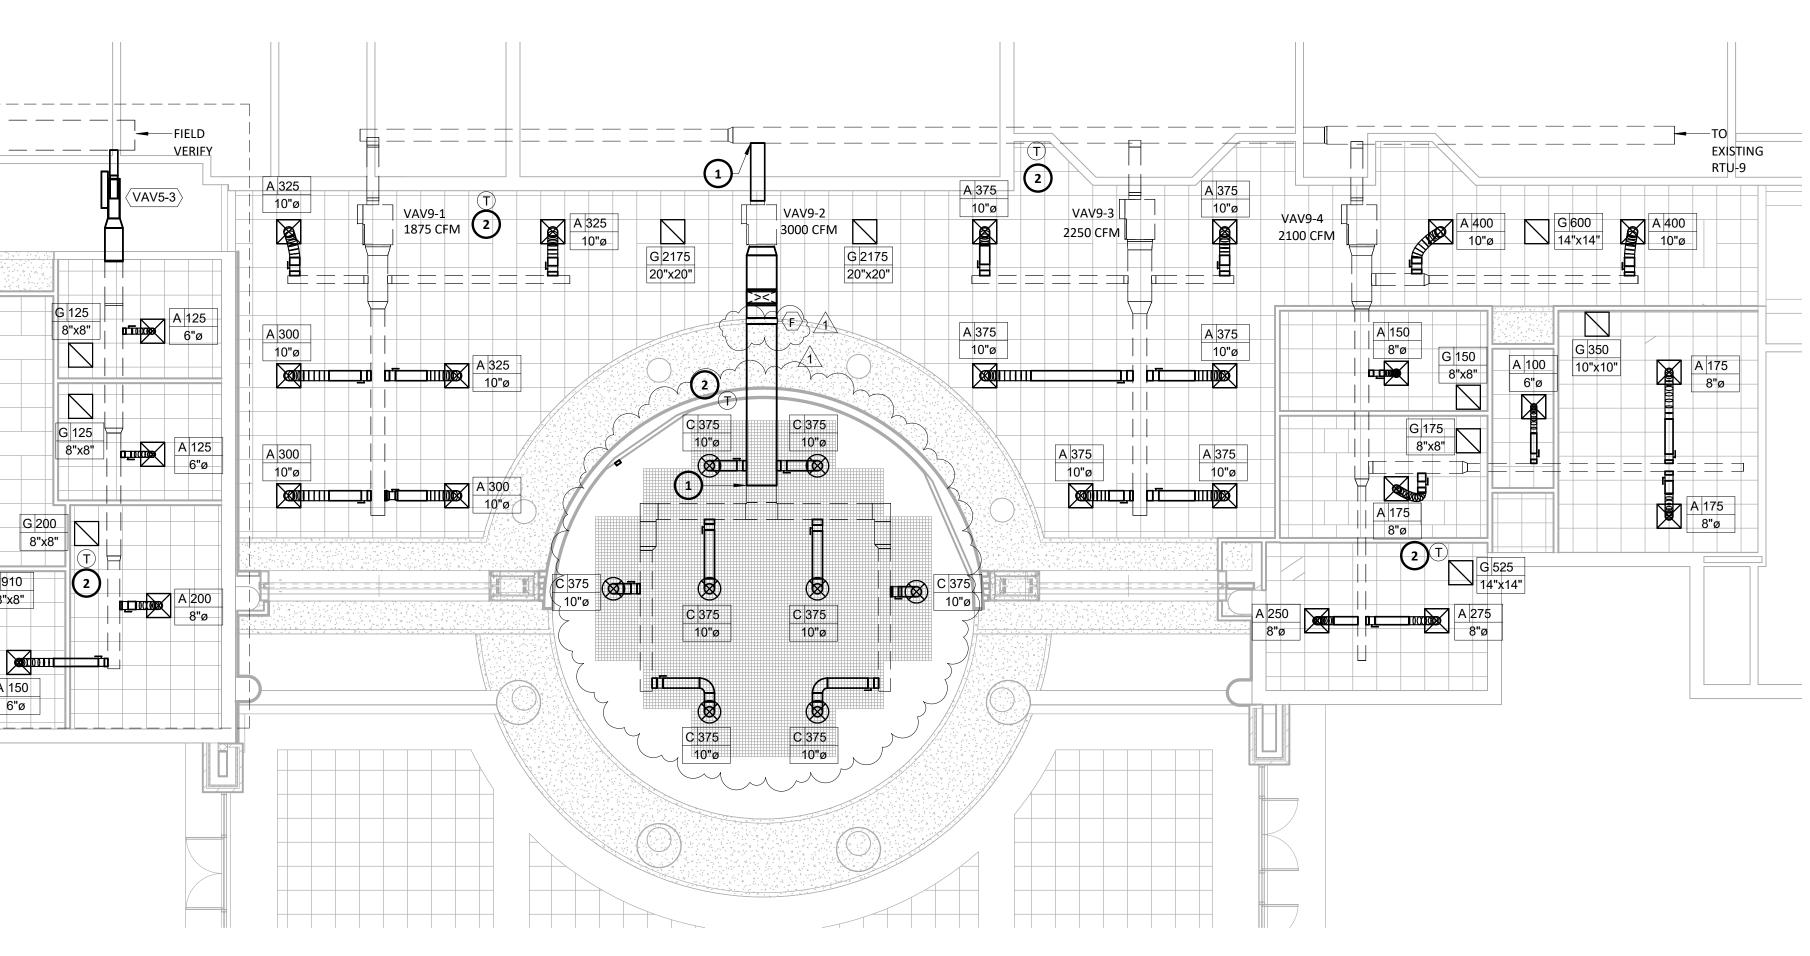

- ELECTRIC. CONTRACTOR SHALL ENGAGE AND SHALL RECOMMISSION AND REPROGRAM EXISTING TERMINAL UNITS THAT ARE IN THIS SCOPE OF WORK. COORDINATE WITH TAB FULLY FUNCTIONAL.
- SCHNEIDER ELECTRIC TO RECOMMISION
- DUCT FOR EACH SUPPLY DIFFUSER. DUCT FOR EACH SUPPLY DIFFUSER AS INDICATED. EXISTING MANUAL BALANCING
- SUCCESSFUL TESTING, ADJUSTING, AND BALANCING.
- UNITS. TERMINAL UNITS SHALL BE TESTED, RECOMISSIONED TO BE FULLY FUNCTIONAL.


DIFFUSER SUSPENDENT ABOVE CEILING. AND ACCESS DOOR EQUAL TO RUSKIN ADH22F FOR

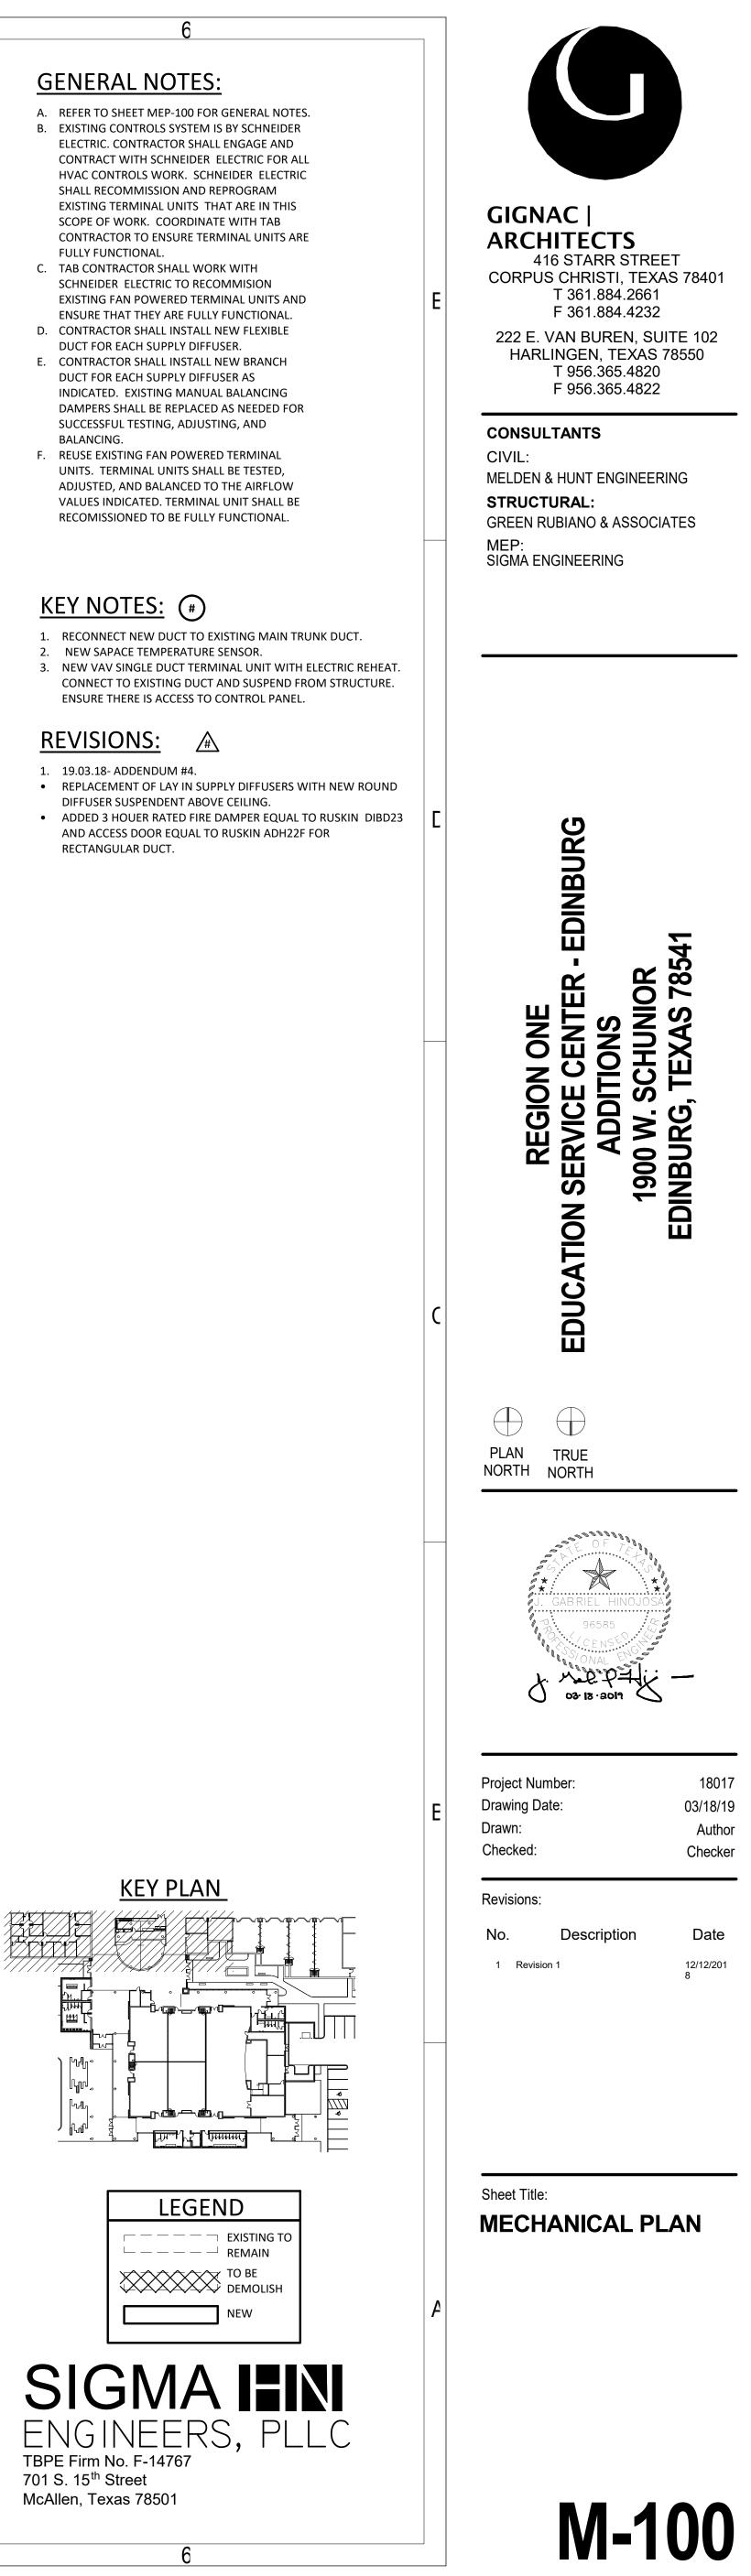

	DUAL COIL - DUAL PATH AIR HANDLING UNIT SCHEDULE	<u>REVISIONS:</u>
	Supply Fan Unit Unit Unit EAT EAT EAT EAT EAT LXWXH Weight Tag Manuf. Model STYLE LXWXH Weight Design Min.	
	Tag Manuf. Model STYLE LxWxH (in) Weight (lb) Size Type Class DRIVE Design Airflow (CFM) Min. Airflow (CFM) RPM BHP F.S.P. (inH2O) Voltage Power (HP) RPM Control Air PATH Control Class DB WB DB PB PB F.S.P. (inH2O) Voltage Power (HP) RPM Control Air PATH Control Control Capacity (MBH) DB WB DB PB Voltage Voltage Power (HP) Voltage Power (HP) Voltage Power (HP) Voltage Power (HP) Control Air PATH Capacity (MBH) DB VB PB PS Power (HP) Voltage Power (HP) Control Power (HP) Power (HP) No Power (HP) Power (HP) Control Power (HP) Power (H	$\begin{array}{c c c c c c c c c c c c c c c c c c c $
	AHU-1 DAIKIN CAH009 INDOOR 154x54x82 2946 PLENUM II DIRECT 6700 2400 2435 5.55 1.50 3.16 460/60/3 7.5 1800 VFD III 017 940 54.33	53.9 <400
E	Arres	54.3 <500
	NOTES: 1. DOUBLE WALL CONSTRUCTION WITH INJECTED FOAM MINIMUM R-13 INSULATION. 2. INTEGRAL MOTORIZED OUTSIDE AIR & RETURN AIR DAMPERS (ACTUATORS BY CONTROLS CONTRACTOR).	SOUND POWER DATA
	 PREMIUM EFFICIENCY TEFC MOTORS WITH MOTOR SHAFT GROUNDING KITS. VARIABLE FREQUENCY DRIVE WITH DISCONNECT BY MECHANICAL CONTRACTOR. DIRECT DRIVE PLENUM FAN. PROVIDE SHIPPING SPLITS. 	NARK PATH FREQUENCY MARK PATH FREQUENCY 63 125 250 500 1000 8000 AHU-1 SUPPLY: 84 77 80 90 88 83 75
	7. PROVIDE 6" BASE RAIL.	AHO-1 SCH LH OH SCH LH SCH LH
	AIR HANDLING UNIT SCHEDUL	
	UNIT UNIT Out of the second seco	Sensible Capacity (MBH) EAT-DB EAT-WB LAT-DB LAT-WB F.V. A.P.D. EWT LWT Rate (GPM) W.P.D. Maximum Maximum Control Valve Filter Type Depth A.P.D.
	TagManuf.ModelSTYLE(in)(lb)(CFM)(CFM)(CFM)(in H2O)DriveTypeClassRPM(inH2O)(HP)(HP)RPMVoltageControl(MBH)AHU-3DAIKINCAHINDOOR128x86x6311511,2003,700180018002.0DIRECTAIRFOIL217503.3710.39151800460/3/60VFD379.8AHU-4DAIKINCAHINDOOR128x86x6311511,2003,700180018002.0DIRECTAIRFOIL217503.3710.39151800460/3/60VFD379.8AHU-5 (Alt #1)DAIKINCAHINDOOR108x42x4011512,0001,0005301002.0DIRECTAIRFOIL217503.521.7321800460/3/60VFD78.4	(MBH) °F °F °F (ft/min) (inH2O) °F (GPM) (ftH2O) Rows FPI Valve Filter Type Depth (inH2O) 298.6 79.0 65.0 54.6 53.7 <500 0.58 44 56 62.8 <10 6 10 3-WAY CCV ANGLED MERV 8 2" 0.5 298.6 79.0 65.0 54.6 53.7 <500 0.58 44 56 62.8 <10 6 10 3-WAY CCV ANGLED MERV 8 2" 0.5 60.7 81.7 66.5 53.9 53.6 <500 0.86 44 56 12.9 <10 6 10 3-WAY CCV ANGLED MERV 8 2" 0.5 60.7 81.7 66.5 53.9 53.6 <500 0.86 44 56 12.9 <10 6 10 3-WAY CCV ANGLED MERV 8 2" 0.5
	NOTES: 1. DOUBLE WALL CONSTRUCTION WITH INJECTED FOAM MINIMUM R-13 INSULATION. 2. INTEGRAL MOTORIZED OUTSIDE AIR & RETURN AIR DAMPERS (ACTUATORS BY CONTROLS CONTRACTOR).	SOUND POWER DATA SOUND POWER DATA
	 PREMIUM EFFICIENCY TEFC MOTORS WITH MOTOR SHAFT GROUNDING KITS. VARIABLE FREQUENCY DRIVE WITH DISCONNECT BY MECHANICAL CONTRACTOR. DIRECT DRIVE PLENUM FAN. SUMPRIME SPUTE 	MARK PATH FREQUENCY MARK PATH FREQUENCY MARK PATH 63 125 250 500 1000 2000 4000 8000 63 125 250 500 1000 2000 AHU-3 SUPPLY: 89 81 92 89 89 80 SUPPLY: 71 69 71 82 74 73 77 70
C	6. SHIPPING SPLITS.	& RETURN: 79 76 86 78 73 69 58 AHU-5 RETURN: 65 59 59 57 59 62 52 AHU-4 CASING: 79 74 79 68 70 61 51 51 64 59 53 64 52 45 46 51
		ERMINAL UNIT SCHEDULE
	$\frac{DOBLE LINE}{ACCESS DOOR}$ $\frac{AD}{D}$ $\frac{B'B}{B'B'}$ $\frac{B'B'}{B'B'}$	INLET S.P.MAX NC LEVELSELECTRIC HEAT COILBIDIN W.G.RAD.DISCH.CFMKWVOLT/PHSTEPSNOTESPACKAGE0.525209259.5480/33ALLBASE BID0.525209409.5480/33ALLBASE BID
	BDD BDD BDD AIR FLOW IN DIRECTION OF ARROW AIR FLOW IN DIRECTION OF A	0.5 25 20 540 540 540 540 540 540 540 540 0.5 25 20 1100 11.0 480/3 3 ALL BASE BID 0.5 32 18 390 4.0 480/3 2 ALL BASE BID 0.5 25 20 950 9.5 480/3 3 ALL BASE BID
	FIRE DAMPER F <th< th=""><th>0.5 25 20 950 9.5 480/3 3 ALL BASE BID 0.5 25 20 1150 11.5 480/3 3 ALL BASE BID 0.5 25 20 1150 11.5 480/3 3 ALL BASE BID 0.5 24 14 300 3.0 480/3 1 ALL BASE BID</th></th<>	0.5 25 20 950 9.5 480/3 3 ALL BASE BID 0.5 25 20 1150 11.5 480/3 3 ALL BASE BID 0.5 25 20 1150 11.5 480/3 3 ALL BASE BID 0.5 24 14 300 3.0 480/3 1 ALL BASE BID
	FLEXIBLE CONNECTION FC FC FC FC FC FC FC VAV-9 AHU-5 TITUS DESV 10" Ø 14 X 12 900 360 FLEXIBLE CONNECTION FC FC FC FC FC VAV-9 AHU-5 TITUS DESV 10" Ø 14 X 12 900 360 FLEXIBLE CONNECTION FC FC FC VAV-9 AHU-5 TITUS DESV 10" Ø 14 X 12 900 360 FLEXIBLE CONNECTION FC	0.5 32 18 450 4.80/3 2 ALL ALT #1 0.5 32 18 550 5.5 480/3 2 ALL ALT #1 0.5 24 14 375 4.0 480/3 1 ALL ALT #3
	MOTORIZED DAMPER M	0.5 32 18 525 5.5 480/3 2 ALL ALT #3 0.5 24 14 300 4.0 480/3 1 ALL ALT #3
	CONTROL DAMPER Image: Control Damper VD VD VD </th <th></th>	
	DUCT ELBOW WITH TURNING VANES F CEILING RETURN GRILLE/REGISTER F<	
C	DUCT SECTION - SUPPLY AIR CEILING EXHAUST FAN (EF) CEILING EXHAUST GRILLE/REGISTER CEILING EXHAUST GRILLE/REGISTER CEILING EXHAUST GRILLE/REGISTER CEILING EXHAUST GRILLE/REGISTER	SCHEDULE
	DUCT SECTION - EXHAUST AIR SERVICE DESCRIPTION DUCT SECTION - RETURN, OUTSIDE, C C C C C C C C C C C C C C C C C C C	MANUFACTURER MAX. NC. MODEL NO. LEVEL (1) REMARKS
	OR RELIEF AIR SIDEWALL SUPPLY GRILLE/REGISTER A SUPPLY THROW (UNLESS NOTED OTHERWISE), ROUND NECK. DUCT, INCLINED DROP H IIIIIIIIIIIIIIIIIIIIIIIIIIIIIIIIIIII	OMINI-AA 30 FTINISH
	DUCT, INCLINED RISE +++ Image: sidewall return/exhaust grilder register FLEXIBLE DUCT - ROUND 8"Image: sidewall return/exhaust grilder register Image: sidewall return/exhaust grilder register FLEXIBLE DUCT - ROUND 8"Image: sidewall return/exhaust grilder register Image: sidewall return/exhaust grilder register FLEXIBLE DUCT - ROUND 8"Image: sidewall return/exhaust grilder register Image: sidewall return/exhaust grilder register	PATTERN, TITUS WHITE R-QMNI TITUS 300FL 30 FINISH
	DUCT TRANSITION $14/10$ $10/10$ $14/10$ $14/10$ $14/10$ $14/10$ $10/10$ EXTRACTOR EXTRACTOR E SUPPLY 50° ANGLE OF ROTATION, OPPOSED BLADE DAMPER.	NIMUM TITUS FINISH DL 35 FINISH
	DUCT TRANSITION 10/10 12/12 8"2 DUCT TRANSITION 10/10 12/12 8"2 Image: Comparison of the comp	PAR-AA 35 FINISH
	FIRST DIMENSION IS SIDE SHOWN (NET CLEAR INSIDE DIMENSION) DOOR UNDERCUT -UC-+ I RETURN ALUMINUM CONSTRUCTION. DOOR LOUVER -L-+ -L-+ SURFACE MOUNTED RETURN GRILLE WITH 3/4" SPACING. ALUMINUM	TITUSWHITE50F30FINISHTITUSWHITE350FL30FINISH
	MISCELLANEOUS SYMBOLS Image: Diffuser, grille or register mark	
	SD DUCT SMOKE DETECTOR AIR FLOW (CFM) 12"2" NECK SIZE/ RECTANGULAR FACE SIZE / NOTES 6 TYP. QUANTITY / NOTES (WHERE APPLICABLE) CBA = COLOR BY ARCHITECT	R FLOW (CFM
E	1@300 AIR FLOW (CFM) PER DIFFUSER 1@300 AIR FLOW (CFM) PER DIFFUSER 6 TYP. QUA 300 TOTAL AIR FLOW (CFM) 0 OTAL AIR FLOW (CFM) 0 OTAL AIR FLOW (CFM)	ECK SIZE / RECTANGULAR FACE SIZE / NOTES UANTITY / NOTES (WHERE APPLICABLE)
	HUMIDISTAT	NC MANUF. MODEL
5	RH RELATIVE HUMIDITY SENSOR OI IDENTIFYING NOMBER OR LETTER FOR SECTIONS. (T) THERMOSTAT OR TEMPERATURE SENSOR (MOUNT 48" AFF)	 <20 TITUS FL-10-HT
NTRAL.r	Image: Control of the control of t	
	F FREZESTAT ENLARGED DETAIL REFERENCE 2. PROVIDE FLEXIBLE DUCT CONNECTIONS TO PLENOM BOX. S PROVIDE WITH ECXX ENDCAPS. 3. PROVIDE WITH ECXX ENDCAPS. S MATCHLINE 4. PROVIDE BORDER TYPE APPLICABLE FOR EACH CEILING APPLICATION.	
	EXHAUST FAN	
	EF-2 600 WOMENS ROOF CENT DB 1496 0.5 .1	HPDRIVEVOLTAGEMAX. SONESCONTROLMANUFACTURERMODELNOTES0.099DIRECT120/18.4DDCCOOK101C15DALL.099DIRECT120/18.4DDCCOOK101C15DALL.7 WATTSDIRECT120/16.8DDCCOOK90C15DHALL
	EF-4 375 WOMEN'S ROOF CENT DB 1503 0.5 90.4 EF-5 600 MENS, JAN, FAMILY ROOF CENT DB 1496 0.5 0.5	.4 WATTS DIRECT 120/1 7.6 DDC COOK 90C15DH ALL .099 DIRECT 120/1 8.4 DDC COOK 101C15D ALL .098 DIRECT 120/1 6.2 DDC COOK 120C15D ALL
	EF-7 800 FOOD PREP. ROOF CENT DB 1139 0.5 . NOTES: 1. INTEGRAL DISCONNECT SWITCH FROM FACTORY. 5 5	.105 DIRECT 120/1 6.5 SWITCH COOK 120C15D ALL
W W	 BACK DRAFT DAMPER. FACTORY MOUNTED FAN SPEED CONTROL. FACTORY MOUNTED FAN SPEED CONTROL. 14" GALVANIZED ROOF CURB WITH DAMPER TRAY. EQUIPMENT OR CURB MANUFACTURER IS RESPONSIBLE FOR PROVIDING A CURB WHICH IS COMPLIANT 	ANT WITH THE APPLICABLE IBC, ASCE, AND TEXAS DEPARTMENT OF INSURANCE
9 10:51:03 AM		ENGINE TBPE Firm No. F-1
		701 S. 15 th Street McAllen, Texas 78

C:\Users\Sign 3/18/2019 10:



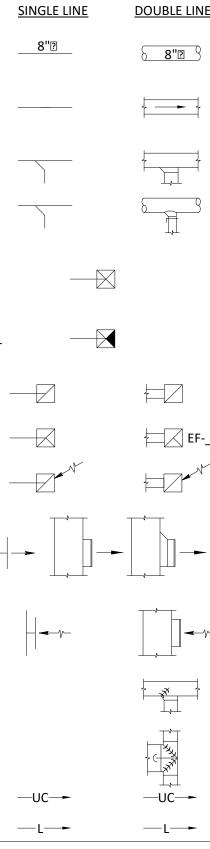



<u>/#\</u>


DUM #4. REVISION TO MODEL NUMBER FOR DIFFUSER TYPE "C".






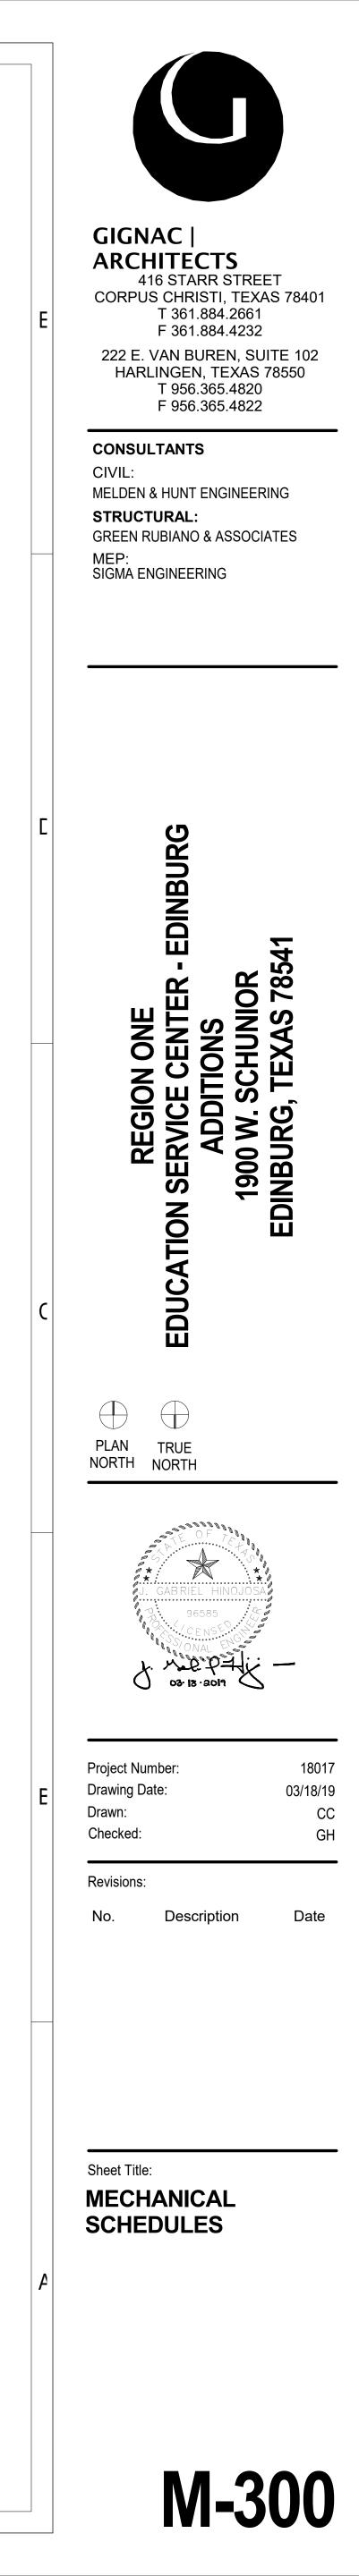

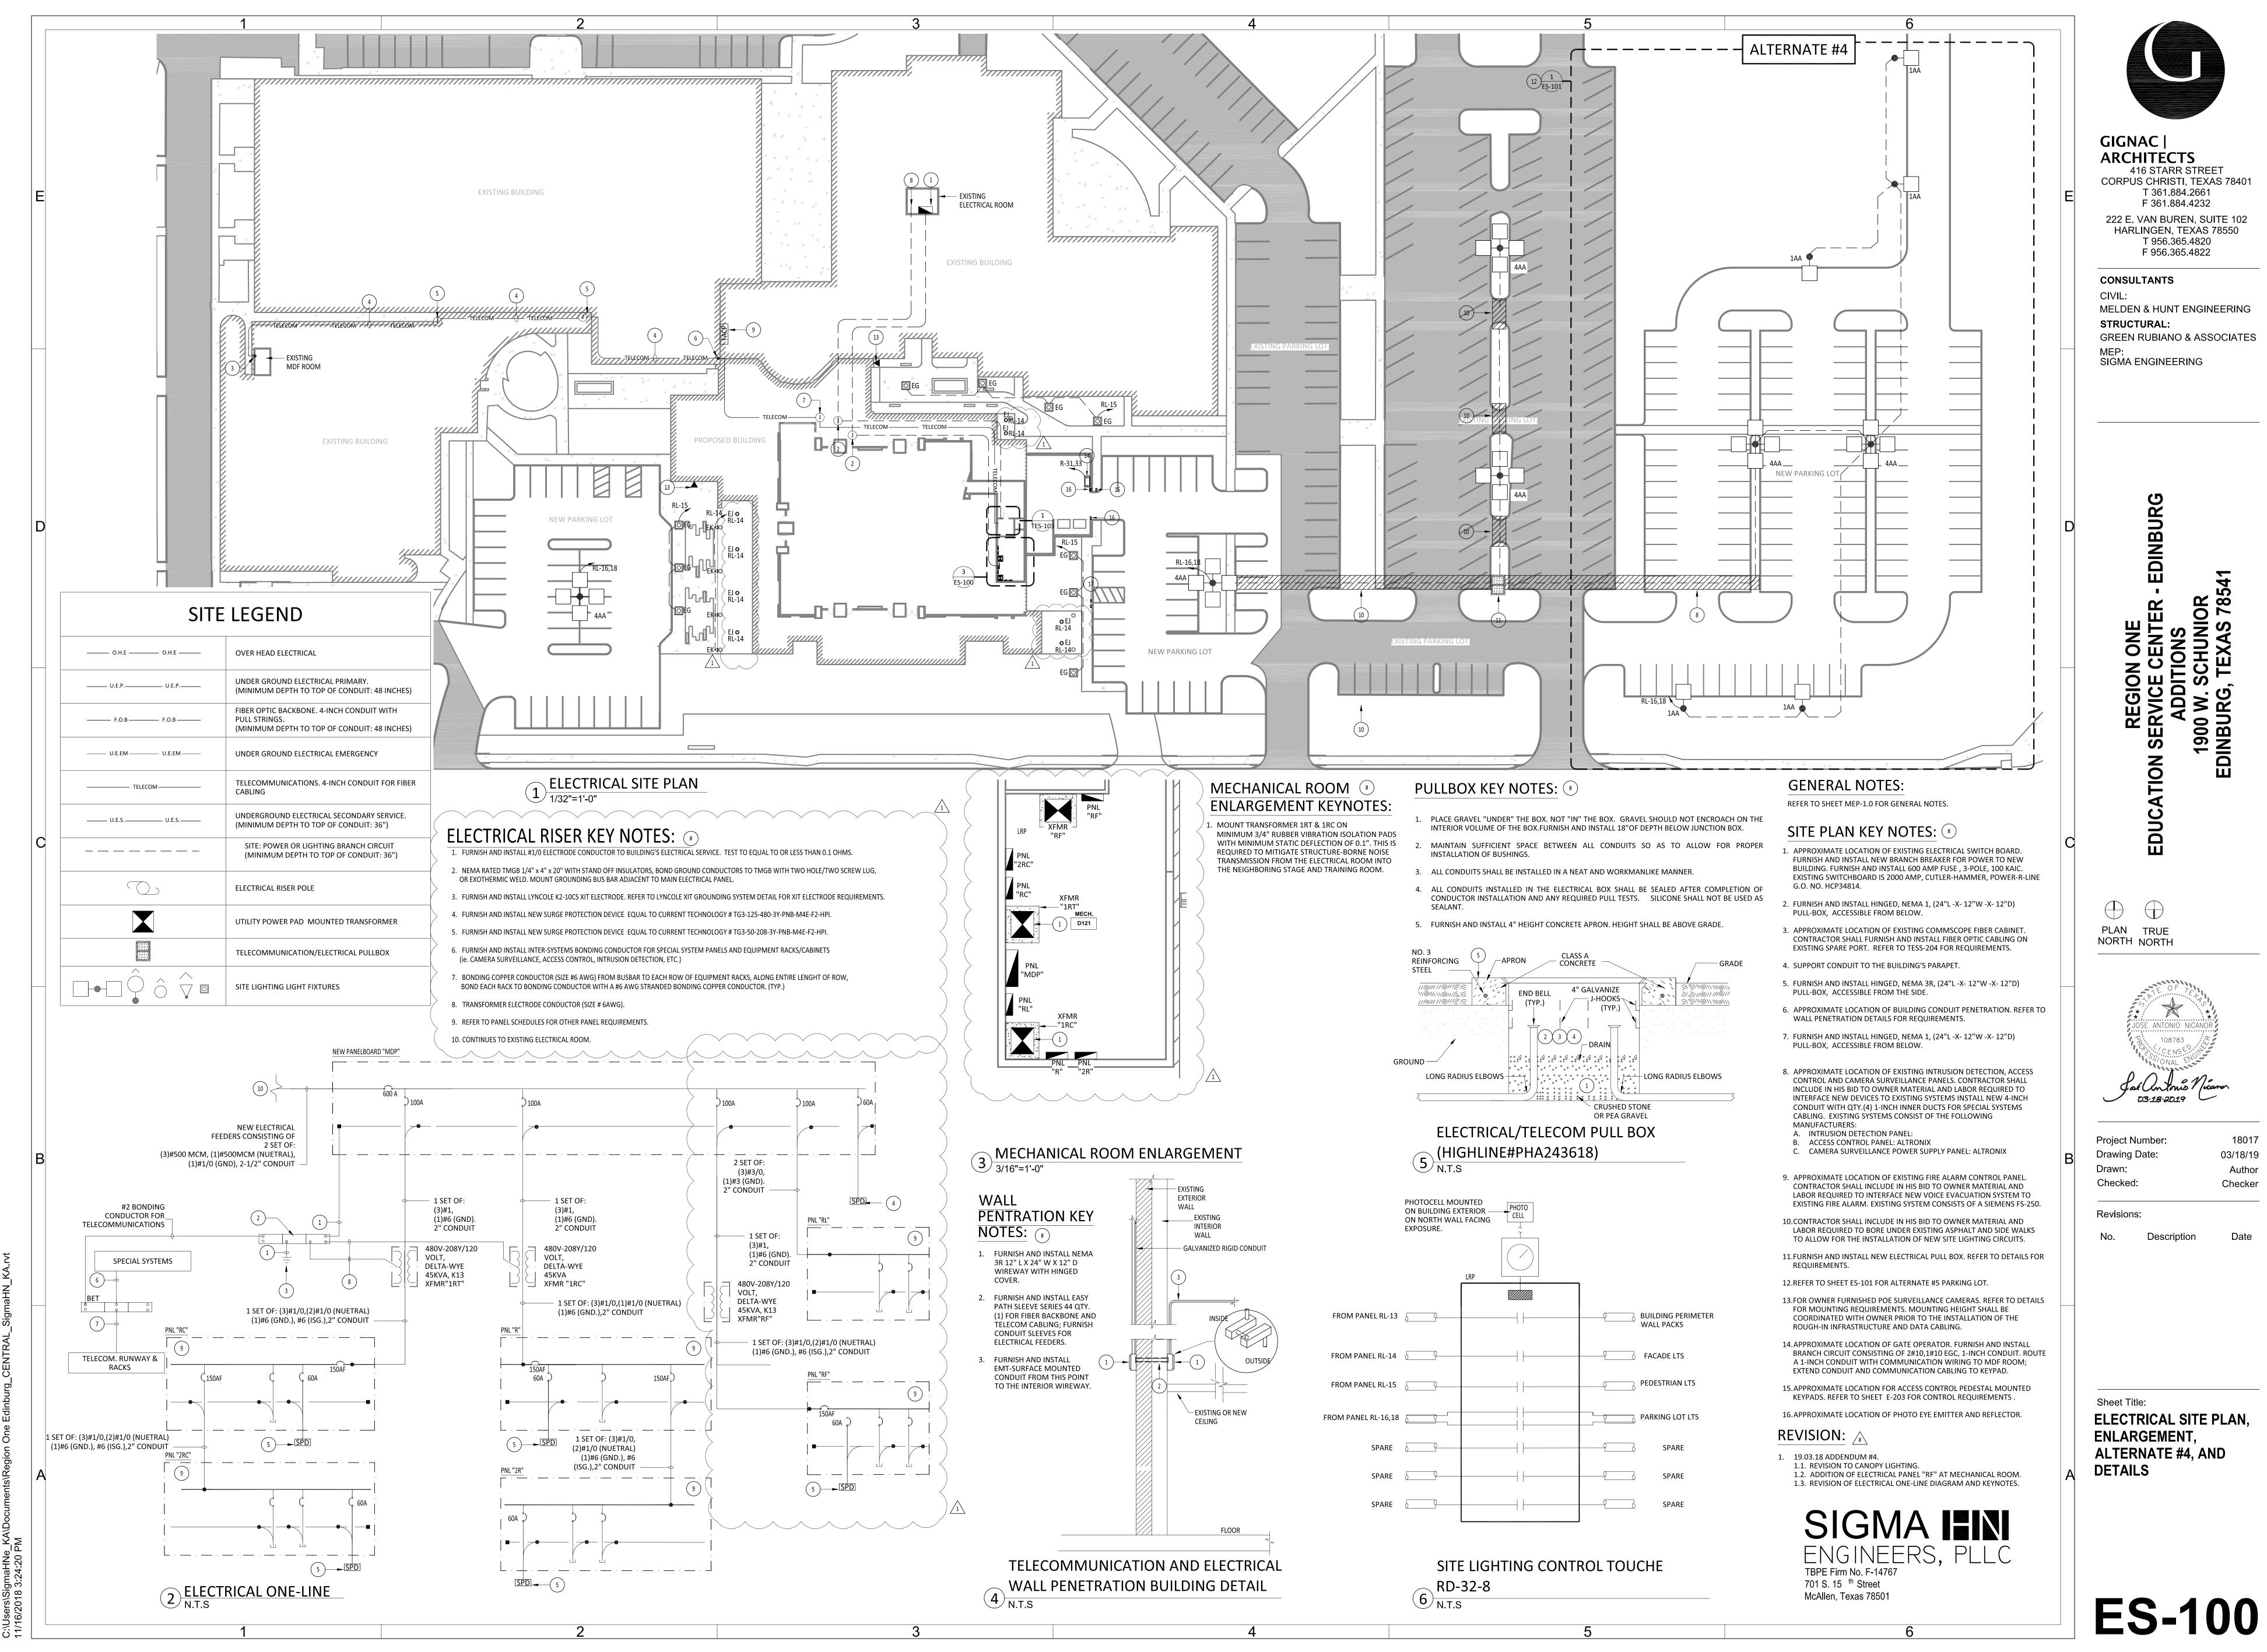


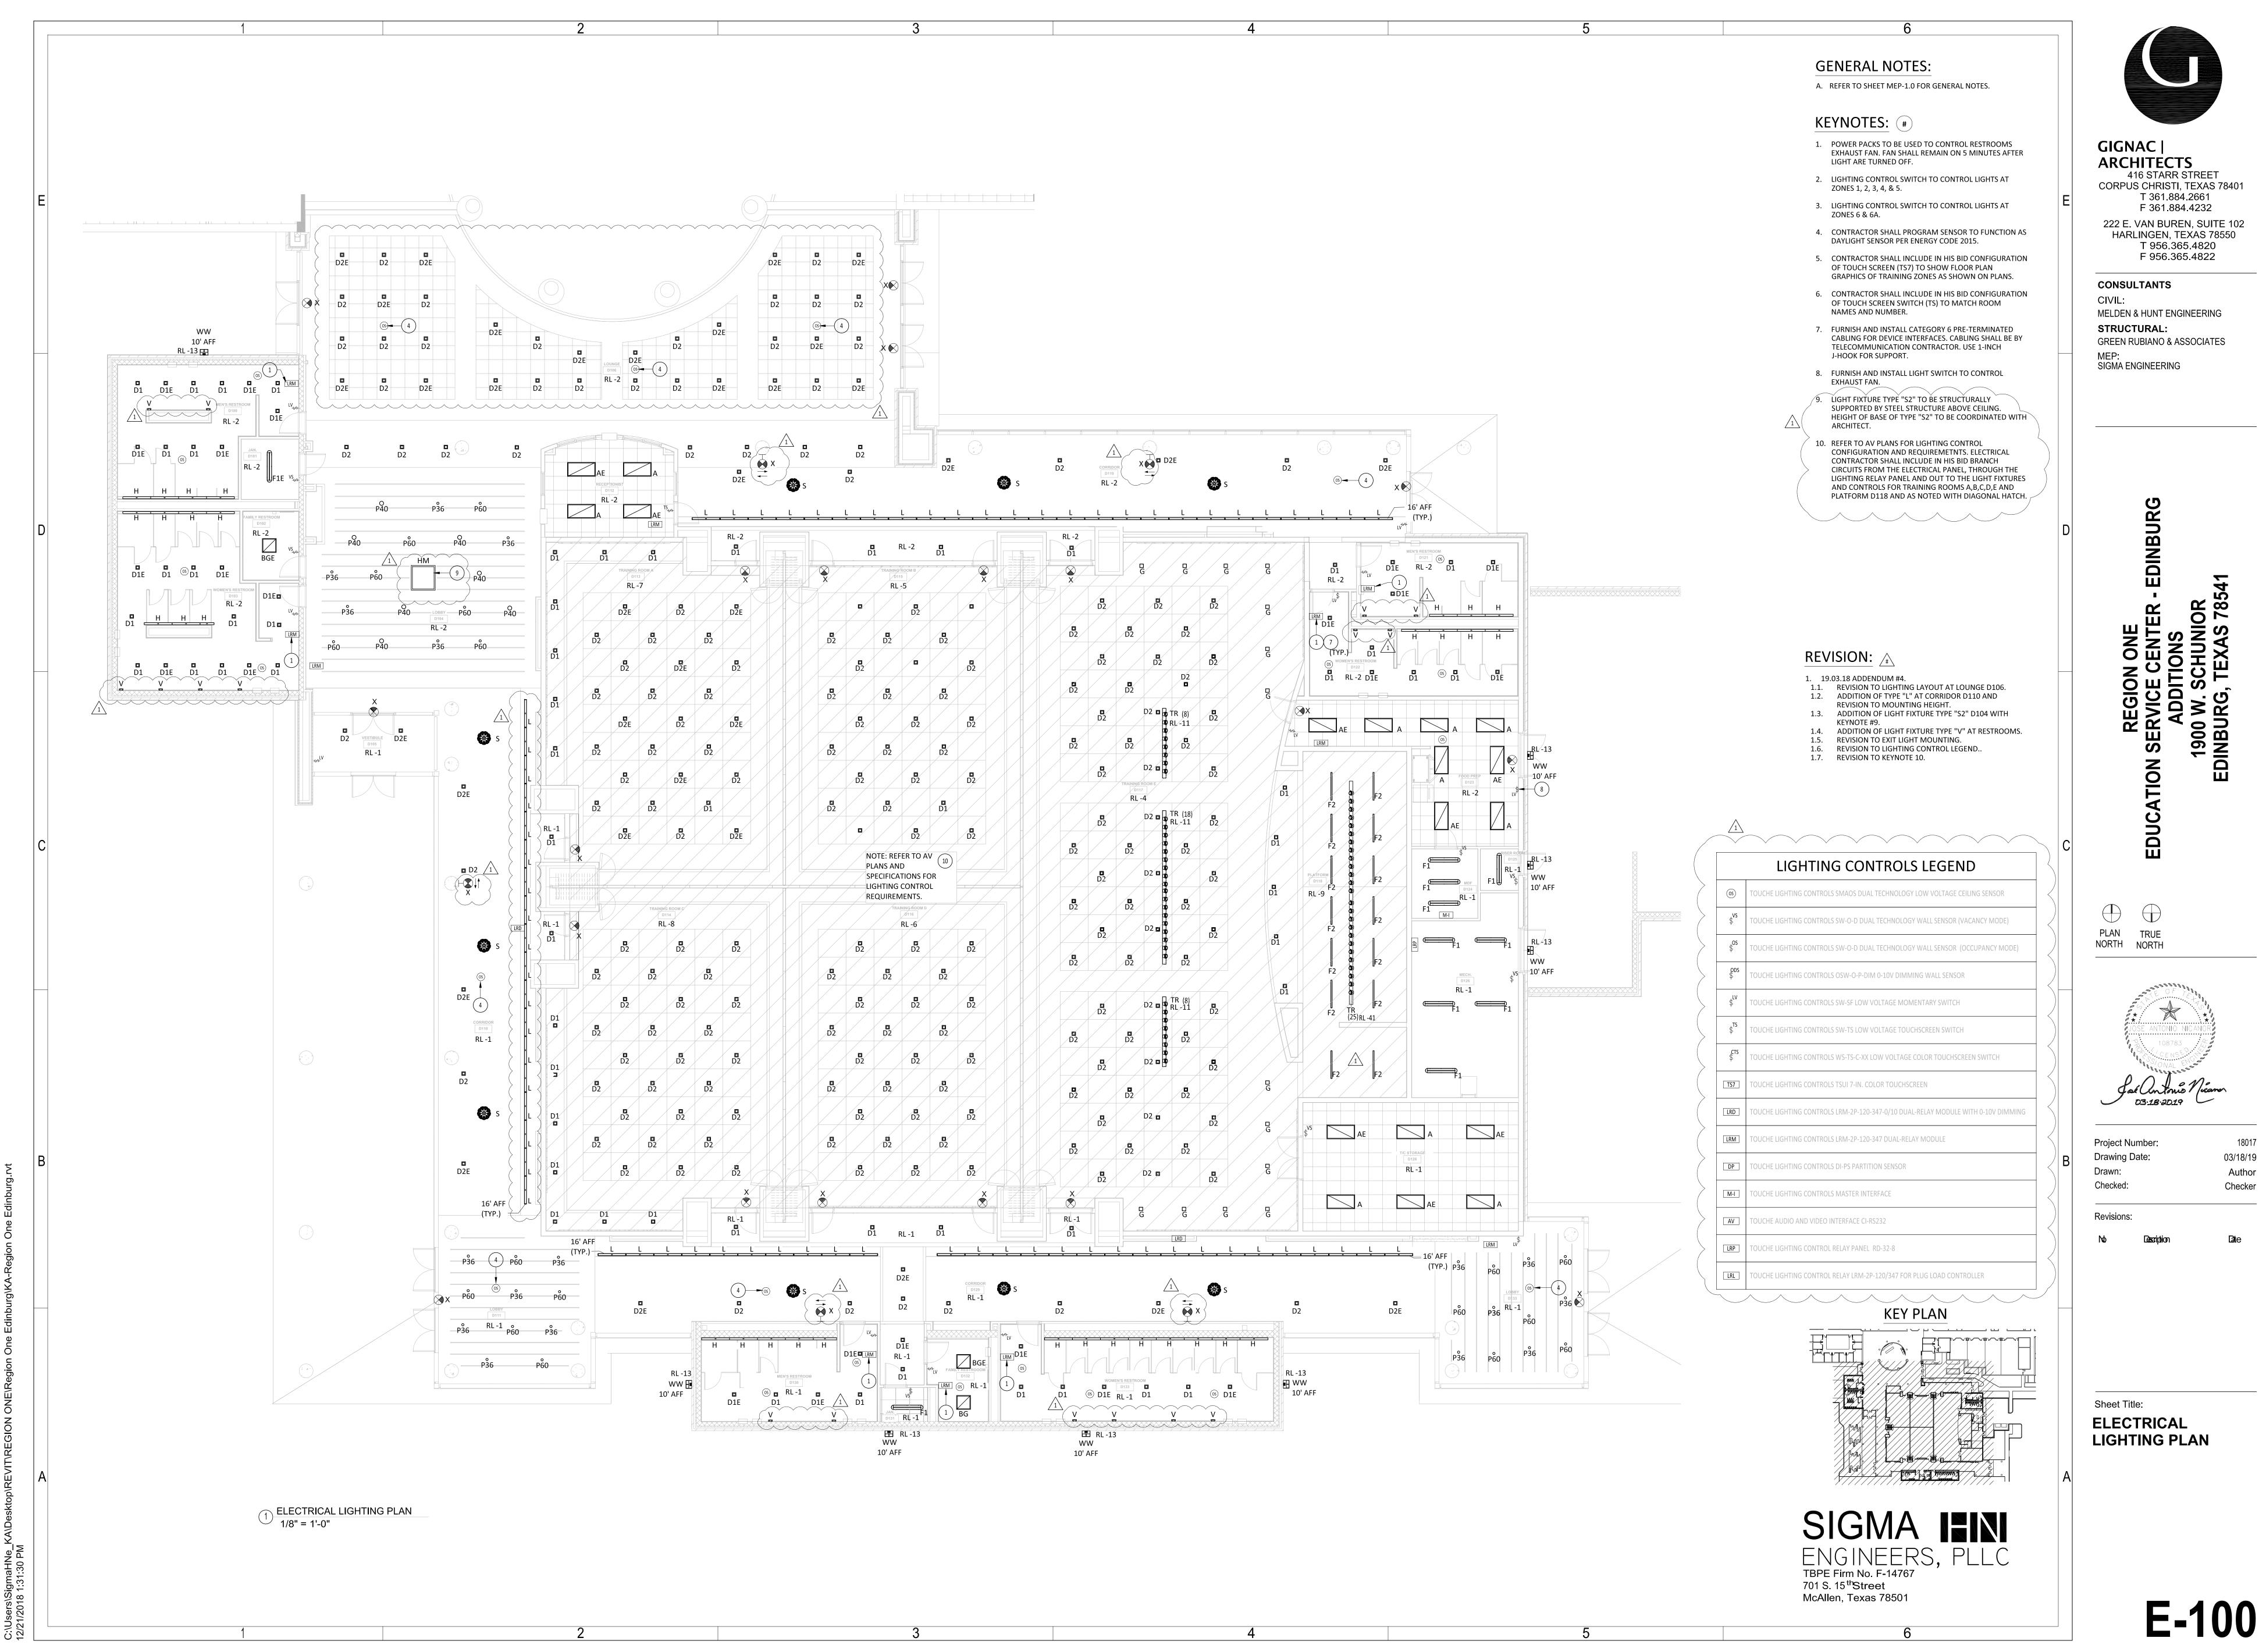

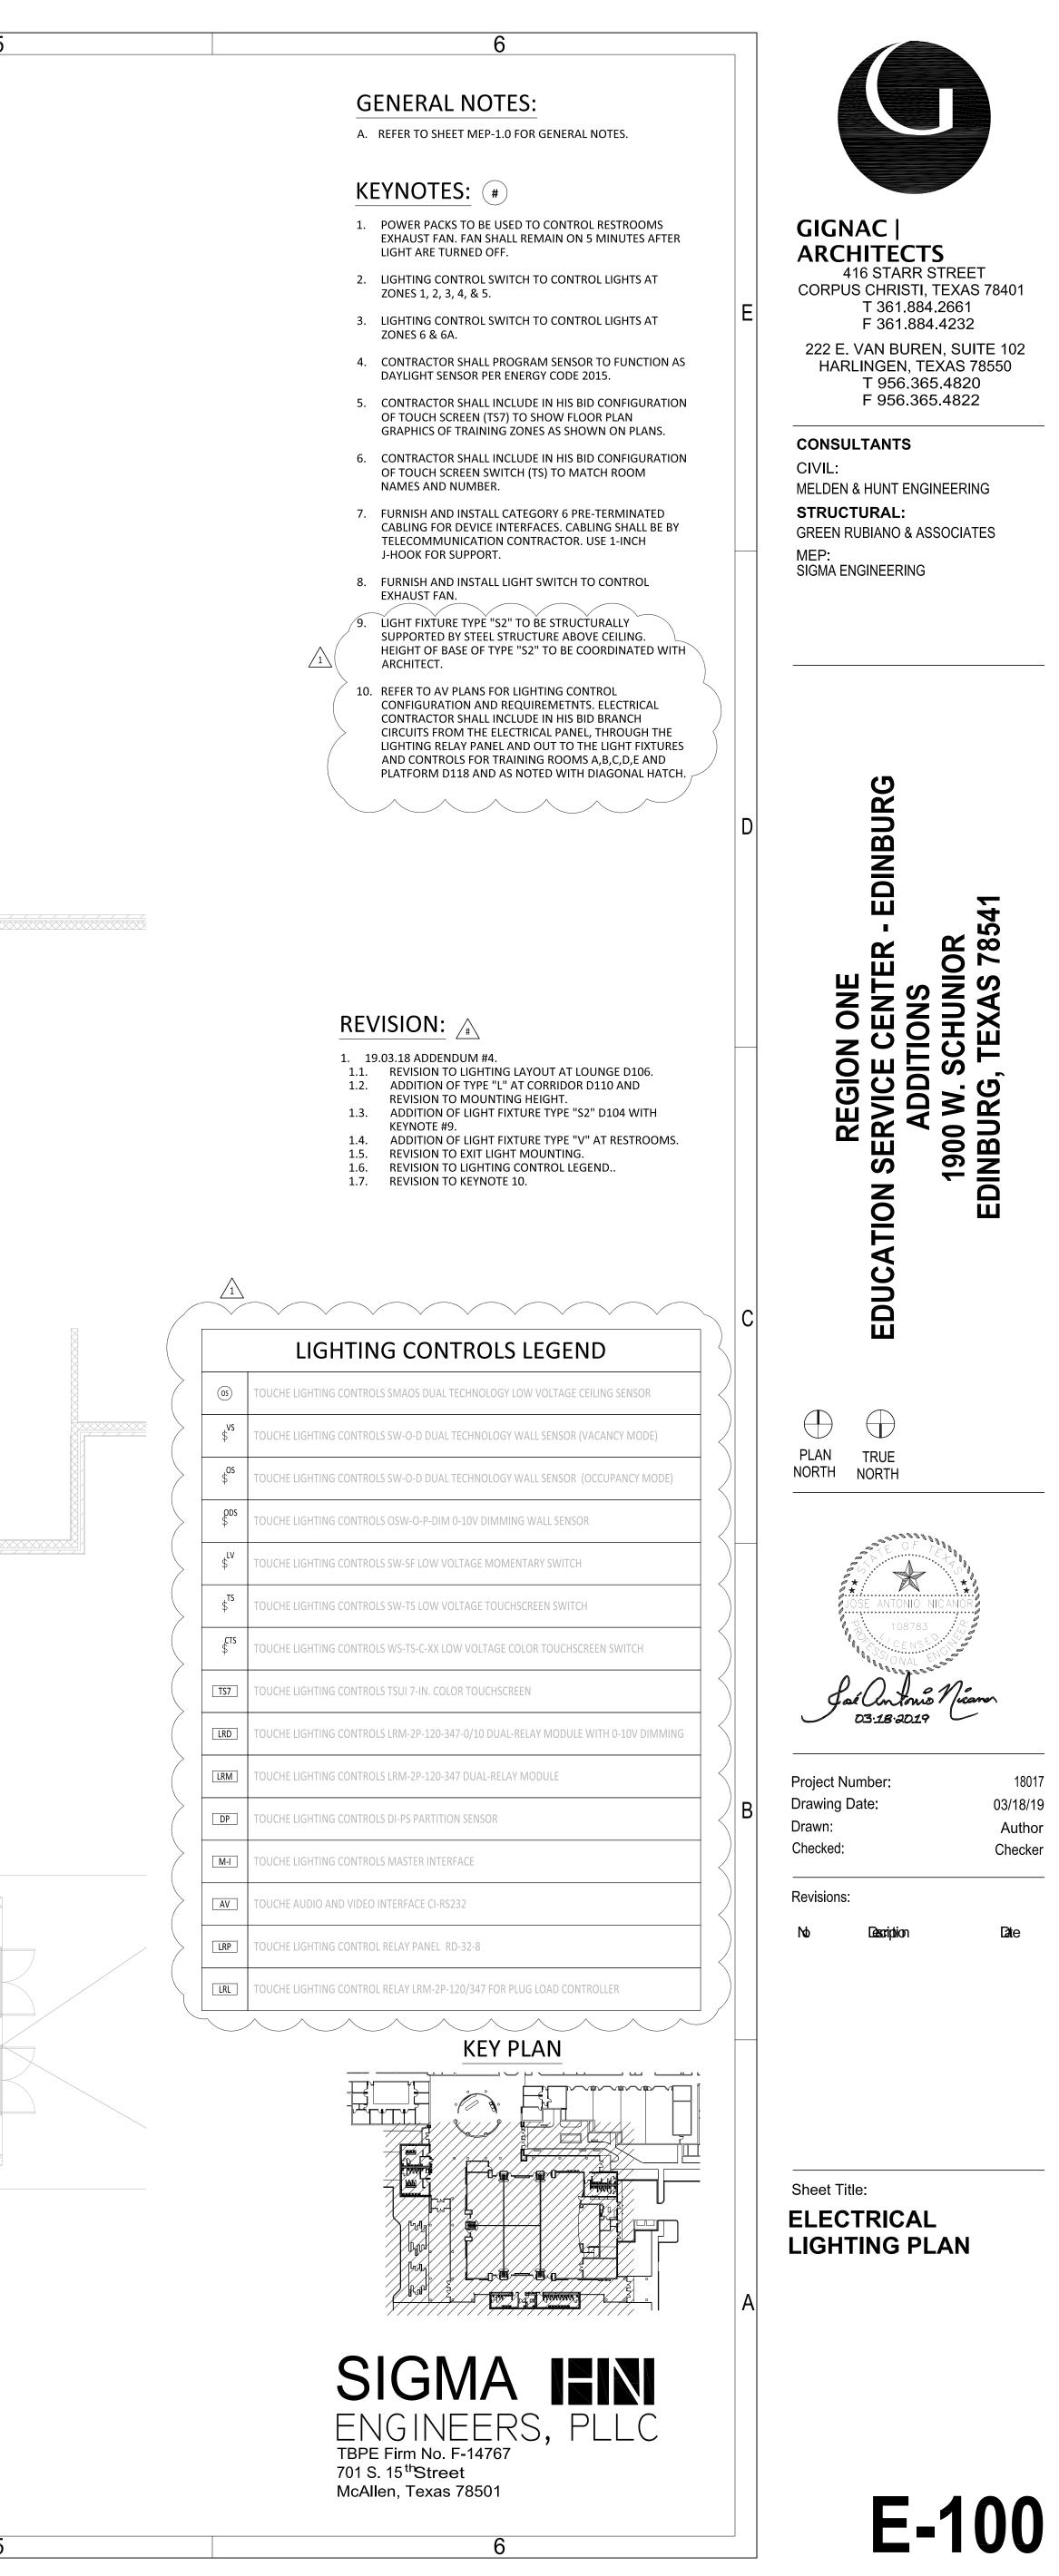

4 40	
1. 19.	03.18 ADDENDUM #4.
1.1.	REVISION TO LIGHTING LAYOUT AT LOUN
1.2.	ADDITION OF TYPE "L" AT CORRIDOR D11
	REVISION TO MOUNTING HEIGHT.
1.3.	ADDITION OF LIGHT FIXTURE TYPE "S2" D

	LIGHTING CONTROLS LEGEND
05	TOUCHE LIGHTING CONTROLS SMAOS DUAL TECHNOLOGY LOW VOLTAGE CEILING SENSOR
vs \$	TOUCHE LIGHTING CONTROLS SW-O-D DUAL TECHNOLOGY WALL SENSOR (VACANCY MODE)
_OS \$	TOUCHE LIGHTING CONTROLS SW-O-D DUAL TECHNOLOGY WALL SENSOR (OCCUPANCY MODE)
ods \$	TOUCHE LIGHTING CONTROLS OSW-O-P-DIM 0-10V DIMMING WALL SENSOR
۲۷ \$	TOUCHE LIGHTING CONTROLS SW-SF LOW VOLTAGE MOMENTARY SWITCH
\$ ^{TS}	TOUCHE LIGHTING CONTROLS SW-TS LOW VOLTAGE TOUCHSCREEN SWITCH
CTS \$	TOUCHE LIGHTING CONTROLS WS-TS-C-XX LOW VOLTAGE COLOR TOUCHSCREEN SWITCH
TS7	TOUCHE LIGHTING CONTROLS TSUI 7-IN. COLOR TOUCHSCREEN
LRD	TOUCHE LIGHTING CONTROLS LRM-2P-120-347-0/10 DUAL-RELAY MODULE WITH 0-10V DIMMI
LRM	TOUCHE LIGHTING CONTROLS LRM-2P-120-347 DUAL-RELAY MODULE
DP	TOUCHE LIGHTING CONTROLS DI-PS PARTITION SENSOR
M-I	TOUCHE LIGHTING CONTROLS MASTER INTERFACE
AV	TOUCHE AUDIO AND VIDEO INTERFACE CI-RS232
LRP	TOUCHE LIGHTING CONTROL RELAY PANEL RD-32-8
LRL	TOUCHE LIGHTING CONTROL RELAY LRM-2P-120/347 FOR PLUG LOAD CONTROLLER

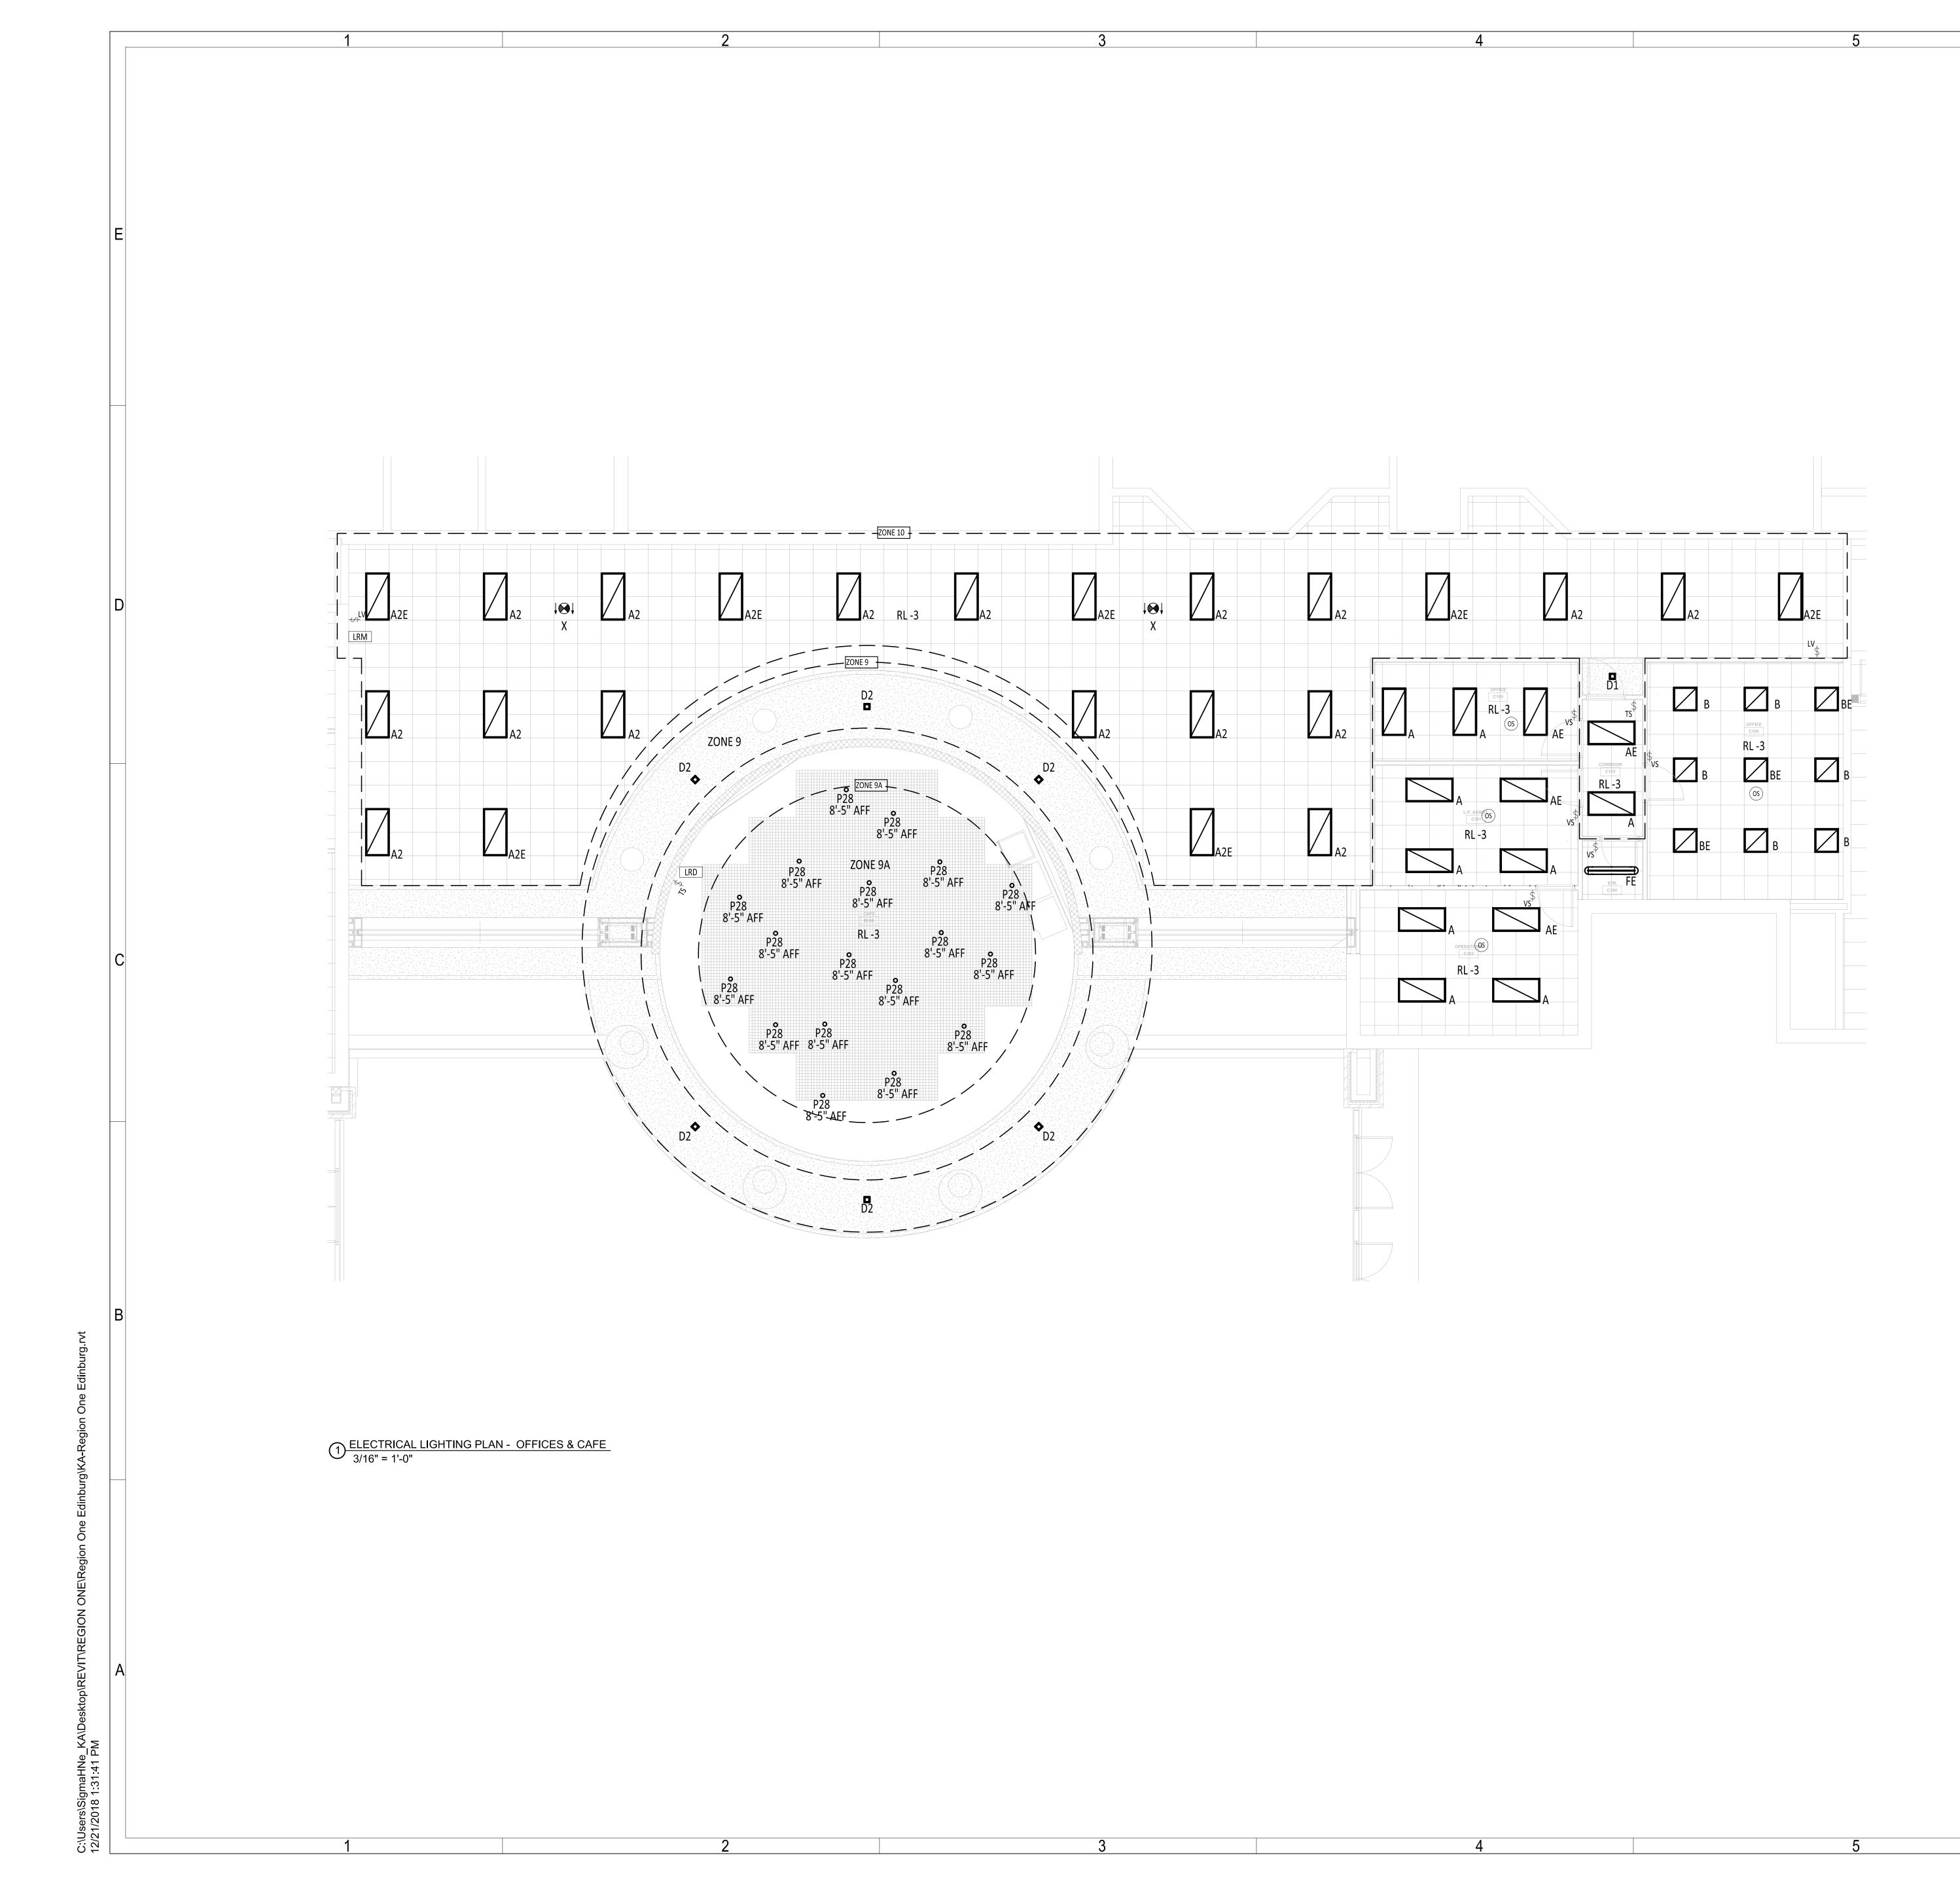

GENERAL NOTES:


A. REFER TO SHEET MEP-1.0 FOR GENERAL NOTES.

REVISION:


1. 19.03.18 ADDENDUM #4. REVISION TO LIGHTING CONTROL LEGEND.


	LIGHTING CONTROLS LEGEND
05	TOUCHE LIGHTING CONTROLS SMAOS DUAL TECHNOLOGY LOW VOLTAGE CEILING SENSOR
\$ ^{VS}	TOUCHE LIGHTING CONTROLS SW-O-D DUAL TECHNOLOGY WALL SENSOR (VACANCY MODE)
\$ \$	TOUCHE LIGHTING CONTROLS SW-O-D DUAL TECHNOLOGY WALL SENSOR (OCCUPANCY MODE)
ODS \$	TOUCHE LIGHTING CONTROLS OSW-O-P-DIM 0-10V DIMMING WALL SENSOR
\$ ^{LV}	TOUCHE LIGHTING CONTROLS SW-SF LOW VOLTAGE MOMENTARY SWITCH
\$ ^{TS}	TOUCHE LIGHTING CONTROLS SW-TS LOW VOLTAGE TOUCHSCREEN SWITCH
CTS \$	TOUCHE LIGHTING CONTROLS WS-TS-C-XX LOW VOLTAGE COLOR TOUCHSCREEN SWITCH
TS7	TOUCHE LIGHTING CONTROLS TSUI 7-IN. COLOR TOUCHSCREEN
LRD	TOUCHE LIGHTING CONTROLS LRM-2P-120-347-0/10 DUAL-RELAY MODULE WITH 0-10V DIMMIN
LRM	TOUCHE LIGHTING CONTROLS LRM-2P-120-347 DUAL-RELAY MODULE
DP	TOUCHE LIGHTING CONTROLS DI-PS PARTITION SENSOR
M-I	TOUCHE LIGHTING CONTROLS MASTER INTERFACE
AV	TOUCHE AUDIO AND VIDEO INTERFACE CI-RS232
LRP	TOUCHE LIGHTING CONTROL RELAY PANEL RD-32-8
LRL	TOUCHE LIGHTING CONTROL RELAY LRM-2P-120/347 FOR PLUG LOAD CONTROLLER

KEY PLAN

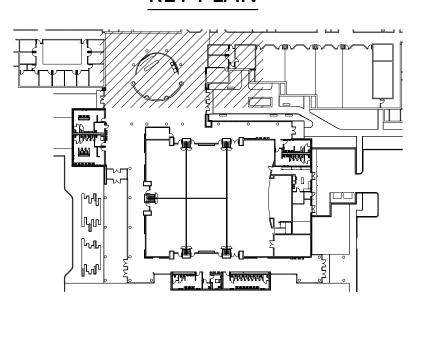



SIGNA PLLC ENGINEERS, PLLC TBPE Firm No. F-14767 701 S. 15th Street McAllen, Texas 78501

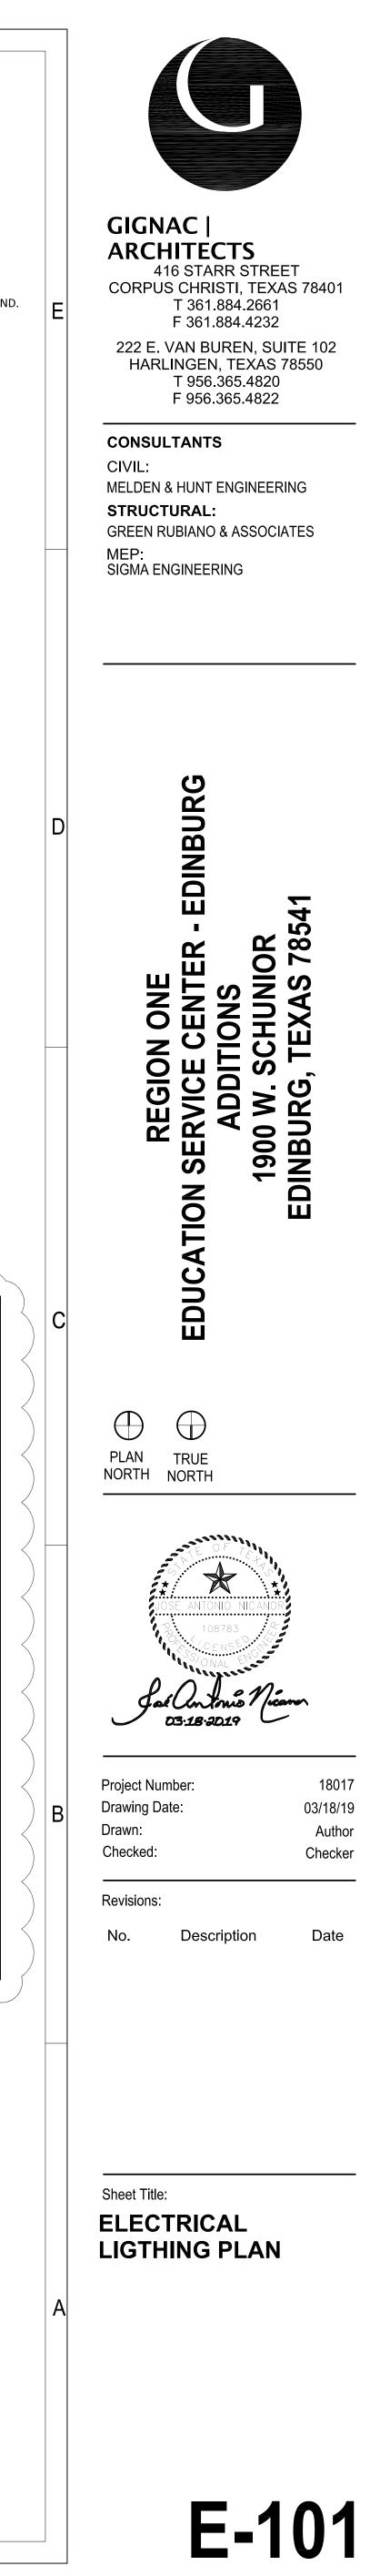

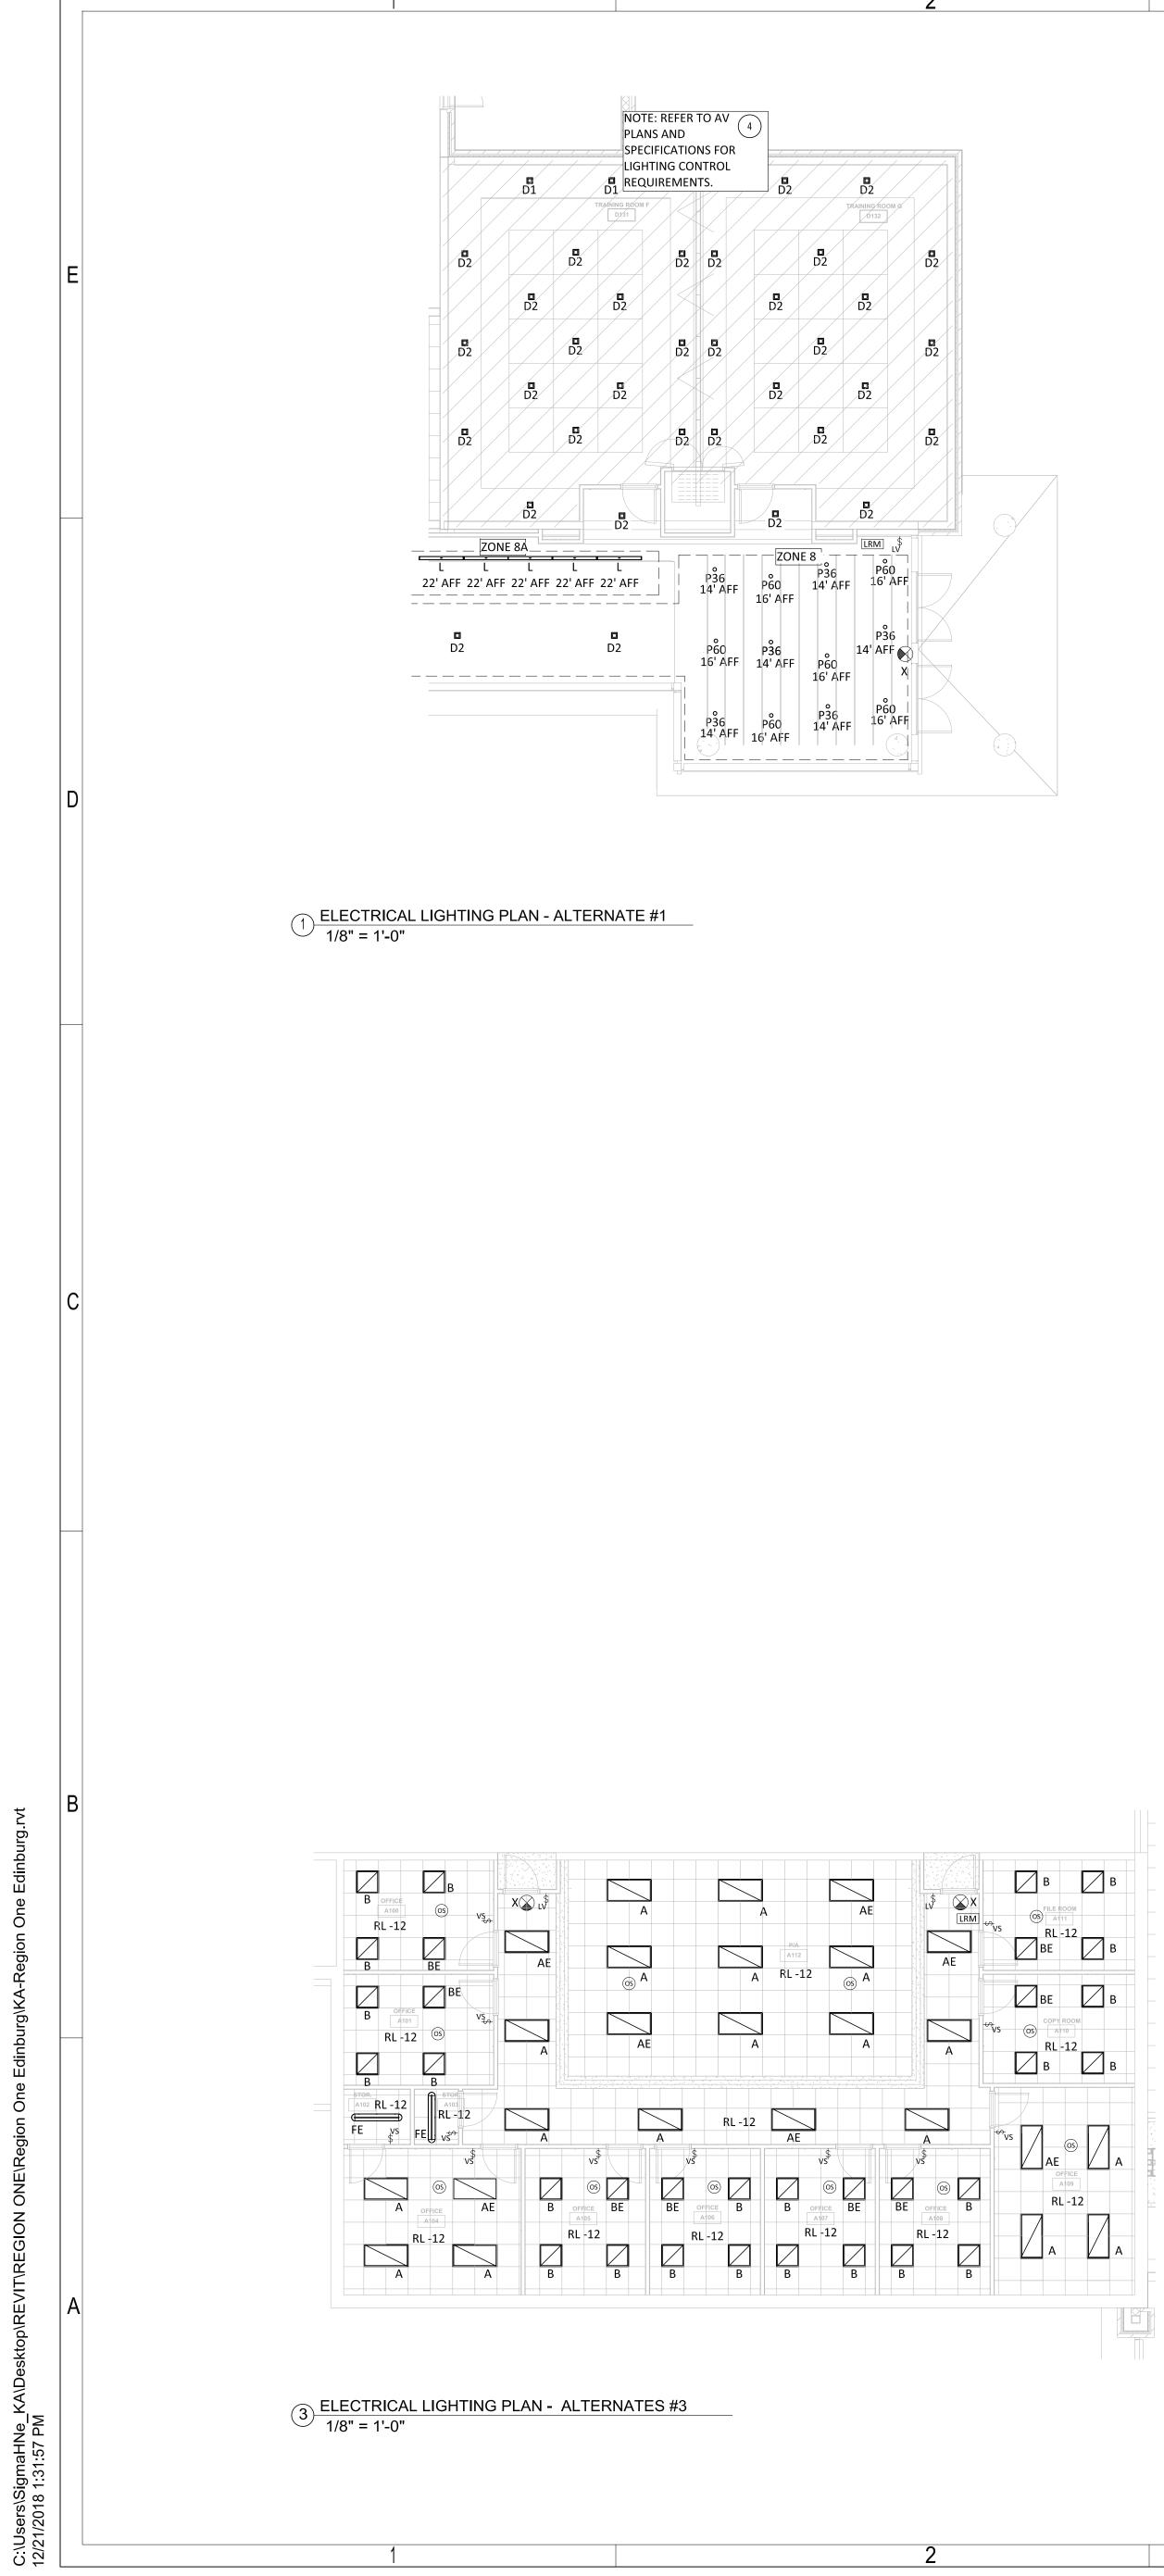



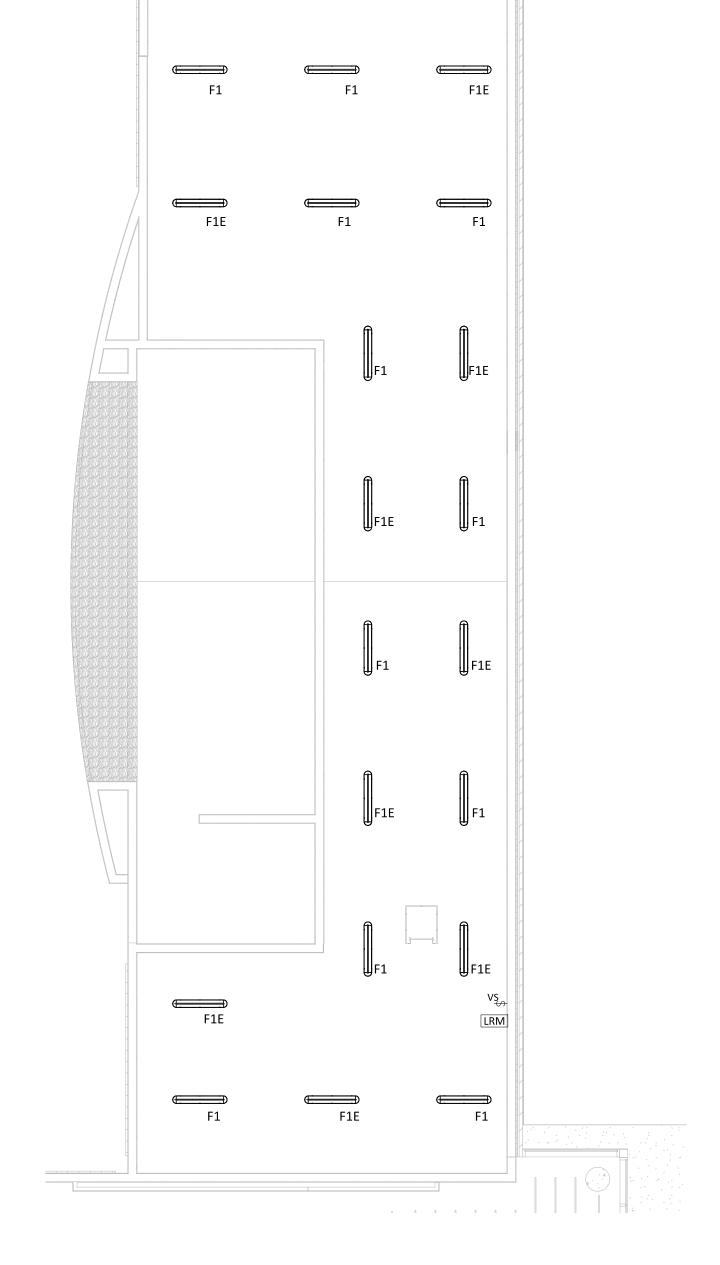

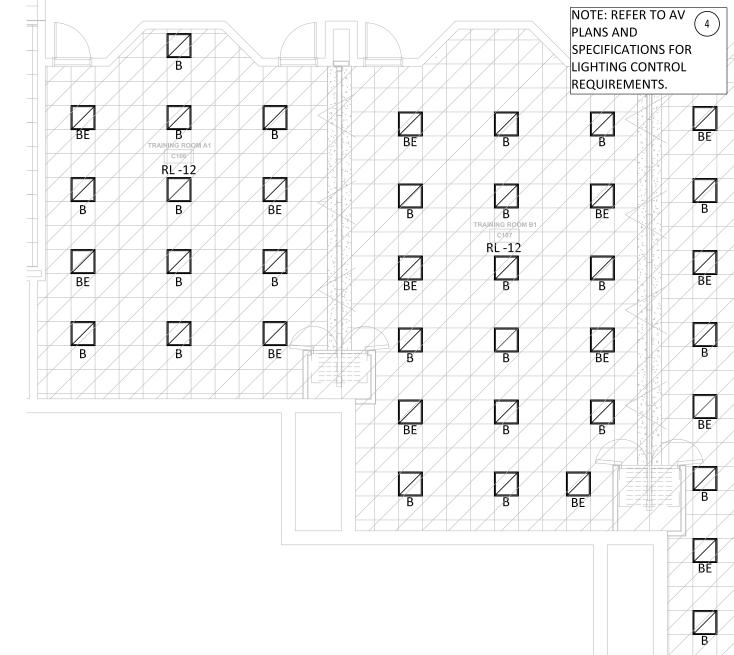

2 ELECTRICAL LIGHITNG PLAN - ALTERNATE #2 1/8" = 1'-0"

Z BE \mathbb{Z} \square RE B Z Ŋ BE Ø Z BE B

Ø

Ø

Ø

Ø


GENERAL NOTES:

A. REFER TO SHEET MEP-1.0 FOR GENERAL NOTES.


1. KEYNOTES: (#)

- 2. CONTRACTOR SHALL INCLUDE IN HIS BID CONFIGURATION OF TOUCH SCREEN SWITCH (TS) TO MATCH ROOM NAMES AND NUMBER.
- 3. FURNISH AND INSTALL CATEGORY 6 PRE-TERMINATED CABLING FOR DEVICE INTERFACES. CABLING SHALL BE BY
- TELECOMMUNICATION CONTRACTOR. USE 1-INCH J-HOOK FOR SUPPORT. 4. REFER TO AV PLANS FOR LIGHTING CONTROL CONFIGURATION AND REQUIREMETNTS. ELECTRICAL CONTRACTOR SHALL INCLUDE IN HIS BID BRANCH CIRCUITS FROM THE ELECTRICAL PANEL, THROUGH THE LIGHTING
- RELAY PANEL AND OUT TO THE LIGHT FIXTURES AND CONTROLS FOR TRAINING ROOMS F,G,A1,B1,C1, AND D1 AS NOTED WITH DIAGONAL HATCH. _____
- REVISION:
- 1. 19.03.18 ADDENDUM #4. REVISION TO LIGHTING CONTROL LEGEND AND ADDITION OF KEYNOTE 4.


	LIGHTING CONTROLS LEGEND
OS	TOUCHE LIGHTING CONTROLS SMAOS DUAL TECHNOLOGY LOW VOLTAGE CEILING SENSOR
vs \$	TOUCHE LIGHTING CONTROLS SW-O-D DUAL TECHNOLOGY WALL SENSOR (VACANCY MODE)
\$ \$	TOUCHE LIGHTING CONTROLS SW-O-D DUAL TECHNOLOGY WALL SENSOR (OCCUPANCY MODI
ods \$	TOUCHE LIGHTING CONTROLS OSW-O-P-DIM 0-10V DIMMING WALL SENSOR
L V \$	TOUCHE LIGHTING CONTROLS SW-SF LOW VOLTAGE MOMENTARY SWITCH
s \$	TOUCHE LIGHTING CONTROLS SW-TS LOW VOLTAGE TOUCHSCREEN SWITCH
CTS \$	TOUCHE LIGHTING CONTROLS WS-TS-C-XX LOW VOLTAGE COLOR TOUCHSCREEN SWITCH
TS7	TOUCHE LIGHTING CONTROLS TSUI 7-IN. COLOR TOUCHSCREEN
LRD	TOUCHE LIGHTING CONTROLS LRM-2P-120-347-0/10 DUAL-RELAY MODULE WITH 0-10V DIMM
LRM	TOUCHE LIGHTING CONTROLS LRM-2P-120-347 DUAL-RELAY MODULE
DP	TOUCHE LIGHTING CONTROLS DI-PS PARTITION SENSOR
M-I	TOUCHE LIGHTING CONTROLS MASTER INTERFACE
AV	TOUCHE AUDIO AND VIDEO INTERFACE CI-RS232
LRP	TOUCHE LIGHTING CONTROL RELAY PANEL RD-32-8
LRL	TOUCHE LIGHTING CONTROL RELAY LRM-2P-120/347 FOR PLUG LOAD CONTROLLER

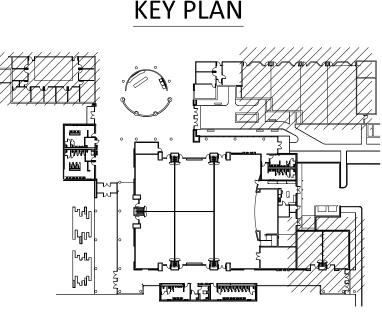

SIGMA EIN ENGINEERS, PLLC TBPE Firm No. F-14767 701 S. 15th McAllen, T**Strasse**78501

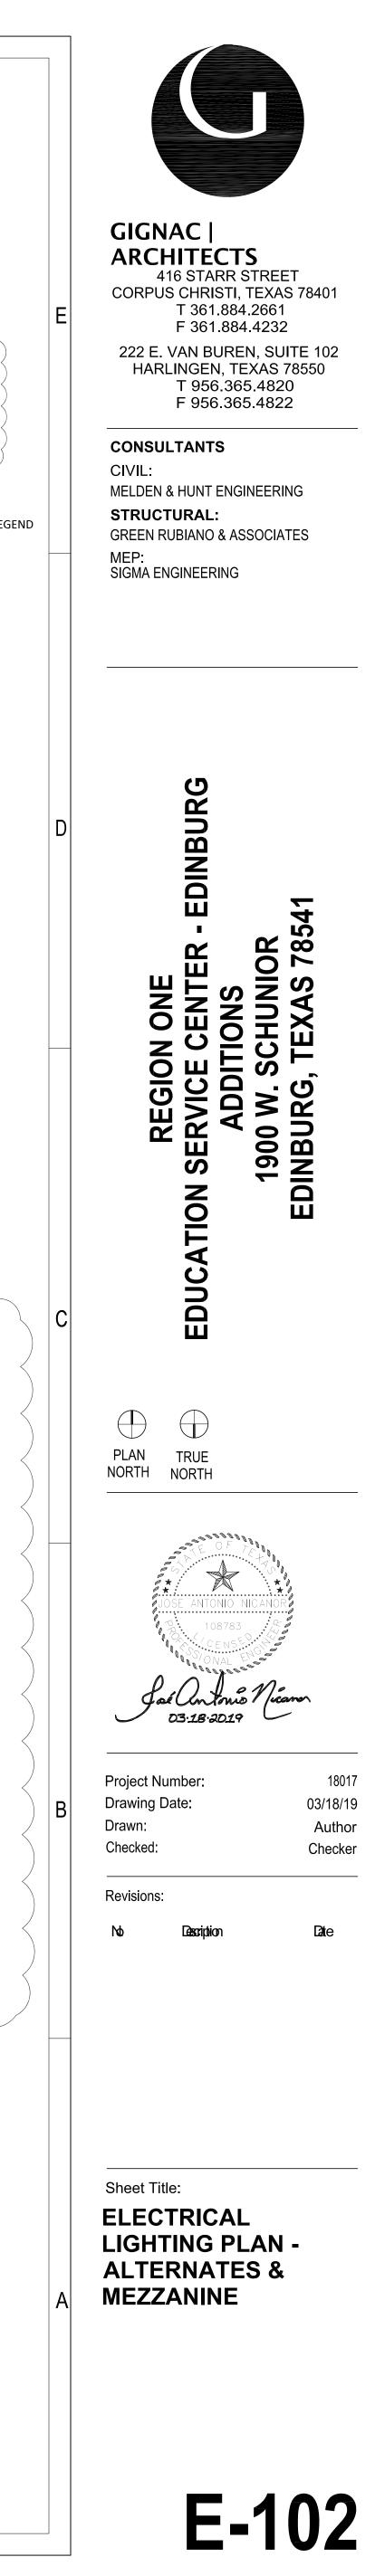




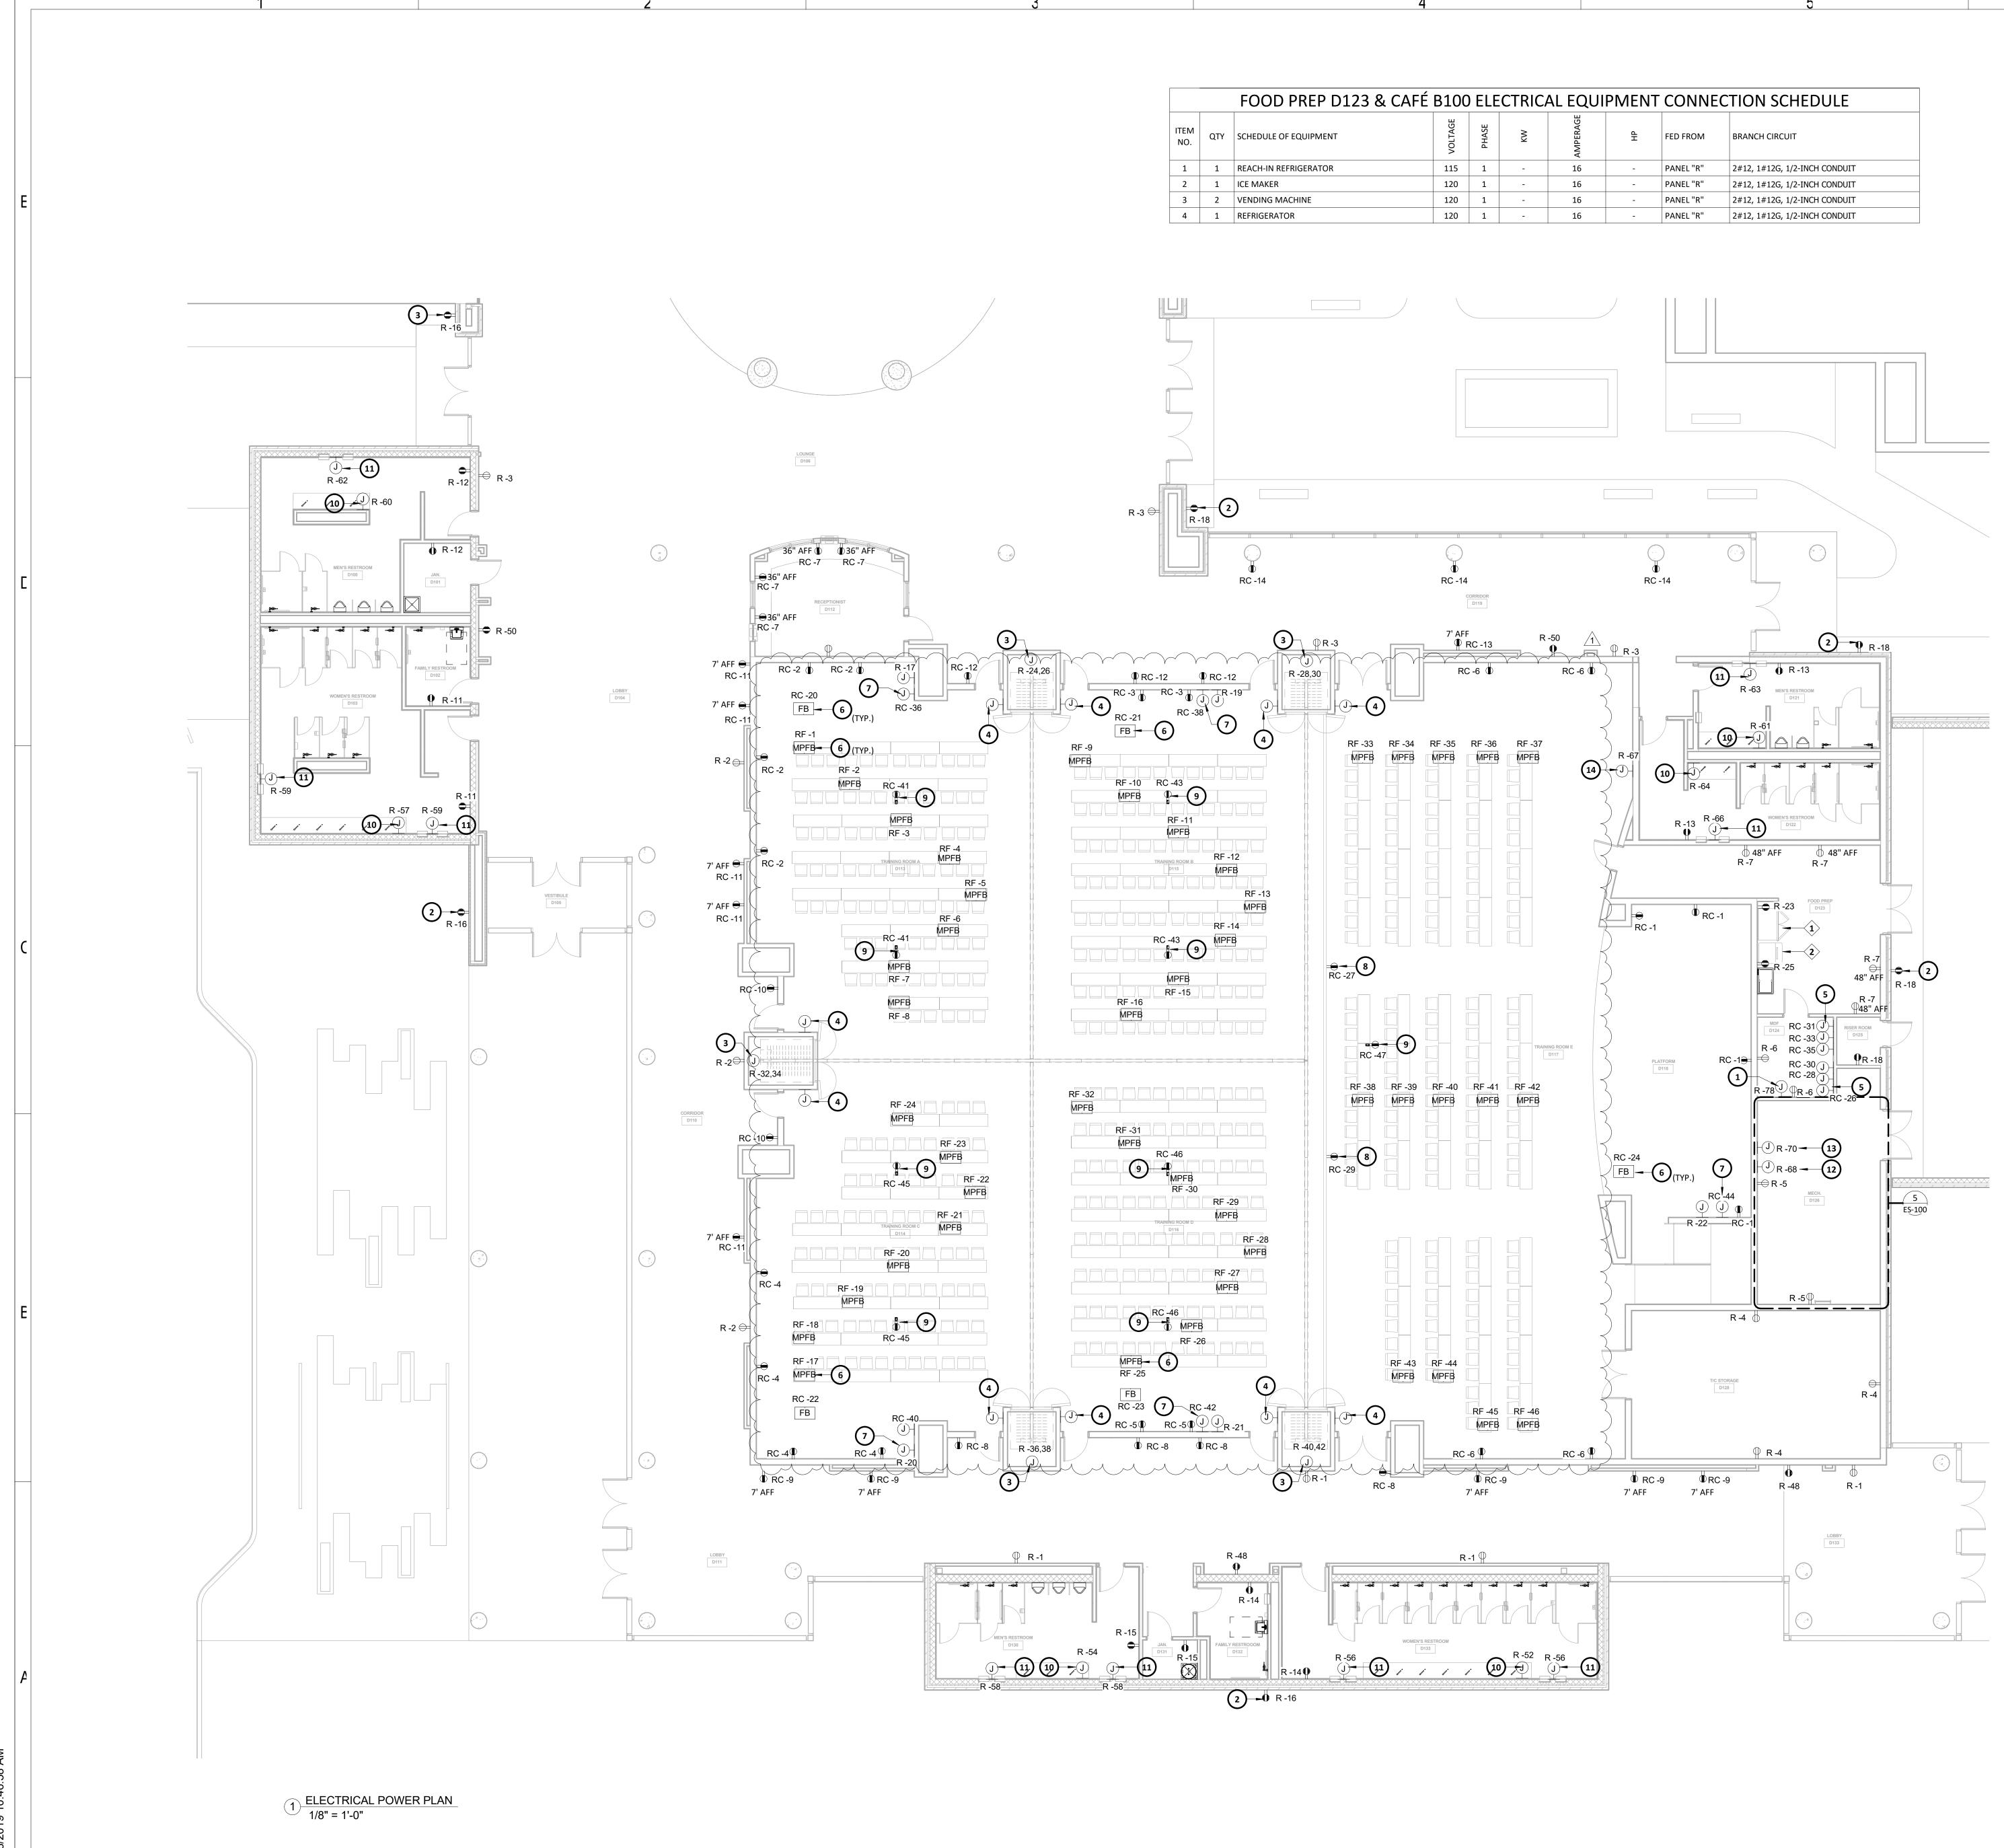



- CONTROL PANEL.
- CONSISTING OF 2#20, 1#10EGC, 1/2"C AND SAFETY AND MOTION SENSOR.
- CONTROL SWITCH. MOUNT AT 48" AFF.
- EQUIPMENT RACK.
- PROJECTOR SCREEN AT MANUFACTURER SPECIFIED
- REFER TO AV PLANS FOR MOUNTING HEIGHT REQUIREMENTS.

- DISPENSER.
- POWER CONTROL DISTRIBUTION PANEL.
- POWER CONTROL RELAY PANEL.
- ALARM PANEL.

DUE TO ADDITION OF FLOOR BOXES AT TRAINING ROOMS.

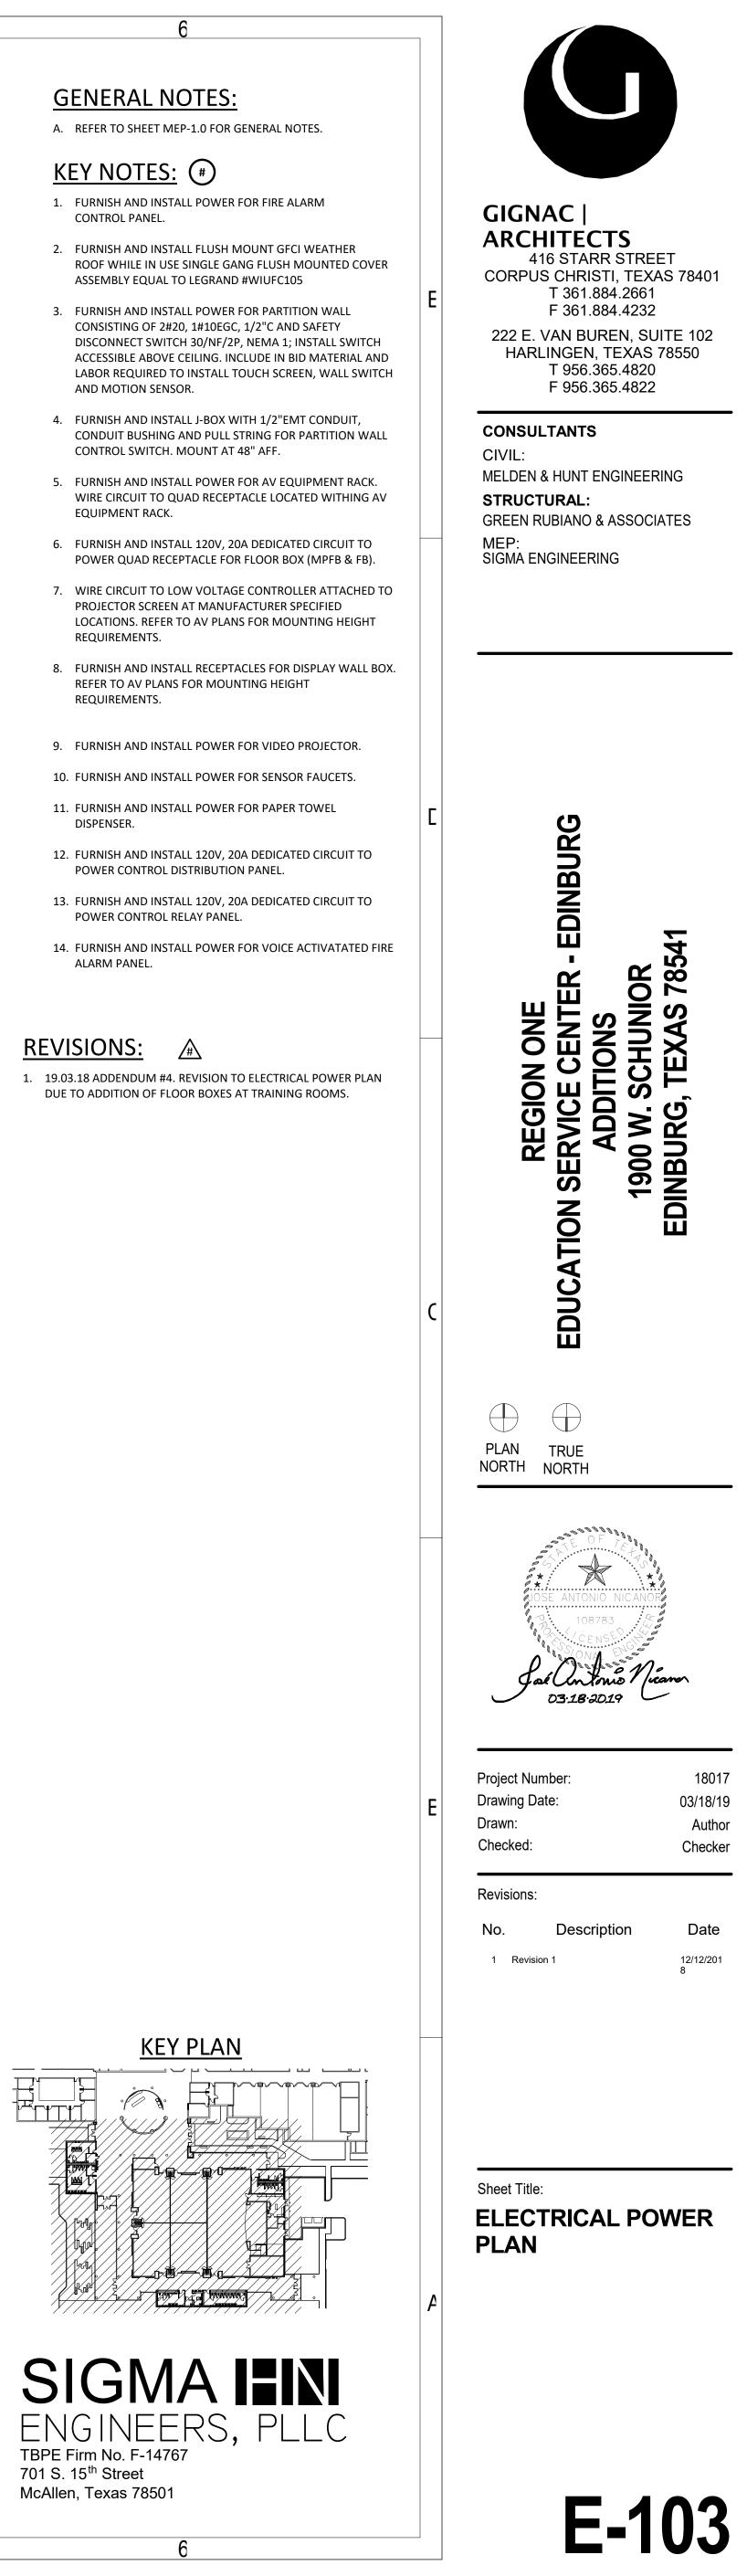

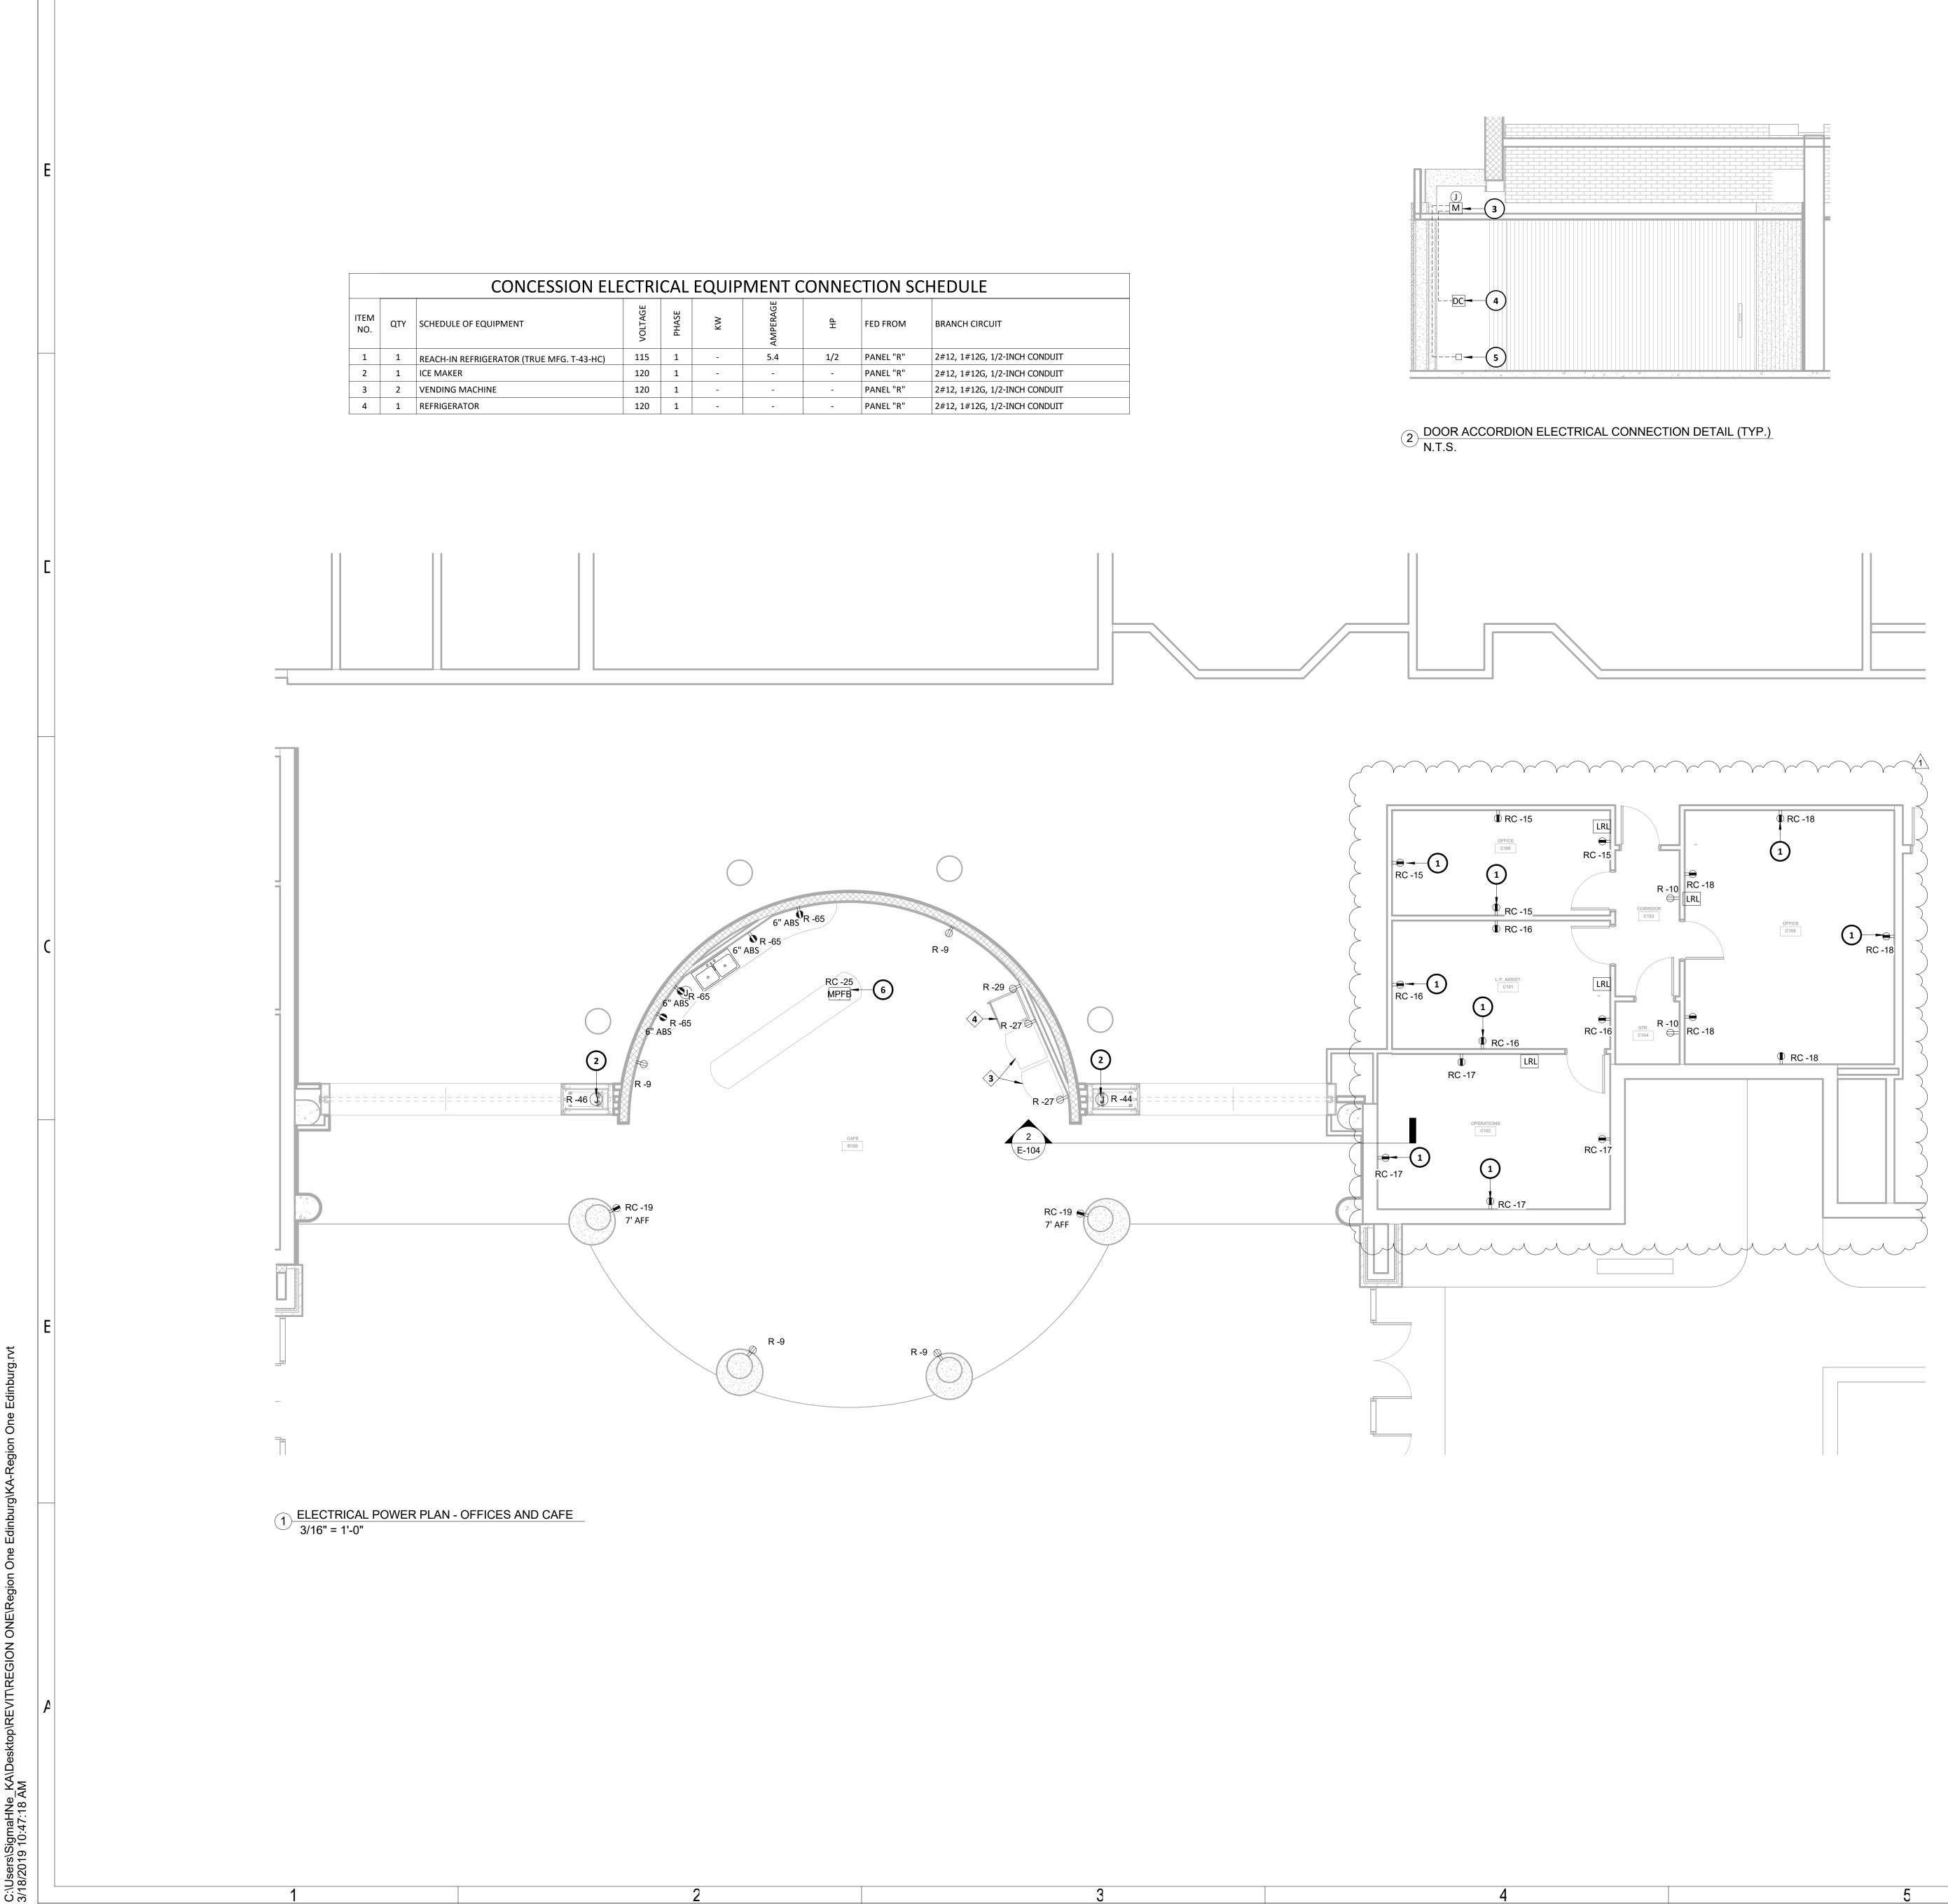

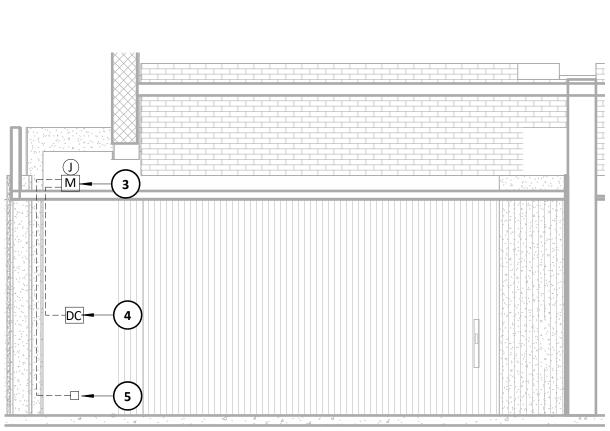



			Ú		
	- , <i>4</i>	1.7	1.4	1 . ¹ .	

1ENT C	ONNEC	TION SCH	IEDULE
AMPERAGE	ЧН	FED FROM	BRANCH CIRCUIT
5.4	1/2	PANEL "R"	2#12, 1#12G, 1/2-INCH CONDUIT
-	-	PANEL "R"	2#12, 1#12G, 1/2-INCH CONDUIT
-	-	PANEL "R"	2#12, 1#12G, 1/2-INCH CONDUIT
-	-	PANEL "R"	2#12, 1#12G, 1/2-INCH CONDUIT


"LRL" CONSISTING ON TOUCHE MODEL LRM-2P-120/347.



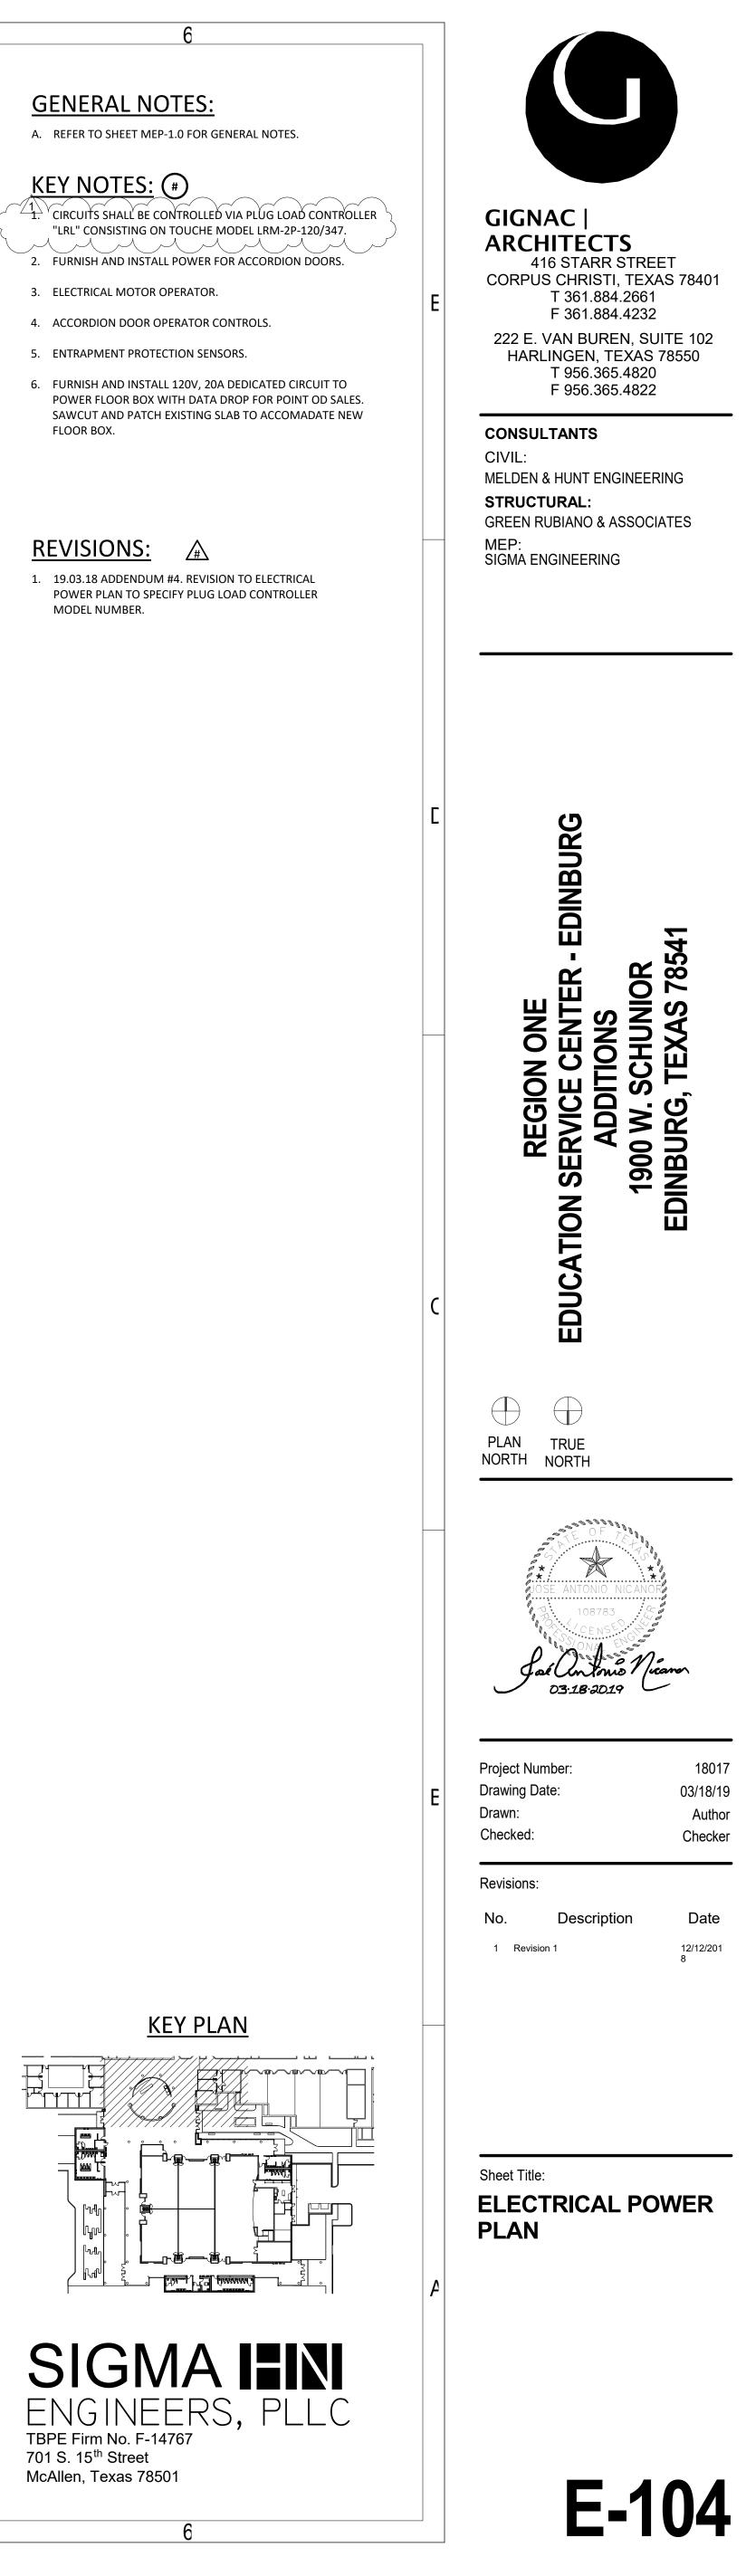


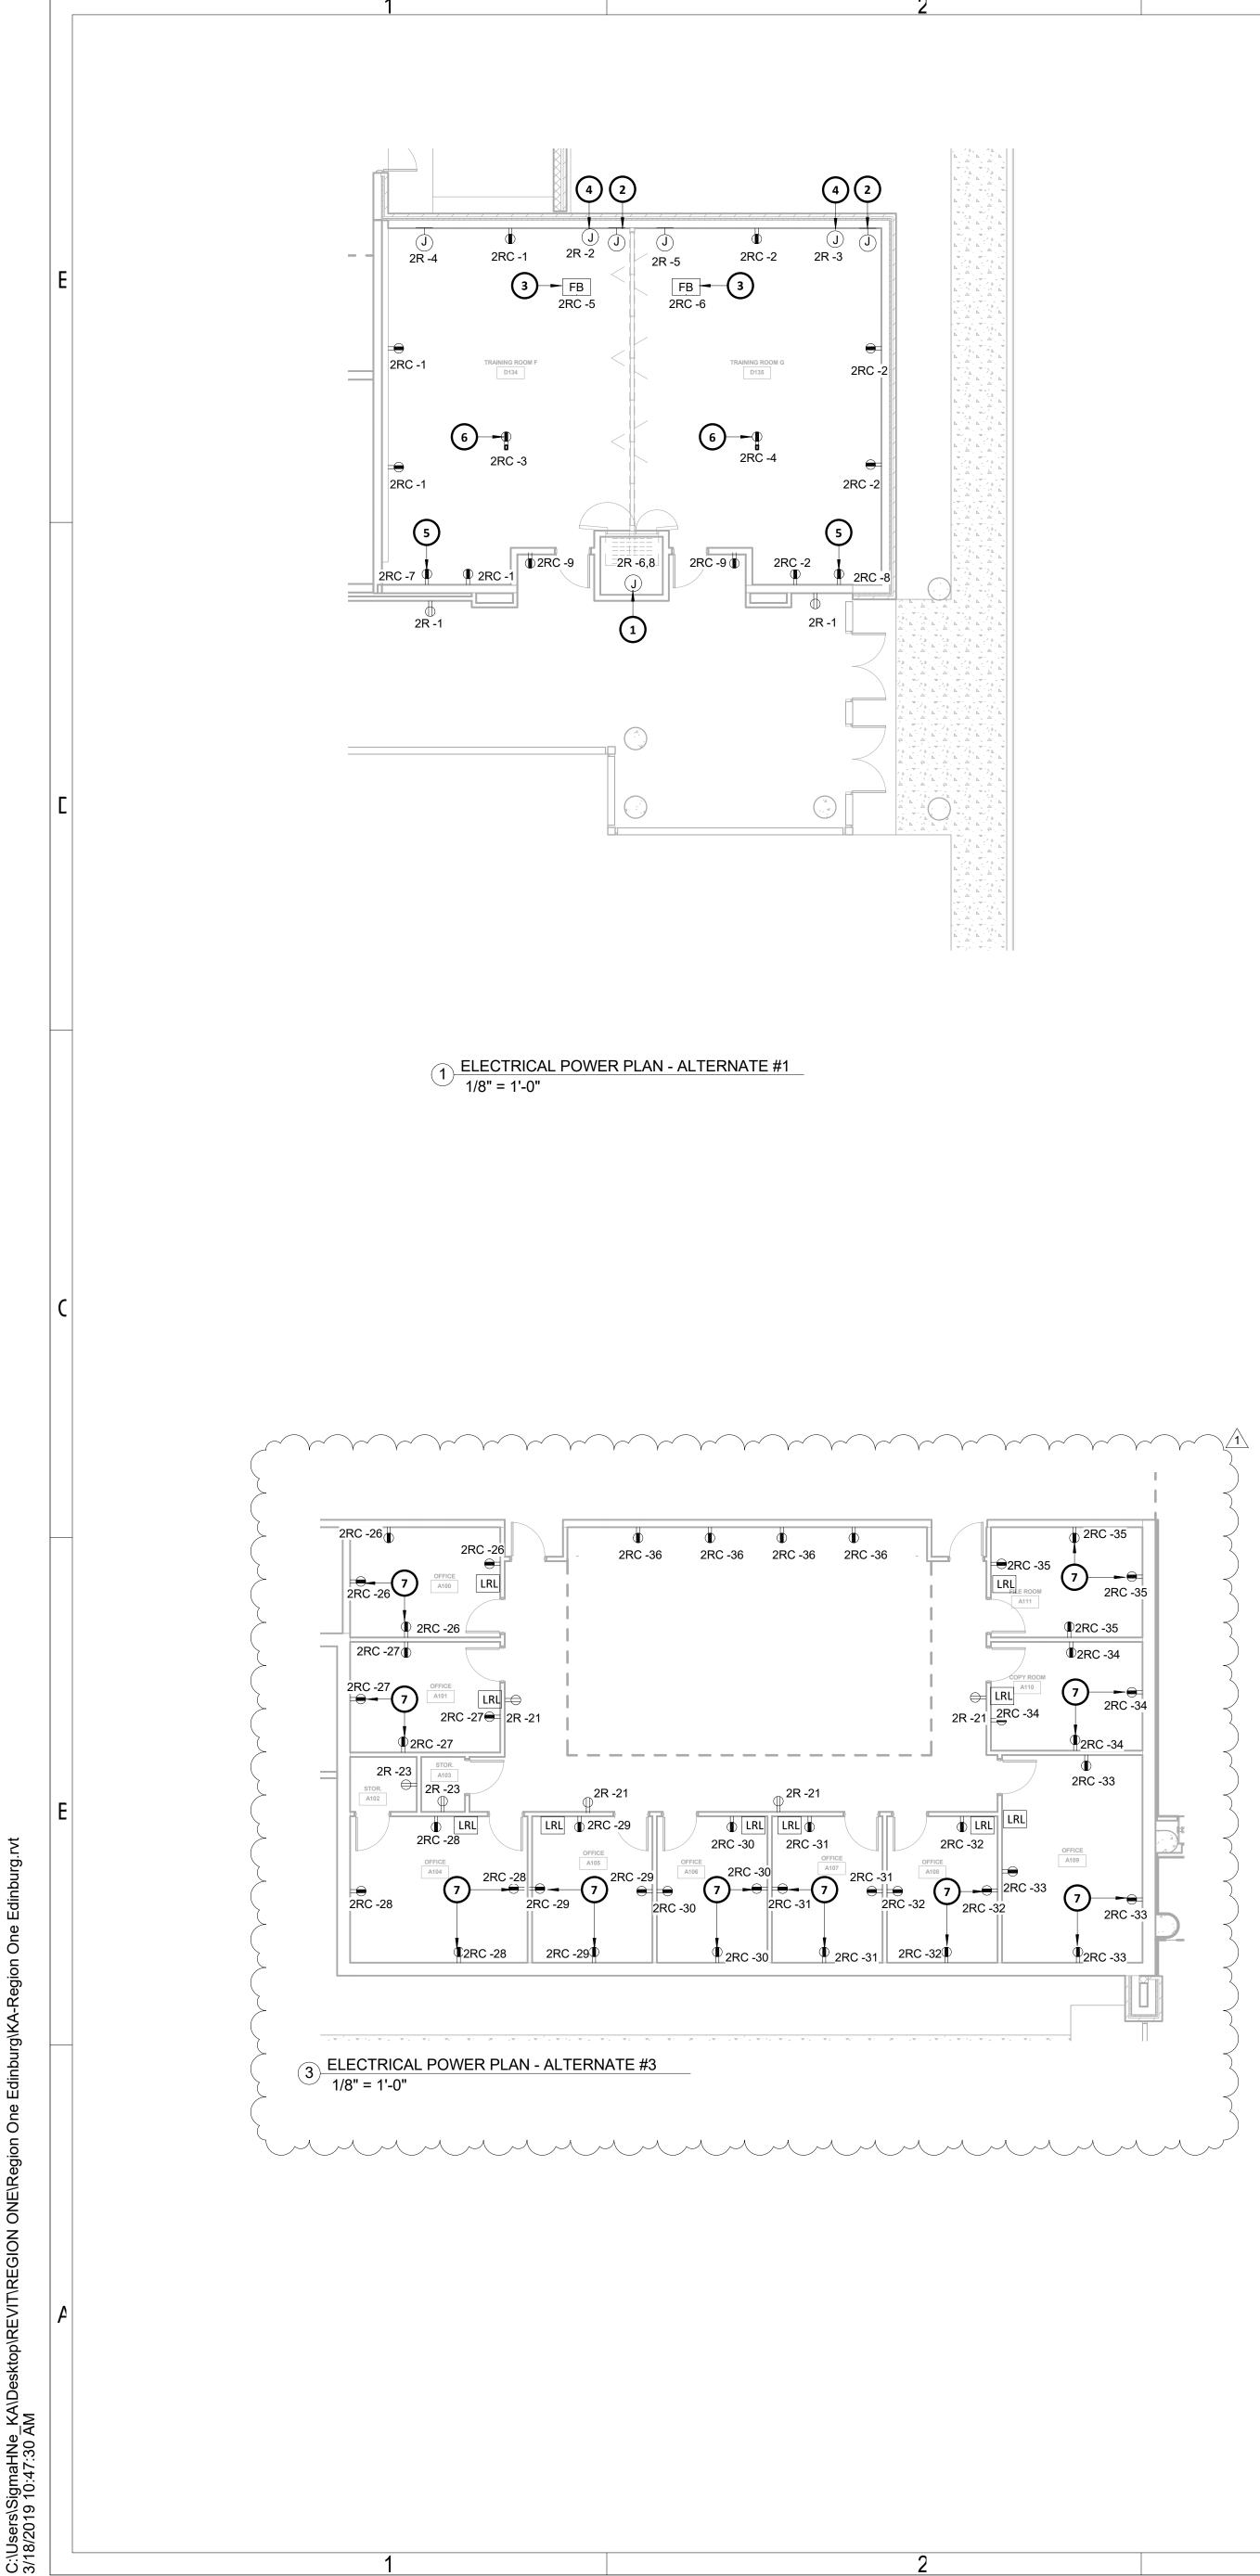



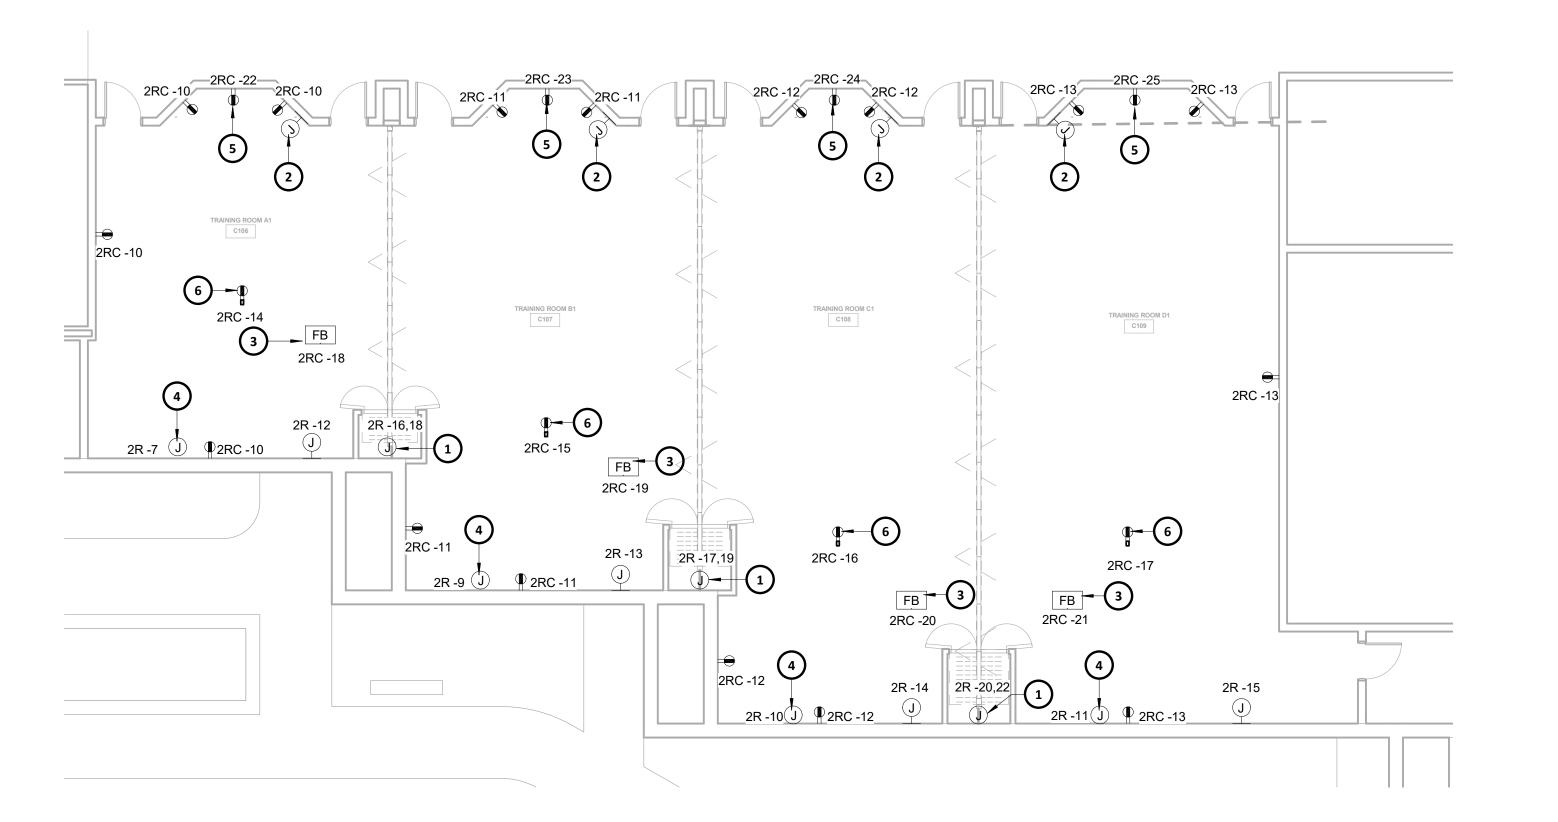

2 ELECTRICAL POWER PLAN - ALTERNATE #2 1/8" = 1'-0"

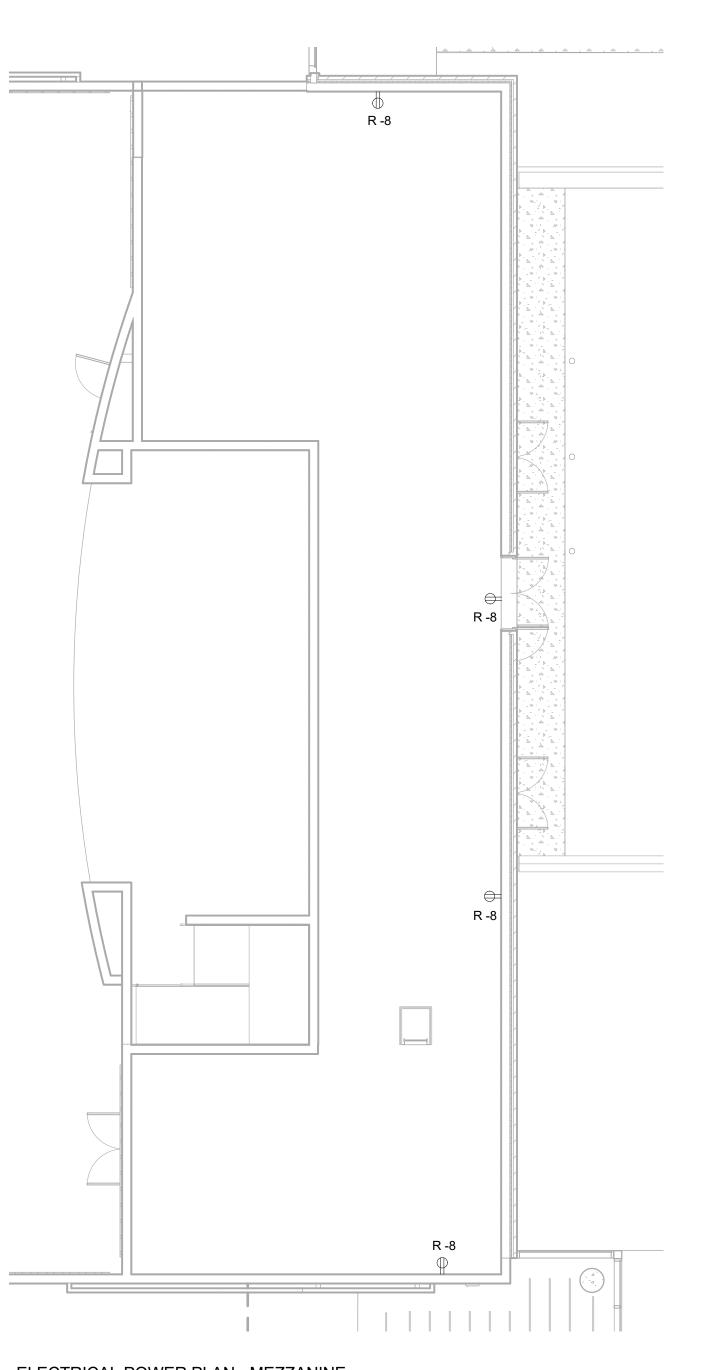

4 ELECTRICAL POWER PLAN - MEZZANINE 1/8" = 1'-0"

- **GENERAL NOTES:**
- A. REFER TO SHEET MEP-1.0 FOR GENERAL NOTES.


KEY NOTES: (#)

- 1. FURNISH AND INSTALL POWER FOR PARTITION WALL CONSISTING OF 2#20, 1#10EGC, 1/2"C AND SAFETY DISCONNECT SWITCH 30/NF/2P, NEMA 1; INSTALL SWITCH ACCESSIBLE ABOVE CEILING. INCLUDE IN BID MATERIAL AND LABOR REQUIRED TO INSTALL TOUCH SCREEN, WALL SWITCH AND MOTION SENSOR.
- 2. FURNISH AND INSTALL J-BOX WITH 1/2"EMT CONDUIT, CONDUIT BUSHING AND PULL STRING FOR PARTITION WALL CONTROL SWITCH. MOUNT AT 48" AFF.
- 3. FURNISH AND INSTALL 120V, 20A DEDICATED CIRCUIT TO POWER QUAD RECEPTACLE FOR FLOOR BOX (FB & MPFB).
- PROJECTOR SCREEN AT MANUFACTURER SPECIFIED LOCATIONS. REFER TO AV PLANS FOR MOUNTING HEIGHT REQUIREMENTS.
- 5. FURNISH AND INSTALL RECEPTACLES FOR DISPLAY WALL BOX. REFER TO AV PLANS FOR MOUNTING HEIGHT REQUIREMENTS.
- 6. FURNISH AND INSTALL POWER FOR VIDEO PROJECTOR. CIRCUITS SHALL BE CONTROLLED VIA PLUG LOAD CONTROLLER "LRL" CONSISTING ON TOUCHE MODEL LRM-2P-120/347.


MODEL NUMBER.

REVISIONS: 1. 19.03.18 ADDENDUM #4. REVISION TO ELECTRICAL POWER PLAN TO SPECIFY PLUG LOAD CONTROLLER

<u>KEY PLAN</u>

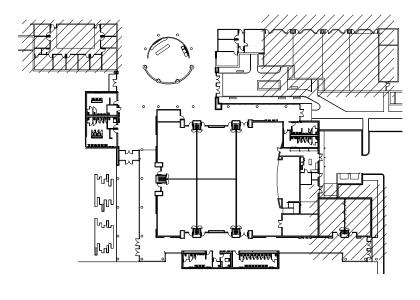

SIGMA **HIN** ENGINEERS, PLLC TBPE Firm No. F-14767 701 S. 15th Street McAllen, Texas 78501

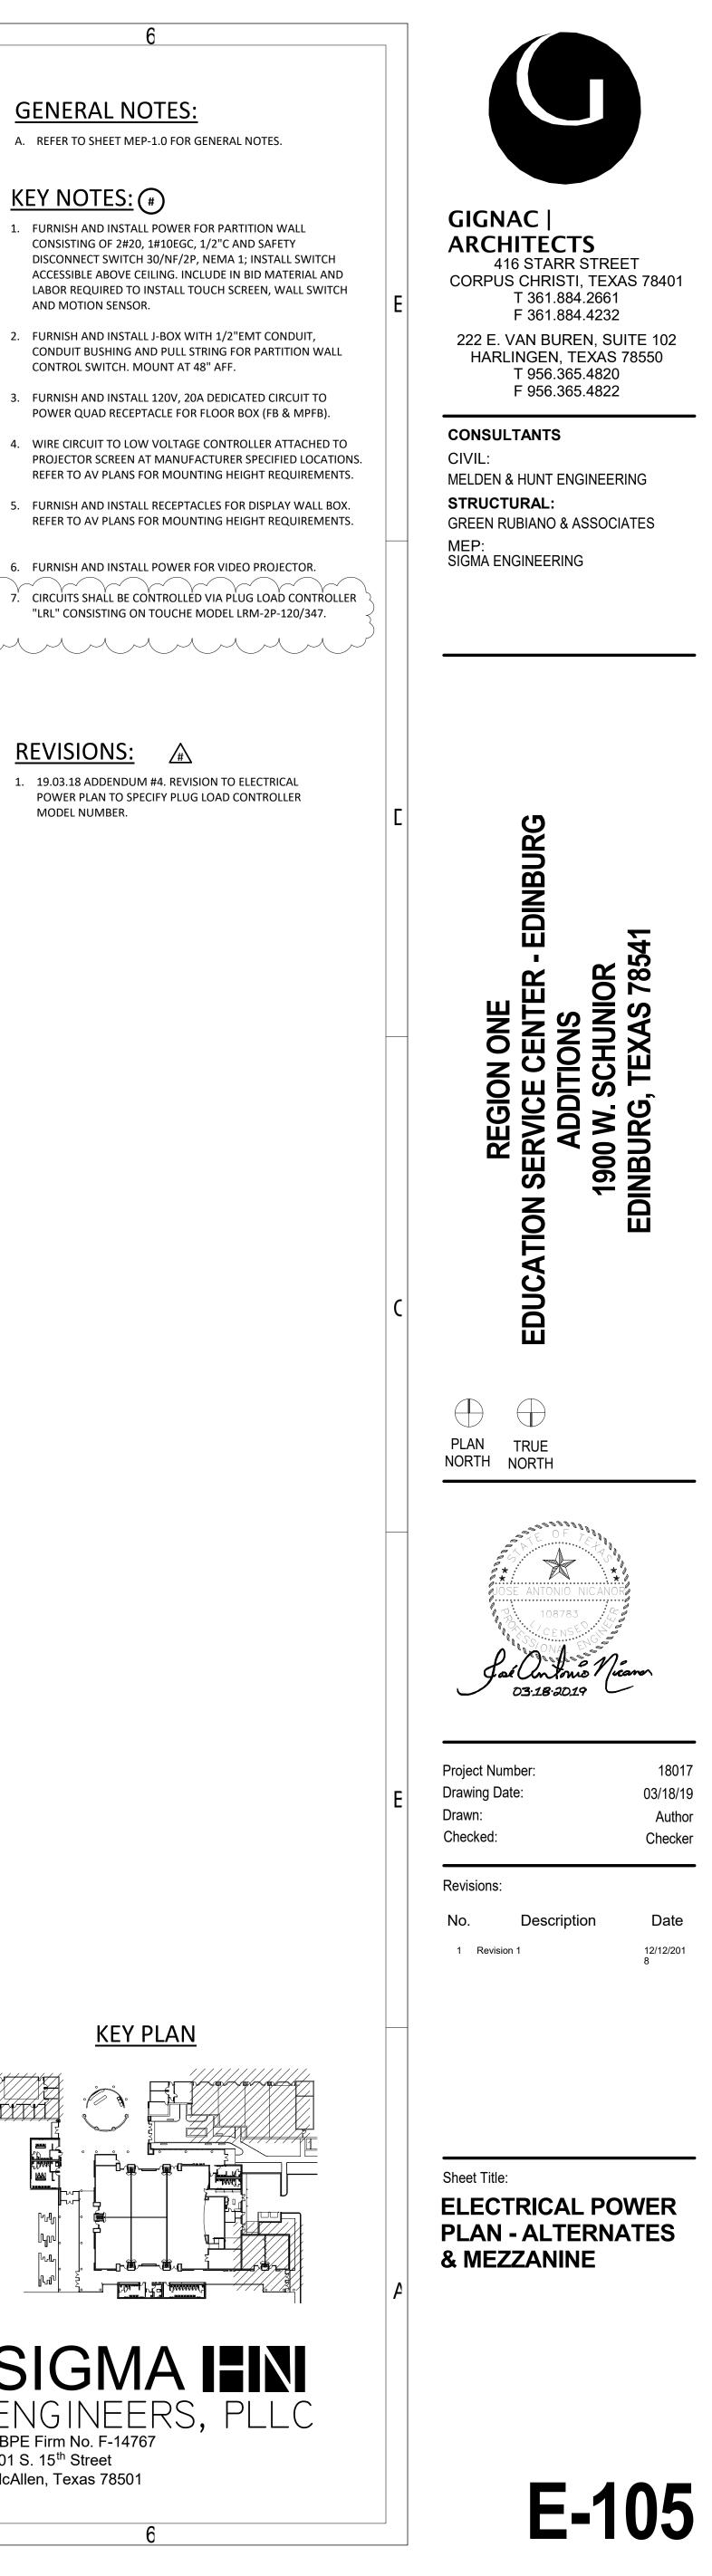

Branch Panel: MDP Location: ELEC. D127 Supply From: Mounting: SURFACE Enclosure: NEMA 1 Notes:	Volts: 480/277 Wye Phases: 3 Wires: 4	A.I.C. Rating: 40,000 Mains Type: COPPER Mains Rating: 800 A MCB Rating: 800 A	
1 XFMR "RF" 300 A 3 5 7 XFMR "1RT" 300 A 9	Poles A B C Poles 3 1152 0 VA 1 1 1 1152 0 VA 1 1 1 1152 0 VA 1 1 1 1152 0 VA 1 1 1 <th>20 A SPARE 20 A SPARE 300 A XFMR "1RC" </th> <th>CK 2 4 6 8 10</th>	20 A SPARE 20 A SPARE 300 A XFMR "1RC"	CK 2 4 6 8 10
15 17 19 VFD-5 20 A 21 23 25 VFD-2 20 A 27 29 31 VFD-4 30 A 33 35	Image with the sector of the	60 A SURGE PROTECTION DEVICE 20 A UH-1 20 A UH-1 20 A VFD-1 20 A VFD-1 30 A VFD-3 175 A CH-1	12 14 16 18 20 22 24 24 26 28 30 32 32 34 34 36 38
39	2683 2683 2683 0 VA 1 ad: 194110 VA 194528 VA 194448 VA	 20 A SPARE	40
HVAC2792Other1883Receptacle603Power467	Cted Load Demand Factor Estimated Demand 217 VA 100.00% 279217 VA 336 VA 100.00% 188336 VA 360 VA 58.28% 35180 VA 774 VA 100.00% 46774 VA 34 VA 100.00% 8534 VA	Panel Totals Total Conn. Load: 583085 VA Total Est. Demand: 557906 VA Total Conn.: 701 A Total Est. Demand: 671 A	
VOLTAGE: 480Y/277 VOLT 3 PHASE 4 WIRE 400 A MAIN CIRCUIT BREAKER BUSSING: MAIN - 400 A ISC = 22,000 A RMS SYM ENCLOSURE: NEMA 1 NEMA CKT BKR VA:L VA:R VA:R LIGHTING INTER 3 20/1 2582 LIGHTING INTER	RIOR B LTG. INTERIOR - ZONE 1	3507 20/1	ACE 0% ND CE KT 2 4
5 20/1 644 LTG. INTERIOR 7 20/1 756 LTG. INTERIOR 9 20/1 850 LTG. STAGE 11 20/1 0 TRACK LIGHTIN 13 20/1 472 BUILDING PERIF 15 20/1 390 PEDESTRIAN LIC 17 30/3 0 2498 VAV-1 19 - 0 2498 " 21 - 0 2498 " 23 40/3 0 4100 VAV-3	- ZONE 4 A LTG. INTERIOR - ZONE 5 B LTG. MEZZANINE IG C LIGHTING INTERIOR - ALTER METER WALL PACKS A FACADE LIGHTING	Image: Matrix Signal Topological Topological <thtopological< t<="" td=""><td>6 8 10 12 14 16 18 20 22 24</td></thtopological<>	6 8 10 12 14 16 18 20 22 24
25 - 0 4100 " 27 - 0 4100 " 29 40/3 0 3167 VAV-5 31 - 0 3167 " 33 - 0 3167 " 35 40/3 0 1277 VAV-7 37 - 0 1277 " 39 - 0 1277 " 41 20/1 0 TRACK LIGHTIN	A VAV-6 B " C " A VAV-4 B " C " A VAV-4 B " C " A VAV-4 B " C " B B C " B B B B	3333 0 40/3 2 3333 0 - 2 3333 0 - 3 3333 0 - 3 1267 0 30/3 3 1267 0 - 3 1267 0 - 3 3333 0 30/3 3 3333 0 30/3 3 3333 0 30/3 3	226 228 330 332 334 336 338 400 422
43 20/1 0 SPARE 45 20/1 0 SPARE 47 40/3 0 500 VAV-9 ALTERNA 49 - 0 500 " 51 - 0 500 "	A VAV-10 ALTERNATE #1 B " ATE #1 C " ATE #1 A EDH-2	611 0 - 4 611 0 - 4 3667 0 20/3 5 3667 0 - 5 3667 0 - 5 3667 0 - 5 3667 0 - 5	14 16 18 50 52 54
53 20/3 0 3667 EDH-1 55 - 0 3667 " 57 - 0 3667 " 59 80/3 0 1766 EDH-3 61 - 0 1766 " 63 - 0 1766 " 65 40/3 0 500 VAV-5-2	B " C " A EDH-4 B " C " A VAV-5-1 B " C " A VAV-5-1 B " C " A VAV-5-3	1766 0 - 6 555 0 40/3 6 555 0 - 6 555 0 - 6 555 0 - 6	58 50 52 54 56
53 20/3 0 3667 EDH-1 55 - 0 3667 " 57 - 0 3667 " 59 80/3 0 1766 EDH-3 61 - 0 1766 " 63 - 0 1766 "	C " A EDH-4 B " C " A VAV-5-1 B "	1766 0 - 5 1766 0 - 6 555 0 40/3 6 555 0 - 6 555 0 - 6 555 0 - 6 555 0 - 6 555 0 30/3 6 555 0 - 7 555 0 - 7 555 0 - 7 555 0 - 7 555 0 20/1 7 0 20/1 7 7 0 20/1 7 7 0 0 20/1 7 0 0 60/3 8 8 0 0 - 8 0 - 8	58 50 52 54

C:\Users\SigmaHI 3/18/2019 10:47:3

180/277 3 1	Wye				A.I.C. Rating: 40,000 Mains Type: COPPER Mains Rating: 800 A MCB Rating: 800 A	
	(2	Poles	Trip	Circuit Description	СКТ
0.)//			1	20 A	SPARE	2
0 VA	1000	1250	1	20 A	SPARE	4
	1008	1350	3	300 A	XFMR "1RC"	6 8
350						10
350	2821	0 VA	3	 60 A	SURGE PROTECTION DEVICE	10
	2021	UVA				12
0 VA						14
	6995	369 VA	3	20 A	UH-1	18
	0000	505 VA				20
69 VA						20
00 1/1	942 VA	3048	3	20 A	VFD-1	24
	0.2.07					26
3048						28
	3048	5820	3	30 A	VFD-3	30
						32
5820						34
	5820	2683	3	175 A	CH-1	36
						38
2683						40
	2683	0 VA	1	20 A	SPARE	42
VA		48 VA		1	1	I
A	70	2 A				

Branch Panel: R

	Branch Panel: R Location: ELEC. D127 Supply From: XFMR 1RT Mounting: SURFACE Enclosure: NEMA 1					Volts: Phases: Wires:		3 Wye				A.I.C. Rating: 10,000 Mains Type: COPPER Mains Rating: 250 A MCB Rating: 250 A	
Notes:		1	1	1		1		1		1	1	1	
скт	Circuit Description	Trip	Poles		A		в		С	Poles	Trip	Circuit Description	СКТ
1	GEN. RCPT. CORRIDOR D129	20 A	1		720 VA					1	20 A	GEN. RCPT. CORR.D110, LOBBY D104	2
3	GEN. RCPT. LOUNGE D106, CORRIDOR D119	20 A	1				540 VA			1	20 A	GEN. RCPT. T/C STORAGE	4
5	GEN. RCPT. MECH./ELEC. ROOM	20 A	1						360 VA	1	20 A	GEN. RCPT. MDF ROOM D124	6
7	GEN. RCPT. FOOD PREP D123	20 A	1	720 VA	720 VA					1	20 A	GEN. RCPT. MEZZANINE	8
9	GEN. RCPT. CAFE B100	20 A	1				360 VA			1	20 A	GEN. RCPT. CORRIDOR C103 & STG C104	10
11	GFCI RCPT. WOMEN R.R. D103 & FAM. R.R	20 A	1					-	360 VA	1	20 A	GFCI RCPT. MEN R.R. D100 & JAN. 101	12
13	GFCI RCPT. WOMEN & MEN R.R. D121 & D122	20 A	1	360 VA	360 VA					1	20 A	GFCI RCPT. WOMEN R.R. D133 & FAM. R.R.	
15	GFCI RCPT. MEN R.R D130 & JAN. D131	20 A	1				540 VA			1	20 A	GFCI RCPT. BUILDING PERIMETER	16
17	AV BRIDGE TRAINING RM A D113	20 A	1						720 VA	1	20 A	GFCI RCPT. BUILDING PERIMETER	18
19	AV BRIDGE TRAINING RM B D115	20 A	1	180 VA	180 VA					1	20 A	AV BRIDGE TRAINING RM C D114	20
21	AV BRIDGE TRAINING RM D D116	20 A	1				180 VA			1	20 A	AV BRIDGE STAGE D118	22
23	ITEM 1 - REACH-IN REFRIFERATOR	20 A	1					1920	1500	2	20 A	PARTITION WALL MOTOR TRAINING ROOM	24
25	ITEM 2 - ICE MAKER	20 A	1	1920	1500			1020	1000				26
27	ITEM 2 VENDING MACHINE	20 A	1	1020	1000	3840	1500			2	20 A	PARTITION WALL MOTOR TRAINING ROOM	28
29	ITEM 4 - REFRIGERATOR	20 A	1			0040	1000	1920	1500				30
31	SERVICE YARD GATE MOTOR	20 A	2	1664	1500			1920	1300	2	20 A	PARTITION WALL MOTOR TRAINING ROOM	30
33		20 A		1004	1500	1664	1500				20 A	PARTITION WALL MOTOR TRAINING ROOM	34
35	 EF-1 & 2					1004	1500	157 VA	1500	2		 PARTITION WALL MOTOR TRAINING ROOM	36
35	EF-1 & 2 EF-3 & 4	20 A 20 A	1	457\/A	1500			157 VA	1500	-		PARTITION WALL MOTOR TRAINING ROOM	38
39	EF-5 & 6	20 A 20 A	1	157 VA	1500	157\/A	1500			2		 PARTITION WALL MOTOR TRAINING ROOM	40
41	WH-1D	20 A 30 A	2			157 VA	1500	2250	1500			PARTITION WALL MOTOR TRAINING ROOM	40
41			2	2250	500 VA			2250	1500			ACCORDION DOOR MOTOR CAFE B100	42
43	 WH-2D	 30 A	2	2250	500 VA		500 VA			1	-	ACCORDION DOOR MOTOR CAFE B100	44
45						2250	500 VA		260.1/4		20 A 20 A	EWC - CORRIDOR D129	40
47	 WH-3D	 30 A	2	2250	360 VA			2250	360 VA	1	20 A 20 A	EWC - LOBBY D104 & CORRIDOR D119	50
49 51				2250	300 VA	2250	180 VA			1	20 A 20 A	WOMEN R.R. D133 SENSOR FAUCET	50
						2250	160 VA		100.1/4				52
53	FCU-1 & FCCU-1	20 A	2	1110	2001/4			1140	180 VA			MENR.R. D130 SENSOR FAUCET	
55				1140	360 VA		0001/4			1	20 A	WOMEN R.R. D133 PAPER TOWEL DISPENS	
57	WOMEN R.R. D103 SENSOR FAUCET	20 A	1			180 VA	360 VA		400.1/4		_	MEN R.R. D130 PAPER TOWEL DISPENSER	58
59	WOMEN R.R. D103 PAPER DISPENSER	20 A	1	400.144	400.1/4			360 VA	180 VA			MEN R.R. D100 SENSOR FAUCET	60
61	MENR.R. D121SENSOR FAUCET	20 A	1	180 VA	180 VA		400.1/4			1	20 A	MEN R.R. D100 PAPER DISPENSER	62
63	MEN R.R. D121 PAPER TOWEL DISPENSER	20 A	1			180 VA	180 VA		400.144	1	20 A	WOMEN R.R. D122 SENSOR FAUCET	64
65	GFCI RCPT. CAFE B100	20 A	1	400344	400344			720 VA	180 VA		20 A	WOMEN R.R. D122 PAPER TOWEL DISPENS	
67	VOICE ACTIVATED FIRE ALARM PANEL	20 A	1	180 VA	180 VA					1	20 A		68
69	IWH-1	20 A	2			2500	180 VA			1	20 A	CONTROL DISTRIBUTION PANEL	70
71								2500	78 VA	1		EF-7	72
73	SPARE	20 A	1	0 VA	0 VA		-			1	20 A	SPARE	74
75	SPARE	20 A	1			0 VA	0 VA			1	20 A	SPARE	76
77	SPARE	20 A	1					0 VA	180 VA	-	20 A	FIRE ALARM CONTROL PANEL	78
79	PANEL "2R"	150 A	3	6220	0 VA					3	60 A	SURGE PROTECTION DEVICE	80
81						5580	0 VA						82
83								5720	0 VA				84
			al Load: I Amps:	L	32 VA 5 A		01 VA 7 A		15 VA 8 A				
Legend	1:												
	lassification	C ~~~	nected I	head	Der	nand Fa	ctor	Eatin	nated De	mand		Panel Totals	
HVAC	าดออกเป็นไปปา		2280 VA		Der	100.00%			2280 VA				
Other			14048 V/			100.00%			14048 V/			Total Conn. Load: 82092 VA	
Recept	acle		26880 V	Ą		68.60%			18440 V	Ą		Total Est. Demand: 73653 VA	

Legend:

Load Classification	Connected Load	Demand Factor	Estimated Demand	Panel	Totals	
HVAC	2280 VA	100.00%	2280 VA			
Other	14048 VA	100.00%	14048 VA	Total Conn. Load:	82092 VA	
Receptacle	26880 VA	68.60%	18440 VA	Total Est. Demand:	73653 VA	
Power	39328 VA	100.00%	39328 VA	Total Conn.:	228 A	
				Total Est. Demand:	204 A	
Notes:						

Branch Panel: 2R

Location: ELEC. D127 Supply From: R Mounting: SURFACE Enclosure: NEMA 1

	Enclosure: NEMA 1											MCB Rating: 150 A	
Notes:													
скт	Circuit Description	Trip	Poles		4		в	_	C	Poles	Trip	Circuit Description	СКТ
1	GEN. RCPT. CORRIDOR - ALT #1	20 A	1	360 VA	500 VA					1	20 A	PROJ. SCREEN TRAINING RM. D131 - ALT #1	2
3	PROJ. SCREEN TRAINING RM. D132 - ALT #1	20 A	1			500 VA	180 VA			1	20 A	AV BRIDGE TRAINING RM. D131 - ALT #1	4
5	AV BRIDGE TRAINING RM. D132 - ALT #1	20 A	1					180 VA	1500	2	20 A	PARTITION WALL MOTOR TRAINING RM. ALT	6
7	PROJECTOR SCREEN TRAINING RM. A1 - AL	20 A	1	500 VA	1500								8
9	PROJECTOR SCREEN TRAINING RM. B1 - AL	20 A	1			500 VA	500 VA			1	20 A	PROJECTOR SCREEN TRAINING RM. C1 - AL	10
11	PROJECTOR SCREEN TRAINING RM. D1 - AL	20 A	1					500 VA	180 VA	1	20 A	AV BRIDGE TRAINING RM - ALT #2	12
13	AV BRIDGE TRAINING RM - ALT #2	20 A	1	180 VA	180 VA					1	20 A	AV BRIDGE TRAINING RM - ALT #2	14
15	AV BRIDGE TRAINING RM - ALT #2	20 A	1			180 VA	1500			2	20 A	PARTITION WALL MOTOR TRAINING RM. ALT	16
17	PARTITION WALL MOTOR TRAINING ROOM	20 A	2					1500	1500				18
19				1500	1500					2	20 A	PARTITION WALL MOTOR TRAINING RM. ALT	20
21	GEN. RCPT. CORRIDOR - ALT #3	20 A	1			720 VA	1500						22
23	GEN. RCPT. JAN. A103 & CLST A102 - ALT. #3	20 A	1					360 VA	0 VA	1	20 A	SPARE	24
25	SPARE	20 A	1	0 VA	0 VA					1	20 A	SPARE	26
27	SPARE	20 A	1			0 VA	0 VA			1	20 A	SPARE	28
29	SPARE	20 A	1					0 VA	0 VA	1	20 A	SPARE	30
31	SPARE	20 A	1	0 VA	0 VA					1	20 A	SPARE	32
33	SPARE	20 A	1			0 VA	0 VA			1	20 A	SPARE	34
35	SPARE	20 A	1					0 VA	0 VA	1	20 A	SPARE	36
37	SPARE	20 A	1	0 VA	0 VA					3	60 A	SURGE PROTECTION DEVICE	38
39	SPARE	20 A	1			0 VA	0 VA						40
41	SPARE	20 A	1					0 VA	0 VA				42
		Tota	al Load:	6220	AV C	558	0 VA	5720	AV C			•	
		Tota	I Amps:	52	A	47	7 A	48	A				

Load Classification Connected Load 2520 VA 15000 VA Receptacle Power

<u>REVISIONS:</u>


1. 19.03.18 ADDENDUM #4. REVISION TO PANEL "MDP" DUE TO ADDITION OF XFMR "RF" TO POWER ELECTRICAL PANEL "RF".

Volts: 120/208 Wye Phases: 3 Wires: 4

A.I.C. Rating: 10,000 Mains Type: COPPER Mains Rating: 150 A MCB Rating: 150 A

d	Demand Factor	Estimated Demand	Panel	Totals		
	100.00%	2520 VA				
	100.00%	15000 VA	Total Conn. Load:	17520 VA		
			Total Est. Demand:	17520 VA		
			Total Conn.:	49 A		
			Total Est. Demand:	49 A		



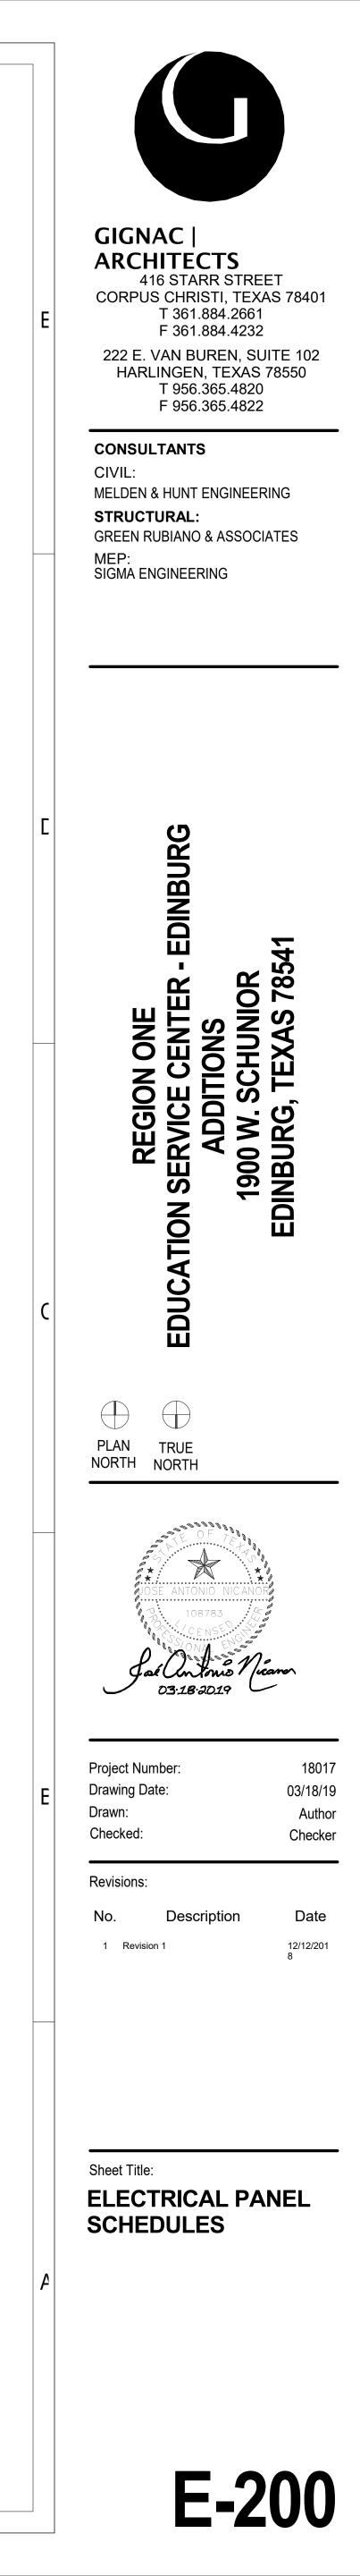


Notes:	Branch Panel: RC Location: MECH. D126 Supply From: XFMR 1RC Mounting: SURFACE Enclosure: NEMA 1				Volts: 120/208 V Phases: 3 Wires: 4	Vye			A.I.C. Rating: 10,000 Mains Type: COPPER Mains Rating: 200 A MCB Rating: 250 A
СКТ 1 IG	Circuit Description RCPT. STAGE D118	Trip 20 A	Poles	A 720 VA 720 VA	B	C	Pol	_	Circuit Description IG RCPT. TRAINING RM. A D113
	RCPT. TRAINING RM. B D115 RCPT. TRAINING RM. D116	20 A 20 A	1		360 VA 720 VA	60 VA 720	1 VA 1		IG RCPT. TRAINING RM. C D114 IG RCPT. TRAINING RM. E D117
7 IG	RCPT. RECEPTIONIST D112 RCPT. MONITORS D129	20 A 20 A 20 A	1	720 VA 720 VA			1	20 A	IG RCPT EMAIL STATIONS CORRIDOR D129 IG RCPT EMAIL STATIONS D110
	RCPT. MONITORS D129 RCPT. MONITORS D110 & D104	20 A 20 A	1			000 VA 540			IG RCPT EMAIL STATIONS D110 IG RCPT EMAIL STATIONS D119
	RCPT. MONITORS D119 RCPT. OFFICE C100	20 A 20 A	1	180 VA 540 VA	720 VA 720 VA		1		IG RCPT EMAIL STATIONS D119 IG RCPT. L.P. ASSIST. C101
	RCPT. OPERATIONS C102 RCPT. MONITORS CAFE B100	20 A 20 A	1	360 VA 720 VA		20 VA 900	VA 1		IG RCPT. OFFICE C105 FLOOR BOX TRAINING RM. A D113
21 FL	OOR BOX TRAINING RM. B D115	20 A	1		720 VA 720 VA		1	20 A	FLOOR BOX TRAINING RM. C D114
	OOR BOX TRAINING RM. D D116 OOR BOX CAFE B100	20 A 20 A	1	720 VA 180 VA		20 VA 720	VA 1		FLOOR BOX STAGE D118 AV EQUIPMENT RACK MDF D124
	SPLAY WALL BOX TRAINING RM. E D117 SPLAY WALL BOX TRAINING RM. E D117	20 A 20 A	1		180 VA 180 VA	80 VA 180	1 VA 1		AV EQUIPMENT RACK MDF D124 AV EQUIPMENT RACK MDF D124
		20 A	1	180 VA 720 VA			1		TELECOMM. RACK-1
	EQUIPMENT RACK MDF D124 EQUIPMENT RACK MDF D124	20 A 20 A	1		180 VA 720 VA	80 VA 180	1 VA 1		TELECOMM. RACK-2 PROJECTOR SCREENS TRAINING RM. A D113
	JAD RCPT. MDF D124 RACK-1 JAD RCPT. MDF D124 RACK-2	20 A 20 A	1	720 VA 180 VA	720 VA 180 VA		1		PROJECTOR SCREENS TRAINING RM B D115 PROJECTOR SCREENS TRAINING RM C D114
	DEO PROJECTOR TRAINING RM A D113 DEO PROJECTOR TRAINING RM B D115	20 A	1	260.1/4 190.1/4		860 VA 180			PROJECTOR SCREENS TRAINING RM D D116 PROJECTOR SCREEN STAGE D118
	DEO PROJECTOR TRAINING RM D D113 DEO PROJECTOR TRAINING RM C D114	20 A 20 A	1	360 VA 180 VA	360 VA 360 VA		1		VIDEO PROJECTOR TRAINING RM D D116
	DEO PROJECTOR STAGE D118 ARE	20 A 20 A	1	0 VA 0 VA		80 VA 0	/A 1 1		SPARE SPARE
51 SP	ARE	20 A	1		0 VA 0 VA	0.1/4	1 / <u>A</u> 1	20 A	SPARE
55 SP	ARE	20 A 20 A	1	0 VA 0 VA		0 VA 0	/A 1 1	20 A	SPARE SPARE
	ARE	20 A 20 A	1		0 VA 0 VA	0 VA 0	1 /A 1		SPARE SPARE
61 SP	ARE	20 A	1	0 VA 0 VA			1	20 A	SPARE
	ARE	20 A 20 A	1		0 VA 0 VA	0 VA 0	1 /A 1		SPARE SPARE
67 SP 69 SP	ARE	20 A 20 A	1	0 VA 0 VA	0 VA 0 VA		1		SPARE
71 SP	ARE	20 A	1			0 VA 0		20 A	SPARE
73 SP 75 SP	ARE	20 A 20 A	1	0 VA 0 VA	0 VA 0 VA		1		SPARE SPARE
77 SP	ARE IRGE PROTECTION DEVICE	20 A 60 A	1	0 VA 5580		0 VA 64	30 3	150 A	PANEL "2RC"
81 83		60 A			0 VA 7020	0 VA 0			 SPARE
Other Receptacle	sification	8	nected 3640 V/ 3480 V	4	mand Factor 100.00% 64.93%		J Demand) VA 0 VA		Panel TotalsTotal Conn. Load:42120 VATotal Est. Demand:30380 VATotal Conn.:117 ATotal Est. Demand:84 A
Other Receptacle		8	3640 V <i>A</i>	4	100.00%	864) VA	d	Total Conn. Load:42120 VATotal Est. Demand:30380 VATotal Conn.:117 A
Other Receptacle	Branch Panel: 2RC	8	3640 V <i>A</i>	A	100.00% 64.93%	864) VA	d	Total Conn. Load:42120 VATotal Est. Demand:30380 VATotal Conn.:117 ATotal Est. Demand:84 A
Other Receptacle	Branch Panel: 2RC Location: Supply From: RC Mounting: SURFACE Enclosure: NEMA 1	Trip	3640 V <i>A</i>		100.00% 64.93% Volts: 120/208 V Phases: 3 Wires: 4	864) VA	es Trip	Total Conn. Load: 42120 VA Total Est. Demand: 30380 VA Total Conn.: 117 A Total Est. Demand: 84 A Image: Hold Conners of the second
Other Receptacle Notes: Notes: Notes: CKT 1 IG	Branch Panel: 2RC Location: Supply From: RC Mounting: SURFACE Enclosure: NEMA 1		3640 V/ 3480 V		100.00% 64.93% Volts: 120/208 V Phases: 3 Wires: 4	864 2174	D VA 0 VA	es Trip 20 A	Total Conn. Load: 42120 VA Total Est. Demand: 30380 VA Total Conn.: 117 A Total Est. Demand: 84 A Image: Stress of the stress
Other Receptacle Notes: Notes: Notes:	Branch Panel: 2RC Location: Supply From: RC Mounting: SURFACE Enclosure: NEMA 1	ттір 20 А	3640 V/ 3480 V		100.00% 64.93% 4 Volts: 120/208 Phases: 3 Wires: 4 180 VA 180 VA	864 2174	0 VA 0 VA 	es Trip 20 A 20 A 20 A	Total Conn. Load: 42120 VA Total Est. Demand: 30380 VA Total Conn.: 117 A Total Est. Demand: 84 A Image: Hold Conners of the second
Other Receptacle	Branch Panel: 2RC Location: Supply From: RC Mounting: SURFACE Enclosure: NEMA 1	Trip 20 A 20 A 20 A 20 A	3640 V/ 3480 V	A A A 	100.00% 64.93% 64.93% 7 7 7 7 7 7 7 7 7 7 7 7 7 7 7 7 7 7 7	864 2174	O VA 0 VA 0 VA 1 1 VA 1 1 VA 1 1 1 1	es Trip 20 A 20 A 20 A 20 A 20 A	Total Conn. Load: 42120 VA Total Est. Demand: 30380 VA Total Conn.: 117 A Total Est. Demand: 84 A A.I.C. Rating: 10,000 Mains Type: COPPER Mains Rating: 150 A MCB Rating: 150 A MCB Rating: 150 A MCB Rating: 150 A IG RCPT. TRAINING RM. G D132 - ALT #1 VIDEO PROJECTOR TRAINING RM. D132 - AL FLOOR BOX TRAINING RM. D132 - ALT #1 DISPLAY WALL BOX TRAINING RM. D132 - AL IG RCPT. TRAINING RM. A1 C106 - ALT #2
Other Receptacle	Branch Panel: 2RC Location: Supply From: RC Mounting: SURFACE Enclosure: NEMA 1 Circuit Description RCPT. TRAINING RM.F D131 - ALT #1 DEO PROJECTOR TRAINING RM. D131 - AL OOR BOX TRAINING RM. D131 - ALT #1 SPLAY WALL BOX TRAINING RM. D131 - AL RCPT. EMAIL STATION - ALT #1 RCPT. TRAINING RM. B1 C107 - ALT #2 RCPT. TRAINING RM. D1 C109 - ALT #2	Trip 20 A 20 A 20 A 20 A 20 A	3640 V/ 3480 V	A A A 	100.00% 64.93% 64.93% 7 7 7 7 7 7 7 7 7 7 7 7 7 7 7 7 7 7 7	864 2174	D VA 0 VA 0 VA 0 VA 1 1 VA 1 1 VA 1 1 VA 1 1 VA 1 1 VA 1	es Trip 20 A 20 A 20 A 20 A 20 A 20 A 20 A 20 A	Total Conn. Load: 42120 VA Total Est. Demand: 30380 VA Total Conn.: 117 A Total Est. Demand: 84 A Image: Stress of the stress
Other Receptacle Notes: Notes: CKT 1 3 VII 5 7 9 11 IG 13 I5 VII 15	Branch Panel: 2RC Location: Supply From: RC Mounting: SURFACE Enclosure: NEMA 1 Circuit Description RCPT. TRAINING RM.F D131 - ALT #1 DEO PROJECTOR TRAINING RM. D131 - AL OOR BOX TRAINING RM. D131 - ALT #1 SPLAY WALL BOX TRAINING RM. D131 - AL RCPT. EMAIL STATION - ALT #1 RCPT. TRAINING RM. B1 C107 - ALT #2	Trip 20 A 20 A 20 A 20 A 20 A	3640 V/ 3480 V	A A A A A A A A A A A A A A A A A A A	100.00% 64.93% 64.93% 7 7 7 7 7 7 7 7 7 7 7 7 7 7 7 7 7 7 7	864 2174	O VA 0 VA 1 VA 1 VA 1 VA 1 VA 1 1 1 1 1 1 1 1 1 1 1 1 1 1 1 1 1 1 1 1	es Trip 20 A 20 A 20 A 20 A 20 A 20 A 20 A 20 A	Total Conn. Load: 42120 VA Total Est. Demand: 30380 VA Total Conn.: 117 A Total Est. Demand: 84 A A.I.C. Rating: 10,000 Mains Type: COPPER Mains Rating: 150 A MCB Rating: 150 A MCB Rating: 150 A IG RCPT. TRAINING RM. G D132 - ALT #1 VIDEO PROJECTOR TRAINING RM. D132 - AL FLOOR BOX TRAINING RM. D132 - ALT #1 DISPLAY WALL BOX TRAINING RM. D132 - ALT #2 IG RCPT. TRAINING RM. A1 C106 - ALT #2 IG RCPT. TRAINING RM. C1 C108 - ALT #2
Other Receptacle Receptacle Notes: Notes: CKT 1 IG 3 VIII 5 FL 7 DIS 9 IG 11 IG 13 IG 15 VIII 19 FL	Branch Panel: 2RC Location: Supply From: RC Mounting: SURFACE Enclosure: NEMA 1	Trip 20 A 20 A 20 A 20 A 20 A 20 A 20 A	3640 V/ 3480 V	A A A A A A A A A A A A A A A A A A A	100.00% 1 64.93% 1 4.93% 1 7 1 7 1 7 1 7 1 7 1 8 120/208 9 120/208	864 2174 Vye	O VA 0 VA 1 VA 1 VA 1 VA 1 VA 1 1 1 1 1 1 1 1 1 1 1 1 1 1 1 1 1 1 1 1	es Trip 20 A 20 A	Total Conn. Load: 42120 VA Total Est. Demand: 30380 VA Total Conn.: 117 A Total Est. Demand: 84 A A.I.C. Rating: 10,000 Mains Type: COPPER Mains Rating: 150 A MCB Rating: 150 A IG RCPT. TRAINING RM. G D132 - ALT #1 VIDEO PROJECTOR TRAINING RM. D132 - AL IG RCPT. TRAINING RM. A1 C106 - ALT #2 IG RCPT. TRAINING RM. A1 C108 - ALT #2 VIDEO PROJ. TRAINING RM. A1 C106 - ALT #2 VIDEO PROJ. TRAINING RM. A1 C106 - ALT #2 FLOOR BOX TRAINING RM. A1 C106 ALT #2 FLOOR BOX TRAINING RM. C1 C108 ALT #2
Other Receptacle Receptacle Notes: Notes: CKT 1 IG 3 VII 5 FL 7 DIS 9 IG 11 IG 13 IG 15 VII 17 VII 19 FL 21 FL 23 DIS	Eircuit Description Circuit Description RCPT. TRAINING RM. D131 - ALT #1 DEO PROJECTOR TRAINING RM. D131 - AL OOR BOX TRAINING RM. D131 - ALT #1 SPLAY WALL BOX TRAINING RM. D131 - AL RCPT. TRAINING RM. B1 C107 - ALT #2 DEO PROJ. TRAINING RM. B1 C107 - ALT #2 DOR BOX TRAINING RM. B1 C107 - ALT #2 DOR BO	Trip 20 A 20 A 20 A 20 A 20 A 20 A 20 A 20 A	3640 V/ 3480 V	A I A I I I <tdi< td=""> I <tdi< <="" td=""><td>100.00% 1 64.93% 1 - 1 - 1 - 1 - 1 - 1 - 1 - 1 - 1 - 1 - 1 - 1 - 1 Phases: 3 Wires: 4 180 VA 180 VA 360 VA 720 VA 180 VA 180 VA 720 VA 180 VA</td><td>864 2174 Vye</td><td>O VA 0 VA 1 1 1 1 1 1 1 1 1 1 1 1 1 1 1 1 1 1 1 </td><td>es Trip 20 A 20 A</td><td>Total Conn. Load: 42120 VA Total Est. Demand: 30380 VA Total Est. Demand: 84 A Total Est. Demand: 84 A A.I.C. Rating: 10,000 Mains Type: COPPER Mains Rating: 150 A MCB Rating: 150 A IG RCPT. TRAINING RM. G D132 - ALT #1 VIDEO PROJECTOR TRAINING RM. D132 - AL FLOOR BOX TRAINING RM. D132 - ALT #1 DISPLAY WALL BOX TRAINING RM. D132 - AL. IG RCPT. TRAINING RM. A1 C106 - ALT #2 VIDEO PROJ. TRAINING RM. A1 C106 - ALT #2 VIDEO PROJ. TRAINING RM. A1 C106 - ALT #2 VIDEO PROJ. TRAINING RM. A1 C106 - ALT #2 FLOOR BOX TRAINING RM. A1 C106 - ALT #2 PLOOR BOX TRAINING RM. A1 C106 - ALT #2 DISPLAY WALL BOX TRNG RM. A1 C106 - ALT #2 DISPLAY WALL BOX TR</td></tdi<></tdi<>	100.00% 1 64.93% 1 - 1 - 1 - 1 - 1 - 1 - 1 - 1 - 1 - 1 - 1 - 1 - 1 Phases: 3 Wires: 4 180 VA 180 VA 360 VA 720 VA 180 VA 180 VA 720 VA 180 VA	864 2174 Vye	O VA 0 VA 1 1 1 1 1 1 1 1 1 1 1 1 1 1 1 1 1 1 1	es Trip 20 A 20 A	Total Conn. Load: 42120 VA Total Est. Demand: 30380 VA Total Est. Demand: 84 A Total Est. Demand: 84 A A.I.C. Rating: 10,000 Mains Type: COPPER Mains Rating: 150 A MCB Rating: 150 A IG RCPT. TRAINING RM. G D132 - ALT #1 VIDEO PROJECTOR TRAINING RM. D132 - AL FLOOR BOX TRAINING RM. D132 - ALT #1 DISPLAY WALL BOX TRAINING RM. D132 - AL. IG RCPT. TRAINING RM. A1 C106 - ALT #2 VIDEO PROJ. TRAINING RM. A1 C106 - ALT #2 VIDEO PROJ. TRAINING RM. A1 C106 - ALT #2 VIDEO PROJ. TRAINING RM. A1 C106 - ALT #2 FLOOR BOX TRAINING RM. A1 C106 - ALT #2 PLOOR BOX TRAINING RM. A1 C106 - ALT #2 DISPLAY WALL BOX TRNG RM. A1 C106 - ALT #2 DISPLAY WALL BOX TR
Other Receptacle Receptacle Notes: Notes: I </td <td>Eircuit Description Circuit Description RCPT. TRAINING RM. D131 - ALT #1 DEO PROJECTOR TRAINING RM. D131 - AL OOR BOX TRAINING RM. D131 - ALT #1 SPLAY WALL BOX TRAINING RM. D131 - AL RCPT. TRAINING RM. B1 C107 - ALT #2 RCPT. TRAINING RM. D1 C109 - ALT #2 DEO PROJ. TRAINING RM. D1 C109 - ALT #2 DEO PROJ. TRAINING RM. D1 C109 - ALT #2 DEO PROJ. TRAINING RM. B1 C107 - ALT #2 DOR BOX TRAINING RM. B1 C107 - ALT #2</td> <td>Trip 20 A 20 A 20 A 20 A 20 A 20 A 20 A 20 A</td> <td>3640 V/ 3480 V</td> <td>A I A I A I A I I I <tdi< td=""> I <tdi< <="" td=""><td>100.00% 1 64.93% 1 - 1 - 1 - 1 - 1 - 1 - 1 - 1 - 1 - 1 - 1 - 1 - 1 Phases: 3 Wires: 4 180 VA 180 VA 360 VA 720 VA 180 VA 180 VA 720 VA 180 VA</td><td>864 2174 Vye</td><td>O VA 0 VA 1 1 1 1 1 1 1 1 1 1 1 1 1 1 1 1 1 1 1 </td><td>es Trip 20 A 20 A</td><td>Total Conn. Load: 42120 VA Total Est. Demand: 30380 VA Total Est. Demand: 84 A Total Est. Demand: 84 A A.I.C. Rating: 10,000 Mains Type: COPPER Mains Rating: 150 A MCB Rating: 150 A IG RCPT. TRAINING RM. G D132 - ALT #1 VIDEO PROJECTOR TRAINING RM. D132 - AL FLOOR BOX TRAINING RM. D132 - ALT #1 DISPLAY WALL BOX TRAINING RM. D132 - AL. YIDEO PROJ. TRAINING RM. A1 C106 - ALT #2 VIDEO PROJ. TRAINING RM. A1 C106 - ALT #2 VIDEO PROJ. TRAINING RM. A1 C106 - ALT #2 FLOOR BOX TRAINING RM. A1 C106 ALT #2 FLOOR BOX TRAINING RM. A1 C106 ALT #2 FLOOR BOX TRAINING RM. A1 C106 - ALT #2 FLOOR BOX TRAINING RM. A1 C106 - ALT #2 FLOOR BOX TRAINING RM. A1</td></tdi<></tdi<></td>	Eircuit Description Circuit Description RCPT. TRAINING RM. D131 - ALT #1 DEO PROJECTOR TRAINING RM. D131 - AL OOR BOX TRAINING RM. D131 - ALT #1 SPLAY WALL BOX TRAINING RM. D131 - AL RCPT. TRAINING RM. B1 C107 - ALT #2 RCPT. TRAINING RM. D1 C109 - ALT #2 DEO PROJ. TRAINING RM. D1 C109 - ALT #2 DEO PROJ. TRAINING RM. D1 C109 - ALT #2 DEO PROJ. TRAINING RM. B1 C107 - ALT #2 DOR BOX TRAINING RM. B1 C107 - ALT #2	Trip 20 A 20 A 20 A 20 A 20 A 20 A 20 A 20 A	3640 V/ 3480 V	A I A I A I A I I I <tdi< td=""> I <tdi< <="" td=""><td>100.00% 1 64.93% 1 - 1 - 1 - 1 - 1 - 1 - 1 - 1 - 1 - 1 - 1 - 1 - 1 Phases: 3 Wires: 4 180 VA 180 VA 360 VA 720 VA 180 VA 180 VA 720 VA 180 VA</td><td>864 2174 Vye</td><td>O VA 0 VA 1 1 1 1 1 1 1 1 1 1 1 1 1 1 1 1 1 1 1 </td><td>es Trip 20 A 20 A</td><td>Total Conn. Load: 42120 VA Total Est. Demand: 30380 VA Total Est. Demand: 84 A Total Est. Demand: 84 A A.I.C. Rating: 10,000 Mains Type: COPPER Mains Rating: 150 A MCB Rating: 150 A IG RCPT. TRAINING RM. G D132 - ALT #1 VIDEO PROJECTOR TRAINING RM. D132 - AL FLOOR BOX TRAINING RM. D132 - ALT #1 DISPLAY WALL BOX TRAINING RM. D132 - AL. YIDEO PROJ. TRAINING RM. A1 C106 - ALT #2 VIDEO PROJ. TRAINING RM. A1 C106 - ALT #2 VIDEO PROJ. TRAINING RM. A1 C106 - ALT #2 FLOOR BOX TRAINING RM. A1 C106 ALT #2 FLOOR BOX TRAINING RM. A1 C106 ALT #2 FLOOR BOX TRAINING RM. A1 C106 - ALT #2 FLOOR BOX TRAINING RM. A1 C106 - ALT #2 FLOOR BOX TRAINING RM. A1</td></tdi<></tdi<>	100.00% 1 64.93% 1 - 1 - 1 - 1 - 1 - 1 - 1 - 1 - 1 - 1 - 1 - 1 - 1 Phases: 3 Wires: 4 180 VA 180 VA 360 VA 720 VA 180 VA 180 VA 720 VA 180 VA	864 2174 Vye	O VA 0 VA 1 1 1 1 1 1 1 1 1 1 1 1 1 1 1 1 1 1 1	es Trip 20 A 20 A	Total Conn. Load: 42120 VA Total Est. Demand: 30380 VA Total Est. Demand: 84 A Total Est. Demand: 84 A A.I.C. Rating: 10,000 Mains Type: COPPER Mains Rating: 150 A MCB Rating: 150 A IG RCPT. TRAINING RM. G D132 - ALT #1 VIDEO PROJECTOR TRAINING RM. D132 - AL FLOOR BOX TRAINING RM. D132 - ALT #1 DISPLAY WALL BOX TRAINING RM. D132 - AL. YIDEO PROJ. TRAINING RM. A1 C106 - ALT #2 VIDEO PROJ. TRAINING RM. A1 C106 - ALT #2 VIDEO PROJ. TRAINING RM. A1 C106 - ALT #2 FLOOR BOX TRAINING RM. A1 C106 ALT #2 FLOOR BOX TRAINING RM. A1 C106 ALT #2 FLOOR BOX TRAINING RM. A1 C106 - ALT #2 FLOOR BOX TRAINING RM. A1 C106 - ALT #2 FLOOR BOX TRAINING RM. A1
Other Receptacle Notes: Notes: I <	Ercuit Description Circuit Description RCPT. TRAINING RM. D131 - ALT #1 DEO PROJECTOR TRAINING RM. D131 - AL OOR BOX TRAINING RM. D131 - ALT #1 SPLAY WALL BOX TRAINING RM. D1 C109 - ALT #2 DEO PROJ. TRAINING RM. D1 C109 - ALT #2 DEO	Trip 20 A 20 A 20 A 20 A 20 A 20 A 20 A 20 A	3640 V/ 3480 V	A I A I I I <tdi< td=""> I <tdi< <="" td=""><td>100.00% 1 64.93% 1 - 1 - 1 - 1 - 1 - 1 - 1 - 1 - 1 - 1 - 1 - 1 - 1 Phases: 3 Wires: 4 180 VA 180 VA 360 VA 720 VA 180 VA 180 VA 720 VA 180 VA 720 VA 720 VA</td><td>864 2174 Vye</td><td>O VA 0 VA 1 VA 1 VA 1 1 1 1 1 1 1 1</td><td>es Trip 20 A 20 A</td><td>Total Conn. Load: 42120 VA Total Est. Demand: 30380 VA Total Est. Demand: 84 A A.I.C. Rating: 10,000 Mains Type: COPPER Mains Rating: 150 A MCB Rating: 150 A IG RCPT. TRAINING RM. G D132 - ALT #1 VIDEO PROJECTOR TRAINING RM. D132 - AL FLOOR BOX TRAINING RM. D132 - AL IG RCPT. TRAINING RM. A1 C106 - ALT #2 IG RCPT. TRAINING RM. A1 C106 - ALT #2 VIDEO PROJ. TRAINING RM. A1 C106 - ALT #2 VIDEO PROJ. TRAINING RM. A1 C106 - ALT #2 VIDEO PROJ. TRAINING RM. A1 C106 - ALT #2 VIDEO PROJ. TRAINING RM. A1 C106 - ALT #2 FLOOR BOX TRAINING RM. A1 C106 - ALT #2 FLOOR BOX TRAINING RM. A1 C106 - ALT #2 PLOOR BOX TRAINING RM. A1 C106 - ALT #2 PLOOR BOX TRAINING RM. A1 C106 - ALT #2 PLOOR BOX TRAI</td></tdi<></tdi<>	100.00% 1 64.93% 1 - 1 - 1 - 1 - 1 - 1 - 1 - 1 - 1 - 1 - 1 - 1 - 1 Phases: 3 Wires: 4 180 VA 180 VA 360 VA 720 VA 180 VA 180 VA 720 VA 180 VA 720 VA 720 VA	864 2174 Vye	O VA 0 VA 1 VA 1 VA 1 1 1 1 1 1 1 1	es Trip 20 A 20 A	Total Conn. Load: 42120 VA Total Est. Demand: 30380 VA Total Est. Demand: 84 A A.I.C. Rating: 10,000 Mains Type: COPPER Mains Rating: 150 A MCB Rating: 150 A IG RCPT. TRAINING RM. G D132 - ALT #1 VIDEO PROJECTOR TRAINING RM. D132 - AL FLOOR BOX TRAINING RM. D132 - AL IG RCPT. TRAINING RM. A1 C106 - ALT #2 IG RCPT. TRAINING RM. A1 C106 - ALT #2 VIDEO PROJ. TRAINING RM. A1 C106 - ALT #2 VIDEO PROJ. TRAINING RM. A1 C106 - ALT #2 VIDEO PROJ. TRAINING RM. A1 C106 - ALT #2 VIDEO PROJ. TRAINING RM. A1 C106 - ALT #2 FLOOR BOX TRAINING RM. A1 C106 - ALT #2 FLOOR BOX TRAINING RM. A1 C106 - ALT #2 PLOOR BOX TRAINING RM. A1 C106 - ALT #2 PLOOR BOX TRAINING RM. A1 C106 - ALT #2 PLOOR BOX TRAI
Other Receptacle Notes: Notes: CKT 1 IG 3 VII 5 FL 7 DIS 9 IG 11 IG 3 VII 5 FL 7 DIS 9 IG 11 IG 25 DIS 21 FL 23 DIS 241 FL 23 DIS 241 IG 33 IG 31 IG 33 IG	Ercuit Description Circuit Description RCPT. TRAINING RM.F D131 - ALT #1 DEO PROJECTOR TRAINING RM. D131 - AL OOR BOX TRAINING RM. D131 - ALT #1 SPLAY WALL BOX TRAINING RM. D131 - AL RCPT. TRAINING RM. B1 C107 - ALT #2 RCPT. TRAINING RM. D1 C109 - ALT #2 DEO PROJ. TRAINING RM. D1 C109 - ALT #3 RCPT. OFFICE A101 - ALT #3 RCPT. OFFICE A107 - ALT #3 RCPT. OFFICE A107 - ALT #3	Image: Control of the second state	3640 V/ 3480 V	A I A I I I <tdi< td=""> I <tdi< <="" td=""><td>100.00% 1 64.93% 1 - 1 - 1 - 1 - 1 - 1 - 1 - 1 - 1 - 1 - 1 - 1 - 1 Phases: 3 Wires: 4 180 VA 180 VA 120 VA 180 VA 120 VA 120 VA 120 VA 120 VA</td><td>864 2174 2174 2174 2174 2174 2174 2174 2174 2174 2174 2174 2174 2174 2174 220 220 220 20 210 <tr< td=""><td>O VA 0 VA 1 1 1 1 1 1 1</td><td>es Trip 20 A 20 A</td><td>Total Conn. Load:42120 VATotal Est. Demand:30380 VATotal Conn.:117 ATotal Est. Demand:84 ABains Rating:10,000Mains Type:COPPERMains Rating:150 AMCB Rating:150 AMCB Rating:150 AMCB Rating:150 AIG RCPT. TRAINING RM. G D132 - ALT #1VIDEO PROJECTOR TRAINING RM. D132 - ALFLOOR BOX TRAINING RM. D132 - ALT #1DISPLAY WALL BOX TRAINING RM. D132 - ALIG RCPT. TRAINING RM. A1 C106 - ALT #2IG RCPT. TRAINING RM. C1 C108 - ALT #2VIDEO PROJ. TRAINING RM. A1 C106 - ALT #2FLOOR BOX TRAINING RM. A1 C108 - ALT #2FLOOR BOX TRAINING RM. A1 C108 - ALT #2FLOOR BOX TRAINING RM. C1 C108 - ALT #2FLOOR BOX TRAINING RM. C1 C108 - ALT #2IG RCPT. OFFICE A100 - ALT #3IG RCPT. OFFICE A100 - ALT #3IG RCPT. OFFICE A106 - ALT #3IG RCPT. OFFICE A108 - ALT #3IG RCPT. COPY RM. A110 - ALT #3</td></tr<></td></tdi<></tdi<>	100.00% 1 64.93% 1 - 1 - 1 - 1 - 1 - 1 - 1 - 1 - 1 - 1 - 1 - 1 - 1 Phases: 3 Wires: 4 180 VA 180 VA 120 VA 180 VA 120 VA 120 VA 120 VA 120 VA	864 2174 2174 2174 2174 2174 2174 2174 2174 2174 2174 2174 2174 2174 2174 220 220 220 20 210 <tr< td=""><td>O VA 0 VA 1 1 1 1 1 1 1</td><td>es Trip 20 A 20 A</td><td>Total Conn. Load:42120 VATotal Est. Demand:30380 VATotal Conn.:117 ATotal Est. Demand:84 ABains Rating:10,000Mains Type:COPPERMains Rating:150 AMCB Rating:150 AMCB Rating:150 AMCB Rating:150 AIG RCPT. TRAINING RM. G D132 - ALT #1VIDEO PROJECTOR TRAINING RM. D132 - ALFLOOR BOX TRAINING RM. D132 - ALT #1DISPLAY WALL BOX TRAINING RM. D132 - ALIG RCPT. TRAINING RM. A1 C106 - ALT #2IG RCPT. TRAINING RM. C1 C108 - ALT #2VIDEO PROJ. TRAINING RM. A1 C106 - ALT #2FLOOR BOX TRAINING RM. A1 C108 - ALT #2FLOOR BOX TRAINING RM. A1 C108 - ALT #2FLOOR BOX TRAINING RM. C1 C108 - ALT #2FLOOR BOX TRAINING RM. C1 C108 - ALT #2IG RCPT. OFFICE A100 - ALT #3IG RCPT. OFFICE A100 - ALT #3IG RCPT. OFFICE A106 - ALT #3IG RCPT. OFFICE A108 - ALT #3IG RCPT. COPY RM. A110 - ALT #3</td></tr<>	O VA 0 VA 1 1 1 1 1 1 1	es Trip 20 A 20 A	Total Conn. Load:42120 VATotal Est. Demand:30380 VATotal Conn.:117 ATotal Est. Demand:84 ABains Rating:10,000Mains Type:COPPERMains Rating:150 AMCB Rating:150 AMCB Rating:150 AMCB Rating:150 AIG RCPT. TRAINING RM. G D132 - ALT #1VIDEO PROJECTOR TRAINING RM. D132 - ALFLOOR BOX TRAINING RM. D132 - ALT #1DISPLAY WALL BOX TRAINING RM. D132 - ALIG RCPT. TRAINING RM. A1 C106 - ALT #2IG RCPT. TRAINING RM. C1 C108 - ALT #2VIDEO PROJ. TRAINING RM. A1 C106 - ALT #2FLOOR BOX TRAINING RM. A1 C108 - ALT #2FLOOR BOX TRAINING RM. A1 C108 - ALT #2FLOOR BOX TRAINING RM. C1 C108 - ALT #2FLOOR BOX TRAINING RM. C1 C108 - ALT #2IG RCPT. OFFICE A100 - ALT #3IG RCPT. OFFICE A100 - ALT #3IG RCPT. OFFICE A106 - ALT #3IG RCPT. OFFICE A108 - ALT #3IG RCPT. COPY RM. A110 - ALT #3
Other Receptacle Receptacle	Eircuit Description Circuit Description RCPT. TRAINING RM.F D131 - ALT #1 DEO PROJECTOR TRAINING RM. D131 - ALT. OOR BOX TRAINING RM. D131 - ALT #1 SPLAY WALL BOX TRAINING RM. D131 - AL RCPT. TRAINING RM. D131 - ALT #1 RCPT. TRAINING RM. D131 - ALT #2 RCPT. TRAINING RM. D1 C109 - ALT #2 DEO PROJ. TRAINING RM. D1 C109 - ALT #2 RCPT. OFFICE A101 - ALT #3 RCPT. OFFICE A105 - ALT #3 RCPT. OFFICE A107 - ALT #3	Trip 20 A 20 A 20 A 20 A 20 A 20 A 20 A 20 A	3640 V/ 3480 V	A I A I I I <tdi< td=""> I <tdi< <="" td=""><td>100.00% 1 64.93% 1 - 1 - 1 - 1 - 1 - 1 - 1 - 1 - 1 - 1 - 1 - 1 - 1 Phases: 3 Wires: 4 180 VA 180 VA 120 VA 180 VA 120 VA 120 VA 120 VA 120 VA</td><td>864 2174 </td><td>O VA 0 VA 1 1 1 1 1 1 1</td><td>es Trip 20 A 20 A</td><td>Total Conn. Load:42120 VATotal Est. Demand:30380 VATotal Est. Demand:84 AIIT A84 ATotal Est. Demand:84 AMains Type:COPPERMains Rating:150 AMCB Rating:150 AMCB Rating:150 AIG RCPT. TRAINING RM. G D132 - ALT #1VIDEO PROJECTOR TRAINING RM. D132 - AL.FLOOR BOX TRAINING RM. D132 - ALT #1DISPLAY WALL BOX TRAINING RM. D132 - AL.IG RCPT. TRAINING RM. A1 C106 - ALT #2IG RCPT. TRAINING RM. A1 C108 - ALT #2VIDEO PROJ. TRAINING RM. A1 C108 - ALT #2FLOOR BOX TRAINING RM. A1 C108 - ALT #2FLOOR BOX TRAINING RM. C1 C108 - ALT #2FLOOR BOX TRAINING RM. C1 C108 - ALT #2ISPLAY WALL BOX TRNG RM. A1 C106 - ALT #2ISPLAY WALL BOX TRNG RM. A1 C106 - ALT #2ISPLAY WALL BOX TRNG RM. A1 C108 - ALT #3IG RCPT. OFFICE A100 - ALT #3IG RCPT. OFFICE A104 - ALT #3IG RCPT. OFFICE A106 - ALT #3</td></tdi<></tdi<>	100.00% 1 64.93% 1 - 1 - 1 - 1 - 1 - 1 - 1 - 1 - 1 - 1 - 1 - 1 - 1 Phases: 3 Wires: 4 180 VA 180 VA 120 VA 180 VA 120 VA 120 VA 120 VA 120 VA	864 2174 	O VA 0 VA 1 1 1 1 1 1 1	es Trip 20 A 20 A	Total Conn. Load:42120 VATotal Est. Demand:30380 VATotal Est. Demand:84 AIIT A84 ATotal Est. Demand:84 AMains Type:COPPERMains Rating:150 AMCB Rating:150 AMCB Rating:150 AIG RCPT. TRAINING RM. G D132 - ALT #1VIDEO PROJECTOR TRAINING RM. D132 - AL.FLOOR BOX TRAINING RM. D132 - ALT #1DISPLAY WALL BOX TRAINING RM. D132 - AL.IG RCPT. TRAINING RM. A1 C106 - ALT #2IG RCPT. TRAINING RM. A1 C108 - ALT #2VIDEO PROJ. TRAINING RM. A1 C108 - ALT #2FLOOR BOX TRAINING RM. A1 C108 - ALT #2FLOOR BOX TRAINING RM. C1 C108 - ALT #2FLOOR BOX TRAINING RM. C1 C108 - ALT #2ISPLAY WALL BOX TRNG RM. A1 C106 - ALT #2ISPLAY WALL BOX TRNG RM. A1 C106 - ALT #2ISPLAY WALL BOX TRNG RM. A1 C108 - ALT #3IG RCPT. OFFICE A100 - ALT #3IG RCPT. OFFICE A104 - ALT #3IG RCPT. OFFICE A106 - ALT #3
Other Receptacle Notes: Notes: Notes: I I I I I I I I I II II II II II II III III III III III III IIII IIII IIIIIIIIIIIIIIIIIIIIIIIIIIIIIIIIIIII	Eircuit Description Circuit Description RCPT. TRAINING RM.F D131 - ALT #1 DEO PROJECTOR TRAINING RM. D131 - AL OOR BOX TRAINING RM. D131 - ALT #1 DEO PROJECTOR TRAINING RM. D131 - AL OOR BOX TRAINING RM. D131 - ALT #1 SPLAY WALL BOX TRAINING RM. D131 - AL RCPT. TRAINING RM. B1 C107 - ALT #2 RCPT. TRAINING RM. B1 C107 - ALT #2 RCPT. TRAINING RM. D1 C109 - ALT #2 DEO PROJ. TRAINING RM. B1 C107 - ALT #2 RCPT. OFFICE A101 - ALT #3 RCPT. OFFICE A105 - ALT #3 RCPT. OFFICE A109 - ALT #3 RCPT. OFFICE A109 - ALT #3 RCPT. FILE RM. A111 - ALT #3	Trip 20 A 20 A 20 A 20 A 20 A 20 A 20 A 20 A	3640 V/ 3480 V	A I A I I I <tdi< td=""> I <tdi< <="" td=""><td>100.00% 1 64.93% 1 - 1 - 1 - 1 - 1 - 1 - 1 - 1 - 1 - 1 - 1 - 1 - 1 Phases: 3 Wires: 4 180 VA 180 VA 120 VA 180 VA 120 VA 120 VA 120 VA 120 VA</td><td>864 2174 2174 2174 2174 2174 2174 2174 2174 2174 2174 2174 2174 2174 2174 220 220 220 20 210 <tr< td=""><td>VA VA VA VA VA Pole VA I I I I I I I I I I I I I I I I <</td><td>es Trip 20 A 20 A</td><td>Total Conn. Load:42120 VATotal Est. Demand:30380 VATotal Est. Demand:84 AA.I.C. Rating:10,000Mains Type:COPPERMains Type:COPPERMains Rating:150 AMCB Rating:150 AMCB Rating:150 AMCB Rating:150 AIG RCPT. TRAINING RM. G D132 - ALT #1VIDEO PROJECTOR TRAINING RM. D132 - ALFLOOR BOX TRAINING RM. D132 - ALFLOOR BOX TRAINING RM. D132 - ALIG RCPT. TRAINING RM. A1 C106 - ALT #2IG RCPT. TRAINING RM. A1 C108 - ALT #2VIDEO PROJ. TRAINING RM. A1 C108 - ALT #2VIDEO PROJ. TRAINING RM. A1 C108 - ALT #2FLOOR BOX TRAINING RM. A1 C108 - ALT #2FLOOR BOX TRAINING RM. A1 C108 - ALT #2FLOOR BOX TRAINING RM. A1 C108 - ALT #2ISPLAY WALL BOX TRNG RM. A1 C108 - ALT #2DISPLAY WALL BOX TRNG RM. A1 C108 - ALT #3IG RCPT. OFFICE A100 - ALT #3IG RCPT. OFFICE A100 - ALT #3IG RCPT. OFFICE A108 - ALT #3IG RCPT. P/A A112 - ALT #3</td></tr<></td></tdi<></tdi<>	100.00% 1 64.93% 1 - 1 - 1 - 1 - 1 - 1 - 1 - 1 - 1 - 1 - 1 - 1 - 1 Phases: 3 Wires: 4 180 VA 180 VA 120 VA 180 VA 120 VA 120 VA 120 VA 120 VA	864 2174 2174 2174 2174 2174 2174 2174 2174 2174 2174 2174 2174 2174 2174 220 220 220 20 210 <tr< td=""><td>VA VA VA VA VA Pole VA I I I I I I I I I I I I I I I I <</td><td>es Trip 20 A 20 A</td><td>Total Conn. Load:42120 VATotal Est. Demand:30380 VATotal Est. Demand:84 AA.I.C. Rating:10,000Mains Type:COPPERMains Type:COPPERMains Rating:150 AMCB Rating:150 AMCB Rating:150 AMCB Rating:150 AIG RCPT. TRAINING RM. G D132 - ALT #1VIDEO PROJECTOR TRAINING RM. D132 - ALFLOOR BOX TRAINING RM. D132 - ALFLOOR BOX TRAINING RM. D132 - ALIG RCPT. TRAINING RM. A1 C106 - ALT #2IG RCPT. TRAINING RM. A1 C108 - ALT #2VIDEO PROJ. TRAINING RM. A1 C108 - ALT #2VIDEO PROJ. TRAINING RM. A1 C108 - ALT #2FLOOR BOX TRAINING RM. A1 C108 - ALT #2FLOOR BOX TRAINING RM. A1 C108 - ALT #2FLOOR BOX TRAINING RM. A1 C108 - ALT #2ISPLAY WALL BOX TRNG RM. A1 C108 - ALT #2DISPLAY WALL BOX TRNG RM. A1 C108 - ALT #3IG RCPT. OFFICE A100 - ALT #3IG RCPT. OFFICE A100 - ALT #3IG RCPT. OFFICE A108 - ALT #3IG RCPT. P/A A112 - ALT #3</td></tr<>	VA VA VA VA VA Pole VA I I I I I I I I I I I I I I I I <	es Trip 20 A 20 A	Total Conn. Load:42120 VATotal Est. Demand:30380 VATotal Est. Demand:84 AA.I.C. Rating:10,000Mains Type:COPPERMains Type:COPPERMains Rating:150 AMCB Rating:150 AMCB Rating:150 AMCB Rating:150 AIG RCPT. TRAINING RM. G D132 - ALT #1VIDEO PROJECTOR TRAINING RM. D132 - ALFLOOR BOX TRAINING RM. D132 - ALFLOOR BOX TRAINING RM. D132 - ALIG RCPT. TRAINING RM. A1 C106 - ALT #2IG RCPT. TRAINING RM. A1 C108 - ALT #2VIDEO PROJ. TRAINING RM. A1 C108 - ALT #2VIDEO PROJ. TRAINING RM. A1 C108 - ALT #2FLOOR BOX TRAINING RM. A1 C108 - ALT #2FLOOR BOX TRAINING RM. A1 C108 - ALT #2FLOOR BOX TRAINING RM. A1 C108 - ALT #2ISPLAY WALL BOX TRNG RM. A1 C108 - ALT #2DISPLAY WALL BOX TRNG RM. A1 C108 - ALT #3IG RCPT. OFFICE A100 - ALT #3IG RCPT. OFFICE A100 - ALT #3IG RCPT. OFFICE A108 - ALT #3IG RCPT. P/A A112 - ALT #3
Other Receptacle Receptacle Notes: Notes: Receptacle Notes: Receptacle Notes: Receptacle Receptacle <td>Branch Panel: 2RC Location: Supply From: RC Mounting: SURFACE Enclosure: NEMA 1 Circuit Description RCPT. TRAINING RM.F D131 - ALT #1 DEO PROJECTOR TRAINING RM. D131 - AL OOR BOX TRAINING RM. D131 - ALT #1 DEO PROJECTOR TRAINING RM. D131 - AL RCPT. EMAIL STATION - ALT #1 RCPT. TRAINING RM. B1 C107 - ALT #2 RCPT. TRAINING RM. B1 C107 - ALT #2 DEO PROJ. TRAINING RM. D1 C109 - ALT #2 SPLAY WALL BOX TRNG RM. B1 C107 - ALT #3 RCPT. OFFICE A101 - ALT #3 RCPT. OFFICE A107 - ALT #3 RCPT. OFFICE A109 - ALT #3 RCPT. FILE RM. A111 - ALT #3 ARE ARE</td> <td>Image: Control of the control of th</td> <td>3640 V/ 3480 V</td> <td>A I A I I I <tdi< td=""> I <tdi< <="" td=""><td>100.00% 1 64.93% 1 7 1 7 1 7 120/208 8 3 9 3 9 3 180 180 <td>864 2174 2174 2174 2174 2174 2174 2174 2174 2174 220 VA 20 VA 210 VA <t< td=""><td>VA 0 VA 1 1</td><td>es Trip 20 A 20 A</td><td>Total Conn. Load: 42120 VA Total Est. Demand: 30380 VA Total Est. Demand: 117 A Total Est. Demand: 84 A Image: Stress of the stress of the</td></t<></td></td></tdi<></tdi<></td>	Branch Panel: 2RC Location: Supply From: RC Mounting: SURFACE Enclosure: NEMA 1 Circuit Description RCPT. TRAINING RM.F D131 - ALT #1 DEO PROJECTOR TRAINING RM. D131 - AL OOR BOX TRAINING RM. D131 - ALT #1 DEO PROJECTOR TRAINING RM. D131 - AL RCPT. EMAIL STATION - ALT #1 RCPT. TRAINING RM. B1 C107 - ALT #2 RCPT. TRAINING RM. B1 C107 - ALT #2 DEO PROJ. TRAINING RM. D1 C109 - ALT #2 SPLAY WALL BOX TRNG RM. B1 C107 - ALT #3 RCPT. OFFICE A101 - ALT #3 RCPT. OFFICE A107 - ALT #3 RCPT. OFFICE A109 - ALT #3 RCPT. FILE RM. A111 - ALT #3 ARE ARE	Image: Control of the control of th	3640 V/ 3480 V	A I A I I I <tdi< td=""> I <tdi< <="" td=""><td>100.00% 1 64.93% 1 7 1 7 1 7 120/208 8 3 9 3 9 3 180 180 <td>864 2174 2174 2174 2174 2174 2174 2174 2174 2174 220 VA 20 VA 210 VA <t< td=""><td>VA 0 VA 1 1</td><td>es Trip 20 A 20 A</td><td>Total Conn. Load: 42120 VA Total Est. Demand: 30380 VA Total Est. Demand: 117 A Total Est. Demand: 84 A Image: Stress of the stress of the</td></t<></td></td></tdi<></tdi<>	100.00% 1 64.93% 1 7 1 7 1 7 120/208 8 3 9 3 9 3 180 180 <td>864 2174 2174 2174 2174 2174 2174 2174 2174 2174 220 VA 20 VA 210 VA <t< td=""><td>VA 0 VA 1 1</td><td>es Trip 20 A 20 A</td><td>Total Conn. Load: 42120 VA Total Est. Demand: 30380 VA Total Est. Demand: 117 A Total Est. Demand: 84 A Image: Stress of the stress of the</td></t<></td>	864 2174 2174 2174 2174 2174 2174 2174 2174 2174 220 VA 20 VA 210 VA <t< td=""><td>VA 0 VA 1 1</td><td>es Trip 20 A 20 A</td><td>Total Conn. Load: 42120 VA Total Est. Demand: 30380 VA Total Est. Demand: 117 A Total Est. Demand: 84 A Image: Stress of the stress of the</td></t<>	VA 0 VA 1 1	es Trip 20 A 20 A	Total Conn. Load: 42120 VA Total Est. Demand: 30380 VA Total Est. Demand: 117 A Total Est. Demand: 84 A Image: Stress of the
Other Receptacle Rotes: Notes: Notes: I	Branch Panel: 2RC Location: Supply From: RC Mounting: SURFACE Enclosure: NEMA 1 Circuit Description RCPT. TRAINING RM.F D131 - ALT #1 DEO PROJECTOR TRAINING RM. D131 - AL OOR BOX TRAINING RM. D131 - ALT #1 SPLAY WALL BOX TRAINING RM. D131 - AL RCPT. EMAIL STATION - ALT #1 RCPT. TRAINING RM. B1 C107 - ALT #2 DEO PROJ. TRAINING RM. D1 C109 - ALT #2 DOR BOX TRAINING RM. D1 C109 - ALT #2 SPLAY WALL BOX TRNG RM. D1 C109 - ALT RCPT. OFFICE A101 - ALT #3 RCPT. OFFICE A107 - ALT #3 RCPT. OFFICE A109 - ALT #3 RCPT. OFFICE A109 - ALT #3 RCPT. OFFICE A109 - ALT #3 RCPT. FILE RM. A111 - ALT #3 ARE ARE	Image: Control of the second state	B640 V/ 3480 V 3480 V Antipersection Poles 1 1 1 1 1 1 1 1 1 1 1 1 1	A I A I I	100.00% 1 64.93% 1 - 1 - - Phases: 3 Wires: 4 180 VA 180 VA 360 VA 720 VA 180 VA 180 VA 10 VA 180 VA 10 VA 0 VA	864 2174 2174 2174 2174 2174 2174 20 </td <td>O VA O VA I I</td> <td>es Trip 20 A 20 A</td> <td>Total Conn. Load: 42120 VA Total Est. Demand: 30380 VA Total Est. Demand: 84 A Total Est. Demand: 84 A Image: Complex Stress Stress</td>	O VA I I	es Trip 20 A 20 A	Total Conn. Load: 42120 VA Total Est. Demand: 30380 VA Total Est. Demand: 84 A Total Est. Demand: 84 A Image: Complex Stress
Other Receptacle Receptacle Notes: Notes: Receptacle Notes: Receptacle Receptacle Receptacle Receptacle Notes: Receptacle Receptacle<	Eification Branch Panel: 2RC Location: Supply From: RC Mounting: SURFACE Enclosure: NEMA 1 Circuit Description RCPT. TRAINING RM.F D131 - ALT #1 DEO PROJECTOR TRAINING RM. D131 - AL DOR BOX TRAINING RM. D131 - ALT #1 SPLAY WALL BOX TRAINING RM. D131 - AL RCPT. TRAINING RM. B1 C107 - ALT #2 PEO PROJ. TRAINING RM. B1 C107 - ALT #2 DEO PROJ. TRAINING RM. B1 C107 - ALT #2 DEO PROJ. TRAINING RM. B1 C107 - ALT #2 DOR BOX TRAINING RM. B1 C107 - ALT #2 DEO PROJ. TRAINING RM. B1 C107 - ALT #2 DEO PROJ. TRAINING RM. B1 C107 - ALT #2 DEO PROJ. TRAINING RM. B1 C107 - ALT #2 DEO PROJ. TRAINING RM. B1 C107 - ALT #2 DEO PROJ. TRAINING RM. B1 C107 - ALT #2 DEO PROJ. TRAINING RM. D1 C109 - ALT #2 DOR BOX TRAINING RM. D1 C109 - ALT #3 RCPT. OFFICE A101 - ALT #3 RCPT. OFFICE A107 - ALT #3 RCPT. OFFICE A107 - ALT #3 RCPT. FILE RM. A111 - ALT #3 ARE ARE ARE	Image: Constant set set set set set set set set set se	B640 V/ 3480 V 340 V 340 V 340 V	A I A I I I	100.00% 1 64.93% 1 - 1 - - - - - - - - - - - - - - - - - - - - Phases: 3 Wires: 4 180 VA 180 VA 180 VA 180 VA 180 VA 180 VA 180 VA 180 VA 720 VA 720 VA	864 2174 <tr< td=""><td>O VA 0 VA 1 VA</td><td>es Trip 20 A 20 A</td><td>Total Conn. Load: 42120 VA Total Est. Demand: 30380 VA Total Est. Demand: 84 A Total Est. Demand: 84 A Image: Complex compl</td></tr<>	O VA 0 VA 1 VA	es Trip 20 A 20 A	Total Conn. Load: 42120 VA Total Est. Demand: 30380 VA Total Est. Demand: 84 A Total Est. Demand: 84 A Image: Complex compl
Other Receptacle Receptacle Notes: Notes: Notes: CKT 1 IG 3 VII 5 FL 7 DIS 9 IG 11 IG 3 VII 5 FL 7 DIS 9 IG 11 IG 33 IG 13 IG 141 IG 33 IG 31 IG 33 IG 341 SP 39 SP 41 SP Legend: Eload Class	Eification Branch Panel: 2RC Location: Supply From: RC Mounting: SURFACE Enclosure: NEMA 1 Circuit Description RCPT. TRAINING RM.F D131 - ALT #1 DEO PROJECTOR TRAINING RM. D131 - AL DOR BOX TRAINING RM. D131 - ALT #1 SPLAY WALL BOX TRAINING RM. D131 - AL RCPT. TRAINING RM. B1 C107 - ALT #2 PEO PROJ. TRAINING RM. B1 C107 - ALT #2 DEO PROJ. TRAINING RM. B1 C107 - ALT #2 DEO PROJ. TRAINING RM. B1 C107 - ALT #2 DOR BOX TRAINING RM. B1 C107 - ALT #2 DEO PROJ. TRAINING RM. B1 C107 - ALT #2 DEO PROJ. TRAINING RM. B1 C107 - ALT #2 DEO PROJ. TRAINING RM. B1 C107 - ALT #2 DEO PROJ. TRAINING RM. B1 C107 - ALT #2 DEO PROJ. TRAINING RM. B1 C107 - ALT #2 DEO PROJ. TRAINING RM. D1 C109 - ALT #2 DOR BOX TRAINING RM. D1 C109 - ALT #3 RCPT. OFFICE A101 - ALT #3 RCPT. OFFICE A107 - ALT #3 RCPT. OFFICE A107 - ALT #3 RCPT. FILE RM. A111 - ALT #3 ARE ARE ARE	Image: Constant set set set set set set set set set se	B640 V/ 3480 V 3480 V 90105 1 1 1 1 1 1 1 1 1 1 1 1 1 1 1 1 1 1	A I A I I I	100.00% 1 64.93% 1 - 1 - 1 - 1 - 1 - 1 - 1 - 1 - 1 - 1 - 1 - 1 Phases: 3 Wires: 4 180 VA 180 VA 180 VA 0 VA 180 VA 0 VA 180 VA 0 VA 180 VA<	864 2174 <tr< td=""><td>O VA 0 I VA 1 VA</td><td>es Trip 20 A 20 A</td><td>Total Conn. Load: 42120 VA Total Est. Demand: 3030 VA Total Est. Demand: 117 A Total Est. Demand: 84 A Image: Strate S</td></tr<>	O VA 0 I VA 1 VA	es Trip 20 A 20 A	Total Conn. Load: 42120 VA Total Est. Demand: 3030 VA Total Est. Demand: 117 A Total Est. Demand: 84 A Image: Strate S
Other Receptacle Receptacle Notes: Notes: Receptacle Notes: Receptacle Receptacle Notes: Receptacle Receptacle Receptacle Notes: Receptacle	Eification Branch Panel: 2RC Location: Supply From: RC Mounting: SURFACE Enclosure: NEMA 1 Circuit Description RCPT. TRAINING RM.F D131 - ALT #1 DEO PROJECTOR TRAINING RM. D131 - AL DOR BOX TRAINING RM. D131 - ALT #1 SPLAY WALL BOX TRAINING RM. D131 - AL RCPT. TRAINING RM. B1 C107 - ALT #2 PEO PROJ. TRAINING RM. B1 C107 - ALT #2 DEO PROJ. TRAINING RM. B1 C107 - ALT #2 DEO PROJ. TRAINING RM. B1 C107 - ALT #2 DOR BOX TRAINING RM. B1 C107 - ALT #2 DEO PROJ. TRAINING RM. B1 C107 - ALT #2 DEO PROJ. TRAINING RM. B1 C107 - ALT #2 DEO PROJ. TRAINING RM. B1 C107 - ALT #2 DEO PROJ. TRAINING RM. B1 C107 - ALT #2 DEO PROJ. TRAINING RM. B1 C107 - ALT #2 DEO PROJ. TRAINING RM. D1 C109 - ALT #2 DOR BOX TRAINING RM. D1 C109 - ALT #3 RCPT. OFFICE A101 - ALT #3 RCPT. OFFICE A107 - ALT #3 RCPT. OFFICE A107 - ALT #3 RCPT. FILE RM. A111 - ALT #3 ARE ARE ARE	Image: Constant set set set set set set set set set se	B640 V/ 3480 V 340 V 340 V 340 V	A I A I I I	100.00% 1 64.93% 1 - 1 - - - - - - - - - - - - - - - - - - - - Phases: 3 Wires: 4 180 VA 180 VA 180 VA 180 VA 180 VA 180 VA 180 VA 180 VA 720 VA 720 VA	864 2174 <tr< td=""><td>O VA 0 VA 1 VA</td><td>es Trip 20 A 20 A</td><td>Total Conn. Load: 42120 VA Total Est. Demand: 30380 VA Total Est. Demand: 84 A Total Est. Demand: 84 A Al.C. Rating: 10,000 Mains Type: COPPER Mains Rating: 150 A MCB Rating: 150 A MCB Rating: 150 A MCB Rating: 150 A MCB Rating: 150 A IG RCPT. TRAINING RM. G D132 - ALT #1 VIDEO PROJECTOR TRAINING RM. D132 - AL. FLOOR BOX TRAINING RM. D132 - ALT #1 DISPLAY WALL BOX TRAINING RM. D132 - AL. IG RCPT. TRAINING RM. A1 C106 - ALT #2 IG RCPT. TRAINING RM. A1 C106 - ALT #2 VIDEO PROJ. TRAINING RM. A1 C106 - ALT #2 VIDEO PROJ. TRAINING RM. C1 C108 - ALT #2 VIDEO PROJ. TRAINING RM. A1 C106 - ALT #2 FLOOR BOX TRAINING RM. C1 C108 ALT #2 PLOOR BOX TRAINING RM. C1 C108 ALT #2 IG RCPT. OFFICE A100 - ALT #3 IG RCPT. OFFICE A100 - ALT #3</td></tr<>	O VA 0 VA 1 VA	es Trip 20 A 20 A	Total Conn. Load: 42120 VA Total Est. Demand: 30380 VA Total Est. Demand: 84 A Total Est. Demand: 84 A Al.C. Rating: 10,000 Mains Type: COPPER Mains Rating: 150 A MCB Rating: 150 A MCB Rating: 150 A MCB Rating: 150 A MCB Rating: 150 A IG RCPT. TRAINING RM. G D132 - ALT #1 VIDEO PROJECTOR TRAINING RM. D132 - AL. FLOOR BOX TRAINING RM. D132 - ALT #1 DISPLAY WALL BOX TRAINING RM. D132 - AL. IG RCPT. TRAINING RM. A1 C106 - ALT #2 IG RCPT. TRAINING RM. A1 C106 - ALT #2 VIDEO PROJ. TRAINING RM. A1 C106 - ALT #2 VIDEO PROJ. TRAINING RM. C1 C108 - ALT #2 VIDEO PROJ. TRAINING RM. A1 C106 - ALT #2 FLOOR BOX TRAINING RM. C1 C108 ALT #2 PLOOR BOX TRAINING RM. C1 C108 ALT #2 IG RCPT. OFFICE A100 - ALT #3
Other Receptacle I I Notes: Notes: I <	Eification Branch Panel: 2RC Location: Supply From: RC Mounting: SURFACE Enclosure: NEMA 1 Circuit Description RCPT. TRAINING RM.F D131 - ALT #1 DEO PROJECTOR TRAINING RM. D131 - AL DOR BOX TRAINING RM. D131 - ALT #1 SPLAY WALL BOX TRAINING RM. D131 - AL RCPT. TRAINING RM. B1 C107 - ALT #2 PEO PROJ. TRAINING RM. B1 C107 - ALT #2 DEO PROJ. TRAINING RM. B1 C107 - ALT #2 DEO PROJ. TRAINING RM. B1 C107 - ALT #2 DOR BOX TRAINING RM. B1 C107 - ALT #2 DEO PROJ. TRAINING RM. B1 C107 - ALT #2 DEO PROJ. TRAINING RM. B1 C107 - ALT #2 DEO PROJ. TRAINING RM. B1 C107 - ALT #2 DEO PROJ. TRAINING RM. B1 C107 - ALT #2 DEO PROJ. TRAINING RM. B1 C107 - ALT #2 DEO PROJ. TRAINING RM. D1 C109 - ALT #2 DOR BOX TRAINING RM. D1 C109 - ALT #3 RCPT. OFFICE A101 - ALT #3 RCPT. OFFICE A107 - ALT #3 RCPT. OFFICE A107 - ALT #3 RCPT. FILE RM. A111 - ALT #3 ARE ARE ARE	Image: Constant set set set set set set set set set se	B640 V/ 3480 V 340 V 340 V 340 V	A I A I I I	100.00% 1 64.93% 1 - 1 - - - - - - - - - - - - - - - - - - - - Phases: 3 Wires: 4 180 VA 180 VA 180 VA 180 VA 180 VA 180 VA 180 VA 180 VA 720 VA 720 VA	864 2174 <tr< td=""><td>O VA 0 VA 1 VA</td><td>es Trip 20 A 20 A</td><td>Total Conn. Load: 42120 VA Total Est. Demand: 3030 VA Total Est. Demand: 84 A Image: Strate Strat</td></tr<>	O VA 0 VA 1 VA	es Trip 20 A 20 A	Total Conn. Load: 42120 VA Total Est. Demand: 3030 VA Total Est. Demand: 84 A Image: Strate Strat
Other Receptacle Receptacle Notes: Notes: Receptacle Notes: Receptacle	Eification Branch Panel: 2RC Location: Supply From: RC Mounting: SURFACE Enclosure: NEMA 1 Circuit Description RCPT. TRAINING RM.F D131 - ALT #1 DEO PROJECTOR TRAINING RM. D131 - AL DOR BOX TRAINING RM. D131 - ALT #1 SPLAY WALL BOX TRAINING RM. D131 - AL RCPT. TRAINING RM. B1 C107 - ALT #2 PEO PROJ. TRAINING RM. B1 C107 - ALT #2 DEO PROJ. TRAINING RM. B1 C107 - ALT #2 DEO PROJ. TRAINING RM. B1 C107 - ALT #2 DOR BOX TRAINING RM. B1 C107 - ALT #2 DEO PROJ. TRAINING RM. B1 C107 - ALT #2 DEO PROJ. TRAINING RM. B1 C107 - ALT #2 DEO PROJ. TRAINING RM. B1 C107 - ALT #2 DEO PROJ. TRAINING RM. B1 C107 - ALT #2 DEO PROJ. TRAINING RM. B1 C107 - ALT #2 DEO PROJ. TRAINING RM. D1 C109 - ALT #2 DOR BOX TRAINING RM. D1 C109 - ALT #3 RCPT. OFFICE A101 - ALT #3 RCPT. OFFICE A107 - ALT #3 RCPT. OFFICE A107 - ALT #3 RCPT. FILE RM. A111 - ALT #3 ARE ARE ARE	Image: Constant state s	B640 V/ 3480 V 340 V 340 V 340 V	A I A I I I	100.00% 1 64.93% 1 - 1 - - - - - - - - - - - - - - - - - - - - Phases: 3 Wires: 4 180 VA 180 VA 180 VA 180 VA 180 VA 180 VA 180 VA 180 VA 720 VA 720 VA	864 2174 <tr< td=""><td>O VA 0 VA 1 VA</td><td>es Trip 20 A 20 A</td><td>Total Conn. Load: 42120 VA Total Est. Demand: 30380 VA Total Est. Demand: 84 A Image: Strate Stra</td></tr<>	O VA 0 VA 1 VA	es Trip 20 A 20 A	Total Conn. Load: 42120 VA Total Est. Demand: 30380 VA Total Est. Demand: 84 A Image: Strate Stra
Other Receptacle Receptacle Notes: Notes: Notes: Receptacle Notes: Receptacle I	Eification Branch Panel: 2RC Location: Supply From: RC Mounting: SURFACE Enclosure: NEMA 1 Circuit Description RCPT. TRAINING RM.F D131 - ALT #1 DEO PROJECTOR TRAINING RM. D131 - AL DOR BOX TRAINING RM. D131 - ALT #1 SPLAY WALL BOX TRAINING RM. D131 - AL RCPT. TRAINING RM. B1 C107 - ALT #2 PEO PROJ. TRAINING RM. B1 C107 - ALT #2 DEO PROJ. TRAINING RM. B1 C107 - ALT #2 DEO PROJ. TRAINING RM. B1 C107 - ALT #2 DOR BOX TRAINING RM. B1 C107 - ALT #2 DEO PROJ. TRAINING RM. B1 C107 - ALT #2 DEO PROJ. TRAINING RM. B1 C107 - ALT #2 DEO PROJ. TRAINING RM. B1 C107 - ALT #2 DEO PROJ. TRAINING RM. B1 C107 - ALT #2 DEO PROJ. TRAINING RM. B1 C107 - ALT #2 DEO PROJ. TRAINING RM. D1 C109 - ALT #2 DOR BOX TRAINING RM. D1 C109 - ALT #3 RCPT. OFFICE A101 - ALT #3 RCPT. OFFICE A107 - ALT #3 RCPT. OFFICE A107 - ALT #3 RCPT. FILE RM. A111 - ALT #3 ARE ARE ARE	Image: Constant state s	B640 V/ 3480 V 340 V 340 V 340 V	A I A I I I	100.00% 1 64.93% 1 - 1 - - - - - - - - - - - - - - - - - - - - Phases: 3 Wires: 4 180 VA 180 VA 180 VA 180 VA 180 VA 180 VA 180 VA 180 VA 720 VA 720 VA	864 2174 <tr< td=""><td>O VA 0 VA 1 VA</td><td>es Trip 20 A 20 A</td><td>Total Conn. Load: 42120 VA Total Est. Demand: 30380 VA Total Est. Demand: 84 A Total Est. Demand: 84 A Al.C. Rating: 10,000 Mains Type: COPPER Mains Rating: 150 A MCB Rating: 150 A MCB Rating: 150 A MCB Rating: 150 A IG RCPT. TRAINING RM. G D132 - ALT #1 VIDEO PROJECTOR TRAINING RM. D132 - AL FLOOR BOX TRAINING RM. D132 - ALT #1 DISPLAY WALL BOX TRAINING RM. D132 - ALT #2 IG RCPT. TRAINING RM. A1 C106 - ALT #2 IG RCPT. TRAINING RM. A1 C106 - ALT #2 VIDEO PROJ. TRAINING RM. A1 C106 - ALT #2 VIDEO PROJ. TRAINING RM. A1 C106 - ALT #2 VIDEO PROJ. TRAINING RM. A1 C106 ALT #2 VIDEO PROJ. TRAINING RM. A1 C106 ALT #2 VIDEO PROJ. TRAINING RM. C1 C108 ALT #2 IG RCPT. OFFICE A100 - ALT #3 IG RCPT. OFFICE A100 - ALT #3 IG RCPT. OFFICE A108 - ALT #3</td></tr<>	O VA 0 VA 1 VA	es Trip 20 A 20 A	Total Conn. Load: 42120 VA Total Est. Demand: 30380 VA Total Est. Demand: 84 A Total Est. Demand: 84 A Al.C. Rating: 10,000 Mains Type: COPPER Mains Rating: 150 A MCB Rating: 150 A MCB Rating: 150 A MCB Rating: 150 A IG RCPT. TRAINING RM. G D132 - ALT #1 VIDEO PROJECTOR TRAINING RM. D132 - AL FLOOR BOX TRAINING RM. D132 - ALT #1 DISPLAY WALL BOX TRAINING RM. D132 - ALT #2 IG RCPT. TRAINING RM. A1 C106 - ALT #2 IG RCPT. TRAINING RM. A1 C106 - ALT #2 VIDEO PROJ. TRAINING RM. A1 C106 - ALT #2 VIDEO PROJ. TRAINING RM. A1 C106 - ALT #2 VIDEO PROJ. TRAINING RM. A1 C106 ALT #2 VIDEO PROJ. TRAINING RM. A1 C106 ALT #2 VIDEO PROJ. TRAINING RM. C1 C108 ALT #2 IG RCPT. OFFICE A100 - ALT #3 IG RCPT. OFFICE A100 - ALT #3 IG RCPT. OFFICE A108 - ALT #3

	Branch Panel: RF Location: MECH. D126 Supply From: XFMR RF Mounting: Surface Enclosure: Type 1		Volts:120/208 WyeA.I.C. Rating:Phases:3Mains Type:COPPERWires:4Mains Rating:150 AMCB Rating:150 A												
otes:															
	Circuit Description FLOOR BOX TRAINING ROOM A D113	Trip 20 A	Poles		A 720 VA		B	C	;	Poles	Trip 20 A	Circuit De		2 CKT	
3	FLOOR BOX TRAINING ROOM A D113	20 A 20 A	1	720 VA	720 VA	-	720 VA			1		FLOOR BOX TRAINING		4	
5	FLOOR BOX TRAINING ROOM A D113	20 A	1			720 VA	720 VA	720 VA	720 \/A	1		FLOOR BOX TRAINING		6	
7	FLOOR BOX TRAINING ROOM A D113	20 A	1	720 \/A	720 VA			720 VA	720 VA	1		FLOOR BOX TRAINING		8	
9	FLOOR BOX TRAINING ROOM B D115	20 A	1	120 11	120 01	-	720 VA			1		FLOOR BOX TRAINING		10	
11	FLOOR BOX TRAINING ROOM B D115	20 A	1			120 171	120 171	720 VA	720 VA	1		FLOOR BOX TRAINING		12	
13	FLOOR BOX TRAINING ROOM B D115	20 A	1	720 VA	720 VA					1		FLOOR BOX TRAINING		14	
15	FLOOR BOX TRAINING ROOM B D115	20 A	1				720 VA			1		FLOOR BOX TRAINING		16	
17	FLOOR BOX TRAINING ROOM C D114	20 A	1					720 VA	720 VA	1		FLOOR BOX TRAINING		18	
19	FLOOR BOX TRAINING ROOM C D114	20 A	1	720 VA	720 VA					1		FLOOR BOX TRAINING		20	
21	FLOOR BOX TRAINING ROOM C D114	20 A	1				720 VA			1	20 A	FLOOR BOX TRAINING	ROOM C D114	22	
23	FLOOR BOX TRAINING ROOM C D114	20 A	1					720 VA	720 VA	1	20 A	FLOOR BOX TRAINING	ROOM C D114	24	
25	FLOOR BOX TRAINING ROOM D D116	20 A	1	720 VA	720 VA					1	20 A	FLOOR BOX TRAINING	ROOM D D116	26	
27	FLOOR BOX TRAINING ROOM D D116	20 A	1			720 VA	720 VA			1	20 A	FLOOR BOX TRAINING	ROOM D D116	28	
29	FLOOR BOX TRAINING ROOM D D116	20 A	1					720 VA	720 VA	1	20 A	FLOOR BOX TRAINING	ROOM D D116	30	
31	FLOOR BOX TRAINING ROOM D D116	20 A	1	720 VA	720 VA					1	20 A	FLOOR BOX TRAINING	ROOM D D116	32	
33	FLOOR BOX TRAINING ROOM E D117	20 A	1			720 VA	720 VA			1	20 A	FLOOR BOX TRAINING	ROOM E D117	34	
35	FLOOR BOX TRAINING ROOM E D117	20 A	1					720 VA	720 VA	1		FLOOR BOX TRAINING		36	
37	FLOOR BOX TRAINING ROOM E D117	20 A	1	720 VA	720 VA					1		FLOOR BOX TRAINING		38	
39	FLOOR BOX TRAINING ROOM E D117	20 A	1			720 VA	720 VA			1		FLOOR BOX TRAINING		40	
41	FLOOR BOX TRAINING ROOM E D117	20 A	1					720 VA	720 VA	1		FLOOR BOX TRAINING		42	
43		20 A	1	720 VA	720 VA		700.) (4			1		FLOOR BOX TRAINING		44	
45 47	FLOOR BOX TRAINING ROOM E D117 SPARE	20 A 20 A	1			720 VA	720 VA	0 VA	0 VA	1		FLOOR BOX TRAINING		46	
49	SPARE	20 A	1	0 VA	0 VA			0 0 7		1		SPARE		50	
51	SPARE	20 A	1		0 111	0 VA	0 VA			1		SPARE		52	
53	SPARE	20 A	1					0 VA	0 VA	1		SPARE		54	
55	SPARE	20 A	1	0 VA	0 VA					1	20 A	SPARE		56	
57	SPARE	20 A	1			0 VA	0 VA			1	20 A	SPARE		58	
59	SPARE	20 A	1					0 VA	0 VA	1	20 A	SPARE		60	
61	SPARE	20 A	1	0 VA	0 VA					1	20 A	SPARE		62	
63	SPARE	20 A	1			0 VA	0 VA			1	20 A	SPARE		64	
65	SPARE	20 A	1					0 VA	0 VA	1	20 A	SPARE		66	
67	SPARE	20 A	1	0 VA	0 VA					1		SPARE		68	
69	SPARE	20 A	1			0 VA	0 VA			1		SPARE		70	
71	SPARE	20 A	1		A 1 1			0 VA	0 VA	1		SPARE		72	
73	SPARE	20 A	1	0 VA	0 VA	0.1/4	0.1/4			1		SPARE		74	
75 77	SPARE SPARE	20 A 20 A	1			0 VA	0 VA	0 VA	0 VA	1		SPARE SPARE		76	
79	SPARE	20 A 20 A	1	0 VA	0 VA			UVA	UVA	1		SPARE		80	
79 81	SPARE	20 A 20 A	1	UVA	UVA	0 VA	0 VA			1		SPARE		80	
83	SPARE	20 A	1			JIA		0 VA	0 VA	1		SPARE		84	
	1		al Load:	1152	20 VA	1152	20 VA	1008		•					
		Tota	I Amps:	98	3 A	98	3 A	84	A						
egeno															
	1	-			-		-4 -		-4				T _4_1-		
. oad C Other	lassification		nected 33120 V			mand Fa			ated De 33120 VA			Panel	Totals		
				•			-			•		Total Conn. Load:	33120 VA		
												Total Est. Demand:			
												Total Conn.: Total Est. Demand:			
		1			1			1				. eta: Let. Demanu.			

<u>REVISIONS:</u>

1. 19.03.18 ADDENDUM #4. ADDITION OF ELECTRICAL PANEL "RF" FOR ADDITIONAL FLOOR BOXES AT TRAININGS.



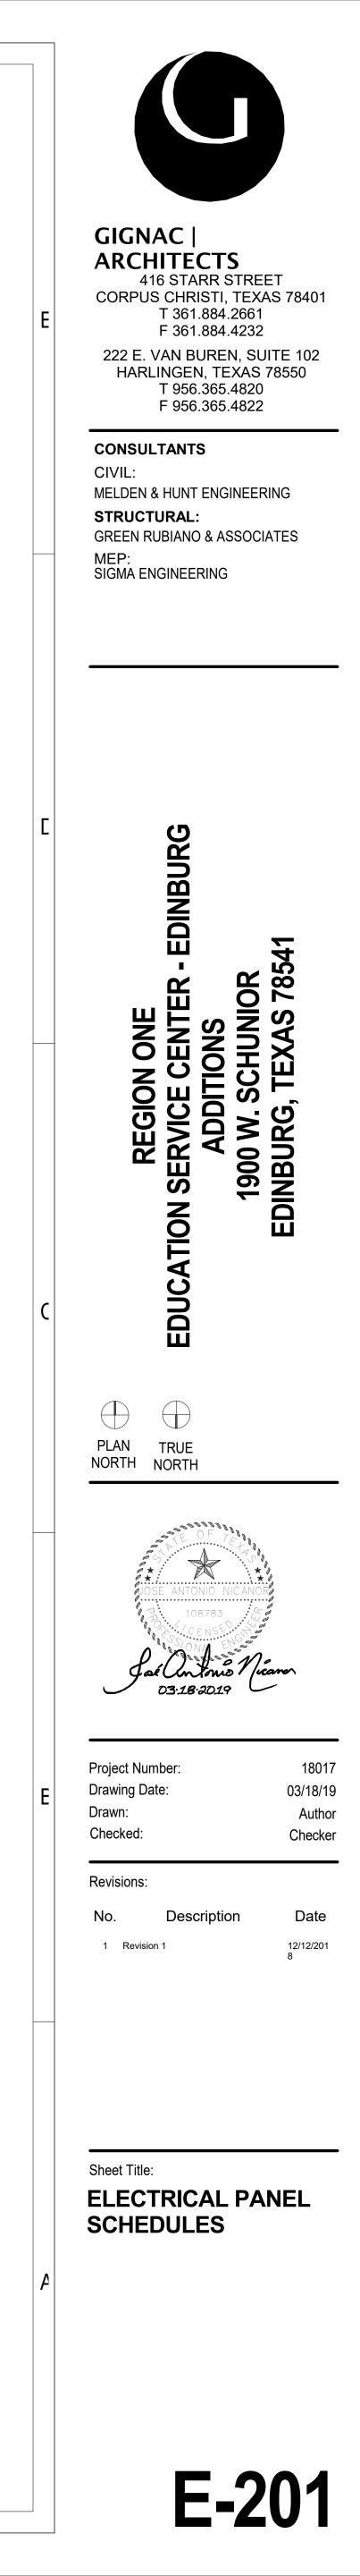

			LIGHT		RE SCHED					
	LIGHT FIXTURE SCHEDULE									
	TYPE MANUF.	CATALOG No.	MOUNTING	ТҮРЕ	COLOR	LUMENS	- VOLTAGE	INPUT W	DESCRIPTION	
	A EATON - METALUX	24FP4735C	RECESSED	LED	3500К	4990	UNV	41	2X4 FLAT PANEL TROFFER	
	AE EATON - METALUX	24FP4735C-EL14W	RECESSED	LED	3500К	4990	UNV	41	2X4 FLAT PANEL TROFFER WITH BATTERY BACK UP	
	A2 EATON - METALUX	24FP6435C	RECESSED	LED	3500К	6602	UNV	59	2X4 FLAT PANEL TROFFER	
	A2E EATON - METALUX	24FP6435C-EL14W	RECESSED	LED	3500К	6602	UNV	59	2X4 FLAT PANEL TROFFER WITH BATTERY BACK UP	
	B EATON - METALUX	22FP3235C	RECESSED	LED	3500К	3417	UNV	30	2X2 FLAT PANEL TROFFER	
	BE EATON - METALUX	22FP3235C-EL14W	RECESSED	LED	3500К	34717	UNV	30	2X2 FLAT PANEL TROFFER WITH BATTERY BACK UP	
	BG EATON - METALUX	22FP3235C-DF-22W-U	RECESSED	LED	3500К	3417	UNV	30	2X2 FLAT PANEL TROFFER	
	BGE EATON - METALUX	22FP3235C-DF-22W-U-EL14W	RECESSED	LED	3500К	3417	UNV	30	2X2 FLAT PANEL TROFFER WITH BATTERY BACK UP	
	D1 EATON - PORTFOLIO	LDSQ4B15D010 EU4B10208035 4LBSQ2H	RECESSED	LED	3500К	1500	UNV	16	4" SQUARE DOWNLIGHT	
	D1E EATON - PORTFOLIO	LDSQ4B15D010 EU4B10208035 4LBSQ2H-EM14	RECESSED	LED	3500К	1500	UNV	16	4" SQUARE DOWNLIGHT WITH BATTERY BACK UP	
	D2 EATON - PORTFOLIO	LDSQ4B30D010 EU4B30408035 4LBSQ2H	RECESSED	LED	3500К	3000	UNV	28	4" SQUARE DOWNLIGHT	
	D2E EATON - PORTFOLIO	LDSQ4B30D010 EU4B30408035 4LBSQ2H-EM14	RECESSED	LED	3500К	3000	UNV	28	4" SQUARE DOWNLIGHT WITH BATTERY BACK UP	
	F1 EATON - METALUX	4SNLED-LD5-65HL-LW-UNV-L835-CD1-U	SURFACE	LED	3500К	6500	UNV	62	4' LINEAR STRIP LIGHT WIDE LIGHT DISTRIBUTION	
	F1E EATON - METALUX	4SNLED-LD5-65HL-LW-UNV-L835-CD1-U-EL14W	SURFACE	LED	3500К	6500	UNV	62	4' LINEAR STRIP LIGHT WITH WIDE LIGHT DISTRIBUTION AND BATTERY BACK UP	
	F2 EATON - METALUX	4SNLED-LD5-64SL-LW-UNV-L835-CD1-U	SURFACE	LED	3500К	6400	UNV	55	4' LINEAR STRIP LIGHT WITH NARROW LIGHT DISTRIBUTION	
	F2E EATON - METALUX	4SNLED-LD5-64SL-LW-UNV-L835-CD1-U-EL14W	SURFACE	LED	3500К	6400	UNV	55	4' LINEAR STRIP LIGHT WITH NARROW LIGHT DISTRIBUTION AND BATTERY BACK UP	
	G EATON - PORTFOLIO	LSSQS4B30D010MB EC4B30508035 4LBSQ0H AC4120MB	PENDANT	LED	3500К	3040	UNV	28	4" SQUARE CYLINDER PENDANT WITH 3000 LUMEN DOWNLIGHT	
	H ALIGHT	D9-MX-LS-35-U-HE-XX-B-D	COVE	LED	3500К	414	UNV	5 /FT	3.5" WIDE LINEAR COVE LIGHT FOR RESTROOM. CONTRACTOR TO VERIFY RUN LENGTHS	
	L ALIGHT	D3-XX-LS-35-UNV-KS-XX-B-D	PENDANT	LED	3500К	414	UNV	5 /FT	3.5" WIDE LINEAR WALL WASH PENDANT. CONTRACTOR TO VERIFY RUN LENGTHS	
	P28 CAMMAN	P8800-24-LN-35K-CLV-MV-BA-STEM	PENDANT	LED	3500К	1450	UNV	20	4" WIDE 28" LONG DECORATIVE ACRYLIC PENDANT	
	P36 CAMMAN	P8800-36-LN-35K-CLV-MV-BA-STEM	PENDANT	LED	3500К	2300	UNV	30	4" WIDE 36" LONG DECORATIVE ACRYLIC PENDANT	
	P40 CAMMAN	P874340	PENDANT	LED	3500К	4475	UNV	73	6" WIDE 40" LONG DECORATIVE ACRYLIC PENDANT	
	P60 CAMMAN	P8800-60-LN-35K-CLV-MV-BA-STEM	PENDANT	LED	3500К	4400	UNV	50	4" WIDE 60" LONG DECORATIVE ACRYLIC PENDANT	
	S WAC LIGHTING	PD-29803-AL	PENDANT	LED	3000K	4938	UNV	42	DECORATIVE CHANDELIER WITH 3 BARS	
Ś	S2 HERMES	MIR-31-SBC	PENDANT	LED	3000К	-		-		
	V WAC LIGHTING	WS-99830-CH	VANITY	LED	3000К	2583	120	28	BATHROOM VANITY	
	X EATON - SURELITES	EUX7	SURFACE	LED	-	-	UNV	-	UNIVERSAL EDGE LIT EXIT SIGN	

EXTERIOR LIGHT FIXTURE SCHEDULE										
TYPE	MANUF.	CATALOG No.	MOUNTING -			VOLTAGE	INPUT W	DESCRIPTION		
				TYPE	COLOR	VOLTAGE		DESCRIPTION		
1AA	EATON - MCGRAW EDISON	GLEON-AF-04-LED-E1-T4W-XX	POLE	LED	4000K	UNV	225	4 SQUARE GALLEON SITE LIGHT WITH TYPE 4 LIGHT DISTRIBUTION		
4AA	EATON - MCGRAW EDISON	GLEON-AF-04-LED-E1-T4W-XX	POLE	LED	4000K	UNV	(4) 225	4 SQUARE GALLEON SITE LIGHT WITH TYPE 4 LIGHT DISTRIBUTION		
EG	LIGMAN	UVA-20001-39W-W40-XX-120/277	POLE	LED	4000K	UNV	39	DECORATIVE AREA LIGHT		
EJ	EATON - PORTFOLIO	LD8B-60-D010-4000-ER8B-5070-8040-8LB-M-2-H-HSA8-LGSKT81P65	RECESSED	LED	4000K	UNV	40	CANOPY LIGHT		
EK	LIGMAN	UKI-60731-M-W40-120/277	GROUND	LED	4000K	UNV	12	INGRADE UPLIGHT		
WW	EATON - MCGRAW EDISON	GWC-AF-01-LED-E1-T2	MOUNTED	LED	4000K	UNV	59	WALL PACK		

C:\Users\SigmaHNe_KA\I 12/21/2018 1:32:04 PM

		LS SHOWN MAY NOT APPEAR E SHOWN SCHEMATIC AND M					
SYMBOL	DESCRIPTION	MNTG. HT. UNO (SEE NOTE 1)	SYMBOL	DESCRIPTION	MNTG. HT. UN (SEE NOTE 1		
	POWER			FIRE ALARM			
Ð	DUPLEX RECEPTACLE - 20A/125V/1P/3W/G	15" AFF	F	FIRE ALARM VOICE EVACUATION SPEAKER.	-		
\$	DUPLEX RECEPTACLE, 20A, GROUND FAULT INTERCEPTOR; C = CEILING MOUNTED.	15" AFF	F	FIRE ALARM PULL STATION	48" AFF		
€	DUPLEX RECEPTACLE, 20A, INSULATED GROUND DEVICE WITH ISOLATED GROUNDING CONDUCTOR; CLG = CEILING MOUNTED.	15" AFF	F	FIRE ALARM AUDIBLE/VISUAL SIGNAL; WP = WEATHER PROOF; S = WITH INTEGRAL VOICE ACTIVATED SPEAKER.	80" AFF		
+	QUADPLEX RECEPTACLE, 20A, GROUND FAULT INTERCEPTOR; CLG = CEILING MOUNTED.	AS REQD.	F	FIRE ALARM AUDIBLE SIGNAL; WP = WEATHER PROOF; S = WITH INTEGRAL VOICE ACTIVATED SPEAKER.	80" AFF		
+	QUADPLEX RECEPTACLE, 20A, INSULATED GROUND DEVICE WITH INSULATED GROUNDING CONDUCTOR; CLG = CEILING MOUNTED.	AS REQD.	F	FIRE ALARM VISUAL SIGNAL; WP = WEATHER PROOF; S = WITH INTEGRAL VOICE ACTIVATED SPEAKER.	80" AFF		
€E	DUPLEX RECEPTACLE ON EMERGENCY CIRCUIT	AS REQD.					
\otimes	SPECIAL PURPOSE RECEPTACLE; MOTOR OR EQUIPMENT CONNECTION	AS REQD.					
H) ()	JUNCTION BOX - SIZE & MOUNTING AS REQUIRED	15" AFF	FS	FIRE ALARM SPRINKLER FLOW SWITCH	-		
			TS	FIRE ALARM SPRINKLER TAMPER SWITCH	-		
		_	S	FIRE ALARM SMOKE DETECTOR CEILING OR WALL MOUNTED	80" AFF		
		_	H	HEAT DETECTOR CEILING OR WALL MOUNTED	-		
				DUCT SMOKE DETECTOR	AS REQD.		
		_	FACP	FIRE ALARM CONTROL PANEL	AS REQD.		
			FAAP	FIRE ALARM ANNUNCIATOR PANEL	AS REQD.		
b 30/-/3	DISCONNECT SWITCH - 30/-/3 INDICATES 30A, 3-POLE, NONFUSED; 30/30/3 INDICATES 30A, 3-POLE, 30A FUSE	AS REQD.	FAEP	FIRE ALARM EXTENDING PANEL	AS REQD.		
св 🖞 30/3	CIRCUIT BREAKER DISCONNECT SWITCH - THERMAL MAGNETIC CB IN NEMA 1 ENCL; AMPS/POLES AS INDICATED	AS REQD.	VAFP	VOICE ACTIVATED FIRE ALARM PANEL	80" AFF		
⊿ 30/30/3	DISCONNECT SWITCH - 30/30/3 INDICATES 30A, 3-POLE, 30A FUSE	AS REQD.	g	SWITCH			
2	MOTOR STARTER FVNR UNO; NUMBER INDICATES NEMA SIZE	AS REQD.	\$3	3 WAY LIGHT SWITCH			
CB 🛛 🖓	COMBINATION MOTOR CONTROLLER/DISCONNECT SWITCH	AS REQD.					
	PANELBOARD	-		GENERAL ABBREVIATIONS			
\wedge	MOTOR	-		BACK SPLASH NC (N.C.) NORMALLY CLOSED			
~	SINGLE LINE CONTINUATION	-		FINISHED FLOOR NIC NOT IN CONTRACT / FINISHED CEILING NL NIGHT LIGHT			
GAAP	GENERATOR ANNUNCIATOR PANEL	-	CB CIRCUI	CB CIRCUIT BREAKER NO (N.O.) NORMALLY OPEN CLG CEILING PNL PANEL EC EMPTY CONDUIT RCPT(S) RECEPTACLE(S) EP ELECTRICAL PRIMARY SD SDAPE			
Х,Х,Х	THREE SINGLE POLE DEVICE CIRCUIT NUMBERS	-	EP ELECTR				
X/X/X	MULTI-POLE DEVICE CIRCUIT NUMBERS	_	F FUSE	SPD SURGE PROTECTION ST (S.T.) SHUNT TRIP	DEVICE		
			GFI GROUN HCC HORIZO	ID FAULT INTERRUPTER SW SWITCH ONTAL CROSS CONNECT US UNDERSLOOP			
			ICC INTERN	MEDIATE CROSS CONNECT UG UNDERGROUND TED GROUND UNLESS NOTED OTH	ERWISE		
				T OR MOUNTED WG WIRE GUARD WP WEATHERPROOF			
				XFMR TRANSFORMER			
	TRANSFORMER	-					

REVISION:

1. 19.03.18 ADDENDUM #4. REVISION TO LIGHT FIXTURE SCHEDULES.



