



# Addendum No. 4

DATE: Wednesday, July 3, 2019

PROJECT: City of Pharr/PSJA Aquatic Facility

PROJECT NO: 971805/ 1819-35-510-C011-051

LOCATION: 3001 N. Cage Blvd., Pharr, Texas 78577

FROM: Laura N. Warren, The Warren Group Architects, Inc.

The following revisions and clarifications shall be considered part of the record contract documents dated June 7, 2019 for the above referenced project and included in the contract amount. All general notes and specifications shall apply to this addendum. Where provisions of the following supplementary data differ from those of the original Contract Documents, this Addendum shall govern and take precedence.

The following scope adjustments have been made. Please adjust bids with the following noted changes:

#### **Specifications**

Item No. 1: As requested by Owner Representative, the Competitive Sealed Proposal opening date has been extended to Tuesday, 07/23/2019 in lieu of 07/11/2019. Time and location remain the same.

Refer to Project Manual dated June 7, 2019. Spec Section 08 71 00 Door Hardware dated 06/7/2019 has been revised. Additional doors to receive card readers as requested by owner. Replace with Spec Section 08 71 00 Door Hardware ADD4 dated 07/03/2019. Insert this section.

#### <u>Drawings</u>

- Item No. 3: Refer to Construction Documents Civil drawing set dated June 7, 2019. Refer to Civil Addendum #4 dated 7/03/2019.
- Refer to Construction Documents sheet A1.11A dated June 7, 2019. Several Exterior Wall types have been changed from EWA-7 to EWA-8. Refer to 30x42 sheet A1.11A ADD 4 dated 7/03/2019. Insert this sheet.
- Item No. 5: Refer to Construction Documents sheet A2.11 dated June 7, 2019. Ladder with cage has been included to access higher level roof. Refer to 30x42 sheet A2.11 ADD 4 dated 7/03/2019. Insert this sheet.

- Item No. 6: Refer to Construction Documents sheet A2.13 dated June 7, 2019. South Interior wall elevation has been provided. Refer to 30x42 sheet A2.13 ADD 4 dated 7/03/2019. Insert this sheet.
- Item No. 7: Refer to Construction Documents sheet A3.02 dated June 7, 2019. Intumescent paint on exposed structure has been noted and clarification on Private Viewing floor structure has been properly depicted. Refer to 30x42 sheet A3.02 ADD 4 dated 7/03/2019. Insert this sheet.
- Refer to Construction Documents sheet A4.13 dated June 7, 2019. Elevation key has been edited to indicate correct drawing reference. Refer to 30x42 sheet A4.13 ADD 4 dated 7/03/2019. Insert this sheet.
- Refer to Construction Documents sheet A4.32 dated June 7, 2019. **Height of Stair**168 has been edited to reflect structural drawings. Refer to 30x42 sheet A4.32 ADD 4
  dated 7/03/2019. Insert this sheet.
- Item No. 10: Refer to Construction Documents sheet A4.33 dated June 7, 2019. Height of Stair 168 has been edited to reflect structural drawings. Refer to 30x42 sheet A4.33 ADD 4 dated 7/03/2019. Insert this sheet.
- Item No. 11: Refer to Construction Documents sheet A5.11 dated June 7, 2019. Louver Details 12, 13 and 14 have been provided. Refer to 30x42 sheet A5.11 ADD 4 dated 7/03/2019. Insert this sheet.
- Item No. 12: Refer to Construction Documents sheet A6.21 dated June 7, 2019. Door and Window Schedules have been revised. Refer to 30x42 sheet A6.21 ADD 4 dated 7/03/2019. Insert this sheet.
- Item No. 13: Refer to Construction Documents sheet A6.22 dated June 7, 2019. Detail keys have been provided along with elevations of louvers, coiling counter shutters, and overhead doors. Refer to 30x42 sheet A6.22 ADD 4 dated 7/03/2019. Insert this sheet.
- Item No. 14: Refer to Construction Documents MEP drawing set dated June 7, 2019. Refer to MEP Addendum #4 dated 7/03/2019.

ISSUED BY:

Laura N. Warren, AIA/Principal
The Warren Group Architects, Inc.

#### Attachments:

PDF Format – 8.5"x11" 08 71 00 Door Hardware ADD4 dated 7/03/2019 PDF Format - 30"x42" C101 ADD 4 dated 07/03/2019 PDF Format - 30"x42" C102 ADD 4 dated 07/03/2019 PDF Format – 30"x42" C103 ADD 4 dated 07/03/2019 PDF Format - 30"x42" C104 ADD 4 dated 07/03/2019 PDF Format - 30"x42" C106 ADD 4 dated 07/03/2019 PDF Format - 30"x42" C111 ADD 4 dated 07/03/2019 PDF Format - 30"x42" C114 ADD 4 dated 07/03/2019 PDF Format – 30"x42" C115 ADD 4 dated 07/03/2019 PDF Format - 30"x42" C116 ADD 4 dated 07/03/2019 PDF Format - 30"x42" A1.11A ADD 4 dated 07/03/2019 PDF Format – 30"x42" A2.11 ADD 4 dated 07/03/2019 PDF Format – 30"x42" A2.13 ADD 4 dated 07/03/2019 PDF Format – 30"x42" A3.02 ADD 4 dated 07/03/2019 PDF Format - 30"x42" A4.13 ADD 4 dated 07/03/2019 PDF Format - 30"x42" A4.32 ADD 4 dated 07/03/2019

PDF Format – 30"x42" A4.33 ADD 4 dated 07/03/2019 PDF Format – 30"x42" A5.11 ADD 4 dated 07/03/2019 PDF Format – 30"x42" A6.21 ADD 4 dated 07/03/2019 PDF Format – 30"x42" A6.22 ADD 4 dated 07/03/2019 PDF Format – 30"x42" E1.02 ADD 4 dated 07/03/2019 PDF Format – 30"x42" E3.01 ADD 4 dated 07/03/2019

# Distribution:

Bidding Vendors Shared File

# ADDENDUM NO. 4 CIVIL PLANS

# CITY OF PHARR/PSJA AQUATIC FACILITY PROJECT NO. 1819-35-510-C011-051

PHARR, TEXAS JULY 3, 2019

The following clarifications, corrections and directives shall become part of the Proposal, Contract Documents and Specifications for the CITY OF PHARR/PSJA AQUATIC FACILITY as prepared by The Warren Group Architects. Revised Civil Plan Sheets have been attached and made part of this Addendum No. 4 and the Contract Documents as follows:

C101 – Dimension Control & Signage Plan
C102 – Drainage Area Map
C103 – Drainage Area Calculations
C104 – Grading and Drainage Plan
C106 – Storm Sewer Line 'B' & 'C'
C111, C114, C115 and C116 – Typical Details

- "Wheel Stops" on the Center's Parking Areas. In general, curb stops will be required all parking spaces facing the edge curb and along the bus parking area on the west side of the proposed building. Please note that the reinforced concrete wheel stops shall be "slotted" to provide drainage. Please refer to the detail contained in the Plans.
- ITEM 2. The size and geometry for the Center's main entrance along the southbound frontage road of I69-C (U.S. Expressway 281) has changed. The entrance width has been reduced to 45 feet (Face to Face) and the center island has been eliminated.
- **ITEM 3.** Please refer to the Architectural Plans for the location of the "Monument Sign".
- **ITEM 4.** The revised plans show clarifications for the roof drain pipe sizes and specification. Roof Drain Pipes shall be PVC, AWWA C-900-16 DR18 with "Ring-Tite" joints and concrete thrust blocks at each bend and wye connection.

ADDENDUM NO. 4
CIVIL PLANS
PHARR/PSJA AQUATIC FACILITY PROJECT
JULY 3, 2019

PAGE 1

- ITEM 5. Additional landscape storm water catchments have been added to the south side of the building within the landscape areas. Storm water catchments for those landscape areas shall be 24" diameter "Nyloplast" inlets as specified in the Typical Details. All other area inlets shall remain as specified.
- ITEM 6. Clarification as to Reinforced Concrete Pipe (RCP) Strength Class designation has been shown in the Plans. In general, RCP Class III shall be used under paved areas. All other RCP shall be Class II. Please refer to schedule contained in the Plans.
- ITEM 7. As a point of clarification, in general, the elevation of the existing site is at elevation 106 feet. Point elevations of existing ground have been included in the Drainage and Grading Plan Sheet C104 as reference.
- **ITEM 8.** "Bioswales" are proposed for the east parking lot only.

Please acknowledge receipt of this Addendum on the space provided in the Proposal and/or Bid Documents.

Submitted by:

Jorge D. Perez, P.E.

Perez Consulting Engineers

808 Dallas Avenue

McAllen, Texas 78501

JORGE D. PERI

ADDENDUM NO. 4 CIVIL PLANS PHARR/PSJA AQUATIC FACILITY PROJECT JULY 3, 2019




600 E. Beaumont Suite #2 McAllen, Texas 78501 (956) 664-2727 Fax (956) 664-2726

# ADDENDUM #4 CITY OF PHARR/PSJA AQUATIC FACILITY 07.03.2019

The following items shall become a part of the contract documents. Refer to full or partial sheets referenced and make changes noted. Bidders are responsible for reading all sections of the addendum. The Addendum consists of the following:

#### **ELECTRICAL**

- Item 1 Sheet E1.02, Electrical Power Floor Plan, card reader rough-in have been added to drawing. Refer to attached drawing.
- Item 2 Sheet E3.01, Electrical Lighting Fixture Schedule, revised fixture schedule. Refer to attached drawing.

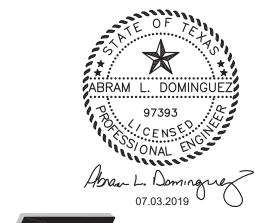



MECHANICAL, ELECTRICAL, PLUMBING ENGINEERS 600 E. BEAUMONT AVE. SUITE 2 McALLEN, TX 78501 (956) 664-2727 TEXAS BOARD OF PROFESSIONAL ENGINEERS REGISTRATION # F-9748

#### SECTION 08 71 00 DOOR HARDWARE

#### PART 1 - GENERAL

#### 1.1 RELATED DOCUMENTS

A. Drawings and general provisions of the Contract, including General and Supplementary Conditions and Division 1 Specification Sections, apply to this Section.

#### 1.2 SUMMARY

- A. This Section includes commercial door hardware for the following:
  - 1. Swinging doors.
- B. Door hardware includes, but is not necessarily limited to, the following:
  - 1. Mechanical door hardware.
  - 2. Electromechanical door hardware.
  - 3. Cylinders specified for doors in other sections.

#### C. Related Sections:

- 1. Division 08 Section "Door Hardware Schedule".
- 2. Division 08 Section "Hollow Metal Doors and Frames".
- 3. Division 08 Section "Flush Wood Doors".
- 4. Division 08 Section "Aluminum-Framed Entrances and Storefronts".
- 5. Division 08 Section "Automatic Door Operators".
- 6. Division 08 Section "Access Control Hardware".
- Division 28 Section "Access Control".
- D. Codes and References: Comply with the version year adopted by the Authority Having Jurisdiction.
  - 1. ANSI A117.1 Accessible and Usable Buildings and Facilities.
  - 2. ICC/IBC International Building Code.
  - 3. NFPA 70 National Electrical Code.
  - 4. NFPA 80 Fire Doors and Windows.
  - 5. NFPA 101 Life Safety Code.
  - 6. NFPA 105 Installation of Smoke Door Assemblies.
  - 7. State Building Codes, Local Amendments.
- E. Standards: All hardware specified herein shall comply with the following industry standards:
  - ANSI/BHMA Certified Product Standards A156 Series
  - UL10C Positive Pressure Fire Tests of Door Assemblies

#### 1.3 SUBMITTALS

971805

- A. Product Data: Manufacturer's product data sheets including installation details, material descriptions, dimensions of individual components and profiles, operational descriptions and finishes.
- B. Door Hardware Schedule: Prepared by or under the supervision of supplier, detailing fabrication and assembly of door hardware, as well as procedures and diagrams. Coordinate the final Door Hardware Schedule with doors, frames, and related work to ensure proper size, thickness, hand, function, and finish of door hardware.
  - 1. Format: Comply with scheduling sequence and vertical format in DHI's "Sequence and Format for the Hardware Schedule."
  - 2. Organization: Organize the Door Hardware Schedule into door hardware sets indicating complete designations of every item required for each door or opening. Organize door hardware sets in same order as in the Door Hardware Sets at the end of Part 3. Submittals that do not follow the same format and order as the Door Hardware Sets will be rejected and subject to resubmission.
  - 3. Content: Include the following information:
    - a. Type, style, function, size, label, hand, and finish of each door hardware item.
    - b. Manufacturer of each item.
    - c. Fastenings and other pertinent information.
    - d. Location of door hardware set, cross-referenced to Drawings, both on floor plans and in door and frame schedule.
    - e. Explanation of abbreviations, symbols, and codes contained in schedule.
    - f. Mounting locations for door hardware.
    - g. Door and frame sizes and materials.
    - h. Warranty information for each product.
  - 4. Submittal Sequence: Submit the final Door Hardware Schedule at earliest possible date, particularly where approval of the Door Hardware Schedule must precede fabrication of other work that is critical in the Project construction schedule. Include Product Data, Samples, Shop Drawings of other work affected by door hardware, and other information essential to the coordinated review of the Door Hardware Schedule.
- C. Shop Drawings: Details of electrified access control hardware indicating the following:
  - 1. Wiring Diagrams: Upon receipt of approved schedules, submit detailed system wiring diagrams for power, signaling, monitoring, communication, and control of the access control system electrified hardware. Differentiate between manufacturer-installed and field-installed wiring. Include the following:
    - a. Elevation diagram of each unique access controlled opening showing location and interconnection of major system components with respect to their placement in the respective door openings.
    - b. Complete (risers, point-to-point) access control system block wiring diagrams.
    - c. Wiring instructions for each electronic component scheduled herein.

- 2. Electrical Coordination: Coordinate with related sections the voltages and wiring details required at electrically controlled and operated hardware openings.
- D. Keying Schedule: After a keying meeting with the owner has taken place prepare a separate keying schedule detailing final instructions. Submit the keying schedule in electronic format. Include keying system explanation, door numbers, key set symbols, hardware set numbers and special instructions. Owner must approve submitted keying schedule prior to the ordering of permanent cylinders/cores.
- E. Proof of Compliance: (California located Projects): Provide a list of product(s) containing chemicals known to cause cancer or reproductive toxicity as defined by the Office of Environmental Health Hazard Assessment (OEHHA) under Proposition 65 (CA Code of Regulations, Title 27, Section 27001). The list includes the specific chemical(s), if the chemical will be exposed to consumers, the means of warning, and an illustration of the label.

#### F. Informational Submittals:

- 1. Product Test Reports: Indicating compliance with cycle testing requirements, based on evaluation of comprehensive tests performed by manufacturer and witnessed by a qualified independent testing agency.
- G. Operating and Maintenance Manuals: Provide manufacturers operating and maintenance manuals for each item comprising the complete door hardware installation in quantity as required in Division 01, Closeout Submittals.

#### 1.4 QUALITY ASSURANCE

- A. Manufacturers Qualifications: Engage qualified manufacturers with a minimum 5 years of documented experience in producing hardware and equipment similar to that indicated for this Project and that have a proven record of successful in-service performance.
- B. Installer Qualifications: A minimum 3 years documented experience installing both standard and electrified door hardware similar in material, design, and extent to that indicated for this Project and whose work has resulted in construction with a record of successful in-service performance.
- C. Door Hardware Supplier Qualifications: Experienced commercial door hardware distributors with a minimum 5 years documented experience supplying both mechanical and electromechanical hardware installations comparable in material, design, and extent to that indicated for this Project. Supplier recognized as a factory direct distributor by the manufacturers of the primary materials with a warehousing facility in Project's vicinity. Supplier to have on staff a certified Architectural Hardware Consultant (AHC) available during the course of the Work to consult with Contractor, Architect, and Owner concerning both standard and electromechanical door hardware and keying.
- D. Automatic Operator Supplier Qualifications: Power operator products and accessories are required to be supplied and installed through current members of the manufacturer's "Power Operator Preferred Installer" program. Suppliers are to be factory trained, certified, and a direct purchaser of the specified power operators and be responsible for the installation and maintenance of the units and accessories indicated for the Project.

- E. Source Limitations: Obtain each type and variety of door hardware specified in this section from a single source unless otherwise indicated.
  - 1. Electrified modifications or enhancements made to a source manufacturer's product line by a secondary or third party source will not be accepted.
  - 2. Provide electromechanical door hardware from the same manufacturer as mechanical door hardware, unless otherwise indicated.
- F. Each unit to bear third party permanent label demonstrating compliance with the referenced standards.
- G. Keying Conference: Conduct conference to comply with requirements in Division 01 Section "Project Meetings." Keying conference to incorporate the following criteria into the final keying schedule document:
  - 1. Function of building, purpose of each area and degree of security required.
  - 2. Plans for existing and future key system expansion.
  - 3. Requirements for key control storage and software.
  - 4. Installation of permanent keys, cylinder cores and software.
  - 5. Address and requirements for delivery of keys.
- H. Pre-Submittal Conference: Conduct coordination conference in compliance with requirements in Division 01 Section "Project Meetings" with attendance by representatives of Supplier(s), Installer(s), and Contractor(s) to review proper methods and the procedures for receiving, handling, and installing door hardware.
  - Prior to installation of door hardware, conduct a project specific training meeting to instruct the installing contractors' personnel on the proper installation and adjustment of their respective products. Product training to be attended by installers of door hardware (including electromechanical hardware) for aluminum, hollow metal and wood doors. Training will include the use of installation manuals, hardware schedules, templates and physical product samples as required.
  - 2. Inspect and discuss electrical roughing-in, power supply connections, and other preparatory work performed by other trades.
  - 3. Review sequence of operation narratives for each unique access controlled opening.
  - 4. Review and finalize construction schedule and verify availability of materials.
  - 5. Review the required inspecting, testing, commissioning, and demonstration procedures
- I. At completion of installation, provide written documentation that components were applied to manufacturer's instructions and recommendations and according to approved schedule.
- 1.5 DELIVERY, STORAGE, AND HANDLING
  - A. Inventory door hardware on receipt and provide secure lock-up and shelving for door hardware delivered to Project site. Do not store electronic access control hardware, software or accessories at Project site without prior authorization.
  - B. Tag each item or package separately with identification related to the final Door Hardware Schedule, and include basic installation instructions with each item or package.

971805

C. Deliver, as applicable, permanent keys, cylinders, cores, access control credentials, software and related accessories directly to Owner via registered mail or overnight package service. Instructions for delivery to the Owner shall be established at the "Keying Conference".

#### 1.6 COORDINATION

- A. Templates: Obtain and distribute to the parties involved templates for doors, frames, and other work specified to be factory prepared for installing standard and electrified hardware. Check Shop Drawings of other work to confirm that adequate provisions are made for locating and installing hardware to comply with indicated requirements.
- B. Door Hardware and Electrical Connections: Coordinate the layout and installation of scheduled electrified door hardware and related access control equipment with required connections to source power junction boxes, low voltage power supplies, detection and monitoring hardware, and fire and detection alarm systems.
- C. Door and Frame Preparation: Doors and corresponding frames are to be prepared, reinforced and pre-wired (if applicable) to receive the installation of the specified electrified, monitoring, signaling and access control system hardware without additional in-field modifications.

#### 1.7 WARRANTY

- A. General Warranty: Reference Division 01, General Requirements. Special warranties specified in this Article shall not deprive Owner of other rights Owner may have under other provisions of the Contract Documents and shall be in addition to, and run concurrent with, other warranties made by Contractor under requirements of the Contract Documents.
- B. Warranty Period: Written warranty, executed by manufacturer(s), agreeing to repair or replace components of standard and electrified door hardware that fails in materials or workmanship within specified warranty period after final acceptance by the Owner. Failures include, but are not limited to, the following:
  - 1. Structural failures including excessive deflection, cracking, or breakage.
  - 2. Faulty operation of the hardware.
  - 3. Deterioration of metals, metal finishes, and other materials beyond normal weathering.
  - 4. Electrical component defects and failures within the systems operation.
- C. Standard Warranty Period: One year from date of Substantial Completion, unless otherwise indicated.
- D. Special Warranty Periods:
  - 1. Five years for standard duty cylindrical (bored) locks and latches.
  - 2. Five years for exit hardware.
  - 3. Ten years for manual surface door closer bodies.
  - 4. Twenty five years for manual surface door closer bodies.
  - 5. Five years for motorized electric latch retraction exit devices.
  - 6. Two years for electromechanical door hardware.

#### 1.8 MAINTENANCE SERVICE

A. Maintenance Tools and Instructions: Furnish a complete set of specialized tools and maintenance instructions as needed for Owner's continued adjustment, maintenance, and removal and replacement of door hardware.

#### PART 2 - PRODUCTS

#### 2.1 SCHEDULED DOOR HARDWARE

- A. General: Provide door hardware for each door to comply with requirements in Door Hardware Sets and each referenced section that products are to be supplied under.
- B. Designations: Requirements for quantity, item, size, finish or color, grade, function, and other distinctive qualities of each type of door hardware are indicated in the Door Hardware Sets at the end of Part 3. Products are identified by using door hardware designations, as follows:
  - 1. Named Manufacturer's Products: Product designation and manufacturer are listed for each door hardware type required for the purpose of establishing requirements. Manufacturers' names are abbreviated in the Door Hardware Schedule.
- C. Substitutions: Requests for substitution and product approval for inclusive mechanical and electromechanical door hardware in compliance with the specifications must be submitted in writing and in accordance with the procedures and time frames outlined in Division 01, Substitution Procedures. Approval of requests is at the discretion of the architect, owner, and their designated consultants.

#### 2.2 HANGING DEVICES

- A. Hinges: ANSI/BHMA A156.1 certified butt hinges with number of hinge knuckles and other options as specified in the Door Hardware Sets.
  - 1. Quantity: Provide the following hinge quantity:
    - a. Two Hinges: For doors with heights up to 60 inches.
    - b. Three Hinges: For doors with heights 61 to 90 inches.
    - c. Four Hinges: For doors with heights 91 to 120 inches.
    - d. For doors with heights more than 120 inches, provide 4 hinges, plus 1 hinge for every 30 inches of door height greater than 120 inches.
  - 2. Hinge Size: Provide the following, unless otherwise indicated, with hinge widths sized for door thickness and clearances required:
    - a. Widths up to 3'0": 4-1/2" standard or heavy weight as specified.
    - b. Sizes from 3'1" to 4'0": 5" standard or heavy weight as specified.
  - 3. Hinge Weight and Base Material: Unless otherwise indicated, provide the following:
    - a. Exterior Doors: Heavy weight, non-ferrous, ball bearing or oil impregnated bearing hinges unless Hardware Sets indicate standard weight.

- b. Interior Doors: Standard weight, steel, ball bearing or oil impregnated bearing hinges unless Hardware Sets indicate heavy weight.
- 4. Hinge Options: Comply with the following:
  - a. Non-removable Pins: Provide set screw in hinge barrel that, when tightened into a groove in hinge pin, prevents removal of pin while door is closed; for the all out-swinging lockable doors.
- 5. Manufacturers:
  - a. McKinney Products; ASSA ABLOY Architectural Door Accessories (MK).
- B. Continuous Geared Hinges: ANSI/BHMA A156.26 Grade 1-600 certified continuous geared hinge. with minimum 0.120-inch thick extruded 6060 T6 aluminum alloy hinge leaves and a minimum overall width of 4 inches. Hinges are non-handed, reversible and fabricated to template screw locations. Factory trim hinges to suit door height and prepare for electrical cutouts.
  - 1. Manufacturers:
    - a. McKinney Products; ASSA ABLOY Architectural Door Accessories (MK).
    - b. Pemko Products; ASSA ABLOY Architectural Door Accessories (PE).

#### 2.3 POWER TRANSFER DEVICES

- A. Concealed Quick Connect Electric Power Transfers: Provide concealed wiring pathway housing mortised into the door and frame for low voltage electrified door hardware. Furnish with Molex™ standardized plug connectors and sufficient number of concealed wires (up to 12) to accommodate the electrified functions specified in the Door Hardware Sets. Connectors plug directly to through-door wiring harnesses for connection to electric locking devices and power supplies. Wire nut connections are not acceptable.
  - Manufacturers:
    - a. Pemko Products; ASSA ABLOY Architectural Door Accessories (PE) EL-CEPT Series.
    - b. Securitron (SU) EL-CEPT Series.
- B. Electric Door Wire Harnesses: Provide electric/data transfer wiring harnesses with standardized plug connectors to accommodate up to twelve (12) wires. Connectors plug directly to throughdoor wiring harnesses for connection to electric locking devices and power supplies. Provide sufficient number and type of concealed wires to accommodate electric function of specified hardware. Provide a connector for through-door electronic locking devices and from hinge to junction box above the opening. Wire nut connections are not acceptable. Determine the length required for each electrified hardware component for the door type, size and construction, minimum of two per electrified opening.
  - 1. Provide one each of the following tools as part of the base bid contract:
    - a. McKinney Products; ASSA ABLOY Architectural Door Accessories (MK) Electrical Connecting Kit: QC-R001.

971805

 McKinney Products; ASSA ABLOY Architectural Door Accessories (MK) -Connector Hand Tool: QC-R003.

#### 2. Manufacturers:

 a. McKinney Products; ASSA ABLOY Architectural Door Accessories (MK) – QC-C Series.

#### 2.4 DOOR OPERATING TRIM

- A. Flush Bolts and Surface Bolts: ANSI/BHMA A156.3 and A156.16, Grade 1, certified.
  - 1. Flush bolts to be furnished with top rod of sufficient length to allow bolt retraction device location approximately six feet from the floor.
  - 2. Furnish dust proof strikes for bottom bolts.
  - 3. Surface bolts to be minimum 8" in length and U.L. listed for labeled fire doors and U.L. listed for windstorm components where applicable.
  - 4. Provide related accessories (mounting brackets, strikes, coordinators, etc.) as required for appropriate installation and operation.
  - 5. Manufacturers:
    - a. Rockwood Products; ASSA ABLOY Architectural Door Accessories (RO).
- B. Door Push Plates and Pulls: ANSI/BHMA A156.6 certified door pushes and pulls of type and design specified in the Hardware Sets. Coordinate and provide proper width and height as required where conflicting hardware dictates.
  - 1. Push/Pull Plates: Minimum .050 inch thick, size as indicated in hardware sets, with beveled edges, secured with exposed screws unless otherwise indicated.
  - 2. Door Pull and Push Bar Design: Size, shape, and material as indicated in the hardware sets. Minimum clearance of 2 1/2-inches from face of door unless otherwise indicated.
  - Offset Pull Design: Size, shape, and material as indicated in the hardware sets. Minimum clearance of 2 1/2-inches from face of door and offset of 90 degrees unless otherwise indicated.
  - 4. Fasteners: Provide manufacturer's designated fastener type as indicated in Hardware Sets.
  - Manufacturers:
    - a. Rockwood Products; ASSA ABLOY Architectural Door Accessories (RO).

#### 2.5 CYLINDERS AND KEYING

- A. General: Cylinder manufacturer to have minimum (10) years experience designing secured master key systems and have on record a published security keying system policy.
- B. Source Limitations: Obtain each type of keyed cylinder and keys from the same source manufacturer as locksets and exit devices, unless otherwise indicated.

- C. Cylinders: Original manufacturer cylinders complying with the following:
  - 1. Mortise Type: Threaded cylinders with rings and cams to suit hardware application.
  - 2. Rim Type: Cylinders with back plate, flat-type vertical or horizontal tailpiece, and raised trim ring.
  - 3. Bored-Lock Type: Cylinders with tailpieces to suit locks.
  - 4. Mortise and rim cylinder collars to be solid and recessed to allow the cylinder face to be flush and be free spinning with matching finishes.
  - 5. Keyway: Manufacturer's Standard.
- D. Patented Cylinders: ANSI/BHMA A156.5, Grade 1, certified patented cylinders employing a utility patented and restricted keyway requiring the use of a patented key. Cylinders are to be protected from unauthorized manufacture and distribution by manufacturer's United States patents. Cylinders are to be factory keyed with owner having the ability for on-site original key cutting.
  - Manufacturers:
    - Yale Locks and Hardware (YA) Keymark Series.
- E. Keying System: Each type of lock and cylinders to be factory keyed.
  - 1. Conduct specified "Keying Conference" to define and document keying system instructions and requirements.
  - 2. Furnish factory cut, nickel-silver large bow permanently inscribed with a visual key control number as directed by Owner.
  - 3. New System: Key locks to a new key system as directed by the Owner.
- F. Key Quantity: Provide the following minimum number of keys:
  - 1. Change Keys per Cylinder: Two (2)
  - 2. Master Keys (per Master Key Level/Group): Five (5).
  - 3. Construction Keys (where required): Ten (10).
  - 4. Construction Control Keys (where required): Two (2).
  - 5. Permanent Control Keys (where required): Two (2).
- G. Construction Keying: Provide construction master keyed cylinders.
- H. Key Registration List (Bitting List):
  - 1. Provide keying transcript list to Owner's representative in the proper format for importing into key control software.
  - 2. Provide transcript list in writing or electronic file as directed by the Owner.
- I. Key Control Cabinet: Provide a key control system including envelopes, labels, and tags with self-locking key clips, receipt forms, 3-way visible card index, temporary markers, permanent markers, and standard metal cabinet. Key control cabinet shall have expansion capacity of 150% of the number of locks required for the project.
  - 1. Manufacturers:
    - a. Lund Equipment (LU).
    - b. MMF Industries (MM).

c. Telkee (TK).

#### 2.6 MECHANICAL LOCKS AND LATCHING DEVICES

- Cylindrical Locksets, Grade 1 (Commercial Duty): ANSI/BHMA A156.2, Series 4000, Grade 1 certified.
  - 1. Locks are to be non-handed and fully field reversible.
  - Manufacturers:
    - a. Yale Locks and Hardware (YA) 4700LN Series.

#### 2.7 LOCK AND LATCH STRIKES

- A. Strikes: Provide manufacturer's standard strike with strike box for each latch or lock bolt, with curved lip extended to protect frame, finished to match door hardware set, unless otherwise indicated, and as follows:
  - Flat-Lip Strikes: For locks with three-piece antifriction latchbolts, as recommended by manufacturer.
  - 2. Extra-Long-Lip Strikes: For locks used on frames with applied wood casing trim.
  - 3. Aluminum-Frame Strike Box: Provide manufacturer's special strike box fabricated for aluminum framing.
  - 4. Double-lipped strikes: For locks at double acting doors. Furnish with retractable stop for rescue hardware applications.
- B. Standards: Comply with the following:
  - 1. Strikes for Mortise Locks and Latches: BHMA A156.13.
  - 2. Strikes for Bored Locks and Latches: BHMA A156.2.
  - 3. Strikes for Auxiliary Deadlocks: BHMA A156.36.
  - 4. Dustproof Strikes: BHMA A156.16.

#### 2.8 CONVENTIONAL EXIT DEVICES

- A. General Requirements: All exit devices specified herein shall meet or exceed the following criteria:
  - 1. At doors not requiring a fire rating, provide devices complying with NFPA 101 and listed and labeled for "Panic Hardware" according to UL305. Provide proper fasteners as required by manufacturer including sex nuts and bolts at openings specified in the Hardware Sets.
  - Where exit devices are required on fire rated doors, provide devices complying with NFPA 80 and with UL labeling indicating "Fire Exit Hardware". Provide devices with the proper fasteners for installation as tested and listed by UL. Consult manufacturer's catalog and template book for specific requirements.

- 3. Except on fire rated doors, provide exit devices with hex key dogging device to hold the pushbar and latch in a retracted position. Provide optional keyed cylinder dogging on devices where specified in Hardware Sets.
- 4. Devices must fit flat against the door face with no gap that permits unauthorized dogging of the push bar. The addition of filler strips is required in any case where the door light extends behind the device as in a full glass configuration.
- 5. Electromechanical Options: Subject to same compliance standards and requirements as mechanical exit devices, electrified devices to be of type and design as specified in hardware sets. Include any specific controllers when conventional power supplies are not sufficient to provide the proper inrush current.
- Lever Operating Trim: Where exit devices require lever trim, furnish manufacturer's heavy duty escutcheon trim with threaded studs for thru-bolts.
  - a. Lock Trim Design: As indicated in Hardware Sets, provide finishes and designs to match that of the specified locksets.
  - b. Where function of exit device requires a cylinder, provide a cylinder (Rim or Mortise) as specified in Hardware Sets.
- 7. Vertical Rod Exit Devices: Where surface or concealed vertical rod exit devices are used at interior openings, provide as less bottom rod (LBR) unless otherwise indicated. Provide dust proof strikes where thermal pins are required to project into the floor.
- 8. Narrow Stile Applications: At doors constructed with narrow stiles, or as specified in Hardware Sets, provide devices designed for maximum 2" wide stiles.
- 9. Dummy Push Bar: Nonfunctioning push bar matching functional push bar.
- 10. Rail Sizing: Provide exit device rails factory sized for proper door width application.
- 11. Through Bolt Installation: For exit devices and trim as indicated in Door Hardware Sets.
- B. Conventional Push Rail Exit Devices (Heavy Duty): ANSI/BHMA A156.3, Grade 1 certified panic and fire exit hardware devices furnished in the functions specified in the Hardware Sets. Exit device latch to be stainless steel, pullman type, with deadlock feature.
  - 1. Manufacturers:
    - a. Yale Locks and Hardware (YA) 7000 Series.
- C. Security Push Rail Exit Devices (Heavy Duty): ANSI/BHMA A156.3, Grade 1 certified rim panic and fire exit hardware devices furnished in the functions specified in the Hardware Sets. Exit device latch to be constructed of high grade, heat treated, corrosion resistant nickel steel alloy, and have a full 3/4" throw projection with slide action positive deadlocking.
  - 1. Static Load Force Resistance: Minimum 3000 lbs certified independent tested.
  - 2. Manufacturers:
    - a. Yale Locks and Hardware (YA) Squarebolt Series.

971805

- D. Tube Steel Removable Mullions: ANSI/BHMA A156.3 removable steel mullions with malleable-iron top and bottom retainers and a primed paint finish.
  - 1. Provide keyed removable feature where specified in the Hardware Sets.
  - 2. Provide stabilizers and mounting brackets as required.
  - 3. Provide electrical quick connection wiring options as specified in the hardware sets.
  - 4. Manufacturers:
    - a. Yale Locks and Hardware (YA) M200 Series.

#### 2.9 DOOR CLOSERS

- A. All door closers specified herein shall meet or exceed the following criteria:
  - 1. General: Door closers to be from one manufacturer, matching in design and style, with the same type door preparations and templates regardless of application or spring size. Closers to be non-handed with full sized covers including installation and adjusting information on inside of cover.
  - Standards: Closers to comply with UL-10C for Positive Pressure Fire Test and be U.L. listed for use of fire rated doors.
  - 3. Cycle Testing: Provide closers which have surpassed 15 million cycles in a test witnessed and verified by UL.
  - 4. Size of Units: Comply with manufacturer's written recommendations for sizing of door closers depending on size of door, exposure to weather, and anticipated frequency of use. Where closers are indicated for doors required to be accessible to the physically handicapped, provide units complying with ANSI ICC/A117.1.
  - 5. Closer Arms: Provide heavy duty, forged steel closer arms unless otherwise indicated in Hardware Sets.
  - 6. Closers shall not be installed on exterior or corridor side of doors; where possible install closers on door for optimum aesthetics.
  - 7. Closer Accessories: Provide door closer accessories including custom templates, special mounting brackets, spacers and drop plates as required for proper installation. Provide through-bolt and security type fasteners as specified in the hardware sets.
- B. Door Closers, Surface Mounted (Large Body Cast Iron): ANSI/BHMA A156.4, Grade 1 surface mounted, heavy duty door closers with complete spring power adjustment, sizes 1 thru 6; and fully operational adjustable according to door size, frequency of use, and opening force. Closers to be rack and pinion type, one piece cast iron body construction, with adjustable backcheck and separate non-critical valves for closing sweep and latch speed control.
  - 1. Manufacturers:
    - a. Sargent Manufacturing (SA) 281 Series.

- C. Door Closers, Surface Mounted (Heavy Duty): ANSI/BHMA A156.4, Grade 1 surface mounted, heavy duty door closers with complete spring power adjustment, sizes 1 thru 6; and fully operational adjustable according to door size, frequency of use, and opening force. Closers to be rack and pinion type, one piece cast iron or aluminum alloy body construction, with adjustable backcheck and separate non-critical valves for closing sweep and latch speed control. Provide non-handed units standard.
  - 1. Manufacturers:
    - a. Yale Locks and Hardware (YA) 4400 Series.

#### 2.10 ELECTROHYDRAULIC DOOR OPERATORS

- A. General: Provide low energy operators of size recommended by manufacturer for door size, weight, and movement; for condition of exposure; and for compliance with UL 325. Coordinate operator mechanisms with door operation, hinges, and activation devices.
  - 1. Fire-Rated Doors: Provide door operators for fire-rated door assemblies that comply with NFPA 80 for fire-rated door components and are listed and labeled by a qualified testing agency.
- B. Standard: Certified ANSI/BHMA A156.19.
- C. Performance Requirements:
  - 1. Opening Force if Power Fails: Not more than 15 lbf required to release a latch if provided, not more than 30 lbf required to manually set door in motion, and not more than 15 lbf required to fully open door.
  - 2. Entrapment Protection: Not more than 15 lbf required to prevent stopped door from closing or opening.
- D. Configuration: Surface mounted or in-ground as required. Door operators to control single swinging and pair of swinging doors.
- E. Operation: Power opening and spring closing operation capable of meeting ANSI A117.1 accessibility guideline. Provide time delay for door to remain open before initiating closing cycle as required by ANSI/BHMA A156.19. When not in automatic mode, door operator to function as manual door closer with fully adjustable opening and closing forces, with or without electrical power.
- F. Features: Operator units to have full feature adjustments for door opening and closing force and speed, backcheck, motor assist acceleration from 0 to 30 seconds, time delay, vestibule interface delay, obstruction recycle, and hold open time from 0 up to 30 seconds.
- G. Provide outputs and relays on board the operator to allow for coordination of exit device latch retraction, electric strikes, magnetic locks, card readers, safety and motion sensors and specified auxiliary contacts.
- H. Brackets and Reinforcements: Manufacturer's standard, fabricated from aluminum with nonferrous shims for aligning system components.

- I. Manufacturers: Subject to compliance with requirements, provide products by one of the following:
  - 1. Norton Door Controls (NO) 6000 Series.

#### 2.11 ARCHITECTURAL TRIM

#### A. Door Protective Trim

- General: Door protective trim units to be of type and design as specified below or in the Hardware Sets.
- Size: Fabricate protection plates (kick, armor, or mop) not more than 2" less than door width (LDW) on stop side of single doors and 1" LDW on stop side of pairs of doors, and not more than 1" less than door width on pull side. Coordinate and provide proper width and height as required where conflicting hardware dictates. Height to be as specified in the Hardware Sets.
- 3. Where plates are applied to fire rated doors with the top of the plate more than 16" above the bottom of the door, provide plates complying with NFPA 80. Consult manufacturer's catalog and template book for specific requirements for size and applications.
- 4. Protection Plates: ANSI/BHMA A156.6 certified protection plates (kick, armor, or mop), fabricated from the following:
  - a. Stainless Steel: 300 grade, 050-inch thick.
- 5. Options and fasteners: Provide manufacturer's designated fastener type as specified in the Hardware Sets. Provide countersunk screw holes.
- 6. Manufacturers:
  - a. Rockwood Products; ASSA ABLOY Architectural Door Accessories (RO).

#### 2.12 DOOR STOPS AND HOLDERS

- A. General: Door stops and holders to be of type and design as specified below or in the Hardware Sets.
- B. Door Stops and Bumpers: ANSI/BHMA A156.16, Grade 1 certified door stops and wall bumpers. Provide wall bumpers, either convex or concave types with anchorage as indicated, unless floor or other types of door stops are specified in Hardware Sets. Do not mount floor stops where they will impede traffic. Where floor or wall bumpers are not appropriate, provide overhead type stops and holders.
  - 1. Manufacturers:
    - a. Rockwood Products; ASSA ABLOY Architectural Door Accessories (RO).

971805

#### 2.13 ARCHITECTURAL SEALS

- A. General: Thresholds, weatherstripping, and gasket seals to be of type and design as specified below or in the Hardware Sets. Provide continuous weatherstrip gasketing on exterior doors and provide smoke, light, or sound gasketing on interior doors where indicated. At exterior applications provide non-corrosive fasteners and elsewhere where indicated.
- B. Smoke Labeled Gasketing: Assemblies complying with NFPA 105 that are listed and labeled by a testing and inspecting agency acceptable to authorities having jurisdiction, for smoke control ratings indicated, based on testing according to UL 1784.
  - 1. Provide smoke labeled perimeter gasketing at all smoke labeled openings.
- C. Fire Labeled Gasketing: Assemblies complying with NFPA 80 that are listed and labeled by a testing and inspecting agency acceptable to authorities having jurisdiction, for fire ratings indicated, based on testing according to UL-10C.
  - 1. Provide intumescent seals as indicated to meet UL10C Standard for Positive Pressure Fire Tests of Door Assemblies, and NPFA 252, Standard Methods of Fire Tests of Door Assemblies.
- D. Sound-Rated Gasketing: Assemblies that are listed and labeled by a testing and inspecting agency, for sound ratings indicated.
- E. Replaceable Seal Strips: Provide only those units where resilient or flexible seal strips are easily replaceable and readily available from stocks maintained by manufacturer.
- F. Manufacturers:
  - 1. Pemko Products; ASSA ABLOY Architectural Door Accessories (PE).

#### 2.14 ELECTRONIC ACCESSORIES

- A. Request-to-Exit Motion Sensor: Request-to-Exit Sensors motion detectors specifically designed for detecting exiting through a door from the secure area to a non-secure area. Include built-in timers (up to 60 second adjustable timing), door monitor with sounder alert, internal vertical pointability coverage, 12VDC or 24VDC power and selectable relay trigger with fail safe/fail secure modes.
  - 1. Manufacturers:
    - a. Securitron (SU) XMS Series.
- B. Door Position Switches: Door position magnetic reed contact switches specifically designed for use in commercial door applications. On recessed models the contact and magnetic housing snap-lock into a 1" diameter hole. Surface mounted models include wide gap distance design complete with armored flex cabling. Provide SPDT, N/O switches with optional Rare Earth Magnet installation on steel doors with flush top channels.
  - 1. Manufacturers:
    - a. Securitron (SU) DPS Series.

C. Switching Power Supplies: Provide switching power supplies that are dual voltage, UL listed, supervised units. Units shall be field selectable with a dedicated battery charging circuit that provide 4 Amp at 12VDC or 24VDC continuous, with up to 16 independently controlled power limited outputs. Units shall tolerate brownout or overvoltage input ± 15% of nominal voltage and have thermal shutdown protection with auto restart. Circuit breaker shall protect against overcurrent and reverse battery faults and units shall be available with a single relay fire trigger or individually triggered relayed outputs. Provide the least number of units, at the appropriate amperage level, sufficient to exceed the required total draw for the specified electrified hardware and access control equipment.

#### 1. Manufacturers:

a. Securitron (SU) - AQ Series.

#### 2.15 FABRICATION

A. Fasteners: Provide door hardware manufactured to comply with published templates generally prepared for machine, wood, and sheet metal screws. Provide screws according to manufacturers recognized installation standards for application intended.

#### 2.16 FINISHES

- A. Standard: Designations used in the Hardware Sets and elsewhere indicate hardware finishes complying with ANSI/BHMA A156.18, including coordination with traditional U.S. finishes indicated by certain manufacturers for their products.
- B. Provide quality of finish, including thickness of plating or coating (if any), composition, hardness, and other qualities complying with manufacturer's standards, but in no case less than specified by referenced standards for the applicable units of hardware
- C. Protect mechanical finishes on exposed surfaces from damage by applying a strippable, temporary protective covering before shipping.

#### PART 3 - EXECUTION

#### 3.1 EXAMINATION

- A. Examine scheduled openings, with Installer present, for compliance with requirements for installation tolerances, labeled fire door assembly construction, wall and floor construction, and other conditions affecting performance.
- B. Notify architect of any discrepancies or conflicts between the door schedule, door types, drawings and scheduled hardware. Proceed only after such discrepancies or conflicts have been resolved in writing.

#### 3.2 PREPARATION

A. Hollow Metal Doors and Frames: Comply with ANSI/DHI A115 series.

B. Wood Doors: Comply with ANSI/DHI A115-W series.

#### 3.3 INSTALLATION

- A. Install each item of mechanical and electromechanical hardware and access control equipment to comply with manufacturer's written instructions and according to specifications.
  - 1. Installers are to be trained and certified by the manufacturer on the proper installation and adjustment of fire, life safety, and security products including: hanging devices; locking devices; closing devices; and seals.
- B. Mounting Heights: Mount door hardware units at heights indicated in following applicable publications, unless specifically indicated or required to comply with governing regulations:
  - 1. Standard Steel Doors and Frames: DHI's "Recommended Locations for Architectural Hardware for Standard Steel Doors and Frames."
  - 2. Wood Doors: DHI WDHS.3, "Recommended Locations for Architectural Hardware for Wood Flush Doors."
  - 3. Where indicated to comply with accessibility requirements, comply with ANSI A117.1 "Accessibility Guidelines for Buildings and Facilities."
  - 4. Provide blocking in drywall partitions where wall stops or other wall mounted hardware is located.
- C. Power Operator products and accessories are required to be installed through current members of the manufacturer's "Power Operator Preferred Installer" program.
- D. Retrofitting: Install door hardware to comply with manufacturer's published templates and written instructions. Where cutting and fitting are required to install door hardware onto or into surfaces that are later to be painted or finished in another way, coordinate removal, storage, and reinstallation of surface protective trim units with finishing work specified in Division 9 Sections. Do not install surface-mounted items until finishes have been completed on substrates involved.
- E. Thresholds: Set thresholds for exterior and acoustical doors in full bed of sealant complying with requirements specified in Division 7 Section "Joint Sealants."
- F. Storage: Provide a secure lock up for hardware delivered to the project but not yet installed. Control the handling and installation of hardware items so that the completion of the work will not be delayed by hardware losses before and after installation.

#### 3.4 FIELD QUALITY CONTROL

A. Field Inspection: Supplier will perform a final inspection of installed door hardware and state in report whether work complies with or deviates from requirements, including whether door hardware is properly installed, operating and adjusted.

#### 3.5 ADJUSTING

A. Initial Adjustment: Adjust and check each operating item of door hardware and each door to ensure proper operation or function of every unit. Replace units that cannot be adjusted to

operate as intended. Adjust door control devices to compensate for final operation of heating and ventilating equipment and to comply with referenced accessibility requirements.

#### 3.6 CLEANING AND PROTECTION

- A. Protect all hardware stored on construction site in a covered and dry place. Protect exposed hardware installed on doors during the construction phase. Install any and all hardware at the latest possible time frame.
- B. Clean adjacent surfaces soiled by door hardware installation.
- C. Clean operating items as necessary to restore proper finish. Provide final protection and maintain conditions that ensure door hardware is without damage or deterioration at time of owner occupancy.

#### 3.7 DEMONSTRATION

A. Instruct Owner's maintenance personnel to adjust, operate, and maintain mechanical and electromechanical door hardware.

#### 3.8 DOOR HARDWARE SETS

- A. The hardware sets represent the design intent and direction of the owner and architect. They are a guideline only and should not be considered a detailed hardware schedule. Discrepancies, conflicting hardware and missing items should be brought to the attention of the architect with corrections made prior to the bidding process. Omitted items not included in a hardware set should be scheduled with the appropriate additional hardware required for proper application and functionality.
- B. The supplier is responsible for handing and sizing all products and providing the correct option for the appropriate door type and material where more than one is presented in the hardware sets. Quantities listed are for each pair of doors, or for each single door.
- C. Materials to be furnished in accordance to Premier/ASSA ABLOY GPO Contract #PP-FA-663.
- D. Manufacturer's Abbreviations:
  - 1. MK McKinney
  - 2. PE Pemko
  - 3. RO Rockwood
  - 4. YA Yale
  - 5. RF Rixson
  - 6. SA SARGENT
  - 7. NO Norton
  - 8. SU Securitron
  - 9. OT OTHER

# **Hardware Sets**

# **Set: 1.0**

Doors: 101A

Description: Exterior Pair, Vestibule Entrance, AO

2 Continuous Hinge	CFM85SLI-HD1 PT		PE 087100	
1 Exit Device (CVR, exit only)	7120 EO ECK1	630	YA 087100	
1 Exit Device (nightlatch)	7120 603F P ECK1 K600		YA	
2 Offset Door Pull	RM3310-24 Mtg-Type 12XHD	US32D	RO 087100	
1 Conc Overhead Stop	6ADJ-X36	630	RF 087100	
1 Surface Closer (CPS)	4430	689	YA 087100	
1 Door Operator (Single)	6061	689	NO 087100	4
1 Threshold	253x3AFG		PE 087100	
1 Rain Guard	346C TKSP		PE 087100	
2 Sweep	345APK TKSP		PE 087100	
1 ElectroLynx Harness (frame)	QC-C_ (size as required)		MK 087100	4
1 ElectroLynx Harness (door)	QC-C_ (size as required)		MK 087100	4
1 Electric Power Transfer	EL-CEPT		SU 087100	4
1 Switch Post	500		NO 087100	4
1 Door Switch	501		NO 087100	4

Notes: Perimeter seal and astragal by door/frame provider.

# **Set: 1.1**

Doors: 101B

Description: Exterior Pair, Vestibule Entrance

2 Continuous Hinge	CFM85SLI-HD1 PT		PE 087100
1 Exit Device (nightlatch)	7120 603F ECK1 K600		YA
1 Exit Device (CVR, exit only)	7120 EO ECK1	630	YA 087100
2 Offset Door Pull	RM3310-24 Mtg-Type 12XHD	US32D	RO 087100
2 Surface Closer (CPS)	4430	689	YA 087100
1 Threshold	253x3AFG		PE 087100
1 Rain Guard	346C TKSP		PE 087100
2 Sweep	345APK TKSP		PE 087100

Notes: Perimeter seal and astragal by door/frame provider.

#### **Set: 2.0**

Doors: 106B, 117B, 130A, 130B, 160A, 160B, 161A, 161B

Description: Exterior Pair, Corridor Exit

2 Continuous Hinge	CFM_SLI-HD1 (size as required)		PE	087100
1 Removable Mullion	KRM200	600	YA	087100
2 Exit Device (rim, exit only)	7150 EO ECK1	630	YA	087100
1 Cylinder	K6 Series	626	YA	087100
2 Surface Closer (CPS)	4430	689	YA	087100
2 Kick Plate	K1050 10" high x 1" LDW SA BEV	US32D	RO	
1 Threshold	253x3AFG		PE	087100
1 Gasketing	2891APK		PE	087100
1 Rain Guard	346C TKSP		PE	087100
2 Sweep	345APK TKSP		PE	087100
2 Astragal	29310CP TKSP		PE	087100

Notes: Template closer and exit device for weatherstrip mounting. Install weatherstrip on frame prior to installing closer or exit device strike to provide a continuous seal.

# **Set: 3.0**

Doors: 157A, 157B, 164

Description: Exterior Pair, Mech/Elect, Exit

6 Hinge (stainless heavy weight)	T4A3386 NRP (size as required)	US26D	MK	087100
1 Removable Mullion	KRM200	600	YA	087100
1 Exit Device (rim, exit only)	7150 EO ECK1	630	YA	087100
1 Exit Device (rim, nightlatch)	7150F MO627F K600 ECK1	630	YA	087100
1 Cylinder	K6 Series	626	YA	087100
2 Surface Closer (CPS)	4430	689	YA	087100
2 Kick Plate	K1050 10" high x 1" LDW SA BEV	US32D	RO	
1 Threshold	253x3AFG		PE	087100
1 Gasketing	2891APK		PE	087100
1 Rain Guard	346C TKSP		PE	087100
2 Sweep	345APK TKSP		PE	087100
2 Astragal	29310CP TKSP		PE	087100

Notes: Template closer and exit device for weatherstrip mounting. Install weatherstrip on frame prior to installing closer or exit device strike to provide a continuous seal.

# Set: 3.1

Doors: 163B

Description: Exterior Pair, Mech/Elect, Exit - CR

6 Hinge (stainless heavy weight)	T4A3386 NRP (size as required)	US26D	MK 087100	
1 Removable Mullion	KRM200	600	YA 087100	
1 Electric Exit Device (rim, fail secure)	7150 B S MO691F K620 ECK1	630	YA 087100	4
1 Exit Device (rim, exit only)	7150 EO ECK1	630	YA 087100	
2 Cylinder	K6 Series	626	YA 087100	
2 Surface Closer (CPS)	4430	689	YA 087100	
2 Kick Plate	K1050 10" high x 1" LDW SA BEV	US32D	RO	
1 Threshold	253x3AFG		PE 087100	
1 Gasketing	2891APK		PE 087100	
1 Rain Guard	346C TKSP		PE 087100	
2 Sweep	345APK TKSP		PE 087100	
1 Astragal	29310CP TKSP		PE 087100	
1 ElectroLynx Harness (frame)	QC-C_ (size as required)		MK 087100	4
1 ElectroLynx Harness (door)	QC-C_ (size as required)		MK 087100	4
1 Electric Power Transfer	EL-CEPT		SU 087100	4
1 Card Reader	Card Reader by Security		OT	
2 Position Switch	DPS-M-BK		SU 087100	4
1 Power Supply	AQD		SU 087100	4

Notes: Template closer and exit device for weatherstrip mounting. Install weatherstrip on frame prior to installing closer or exit device strike to provide a continuous seal.

# Operation:

- 1. Door normally closed and locked. Access is obtained by valid credential or key override. Locksets mechanically lock during power failure.
- 2. Free egress from inside by depressing inside lever.
- 3. Request to exit switch in lever to signal authorized egress to the access control system.
- 4. Door position switch to signal door open/closed to the access control system.

#### **Set: 4.0**

Doors: 143

Description: Exterior Single, Riser

3 Hinge (stainless) TA2314 NRP (size as required) US26D MK 087100

#### CITY OF PHARR/PSJA AQUATIC FACILITY 971805

<ul><li>1 Storeroom or Closet Lock</li><li>1 Surface Closer (CPS)</li></ul>	MO 4705LN 497 K600 4430	626 689	YA 087100 YA 087100
1 Kick Plate	K1050 10" high x 2" LDW CSK BEV	US32D	RO 087100
1 Threshold	253x3AFG		PE 087100
1 Gasketing	2891APK		PE 087100
1 Rain Guard	346C TKSP		PE 087100
1 Sweep	345APK TKSP		PE 087100

Notes: Template closer for weatherstrip mounting. Install weatherstrip on frame prior to installing closer to provide a continuous seal.

# **Set: 5.0**

**Doors: 166** 

Description: Exterior Single, Acid Room, SRI - CR

3 Hinge (stainless)	TA2314 NRP (size as required)	US26D	MK 087100	
1 Fail Secure Lock	MO 4791LN 497 K600	626	YA 087100	4
1 Cylinder	K6 Series	626	YA 087100	
1 Door Closer	SRI 281 CPS	EN	SA 087100	
1 Kick Plate	K1050 10" high x 2" LDW SA BEV	US32D	RO	
1 Threshold	253x3AFG		PE 087100	
1 Gasketing	2891APK		PE 087100	
1 Rain Guard	346C TKSP		PE 087100	
1 Sweep	345APK TKSP		PE 087100	
1 ElectroLynx Harness (frame)	QC-C_ (size as required)		MK 087100	4
1 ElectroLynx Harness (door)	QC-C_ (size as required)		MK 087100	4
1 Electric Power Transfer	EL-CEPT		SU 087100	4
1 Card Reader	Card Reader by Security		OT	
1 Position Switch	DPS-M-BK		SU 087100	4
1 Power Supply	AQD		SU 087100	4

Notes: Template closer and for weatherstrip mounting. Install weatherstrip on frame prior to installing closer to provide a continuous seal.

# Set: 6.0

Doors: 102B, 103A, 103B

Description: Interior Pair, Vestibule

<ul><li>2 Continuous Hinge</li><li>2 Door Pull</li><li>2 Push Bar</li><li>2 Surface Closer (CPS)</li></ul>	CFM_SLI-HD1 (size as required) RM3300-24 Mtg-Type 12XHD RM3102 Mtg-Type 12XHD 4430	US32D US32D 689	PE 087100 RO 087100 RO 087100 YA 087100	
	<u>Set: 6.1</u>			
Doors: 102A	<u>561. 0.1</u>			
Description: Interior Pair, Vestibule				
2 Continuous Hinge	CFM_SLI-HD1 (size as required)		PE 087100	
2 Door Pull	RM3300-24 Mtg-Type 12XHD	US32D	RO 087100	
2 Push Bar	RM3102 Mtg-Type 12XHD	US32D	RO 087100	
1 Conc Overhead Stop	6ADJ-X36	630	RF 087100	
2 Surface Closer (CPS)	4430	689	YA 087100	
1 Door Operator (Single)	6061	689	NO 087100	4
1 Door Switch	501		NO 087100	4
1 Door Switch (vestibule)	504		NO 087100	4
	<u>Set: 7.0</u>			
Doors: 103 D, 103C				
Description: Interior Pair, Vestibule	, SRI			
2 Continuous Hinge	CFM_SLI-HD1 (size as required)		PE 087100	
2 Door Pull	RM3300-24 Mtg-Type 12XHD	US32D	RO 087100	
2 Push Bar	RM3102 Mtg-Type 12XHD	US32D	RO 087100	
2 Door Closer	SRI 281 CPS	EN	SA 087100	
	Set: 8.0			
Doors: 106A, 117A, 117C	<del></del>			
Description: Interior Pair, Corridor,	CR HO			
6 Hinge (heavy weight)	T4A3786 NRP (size as required)	US26D	MK 087100	
1 Removable Mullion	KRM200	600	YA 087100	
1 Electric Exit Device (rim, fail secure)	7150 B S MO691F K620 ECK1	630	YA 087100	4
1 Exit Device (rim, exit only)	7150 EO ECK1	630	YA 087100	

4430T

**BEV** 

K1050 10" high x 1" LDW CSK

2 Kick Plate

2 Surface Closer (CPSH)

YA 087100

RO 087100

689

US32D

2 Wall Stop	406	US26D	RO 087100	
1 Gasketing	S88BL		PE 087100	
1 ElectroLynx Harness (frame)	QC-C_ (size as required)		MK 087100	4
1 ElectroLynx Harness (door)	QC-C_ (size as required)		MK 087100	4
1 Electric Power Transfer	EL-CEPT		SU 087100	4
1 Card Reader	Card Reader by Security		OT	
2 Position Switch	DPS-M-BK		SU 087100	4
1 Power Supply	AQD		SU 087100	4

### Notes: Operation:

- 1. Door normally closed, latched and locked. Access is obtained from the secure side by valid credential or key override. In the event of power failure door mechanically locks.
- 2. Free egress from the interior by depressing inside push pad.
- 3. Request to exit switch in push pad signals authorized egress to the access control system.
- 4. Door position switch signals door/open closed to access control system.
- 5. Contact switch in latch mechanism ensures positive strike.

# **Set: 9.0**

Doors: 105, 116, 132A, 132B, 137A

Description: Interior Single, Admin/Concession, CR

3 Hinge	TA2714 (size as required)	US26D	MK 087100	
1 Fail Secure Lock	MO 4791LN 497 K600	626	YA 087100	4
1 Surface Closer	R4400	689	YA 087100	
1 Kick Plate	K1050 10" high x 2" LDW CSK BEV	US32D	RO 087100	
1 Wall Stop	406	US26D	RO 087100	
1 Gasketing	S88BL		PE 087100	
1 ElectroLynx Harness (frame)	QC-C_ (size as required)		MK 087100	4
1 ElectroLynx Harness (door)	QC-C_ (size as required)		MK 087100	4
1 Electric Power Transfer	EL-CEPT		SU 087100	4
1 Card Reader	Card Reader by Security		OT	
1 Position Switch	DPS-M-BK		SU 087100	4
1 Motion Sensor	XMS		SU 087100	4
1 Power Supply	AQD		SU 087100	4

#### Notes: Operation:

1. Door normally closed and locked. Access is obtained by valid credential or key override. Locksets mechanically lock during power failure.

- 2. Free egress from inside by depressing inside lever.
- 3. Door position switch to signal door open/closed to the access control system.
- 4. Motion sensor to signal authorized egress to the access control system.

#### **Set: 10.0**

Doors: 144, 159A, 168

Description: Interior Single, Pool, CR SRI

3 Hinge (stainless)	TA2314 (size as required)	US26D	MK 087100	
1 Fail Secure Lock	MO 4791LN 497 K600	626	YA 087100	4
1 Door Closer	SRI 281 O	EN	SA 087100	
1 Kick Plate	K1050 10" high x 2" LDW SA BEV	US32D	RO	
1 Wall Stop	406	US26D	RO 087100	
3 Silencer	608-RKW		RO 087100	
1 ElectroLynx Harness (frame)	QC-C_ (size as required)		MK 087100	4
1 ElectroLynx Harness (door)	QC-C_ (size as required)		MK 087100	4
1 Electric Power Transfer	EL-CEPT		SU 087100	4
1 Card Reader	Card Reader by Security		OT	
1 Position Switch	DPS-M-BK		SU 087100	4
1 Motion Sensor	XMS		SU 087100	4
1 Power Supply	AQD		SU 087100	4

#### **Notes: Operation:**

- 1. Door normally closed and locked. Access is obtained by valid credential or key override. Locksets mechanically lock during power failure.
- 2. Free egress from inside by depressing inside lever.
- 3. Door position switch to signal door open/closed to the access control system.
- 4. Motion sensor to signal authorized egress to the access control system.

#### **Set: 11.0**

Doors: 142

Description: Interior Pair, Storage

6 Hinge	TA2714 NRP (size as required)	US26D	MK 087100
2 Flush Bolt	555	US26D	RO 087100
1 Dust Proof Strike	570	US26D	RO 087100
1 Storeroom or Closet Lock	MO 4705LN 497 K600	626	YA 087100
1 Surface Closer	PR4400	689	YA 087100
2 Kick Plate	K1050 10" high x 1" LDW CSK	US32D	RO 087100

	BEV		
2 Wall Stop	406	US26D	RO 087100
2 Astragal	29310CP TKSP		PE 087100
2 Silencer	608-RKW		RO 087100
	<b>Set: 12.0</b>		
Doors: 162			
Description: Exterior Pair, Mech			
6 Hinge (stainless)	TA2314 NRP (size as required)	US26D	MK 087100
2 Flush Bolt	555	US26D	RO 087100
1 Dust Proof Strike	570	US26D	RO 087100
1 Storeroom or Closet Lock	MO 4705LN 497 K600	626	YA 087100
1 Surface Closer (CPS)	4430	689	YA 087100
2 Kick Plate	K1050 10" high x 1" LDW CSK BEV	US32D	RO 087100
2 Wall Stop	406	US26D	RO 087100
1 Threshold	253x3AFG		PE 087100
1 Gasketing	2891APK		PE 087100
1 Rain Guard	346C TKSP		PE 087100
2 Sweep	345APK TKSP		PE 087100
2 Astragal	29310CP TKSP		PE 087100

Notes: Template closer for weatherstrip mounting. Install weatherstrip on frame prior to installing closer to provide a continuous seal.

# Set: 13.0

Doors: 165

Description: Exterior Pair, Calcium Hypo, SRI - CR

6 Hinge (stainless)	TA2314 NRP (size as required)	US26D	MK 087100	
2 Flush Bolt	555	US26D	RO 087100	
1 Dust Proof Strike	570	US26D	RO 087100	
1 Fail Secure Lock	MO 4791LN 497 K600	626	YA 087100	4
1 Cylinder	K6 Series	626	YA 087100	
1 Door Closer	SRI 281 CPS	EN	SA 087100	
2 Kick Plate	K1050 10" high x 1" LDW SA BEV	US32D	RO	
1 Threshold	253x3AFG		PE 087100	
1 Gasketing	2891APK		PE 087100	

1 Rain Guard	346C TKSP	PE 087100	
2 Sweep	345APK TKSP	PE 087100	
2 Astragal	29310CP TKSP	PE 087100	
1 ElectroLynx Harness (frame)	QC-C_ (size as required)	MK 087100	4
1 ElectroLynx Harness (door)	QC-C_ (size as required)	MK 087100	4
1 Electric Power Transfer	EL-CEPT	SU 087100	4
1 Card Reader	Card Reader by Security	OT	
1 Position Switch	DPS-M-BK	SU 087100	4
1 Power Supply	AQD	SU 087100	4

Notes: Template closer for weatherstrip mounting. Install weatherstrip on frame prior to installing closer to provide a continuous seal.

# **Set: 14.0**

Doors: 167

Description: Interior Pair, Storage, SRI

6 Hinge (stainless)	TA2314 (size as required)	US26D	MK 087100
2 Flush Bolt	555	US26D	RO 087100
1 Dust Proof Strike	570	US26D	RO 087100
1 Storeroom or Closet Lock	MO 4705LN 497 K600	626	YA 087100
1 Door Closer	SRI 281 O	EN	SA 087100
2 Kick Plate	K1050 10" high x 2" LDW SA BEV	US32D	RO
2 Wall Stop	406	US26D	RO 087100
1 Threshold	1665A		PE 087100
2 Astragal	29310CP TKSP		PE 087100
2 Silencer	608-RKW		RO 087100

# **Set: 15.0**

Doors: 133

Description: Interior Single, Storage

3 Hinge	TA2714 (size as required)	US26D	MK 087100
1 Storeroom or Closet Lock	MO 4705LN 497 K600	626	YA 087100
1 Surface Closer	R4400	689	YA 087100
1 Kick Plate	K1050 10" high x 2" LDW CSK BEV	US32D	RO 087100
1 Wall Stop	406	US26D	RO 087100

3 Silencer	608-RKW	RO 087100

**Set: 16.0** 

Doors: 129

Description: Interior Single, Elevator SRI

3 Hinge (stainless)	TA2314 (size as required)	US26D	MK 087100
1 Storeroom or Closet Lock	MO 4705LN 497 K600	626	YA 087100
1 Door Closer	SRI 281 O	EN	SA 087100
1 Kick Plate	K1050 10" high x 2" LDW SA BEV	US32D	RO
3 Silencer	608-RKW		RO 087100

Set: 17.0

Doors: 114, 125, 126

Description: Single Interior, Elect/IT

3 Hinge	TA2714 (size as required)	US26D	MK 087100
1 Storeroom or Closet Lock	MO 4705LN 497 K600	626	YA 087100
1 Surface Closer	R4400	689	YA 087100
1 Kick Plate	K1050 10" high x 2" LDW CSK BEV	US32D	RO 087100
1 Wall Stop	406	US26D	RO 087100
1 Gasketing	S88BL		PE 087100

**Set: 18.0** 

Doors: 145, 163A, 163C

Description: Interior Single, Storage/Yard, SRI

3 Hinge (stainless)	TA2314 NRP (size as required)	US26D	MK 087100
1 Storeroom or Closet Lock	MO 4705LN 497 K600	626	YA 087100
1 Door Closer	SRI 281 CPS	EN	SA 087100
1 Kick Plate	K1050 10" high x 2" LDW SA BEV	US32D	RO
3 Silencer	608-RKW		RO 087100

**Set: 19.0** 

Doors: 108, 109, 11 0, 111, 112, 119, 120, 121, 122, 124

Description: Interior Single, Coach/Conference

3 Hinge TA2714 (size as required) US26D MK 087100

1 Entry Lock	MO 4707LN 497 K600	626	YA 087100
1 Kick Plate	K1050 10" high x 2" LDW CSK BEV	US32D	RO 087100
1 Wall Stop	406	US26D	RO 087100
1 Gasketing	S88BL		PE 087100

# **Set: 20.0**

Doors: 147, 151

Description: Interior Single, Coach, SRI

3 Hinge (stainless)	TA2314 (size as required)	US26D	MK 087100
1 Entry Lock	MO 4707LN 497 K600	626	YA 087100
1 Wall Stop	406	US26D	RO 087100
3 Silencer	608-RKW		RO 087100

# Set: 21.0

Doors: 158

Description: Interior Single, First Aid, SRI

3 Hinge (stainless)	TA2314 (size as required)	US26D	MK 087100
1 Privacy Lock	MO 4702LN 497	626	YA 087100
1 Door Closer	DA SRI 281 O	EN	SA 087100
1 Armor Plate	K1050 34" high x 2" LDW SA BEV	US32D	RO
1 Wall Stop	406	US26D	RO 087100
1 Gasketing	S88BL		PE 087100

# **Set: 22.0**

Doors: 135A, 135B

Description: Interior Single, Conditioning

3 Hinge (heavy weight)	T4A3786 (size as required)	US26D	MK 087100
1 Deadbolt (classroom)	D261 K600	626	YA 087100
1 Offset Door Pull	RM3310-24 Mtg-Type 12XHD	US32D	RO 087100
1 Push Plate	70C-RKW	US32D	RO 087100
1 Surface Closer	R4400	689	YA 087100
1 Kick Plate	K1050 10" high x 2" LDW CSK BEV	US32D	RO 087100
1 Wall Stop	406	US26D	RO 087100
1 Gasketing	S88BL		PE 087100

# Set: 23.0

Doors: 205

Description: Interior Single, Private Viewing

3 Hinge	TA2714 (size as required)	US26D	MK 087100
1 Classroom Lock	MO 4708LN 497 K600	626	YA 087100
1 Surface Closer	R4400	689	YA 087100
1 Kick Plate	K1050 10" high x 2" LDW CSK BEV	US32D	RO 087100
1 Wall Stop	406	US26D	RO 087100
1 Gasketing	S88BL		PE 087100

# **Set: 24.0**

Doors: 137B

Description: Interior Single, Corridor, SRI

3 Hinge (stainless)	TA2314 NRP (size as required)	US26D	MK	087100
1 Classroom Lock	MO 4708LN 497 K600	626	YA	087100
1 Door Closer	SRI 281 CPS	EN	SA	087100
1 Kick Plate	K1050 10" high x 2" LDW SA BEV	US32D	RO	
3 Silencer	608-RKW		RO	087100

# Set: 25.0

Doors: 113, 123, 134, 206

Description: Interior Single, Restroom

3 Hinge	TA2714 (size as required)	US26D	MK 0	87100
1 Privacy Lock	MO 4702LN 497	626	YA 0	87100
1 Wall Stop	406	US26D	RO 0	87100
1 Gasketing	S88BL		PE 0	87100

# **Set: 26.0**

Doors: 149, 153

Description: Interior Single, Changing Room, SRI

3 Hinge (stainless)	TA2314 (size as required)	US26D	MK 087100
1 Privacy Lock	MO 4702LN 497	626	YA 087100
1 Wall Stop	406	US26D	RO 087100
3 Silencer	608-RKW		RO 087100

### Set: 27.0

Doors: 159B

Description: Interior Single, Trainer, SRI

3 Hinge (stainless)	TA2314 NRP (size as required)	US26D	MK 087100
1 Entry Lock	MO 4707LN 497 K600	626	YA 087100
1 Kick Plate	K1050 10" high x 2" LDW SA BEV	US32D	RO
1 Wall Stop	406	US26D	RO 087100
3 Silencer	608-RKW		RO 087100

### **Set: 28.0**

Doors: 155, 156

Description: Interior Single, Lifeguard Restroom, SRI

3 Hinge (stainless)	TA2314 (size as required)	US26D	MK 087100
1 Privacy Lock	MO 4702LN 497	626	YA 087100
1 Kick Plate	K1050 10" high x 2" LDW SA BEV	US32D	RO
1 Wall Stop	406	US26D	RO 087100
1 Gasketing	S88BL		PE 087100

### **Set: 29.0**

Doors: 140

Description: Interior Pair, Classroom

6 Hinge (heavy weight)	T4A3786 NRP (size as required)	US26D	MK 087100
1 Deadbolt (classroom)	D261 K600	626	YA 087100
2 Offset Door Pull	RM3310-24 Mtg-Type 12XHD	US32D	RO 087100
2 Push Plate	70C-RKW	US32D	RO 087100
2 Surface Closer	PR4400	689	YA 087100
2 Kick Plate	K1050 10" high x 2" LDW CSK BEV	US32D	RO 087100
2 Wall Stop	406	US26D	RO 087100
1 Gasketing	S88BL		PE 087100
1 Astragal	29310CP TKSP		PE 087100

### Set: 30.0

Doors: 154

Description: Interior Pair, Break, SRI

6 Hinge (stainless heavy weight)	T4A3386 NRP (size as required)	US26D	MK 087100
1 Deadbolt (classroom)	D261 K600	626	YA 087100
2 Offset Door Pull	RM3310-24 Mtg-Type 12XHD	US32D	RO 087100
2 Push Plate	70C-RKW	US32D	RO 087100
2 Door Closer	SRI 281 O	EN	SA 087100
2 Kick Plate	K1050 10" high x 1" LDW SA BEV	US32D	RO
2 Wall Stop	406	US26D	RO 087100
2 Astragal	29310CP TKSP		PE 087100
2 Silencer	608-RKW		RO 087100

### **Set: 31.0**

Doors: 146, 150

Description: Interior Single, Women/Men, SRI

3 Hinge (stainless heavy weight)	T4A3386 NRP (size as required)	US26D	MK 087100
1 Deadbolt (classroom)	D261 K600	626	YA 087100
1 Offset Door Pull	RM3310-24 Mtg-Type 12XHD	US32D	RO 087100
1 Push Plate	70C-RKW	US32D	RO 087100
1 Door Closer	SRI 281 CPS	EN	SA 087100
1 Kick Plate	K1050 10" high x 2" LDW SA BEV	US32D	RO
3 Silencer	608-RKW		RO 087100

#### **Set: 32.0**

Doors: 127

Description: Interior Pair, Corridor, SRI HO

6 Hinge (stainless heavy weight)	T4A3386 NRP (size as required)	US26D	MK	087100
1 Deadbolt (classroom)	D261 K600	626	YA	087100
2 Offset Door Pull	RM3310-24 Mtg-Type 12XHD	US32D	RO	087100
2 Push Plate	70C-RKW	US32D	RO	087100
2 Door Closer	SRI 281 CPSH	EN	SA	087100
2 Kick Plate	K1050 10" high x 1" LDW SA BEV	US32D	RO	
2 Astragal	29310CP TKSP		PE	087100
2 Silencer	608-RKW		RO	087100


### **Set: 33.0**

Doors: 148, 152

Description: Interior Single, Women/Men, SRI


3 Hinge (stainless heavy weight)	T4A3386 (size as required)	US26D	MK 087100
1 Door Pull	RM3300-24 Mtg-Type 12XHD	US32D	RO 087100
1 Push Plate	70C-RKW	US32D	RO 087100
1 Door Closer	SRI 281 CPS	EN	SA 087100
1 Kick Plate	K1050 10" high x 2" LDW SA BEV	US32D	RO
3 Silencer	608-RKW		RO 087100


**END OF SECTION** 

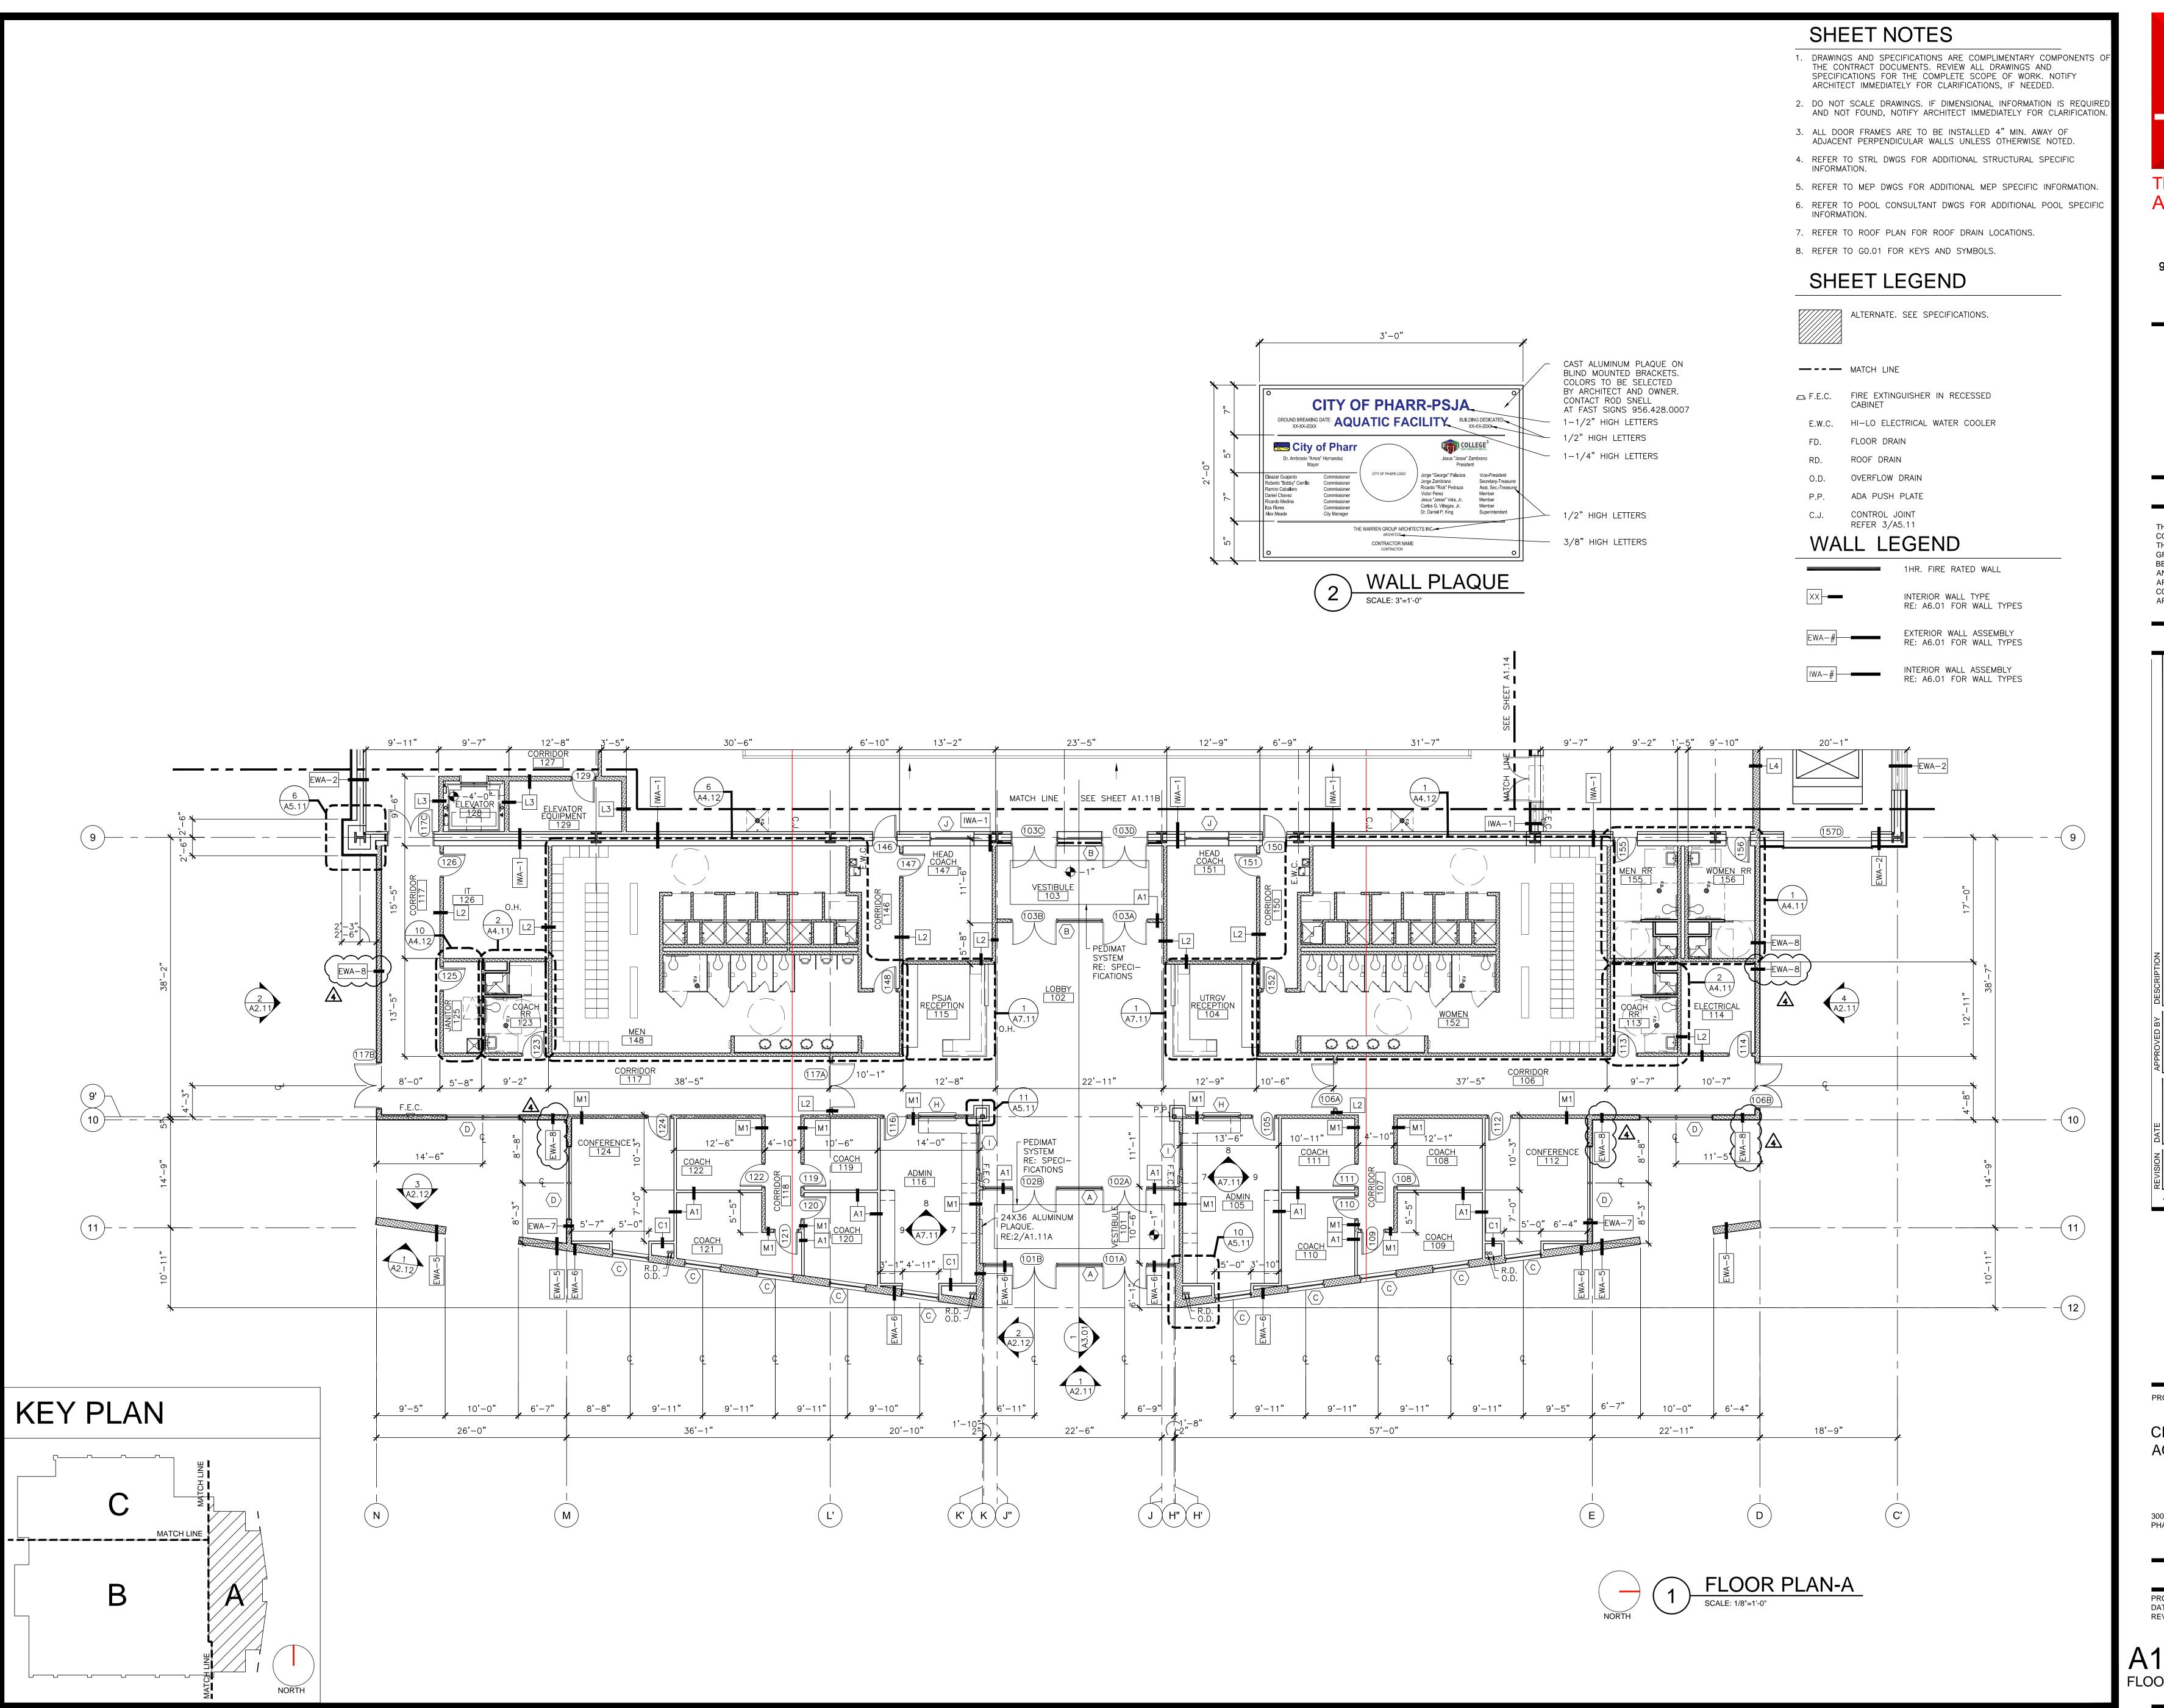



THESE DRAWINGS AND INFORMATION CONTAINED HEREIN ARE PROPERTY AND THE SOLE PROPERTY OF THE WARREN GROUP ARCHITECTS, INC. THEY MAY NOT BE REUSED, REPRODUCED OR ALTERED IN ANY WAY WITHOUT PRIOR WRITTEN APPROVAL FROM AND APPROPRIATE COMPENSATION TO THE WARREN GROUP ARCHITECTS INC.

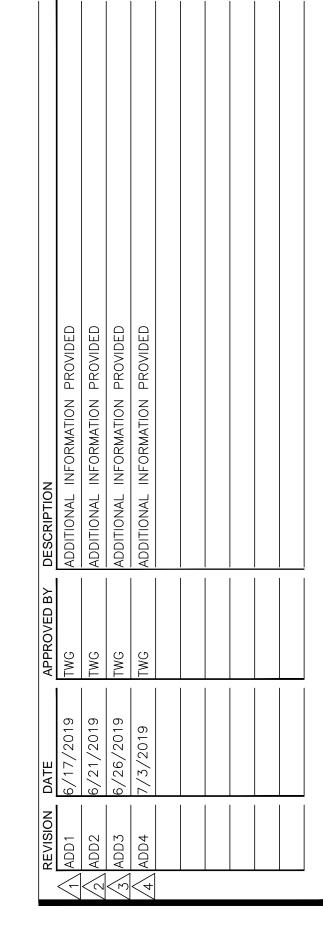

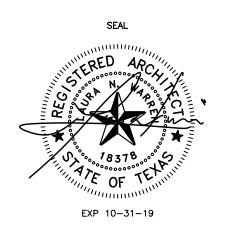


CITY OF PHARR/PSJA AQUATIC FACILITY

3001 N. CAGE BLVD PHARR, TEXAS 78577

971805 06/07/2019 07/03/2019


A1.11A ADD4 FLOOR PLAN-A

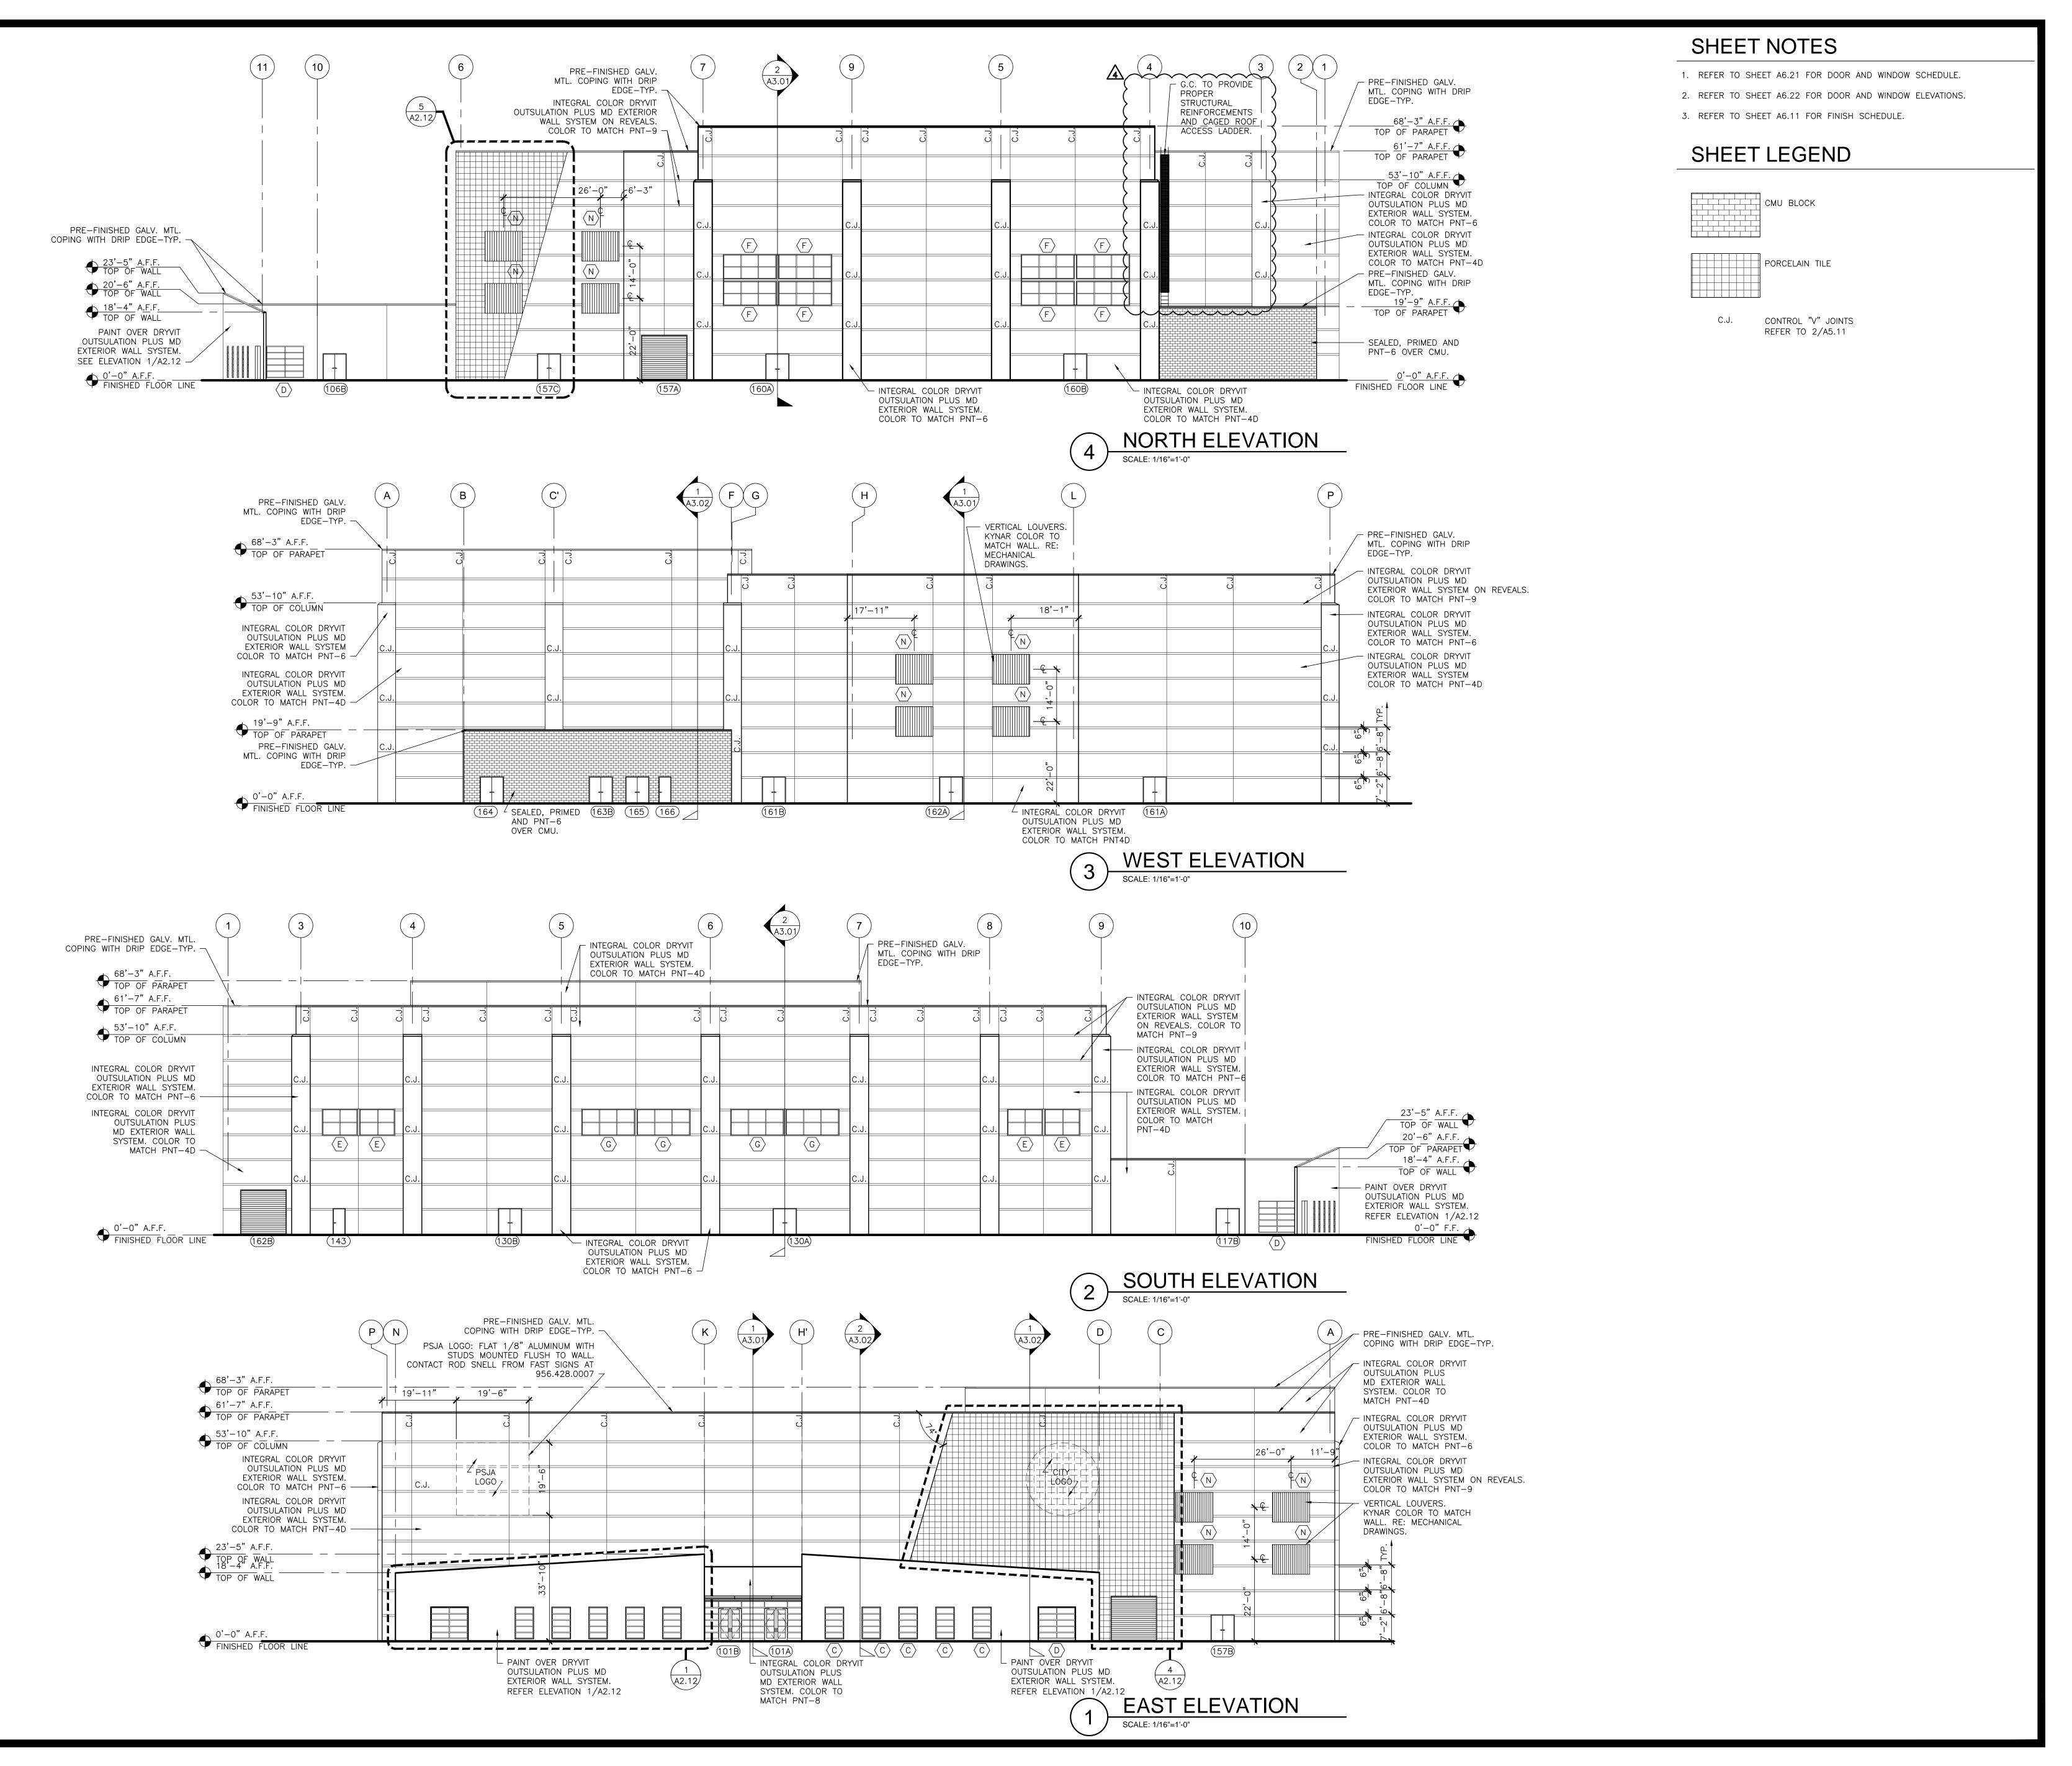




1801 SOUTH SECOND ST.
SUITE 330
McALLEN, TX 78503
9 5 6 . 9 9 4 . 1 9 0 0
t w g a r c h . c o m

THESE DRAWINGS AND INFORMATION CONTAINED HEREIN ARE PROPERTY AND THE SOLE PROPERTY OF THE WARREN GROUP ARCHITECTS, INC. THEY MAY NOT BE REUSED, REPRODUCED OR ALTERED IN ANY WAY WITHOUT PRIOR WRITTEN APPROVAL FROM AND APPROPRIATE COMPENSATION TO THE WARREN GROUP ARCHITECTS INC.

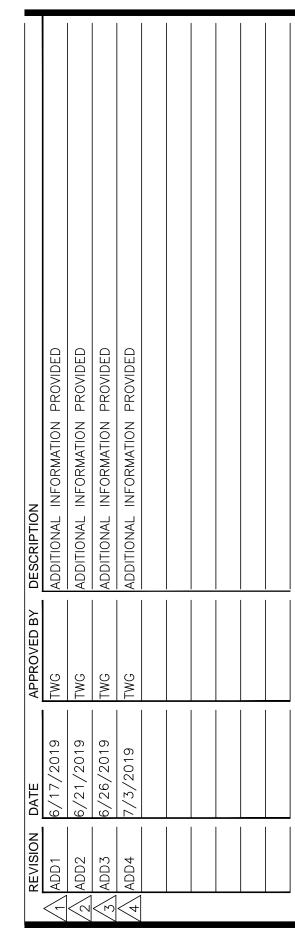

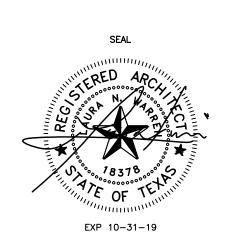


PROPOSED

CITY OF PHARR/PSJA AQUATIC FACILITY

3001 N. CAGE BLVD PHARR, TEXAS 78577

PROJECT 971805
DATE 06/07/2019
REVISED 07/03/2019


A2.11 ADD4
EXTERIOR ELEVATIONS

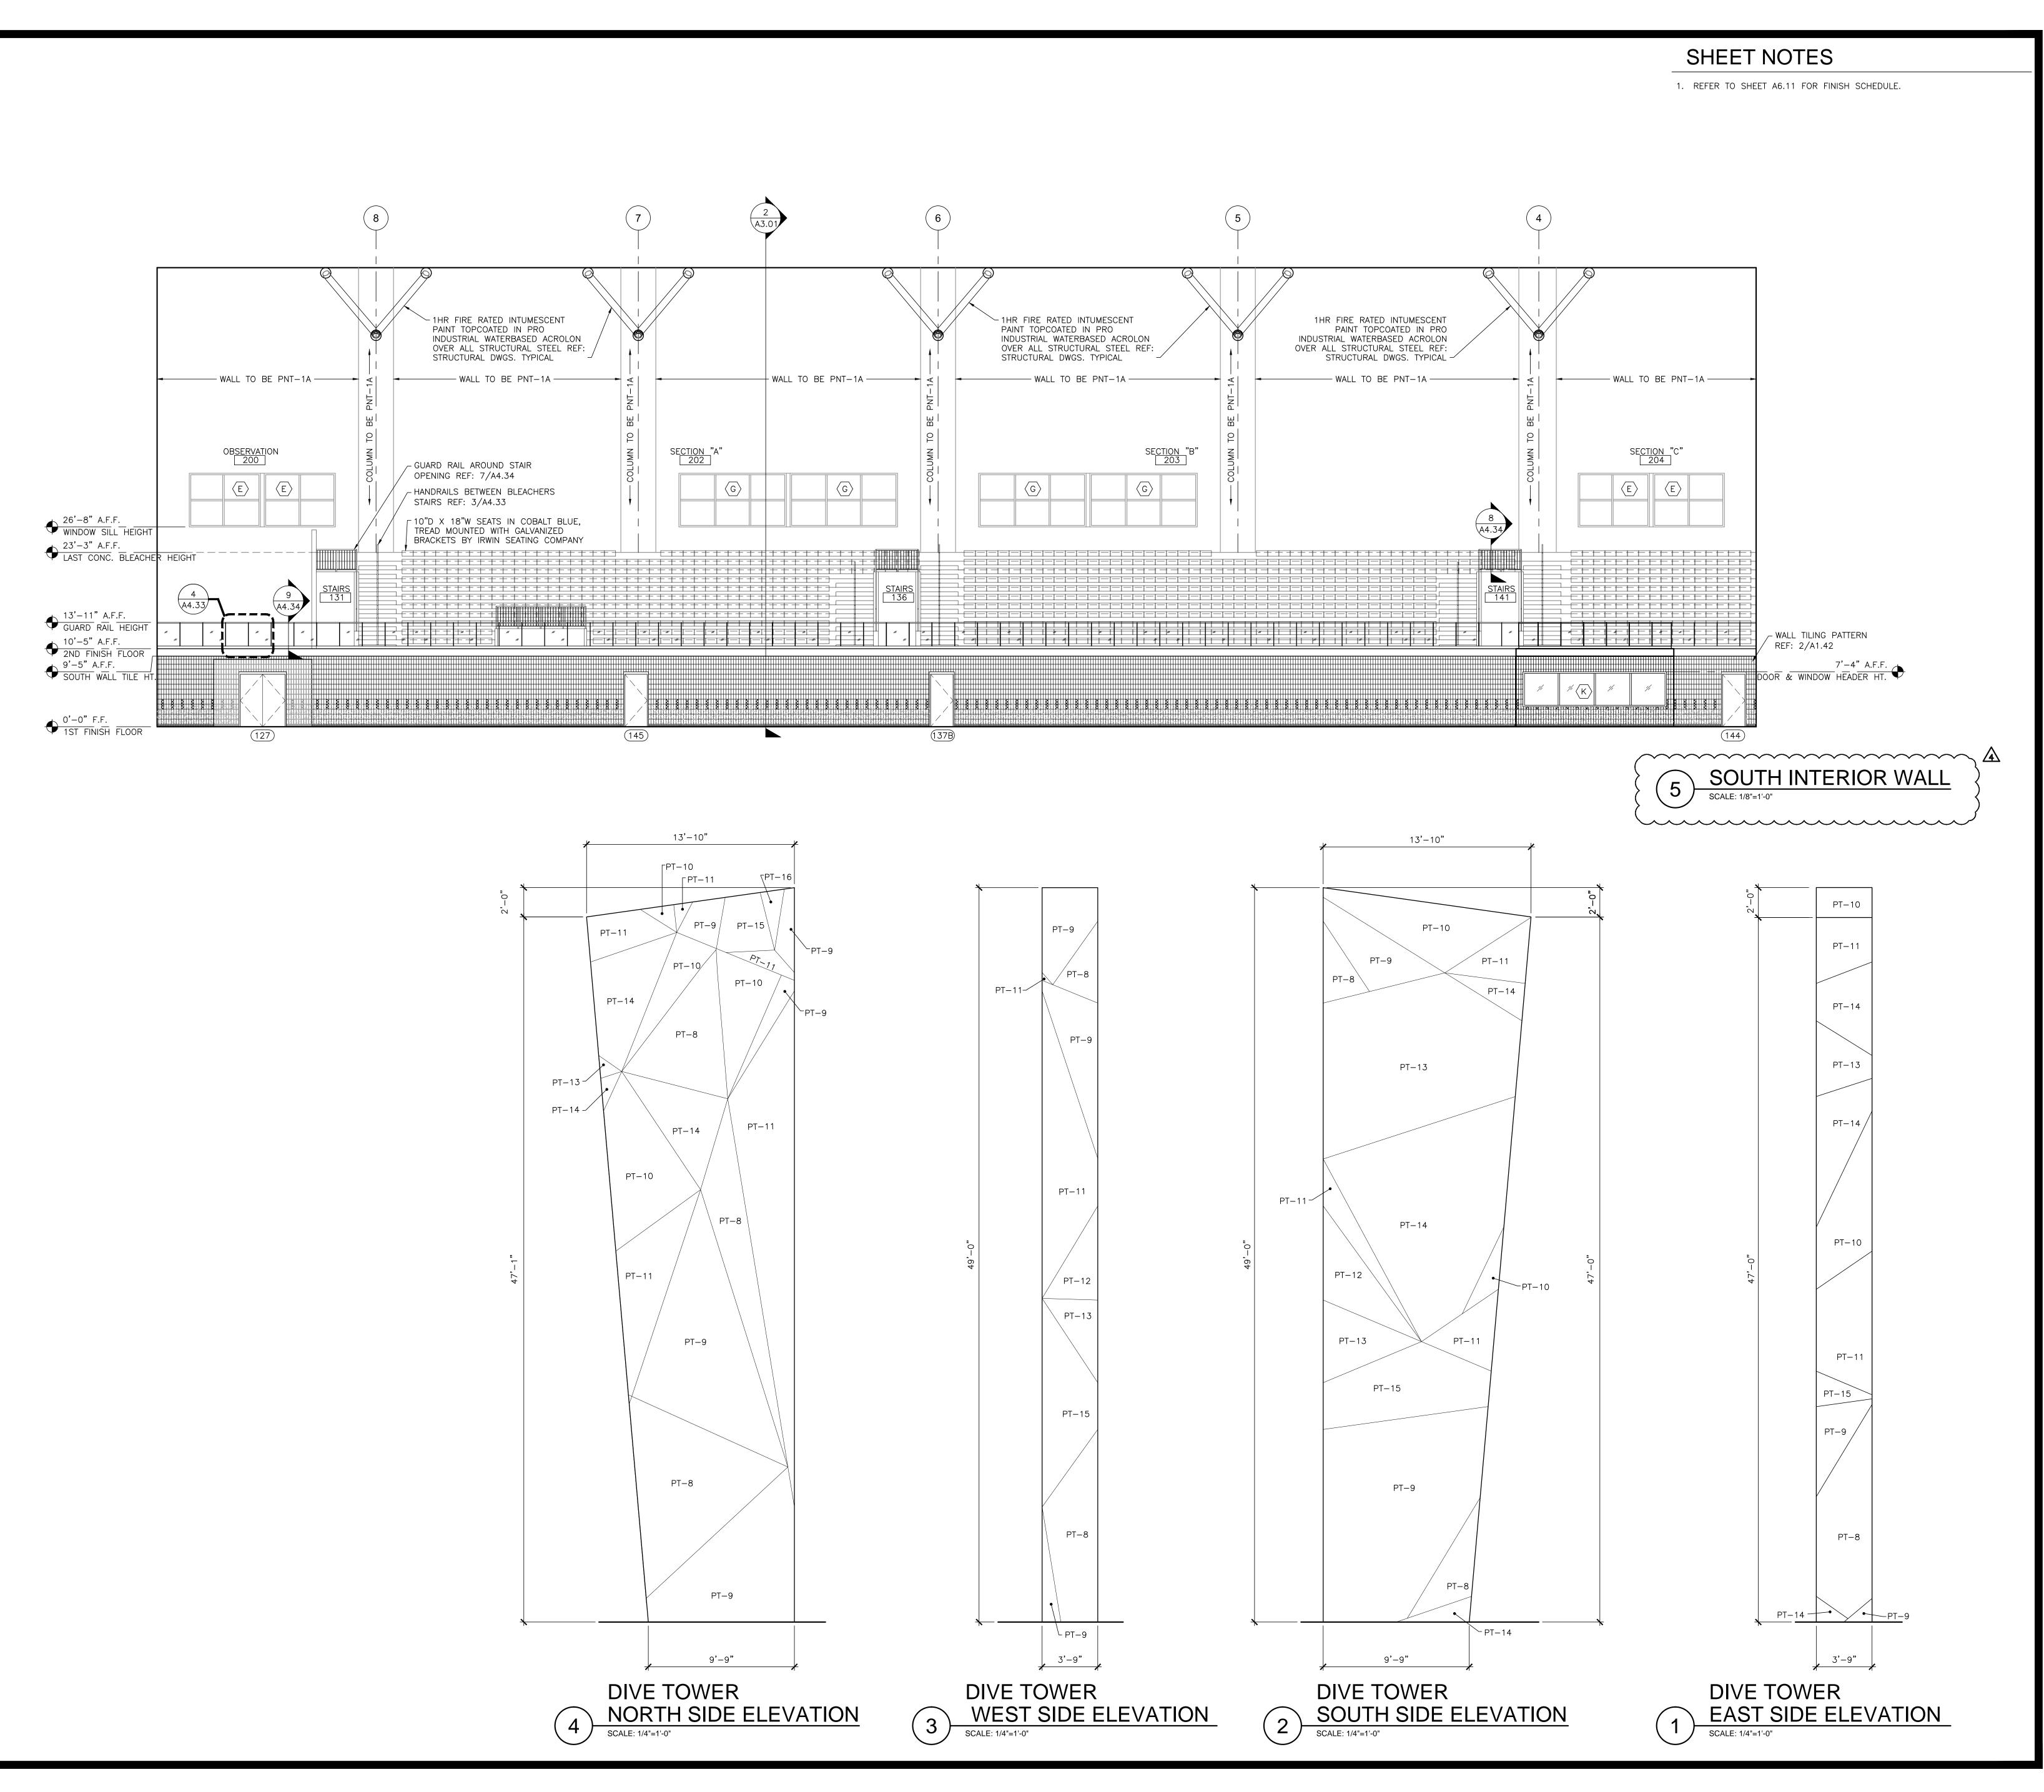




HESE DRAWINGS AND INFORMATION

THESE DRAWINGS AND INFORMATION CONTAINED HEREIN ARE PROPERTY AND THE SOLE PROPERTY OF THE WARREN GROUP ARCHITECTS, INC. THEY MAY NOT BE REUSED, REPRODUCED OR ALTERED IN ANY WAY WITHOUT PRIOR WRITTEN APPROVAL FROM AND APPROPRIATE COMPENSATION TO THE WARREN GROUP ARCHITECTS INC.

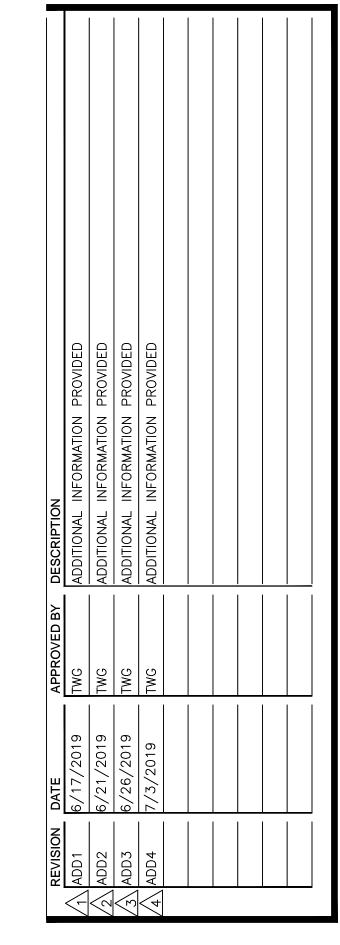

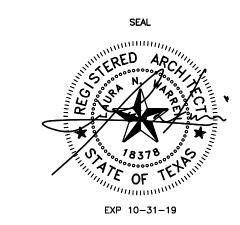


PROPOSE

CITY OF PHARR/PSJA AQUATIC FACILITY

3001 N. CAGE BLVD PHARR, TEXAS 78577


PROJECT 971805
DATE 06/07/2019
REVISED 07/03/2019


A2.13 ADD4
PARTIAL
ENLARGED ELEVATIONS

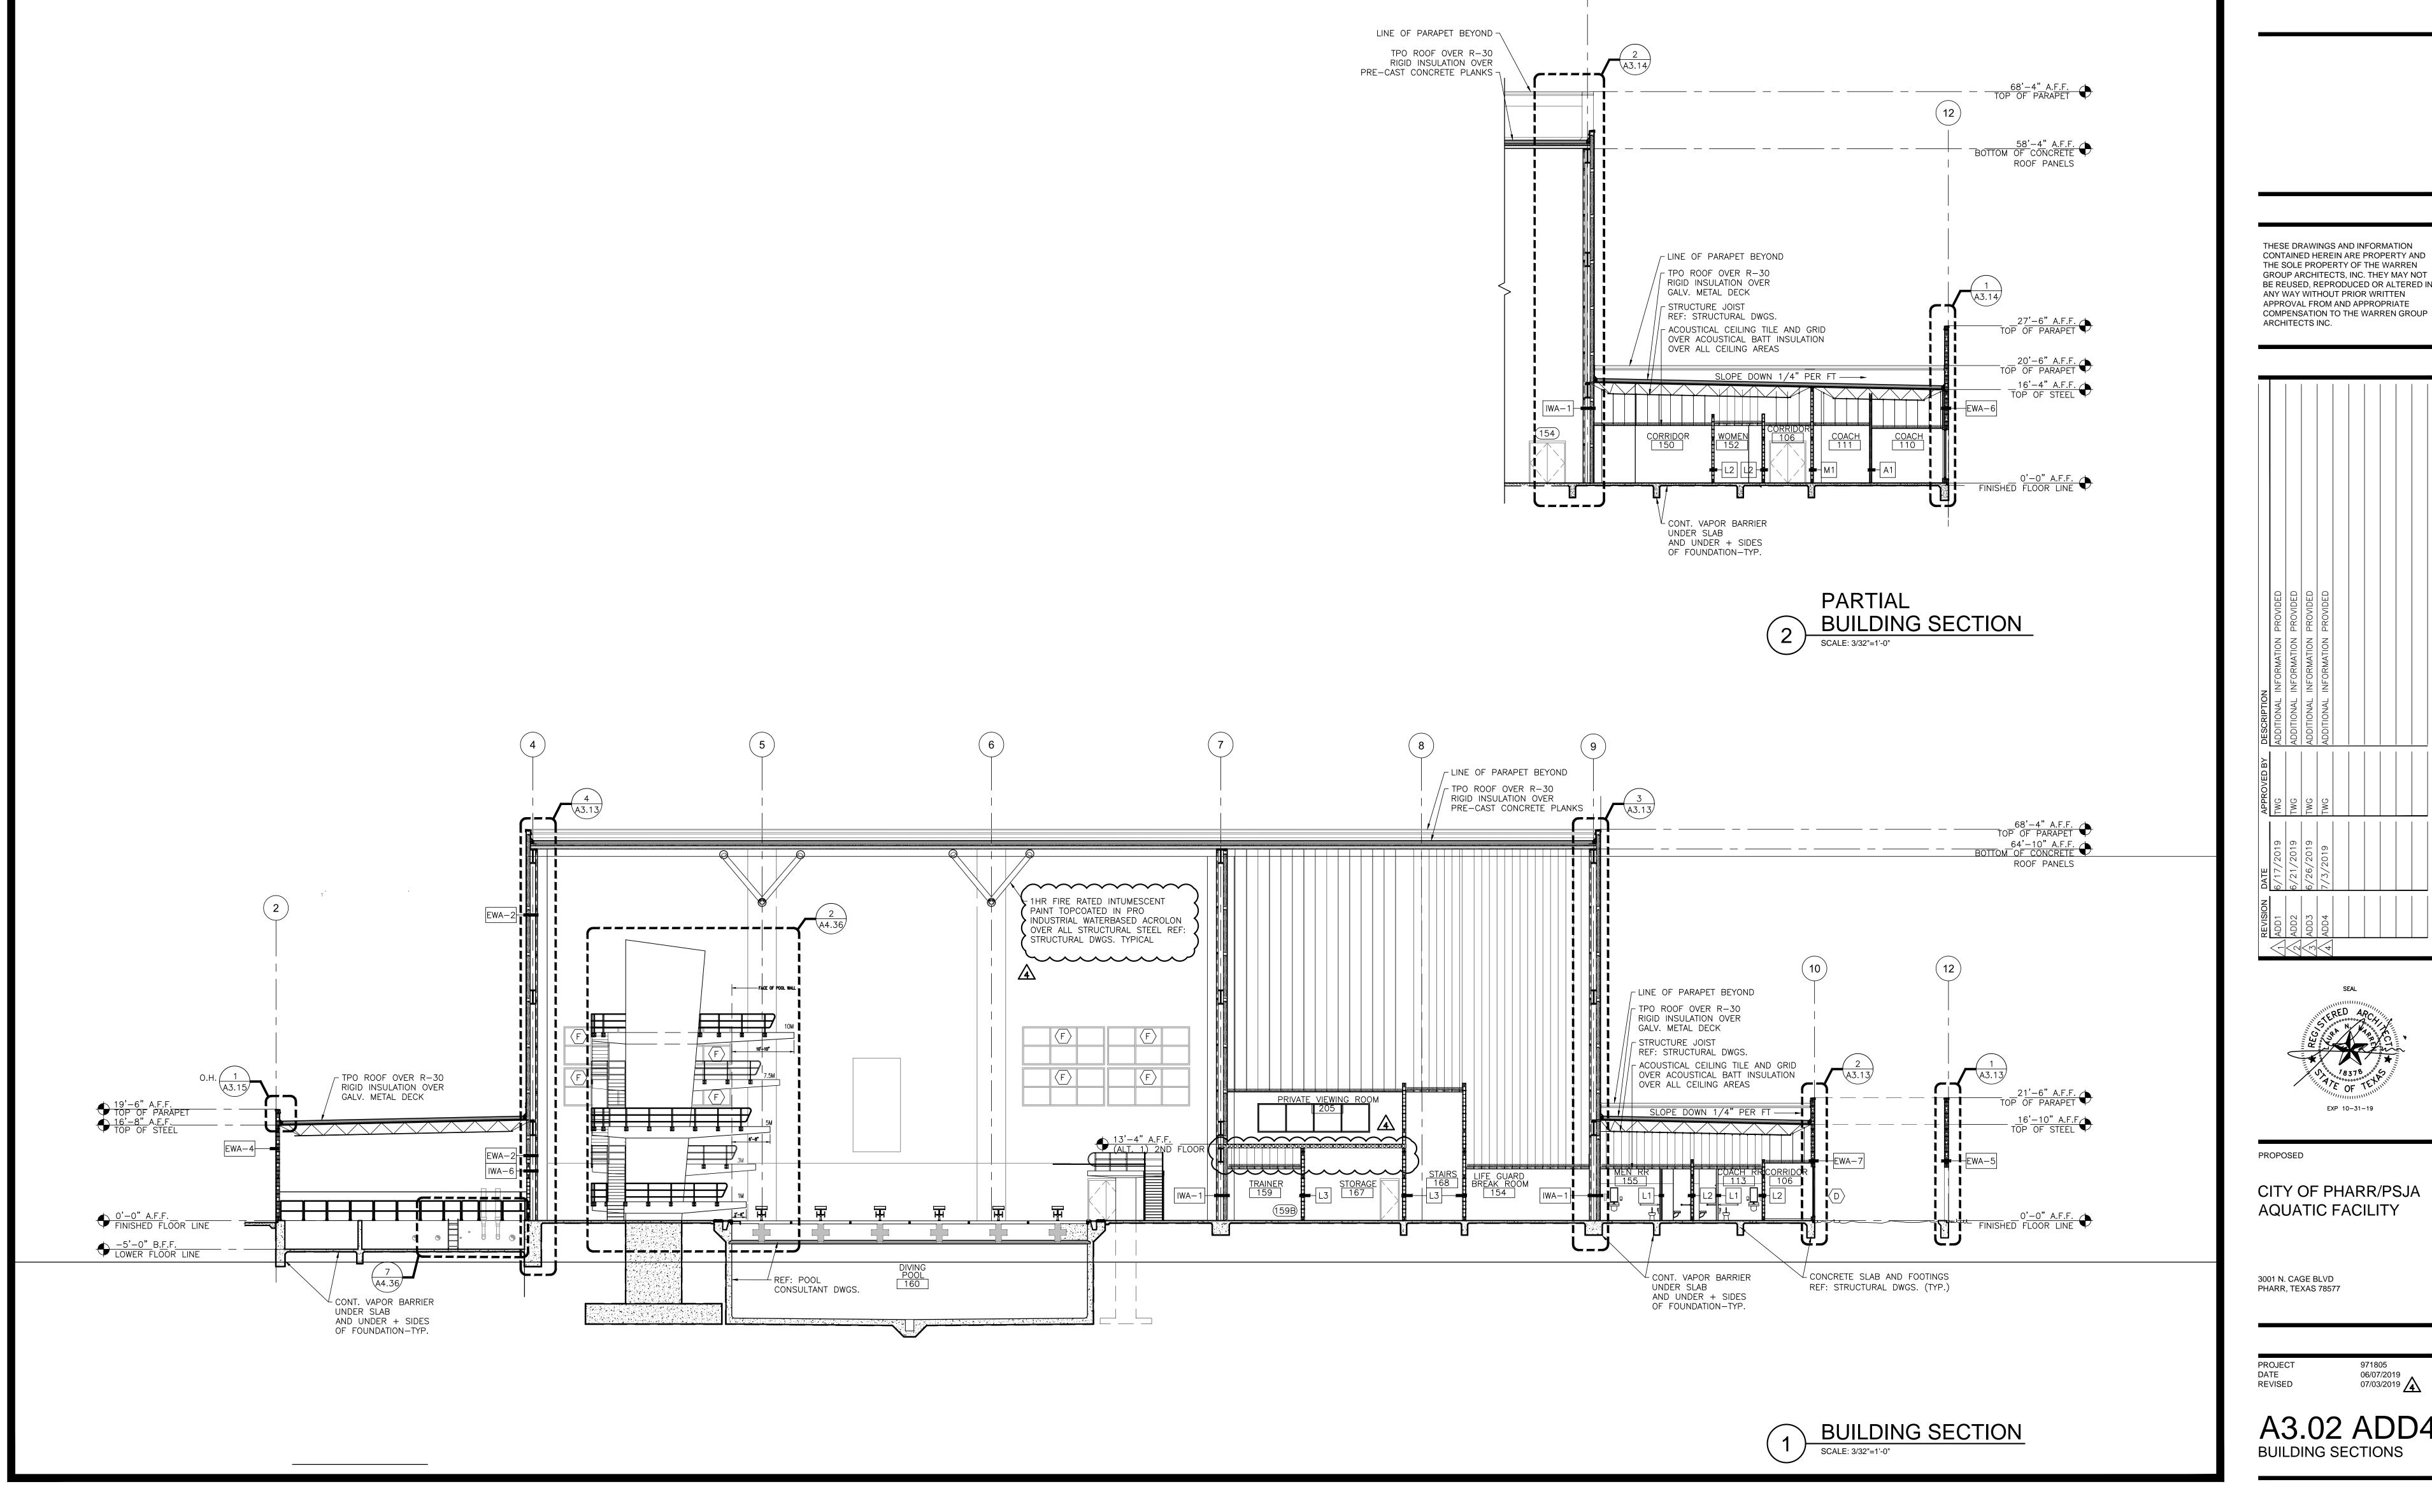



THESE DRAWINGS AND INFORMATION CONTAINED HEREIN ARE PROPERTY AND THE SOLE PROPERTY OF THE WARREN GROUP ARCHITECTS, INC. THEY MAY NOT BE REUSED, REPRODUCED OR ALTERED IN

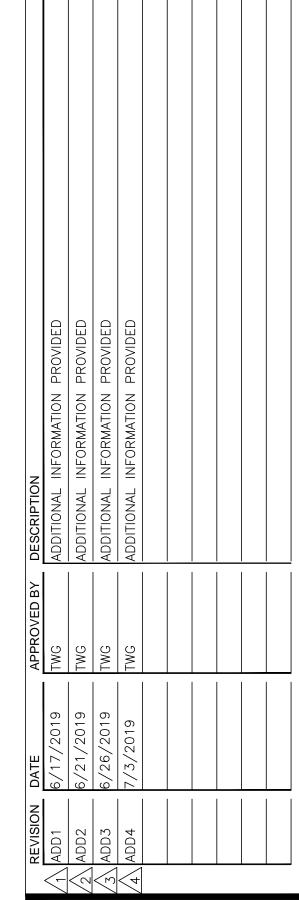

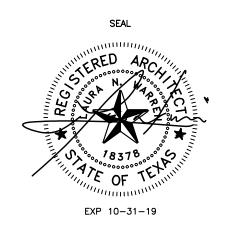

PROPOSED


CITY OF PHARR/PSJA AQUATIC FACILITY

3001 N. CAGE BLVD PHARR, TEXAS 78577

PROJECT DATE REVISED


A3.02 ADD4 **BUILDING SECTIONS** 


971805 06/07/2019 07/03/2019

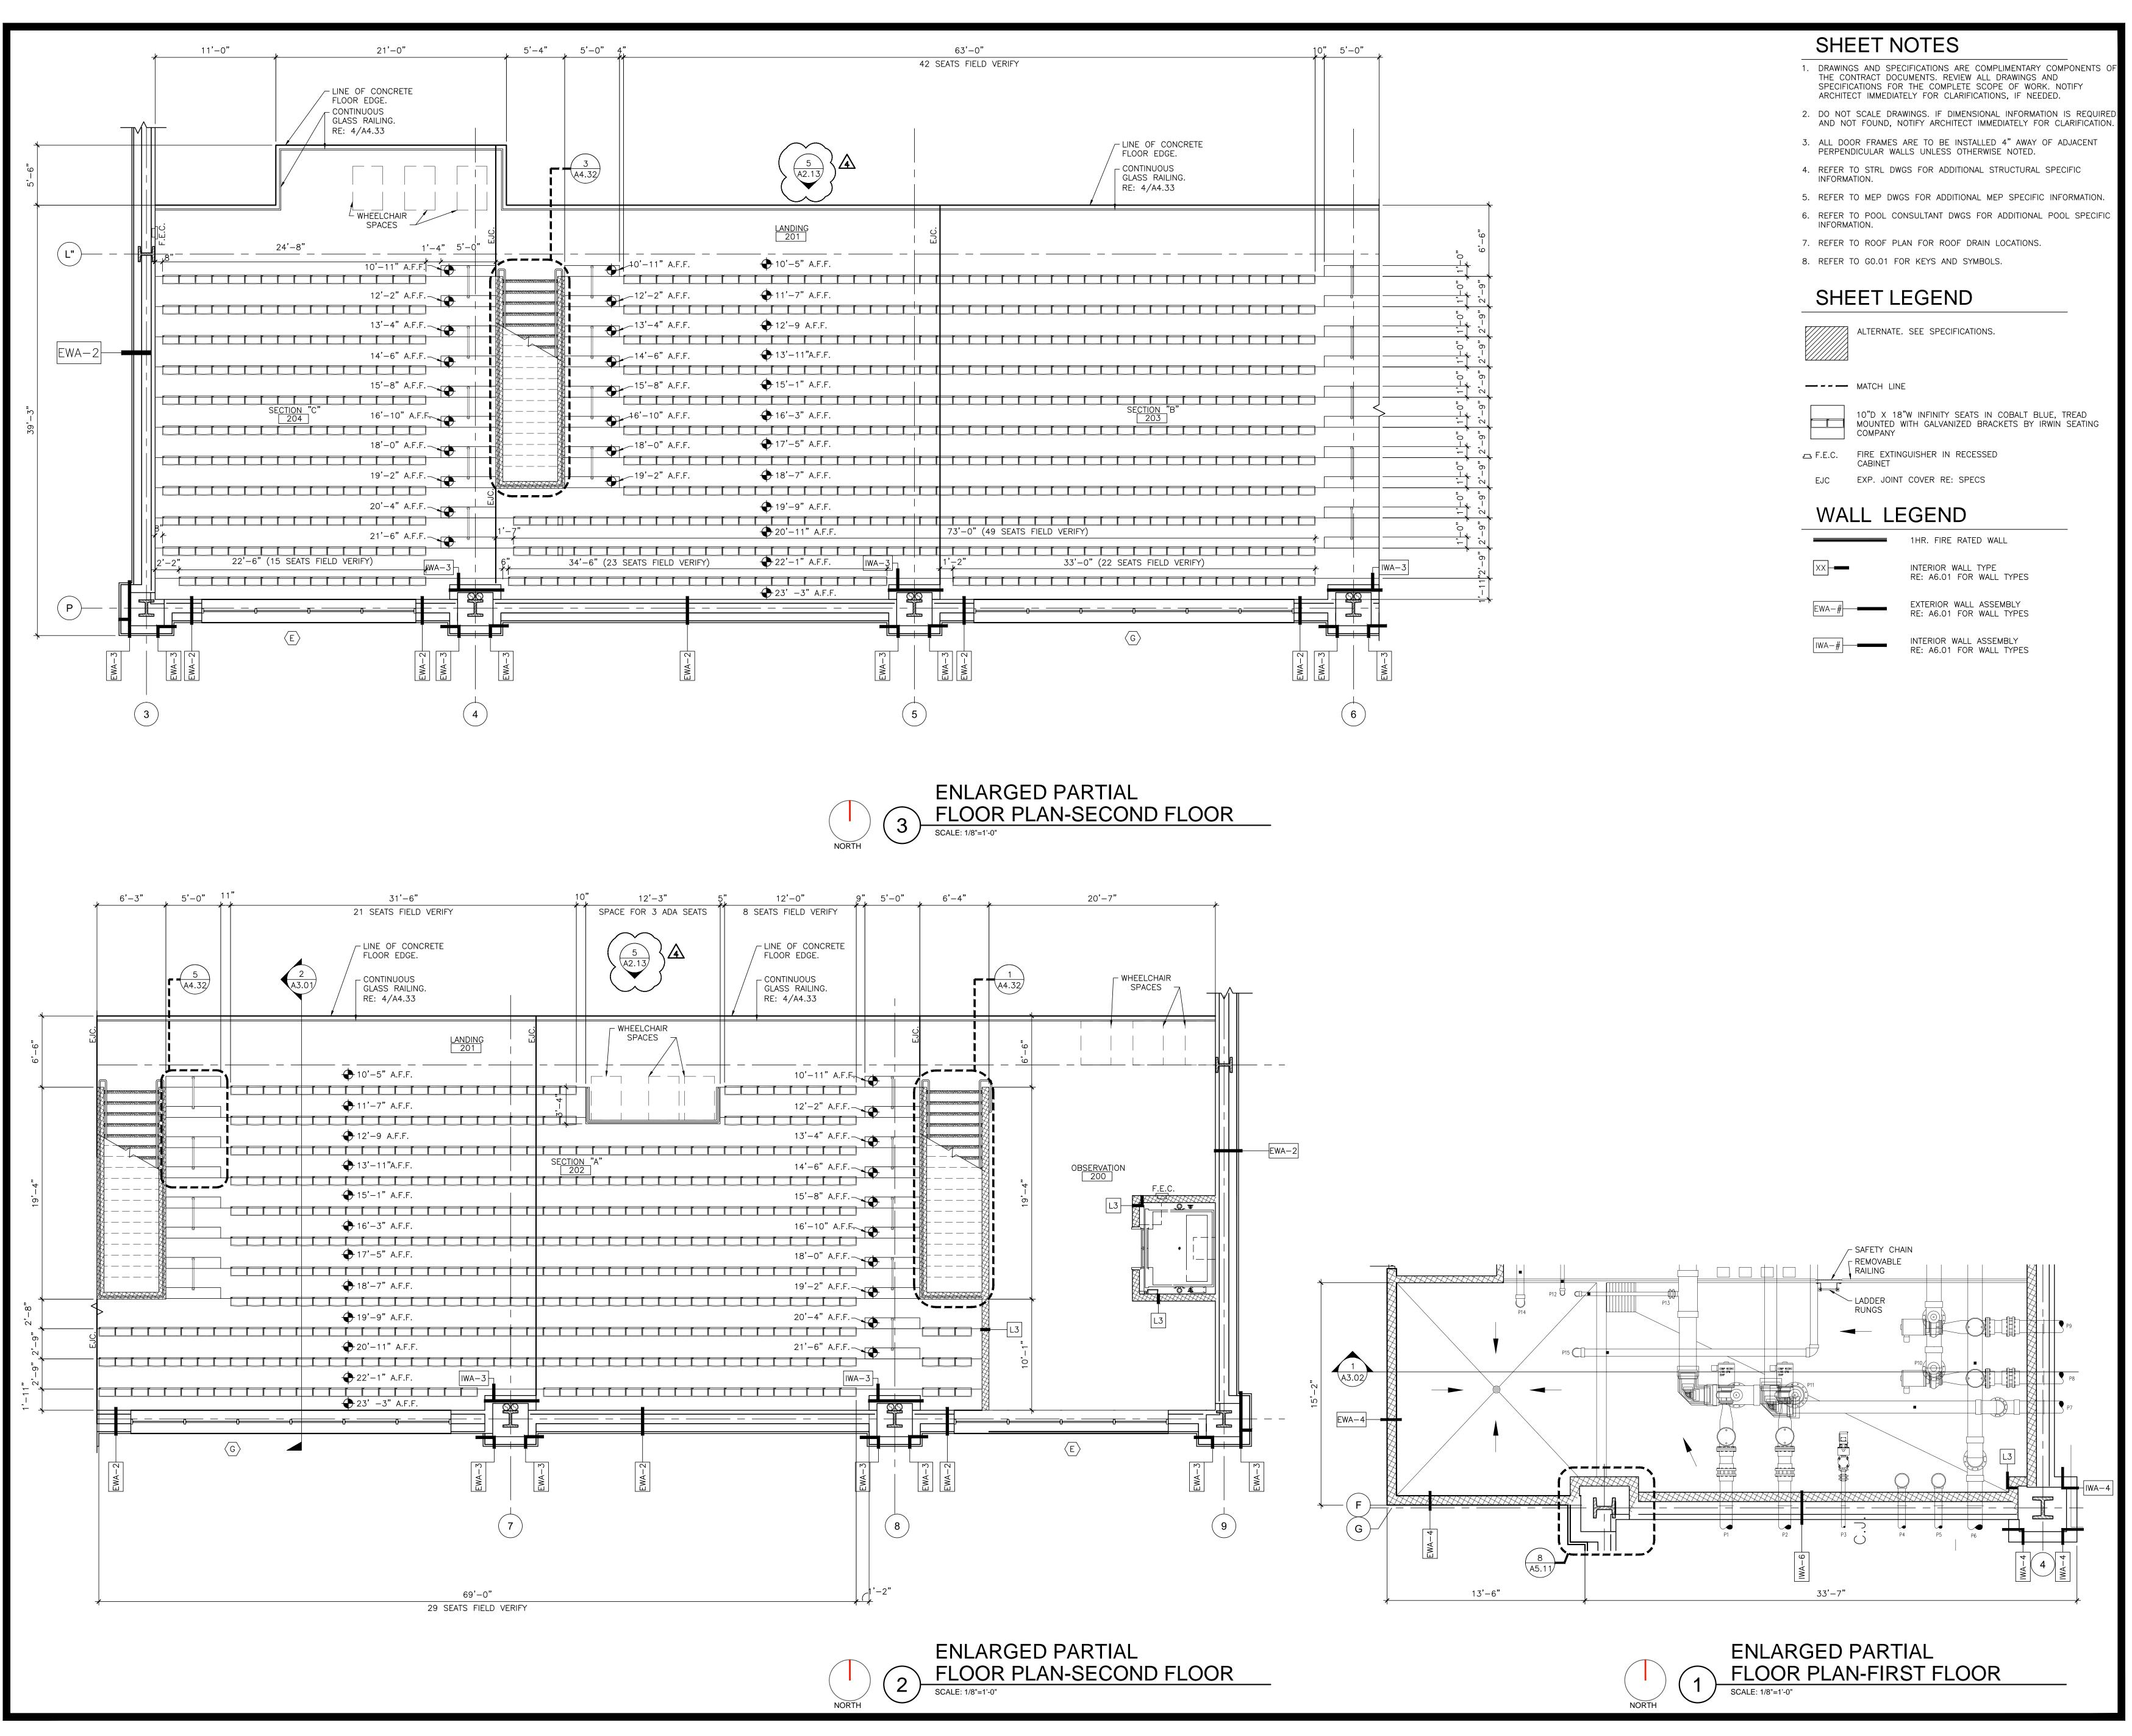



THESE DRAWINGS AND INFORMATION CONTAINED HEREIN ARE PROPERTY AND THE SOLE PROPERTY OF THE WARREN GROUP ARCHITECTS, INC. THEY MAY NOT BE REUSED, REPRODUCED OR ALTERED IN ANY WAY WITHOUT PRIOR WRITTEN APPROVAL FROM AND APPROPRIATE COMPENSATION TO THE WARREN GROUP ARCHITECTS INC.

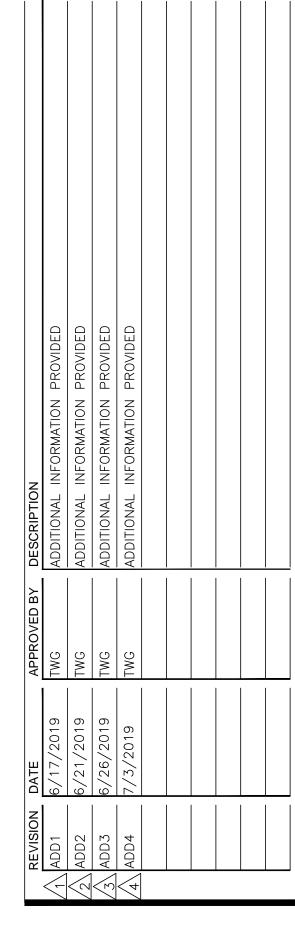

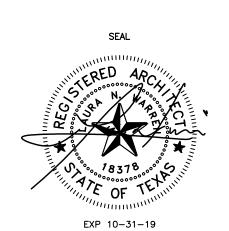


PROPOSED CITY OF PHARR/PSJA AQUATIC FACILITY

3001 N. CAGE BLVD PHARR, TEXAS 78577

PROJECT DATE REVISED 971805 06/07/2019 07/03/2019


A4.13 ADD4 **ENLARGED** 


FLOOR PLANS

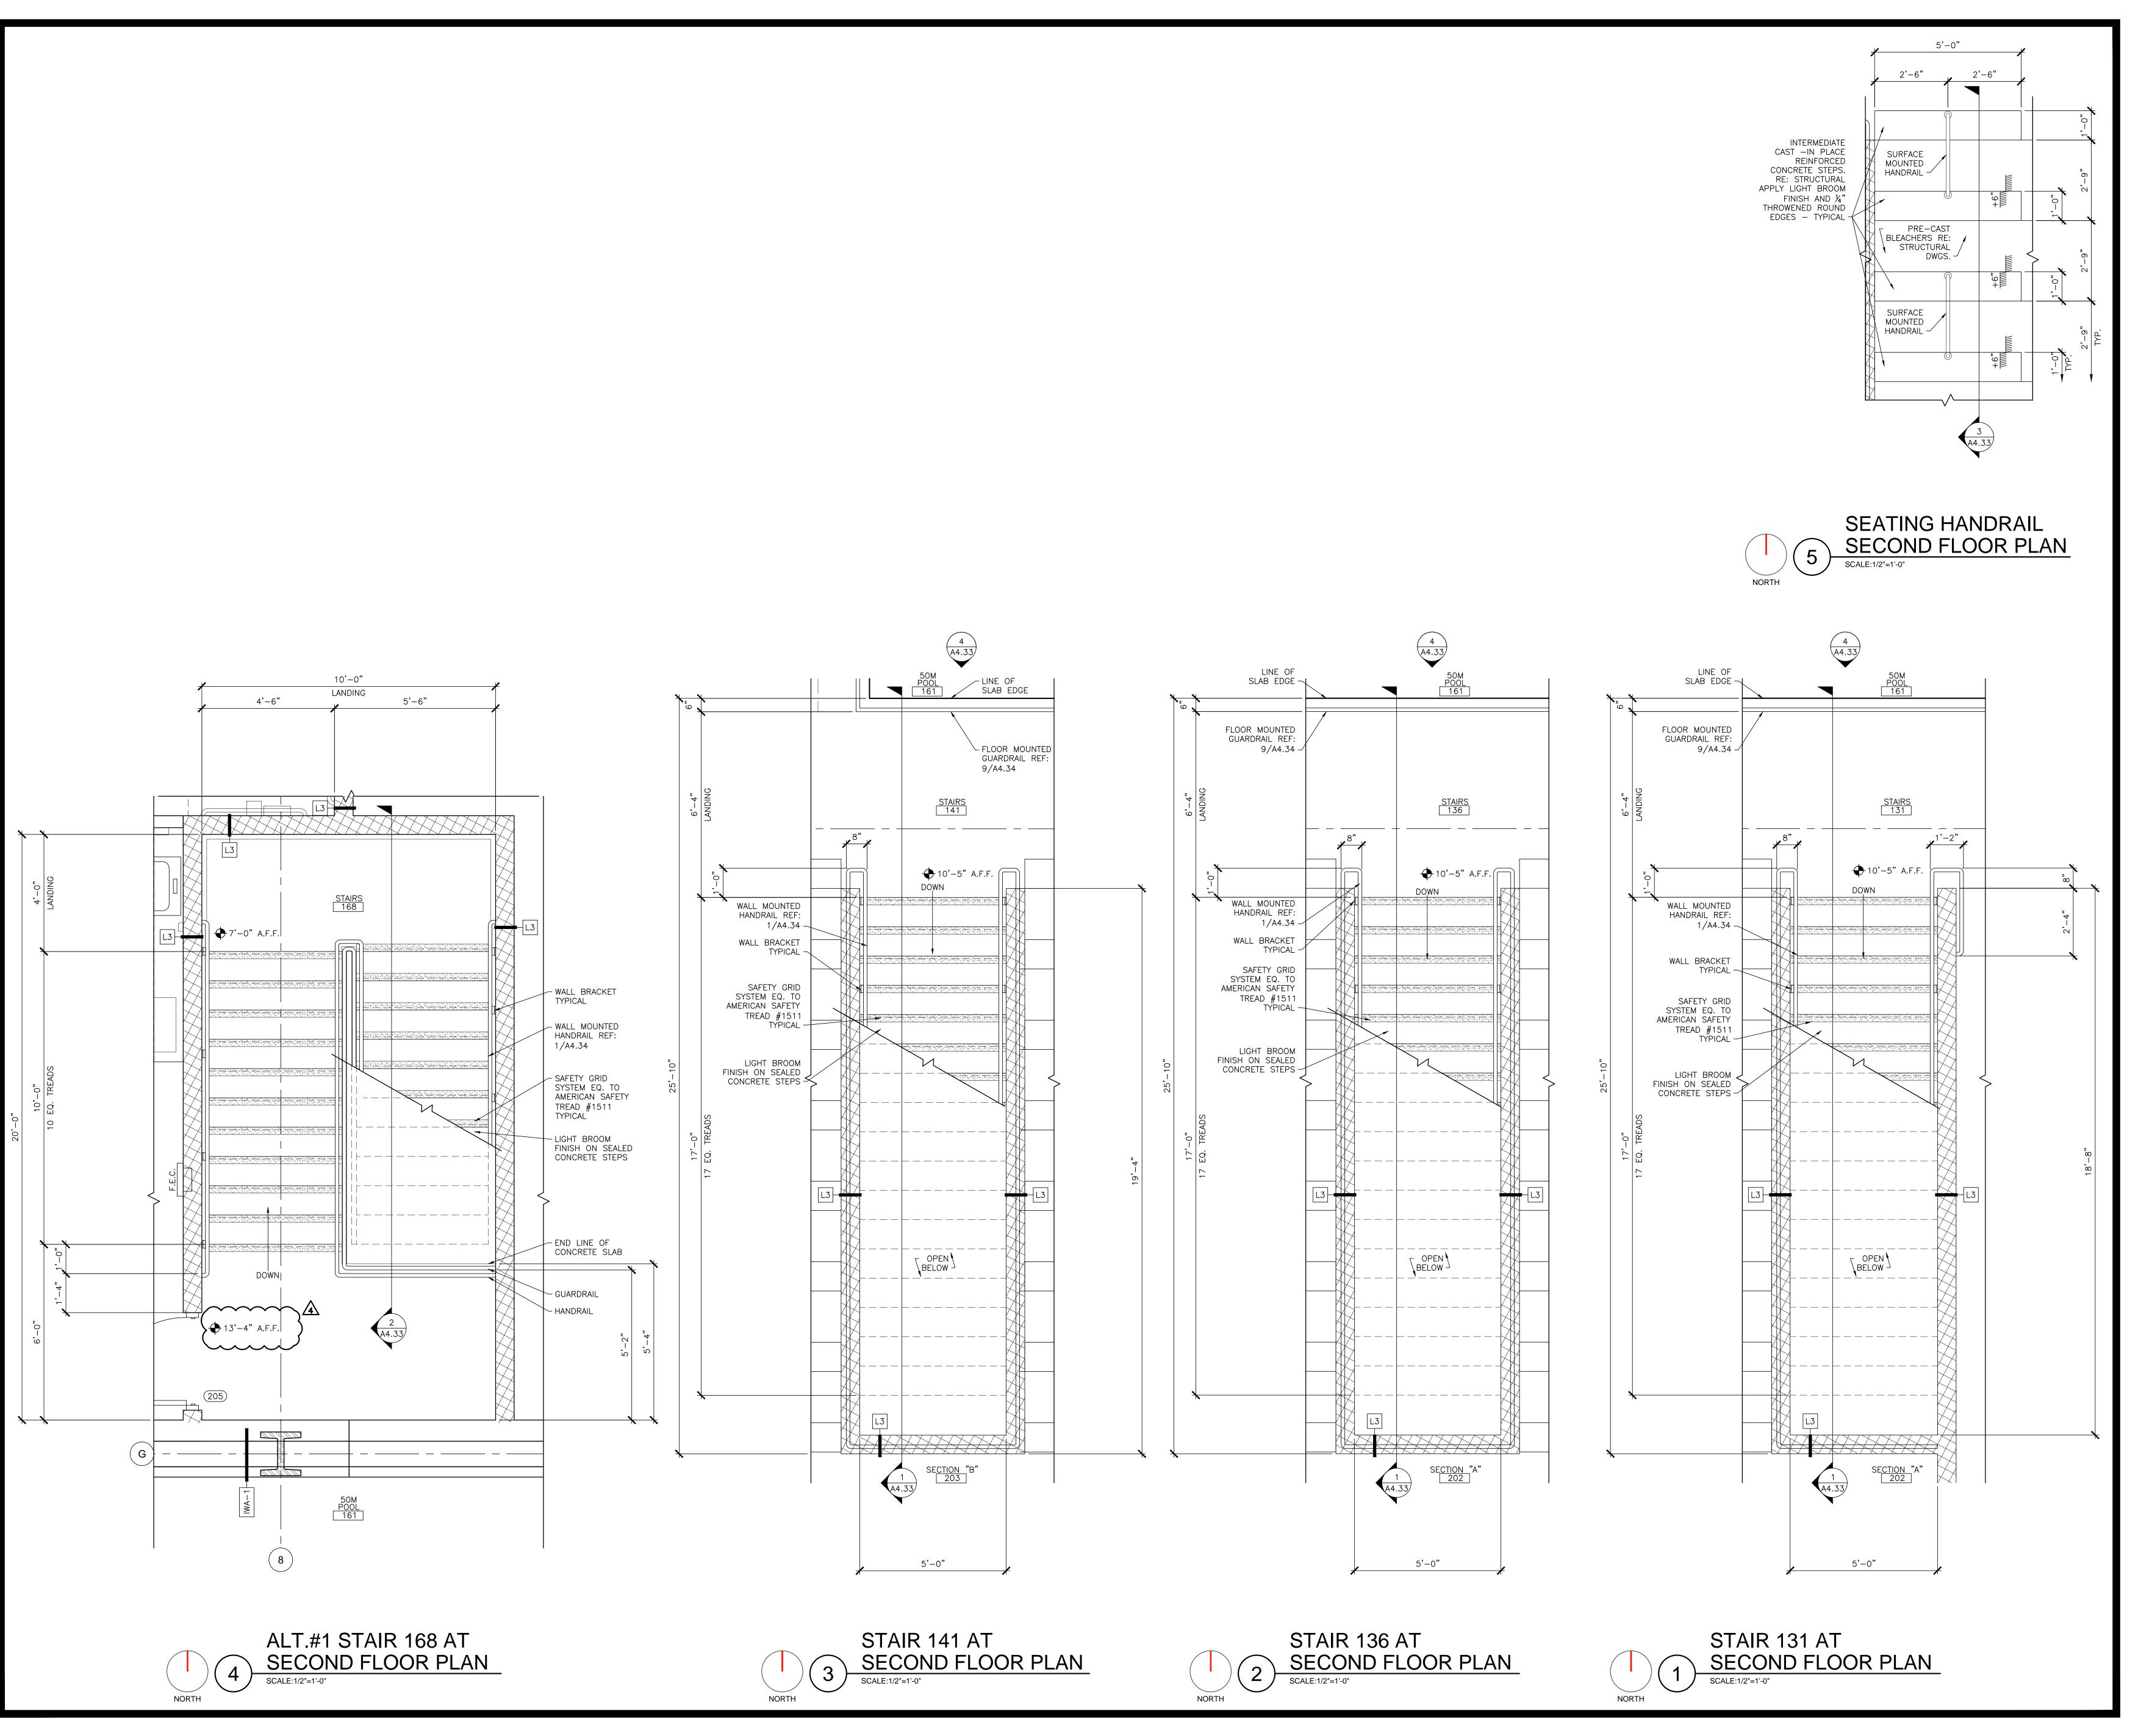



THESE DRAWINGS AND INFORMATION
CONTAINED HEREIN ARE PROPERTY AND
THE SOLE PROPERTY OF THE WARREN
GROUP ARCHITECTS, INC. THEY MAY NOT
BE REUSED, REPRODUCED OR ALTERED IN
ANY WAY WITHOUT PRIOR WRITTEN
APPROVAL FROM AND APPROPRIATE
COMPENSATION TO THE WARREN GROUP
ARCHITECTS INC.

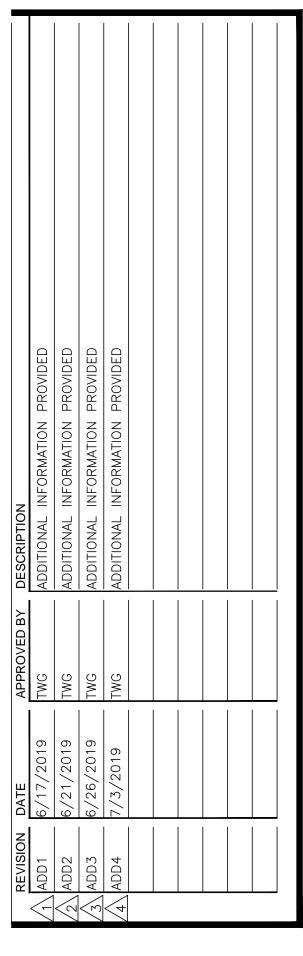

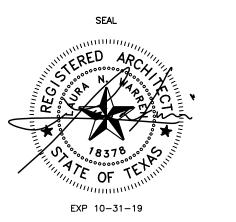

PROPOSED


CITY OF PHARR/PSJA AQUATIC FACILITY

3001 N. CAGE BLVD PHARR, TEXAS 78577

PROJECT DATE REVISED


A4.32 ADD4
ENLARGED
STAIRWAY PLANS


971805 06/07/2019 07/03/2019

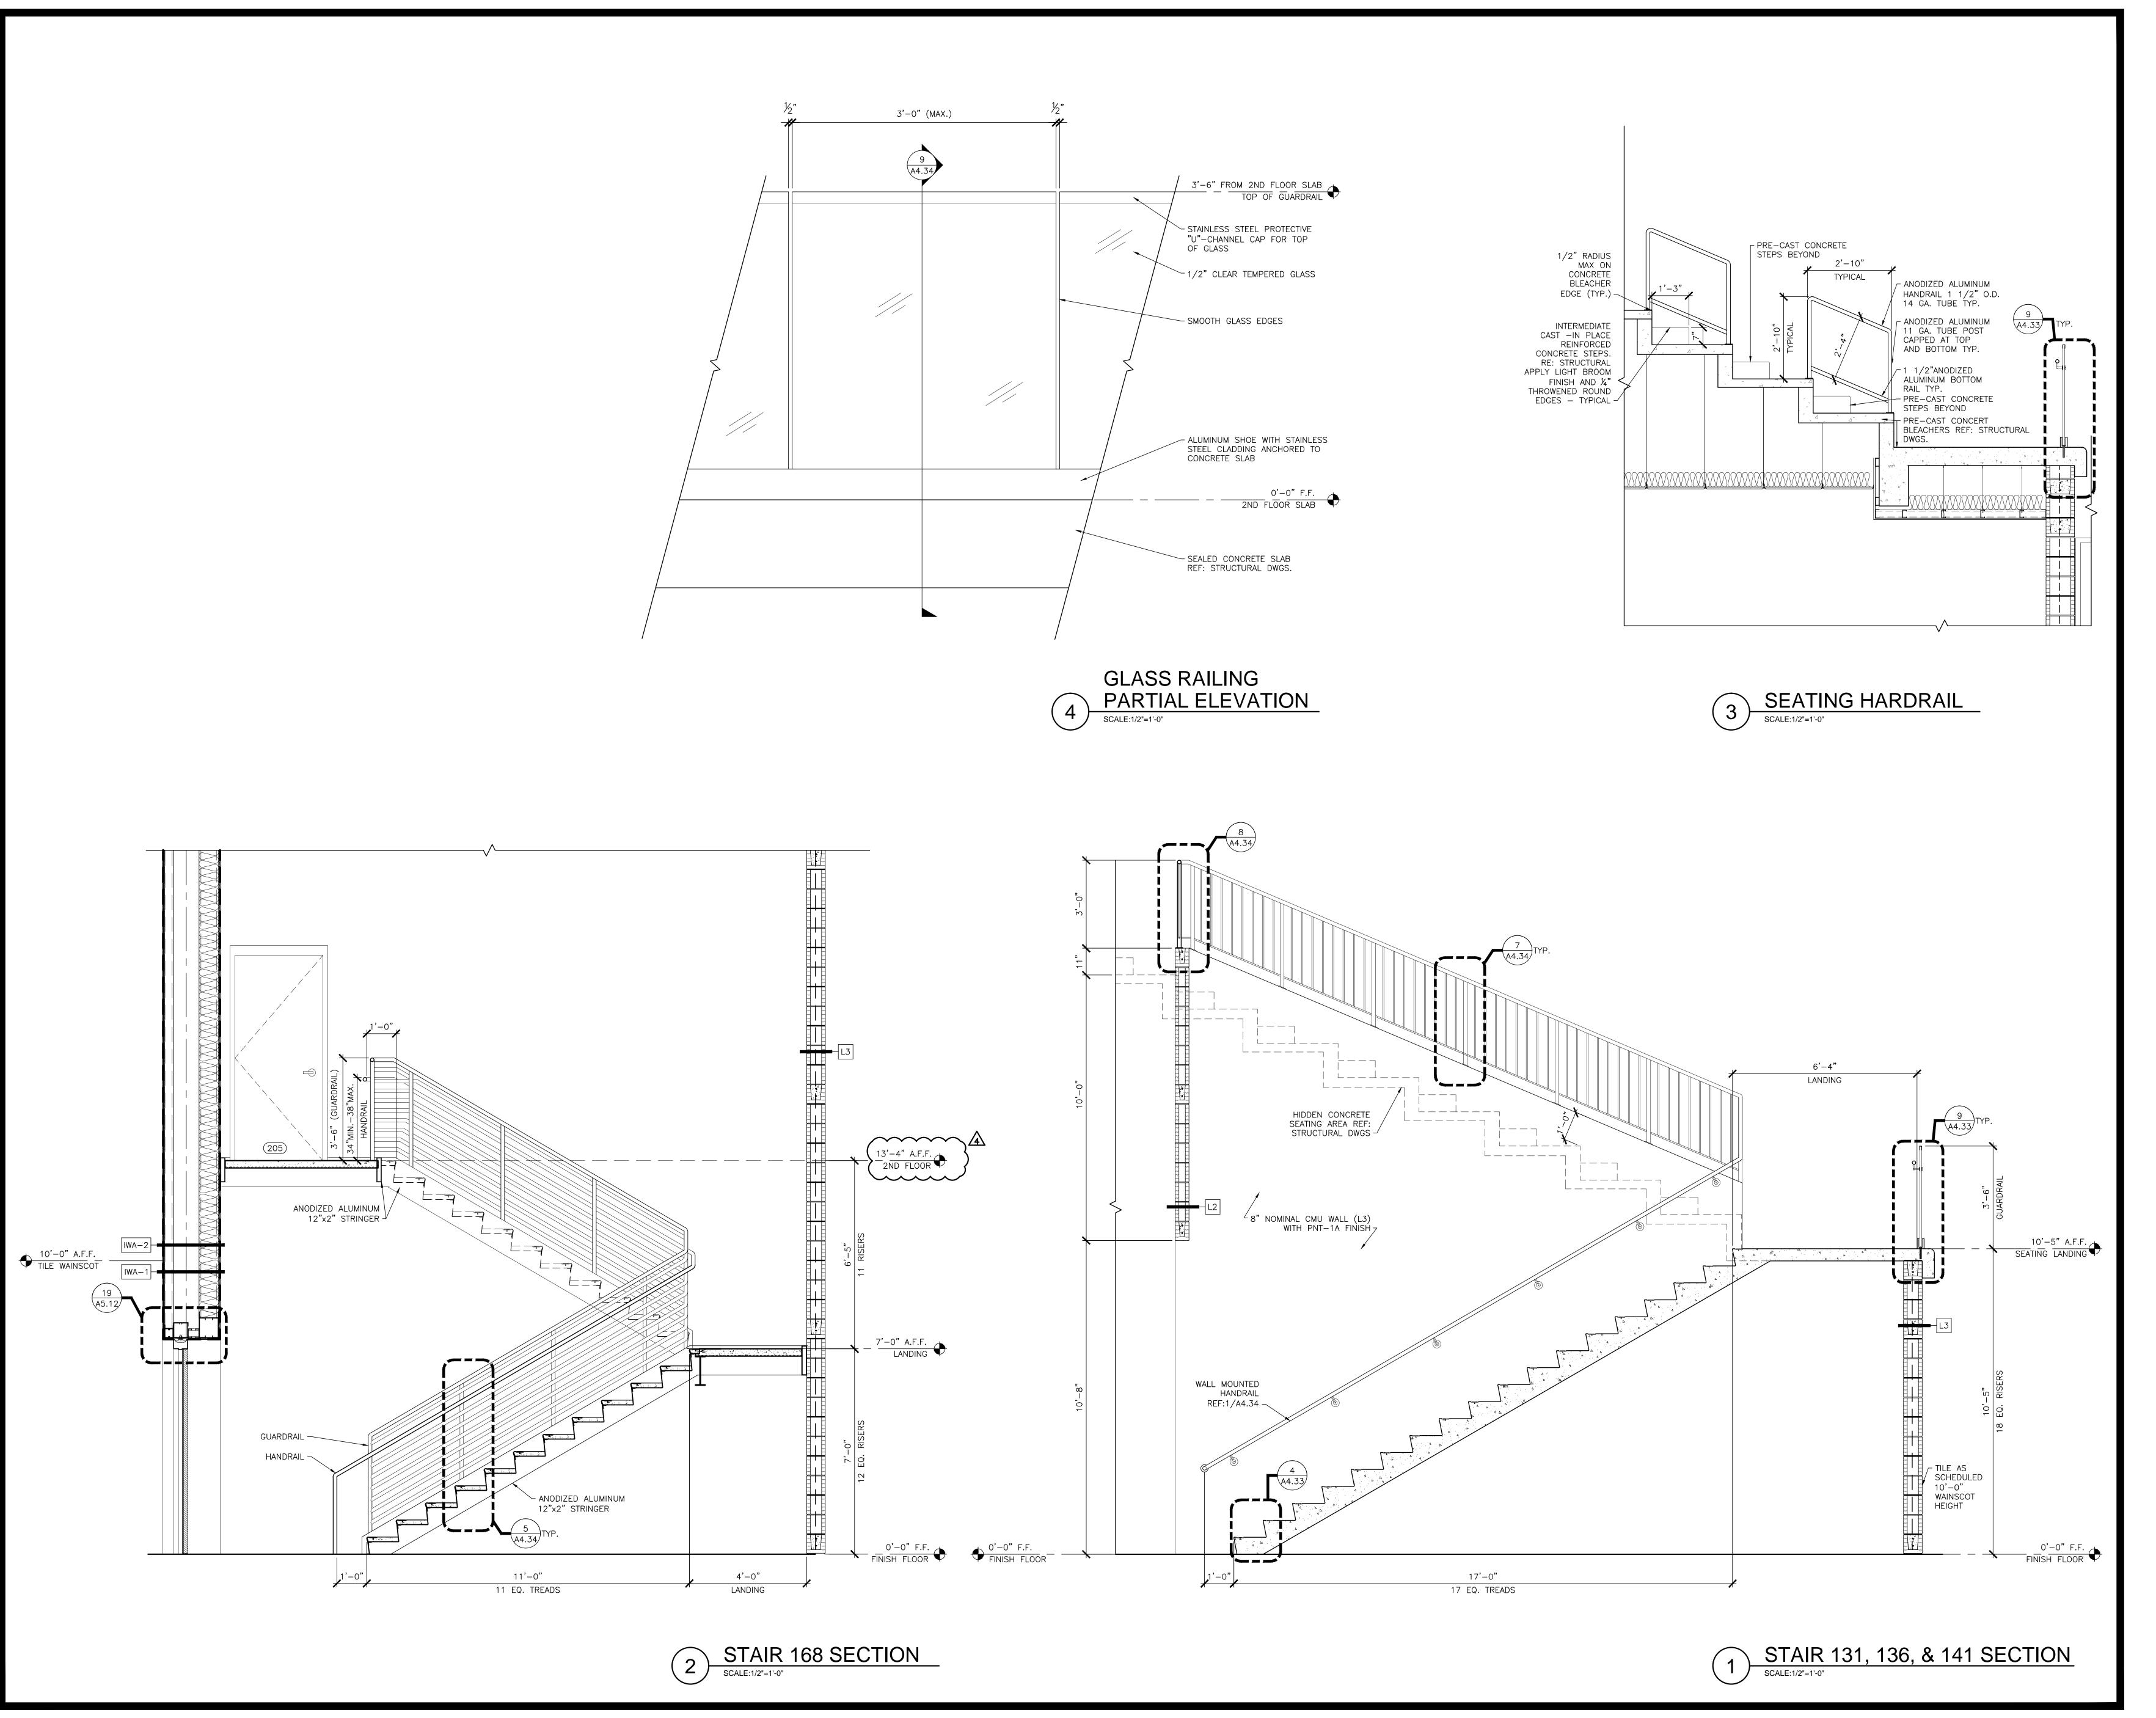



THESE DRAWINGS AND INFORMATION CONTAINED HEREIN ARE PROPERTY AND THE SOLE PROPERTY OF THE WARREN GROUP ARCHITECTS, INC. THEY MAY NOT BE REUSED, REPRODUCED OR ALTERED IN ANY WAY WITHOUT PRIOR WRITTEN APPROVAL FROM AND APPROPRIATE COMPENSATION TO THE WARREN GROUP ARCHITECTS INC.

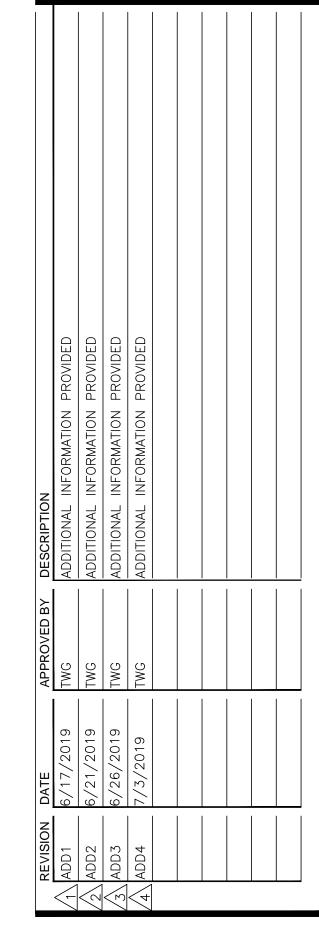

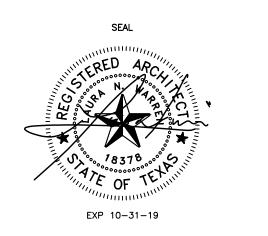

PROPOSED


CITY OF PHARR/PSJA AQUATIC FACILITY

3001 N. CAGE BLVD PHARR, TEXAS 78577

PROJECT 971805
DATE 06/07/2019
REVISED 07/03/2019

A4.33 ADD4

STAIRWAY SECTIONS

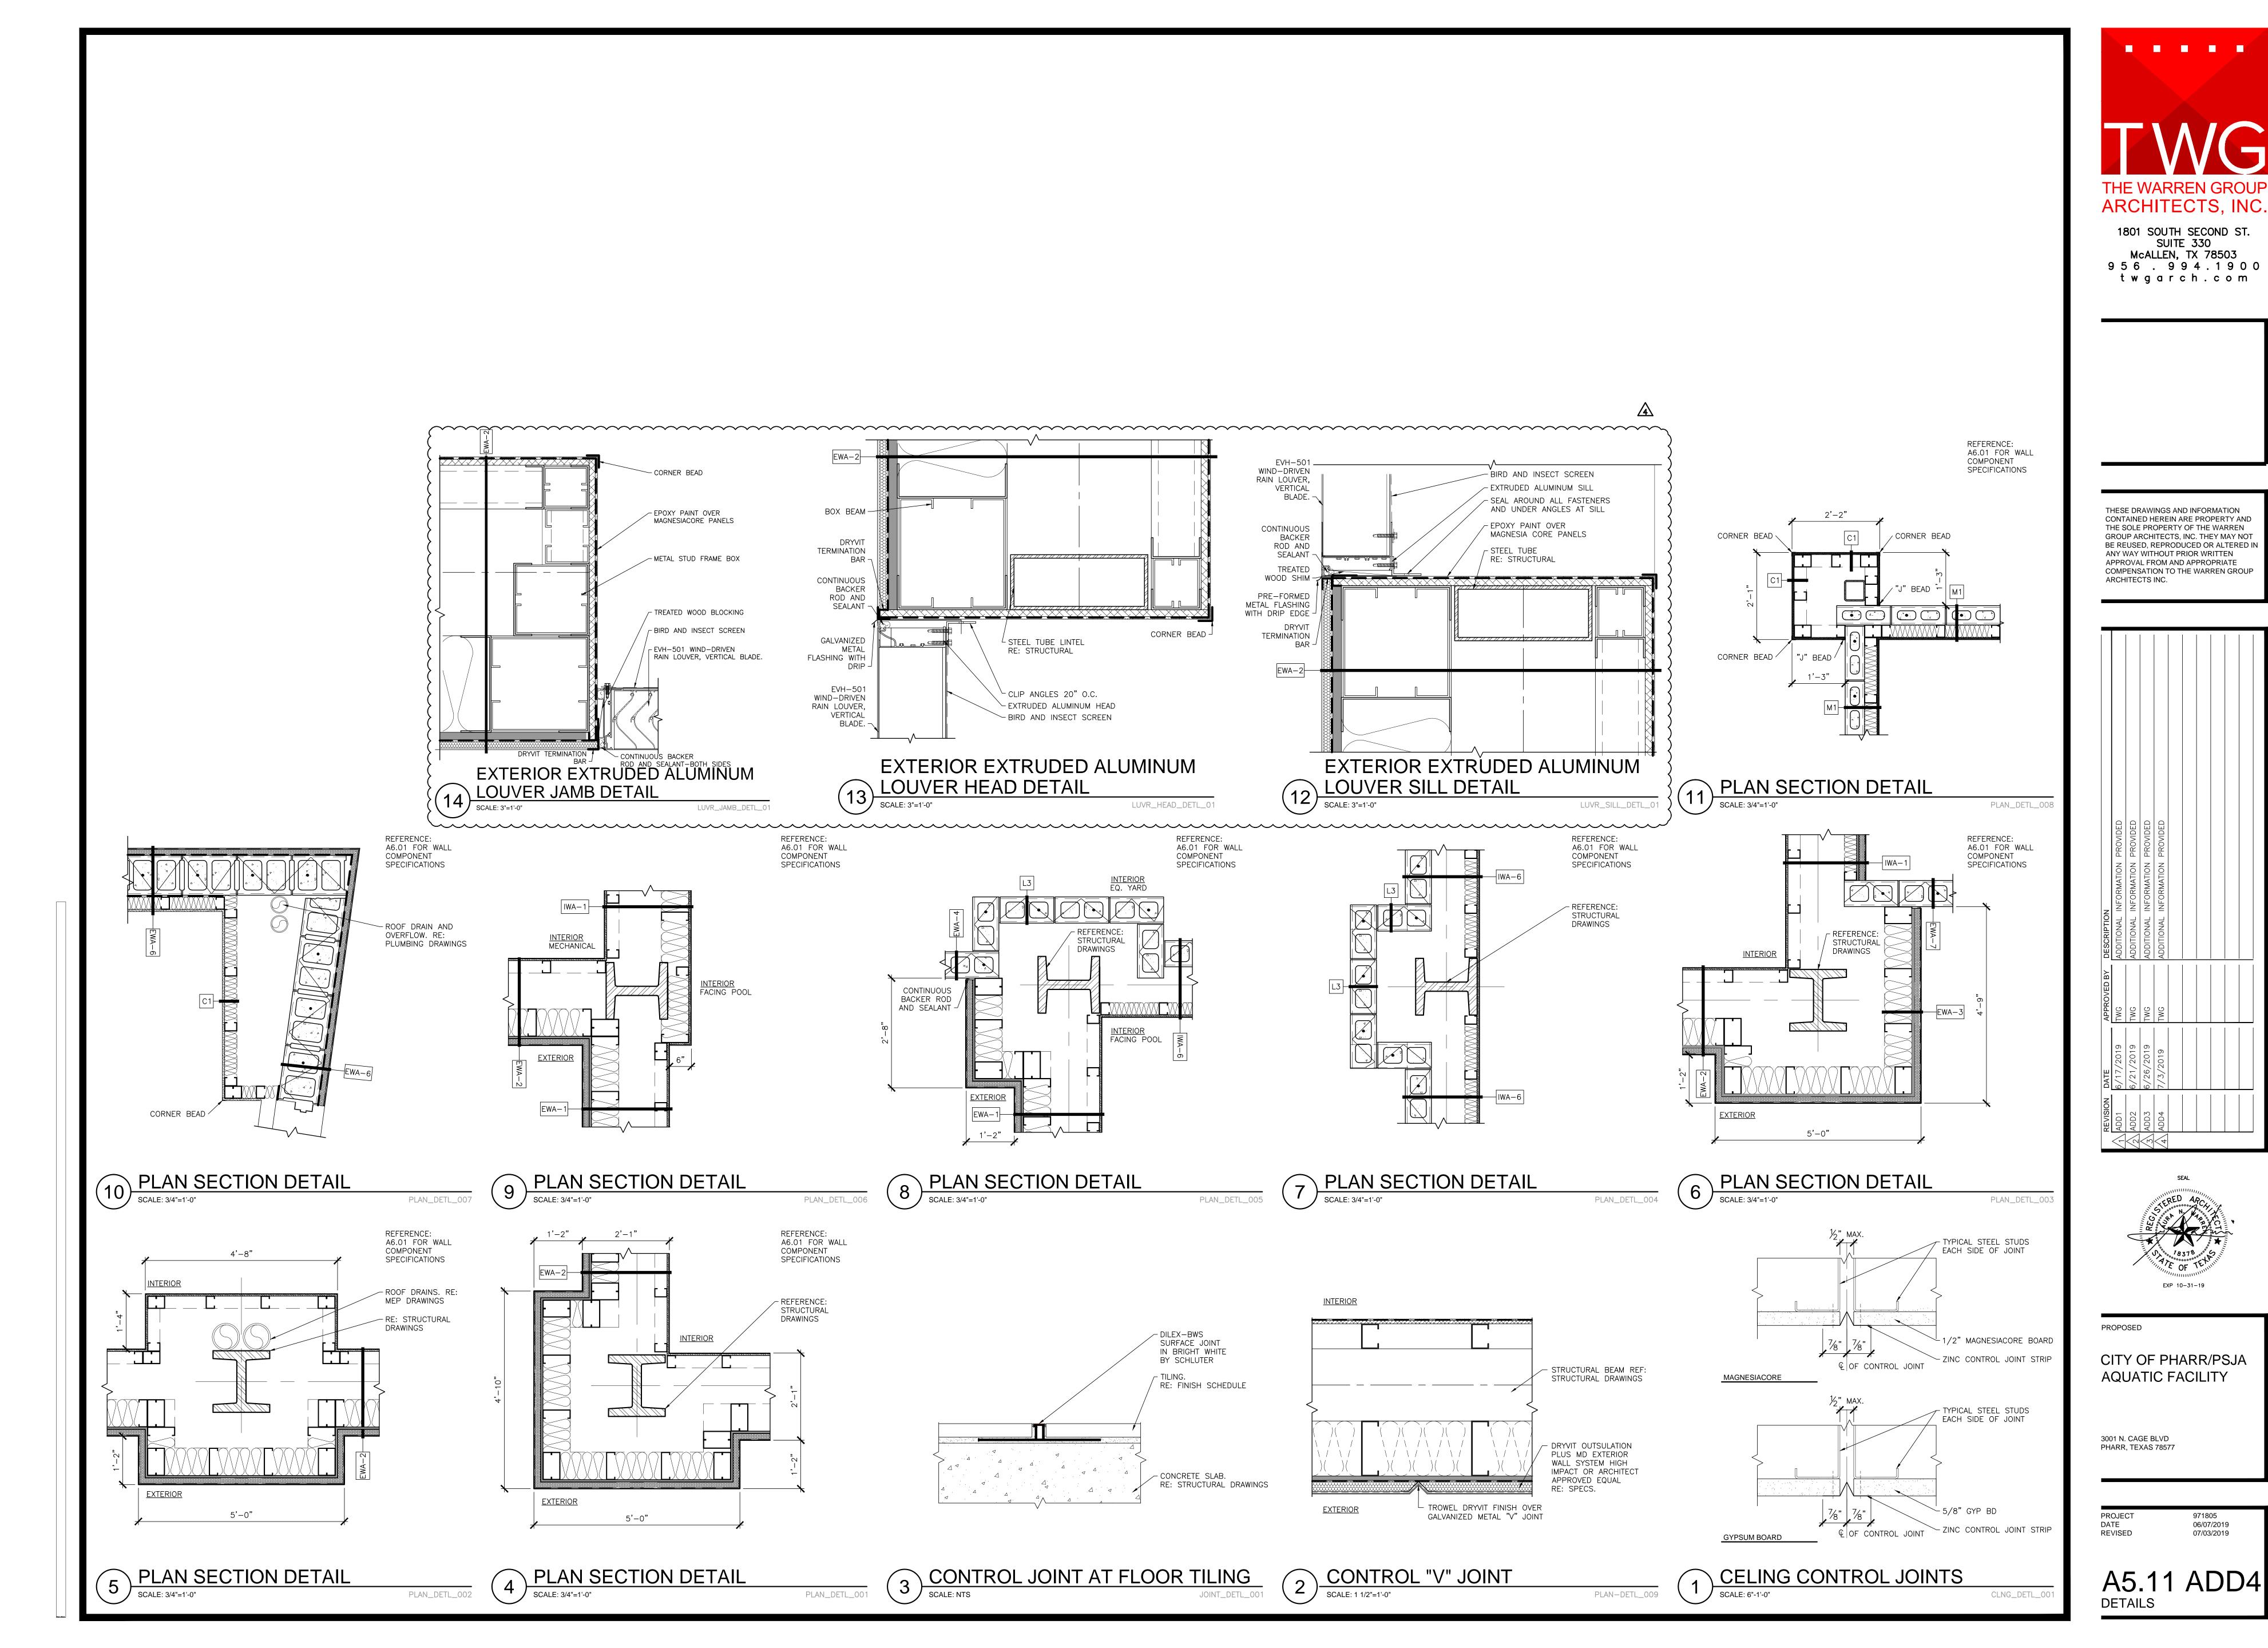

												T0
OPENING		DOOR				FRAME			LH RH			
No.	LOCATION TO	SWING	FIRE RATING	TYPE	FINISH	SIZE	ELEV.	TYPE	FINISH	ELEV.	REMARKS	LHR RHR LOCATION
168	50M POOL 161 TO STAIRS 168	LHR		FRP	_	3'-0" X 7'-0"	D	FRP	_		ALTER	NATE
205	STAIRS 168 TO PRIVATE VIEWING ROOM 205	LH	_	H.MTL	PNT-7B	3'-0" X 7'-0"	E	H.MTL	PNT-7B		ALTER	NATE
206	PRIVATE VIEWING ROOM 205 TO RR 206	LHR	_	H.MTL	PNT-7B	3'-0" X 7'-0"	С	H.MTL	PNT-7B		ALTER	NATE


		FRAME TYPE	_ - -			
ELEV.	TYPE	TYPE	FINISH	GLAZING	SIZE	REMARKS
$\langle A \rangle$	FIXED	ALUMINUM	KAWNEER DEEP BLUE	1" INSULATED LOW-E TINTED REFLECTIVE GLASS	11'-0" X 26'-2"	
$\langle B \rangle$	FIXED	ALUMINUM	KAWNEER DEEP BLUE	1/4" CLEAR SAFETY GLASS	11'-0" X 19'-2"	
(C)	FIXED	ALUMINUM	KAWNEER DEEP BLUE	1" INSULATED LOW-E TINTED REFLECTIVE GLASS	8'-6")X 5'-0"	
D	FIXED	ALUMINUM	KAWNEER DEEP BLUE	1" INSULATED LOW-E TINTED REFLECTIVE GLASS	8'-6")X 10'-0"	
(E)	FIXED	ALUMINUM	KAWNEER DEEP BLUE	1" INSULATED LOW-E TINTED REFLECTIVE GLASS	7'-2" X 9'-6"	
F	FIXED	ALUMINUM	KAWNEER DEEP BLUE	1" INSULATED LOW-E TINTED REFLECTIVE GLASS	6'-8" X 14'-4"	
G	FIXED	ALUMINUM	KAWNEER DEEP BLUE	1" INSULATED LOW-E TINTED REFLECTIVE GLASS	7'-2" X 14'-4"	
$\langle H \rangle$	FIXED	ALUMINUM	KAWNEER DEEP BLUE	1/4" CLEAR SAFETY GLASS	4'-8" X 5'-0"	
	FIXED	ALUMINUM	KAWNEER DEEP BLUE	1/4" CLEAR SAFETY GLASS	4'-0" X 5'-0"	
$\langle J \rangle$	FIXED	ALUMINUM	KAWNEER DEEP BLUE	1/4" CLEAR SAFETY GLASS	4'-0" X 6'-0"	
(K)	FIXED	ALUMINUM	KAWNEER DEEP BLUE	1/4" CLEAR SAFETY GLASS	4'-8" X 19'-2"	
	FIXED	ALUMINUM	KAWNEER DEEP BLUE	1/4" CLEAR SAFETY GLASS	4'-8" X 4'-8"	
M	FIXED	ALUMINUM	GRAY	_	4'-2"X6'-0"	<b>,</b>
$\langle N \rangle$	FIXED	ALUMINUM	TO MATCH WALL	_	RE: MECHANICAL DWGS	5


DOOR SCHEDULE												
=												TO _
OPENING		CMINIC	DOOR	TYPE	FINISH	CIZE		FRAME	FINICLI	EL EV /	DEMARKS	LHR RHR
	LOCATION TO	SWING	RATING –	TYPE	FINISH KAWNEER DEEP		ELEV.		KAWNEER	ELEV.	REMARKS	LOCATION
101A	EXTERIOR TO VESTIBULE 101	DOUBLE	_	ALUMINUM	DEED	(2) 3'-0" X 9'-0"	A	ALUM.	DEEP BLUE KAWNEER			
101B	EXTERIOR TO VESTIBULE 101	DOUBLE		ALUMINUM	BLUE KAWNEER	(2) 3'-0" X 9'-0"	A	ALUM.	DEEP BLUE			
102A	VESTIBULE 101 TO LOBBY 102	DOUBLE	_	ALUMINUM	KAWNEER	(2) 3'-0" X 9'-0"	A	ALUM.	KAWNEER DEEP BLUE			
102B	VESTIBULE 101 TO LOBBY 102	DOUBLE	_	ALUMINUM	DEEP BLUE KAWNEER	(2) 3'-0" X 9'-0"	A	ALUM.	KAWNEER DEEP BLUE			
103A	LOBBY 102 TO VESTIBULE 103	DOUBLE	_	ALUMINUM	DEEP BLUE	(2) 3'-0" X 9'-0"	А	ALUM.	KAWNEER DEEP BLUE			
103B	LOBBY 102 TO VESTIBULE 103	DOUBLE	_	ALUMINUM	+	(2) 3'-0" X 9'-0"	A	ALUM.	KAWNEER DEEP BLUE			
103C	VESTIBULE 103 TO 50M POOL 161	DOUBLE	_	ALUMINUM	KAWNEER ( DEEP BLUE (	(2) 3'-0" X 9'-0"	A	ALUM.	KAWNEER DEEP BLUE			
103D	VESTIBULE 103 TO 50M POOL 161	DOUBLE	_	ALUMINUM	KAWNEER ( DEEP BLUE	(2) 3'-0" X 9'-0"	A	ALUM.	KAWNEER DEEP BLUE			
	LOBBY 102 TO ADMIN. 105	LH	_	H.MTL	PNT-7B	3'-0" X 7'-0"	Е	H.MTL	PNT-7B			
	LOBBY 102 TO CORRIDOR 106  EXTERIOR TO CORRIDOR 106	DOUBLE	-   -	H.MTL H.MTL		(2) 3'-0" X 7'-0" (2) 3'-0" X 7'-0"	F G	H.MTL H.MTL	PNT-7B			
	CORRIDOR 107 TO COACH 108	RH	_	H.MTL		3'-0" X 7'-0"	E	H.MTL	PNT-7B			
	CORRIDOR 107 TO COACH 109	RH		H.MTL		3'-0" X 7'-0"	E	H.MTL	PNT-7B			
	CORRIDOR 107 TO COACH 110  CORRIDOR 107 TO COACH 111	RH LH	_	H.MTL H.MTL		3'-0" X 7'-0" 3'-0" X 7'-0"	E E	H.MTL H.MTL	PNT-7B PNT-7B			
	CORRIDOR 106 TO CONFERENCE 112	RH	_	H.MTL		3'-0" X 7'-0"	E	H.MTL	PNT-7B			
	CORRIDOR 106 TO COACH RR 113  CORRIDOR 106 TO ELECTRICAL 114	LH RH	_ 	H.MTL H.MTL		3'-0" X 7'-0" 3'-0" X 7'-0"	C	H.MTL H.MTL	PNT-7B PNT-7B			
	LOBBY 102 TO ADMIN. 116	RH	_	H.MTL	PNT-7B	3'-0" X 7'-0"	E	H.MTL	PNT-7B			
	LOBBY 102 TO CORRIDOR 117  EXTERIOR TO CORRIDOR 117	DOUBLE		H.MTL		(2) 3'-0" X 7'-0" (2) 3'-0" X 7'-0"	F G	H.MTL H.MTL	PNT-7B			
	CORRIDOR 117 TO CORRIDOR 130	DOUBLE	_	H.MTL		(2) 3'-0" X 7'-0"	F	H.MTL	PNT-7B			
	CORRIDOR 118 TO COACH 120	RH	-   -	H.MTL		3'-0" X 7'-0"	E	H.MTL	PNT-7B			
	CORRIDOR 118 TO COACH 120  CORRIDOR 118 TO COACH 121	LH	_	H.MTL H.MTL		3'-0" X 7'-0" 3'-0" X 7'-0"	E E	H.MTL H.MTL	PNT-7B PNT-7B			
122	CORRIDOR 118 TO COACH 122	LH	_	H.MTL	PNT-7B	3'-0" X 7'-0"	Е	H.MTL	PNT-7B			
	CORRIDOR 117 TO COACH RR 123  CORRIDOR 117 TO CONFERENCE 124	RH		H.MTL H.MTL		3'-0" X 7'-0" 3'-0" X 7'-0"	C E	H.MTL H.MTL	PNT-7B			
	CORRIDOR 117 TO JANITOR 125	LH	_	H.MTL		3'-0" X 7'-0"	С	H.MTL	PNT-7B			
	CORRIDOR 117 TO IT 126  CORRIDOR 127 TO 50M POOL 161	LH		H.MTL FRP	PNT-7B	3'-0" X 7'-0" (2) 3'-0" X 7'-0"	C	H.MTL FRP	PNT-7B			
	CORRIDOR 127 TO ELEVATOR EQUIPMENT 129	LH	_	FRP		3'-0" X 7'-0"	С	FRP	_			
	EXTERIOR TO CORRIDOR 130	DOUBLE	_	H.MTL		(2) 3'-0" X 7'-0"	G	H.MTL	PNT-7B			
	CORRIDOR 130 TO CONCESSION 132	DOUBLE RH	_	H.MTL H.MTL		(2) 3'-0" X 7'-0" 3'-0" X 7'-0"	G E	H.MTL H.MTL	PNT-7B PNT-7B			
132B	CORRIDOR 130 TO CONCESSION 132	LH	_	H.MTL	PNT-7B	3'-0" X 7'-0"	E	H.MTL	PNT-7B			
	CONCESSION 132 TO STORAGE 133  CORRIDOR 130 TO RR 134	RH		H.MTL H.MTL		3'-0" X 7'-0" 3'-0" X 7'-0"	C	H.MTL H.MTL	PNT-7B			
	CORRIDOR 130 TO CONDITIONING 135	RH	_	H.MTL		3'-0" X 7'-0"	E	H.MTL	PNT-7B			
	CORRIDOR 130 TO CONDITIONING 135	LH	-   -	H.MTL		3'-0" X 7'-0"	E	H.MTL	PNT-7B			
	CORRIDOR 130 TO CORRIDOR 137  CORRIDOR 137 TO 50M POOL 161	LHR	_	H.MTL FRP		3'-0" X 7'-0" 3'-0" X 7'-0"	E E	H.MTL FRP	PNT-7B -			
	CORRIDOR 130 CLASSROOM 140	DOUBLE	_	H.MTL		(2) 3'-0" X 7'-0"	F	H.MTL	PNT-7B			
	CORRIDOR 130 TO STORAGE 142  EXTERIOR TO RISER ROOM 143	DOUBLE RHR	<del>-</del>   -	H.MTL H.MTL		(2) 3'-0" X 7'-0" 3'-0" X 7'-0"	H C	H.MTL H.MTL	PNT-7B PNT-7B			
144	50M POOL 161 TO TIMING 144	RH	_	FRP	_	3'-0" X 7'-0"	Е	FRP	_			
	50M POOL 161 TO STORAGE 145 50M POOL 161 TO CORRIDOR 146	RHR		FRP FRP		3'-0" X 7'-0" 3'-0" X 7'-0"	C B	FRP FRP				
	CORRIDOR 146 TO HEAD COACH 147	LH	_	FRP		3'-0" X 7'-0"	E	FRP	_			
	CORRIDOR 146 TO MEN 148	LHR	-	FRP	_	3'-0" X 7'-0"	С	FRP	_			
	50M POOL 161 TO CORRIDOR 150  CORRIDOR 150 TO HEAD COACH 151	RHR	_	FRP FRP		3'-0" X 7'-0" 3'-0" X 7'-0"	B E	FRP FRP	_			
	CORRIDOR 150 TO WOMEN 152	RHR	_	FRP	_	3'-0" X 7'-0"	С	FRP	_			
	50M POOL 161 TO LIFE GUARD BREAK ROOM 154  LIFE GUARD BREAK ROOM 154 TO MEN RR 155	DOUBLE		FRP FRP		(2) 3'-0" X 7'-0" 3'-0" X 7'-0"	F C	FRP FRP				
	LIFE GUARD BREAK ROOM 154 TO WOMEN RR 156	LH	_	FRP		3'-0" X 7'-0"	С	FRP	_			
	EXTERIOR TO MECHANICAL 157	OVERHEAD	_	_	_	12'-0" X 12'-0"		4-	_			
	EXTERIOR TO MECHANICAL 157  EXTERIOR TO MECHANICAL 157	DOUBLE		H.MTL H.MTL	1	(2) 3'-0" X 7'-0" (2) 3'-0" X 7'-0"	H	H.MTL H.MTL	PNT-7B PNT-7B			
	EXTERIOR TO MECHANICAL 157	OVERHEAD	_	_	_	12'-0" X 12'-0"		4 -	_			
	DIVING POOL 160 TO FIRST AID 158  DIVING POOL 160 TO TRAINER 159	RH		FRP FRP		3'-0" X 7'-0" 3'-0" X 7'-0"	E E	FRP FRP				
	TRAINER 159 TO FIRST AID 158	RH	_	FRP		3'-0" X 7'-0"	E	FRP	_			
	EXTERIOR TO DIVING POOL 160	DOUBLE		FRP	_	(2) 3'-0" X 7'-0"	G	ALUM	KAWNEER DEEP BLUE KAWNEER			
	EXTERIOR TO DIVING POOL 160  EXTERIOR TO 50M POOL 161	DOUBLE	<del>-</del>   -	FRP FRP		(2) 3'-0" X 7'-0" (2) 3'-0" X 7'-0"	G G	ALUM ALUM	DEEP BLUE  KAWNEER  DEEP BLUE			
	EXTERIOR TO 50M POOL 161	DOUBLE	_	FRP		(2) 3'-0" X 7'-0"	G	ALUM	KAWNEER DEEP BLUE			
	EXTERIOR TO MECHANICAL 162	DOUBLE	_	H.MTL		(2) 3'-0" X 7'-0"	Н	H.MTL	PNT-7B			
	EXTERIOR TO MECHANICAL 162  50M POOL 161 TO POOL EQ. YARD 163	OVERHEAD RHR		- FRP	_	12'-0" X 12'-0" 3'-0" X 7'-0"	C	FRP				
163B	EXTERIOR TO POOL EQ. YARD 163	DOUBLE	_	FRP	-	(2) 3'-0" X 7'-0"	Н	ALUM	KÄWNEER DEEP BLUE	4		
	50M POOL 161 TO POOL EQ. YARD 163  EXTERIOR TO ELECTRICAL 164	RHR	_	FRP H.MTL		3'-0" X 7'-0" (2) 3'-0" X 7'-0"	С	FRP H.MTL	 PNT-7B			
	EXTERIOR TO ELECTRICAL 164  EXTERIOR TO CALCIUM HYPO SYS. 165	DOUBLE	_	H.MIL FRP	1	(2) 3'-0" × 7'-0"	Н	ALUM	KAWNEER DEEP BLUE			
166	EXTERIOR TO ACID RM. 166	RHR	_	FRP	+	3'-0" X 7'-0"	С	ALUM	KAWNEER DEEP BLUE	_		
167	50M POOL 161 TO STORAGE 167	DOUBLE	_	FRP	_	(2) 3'-0" X 7'-0"	Н	FRP	_			



1801 SOUTH SECOND ST.
SUITE 330
McALLEN, TX 78503
9 5 6 . 9 9 4 . 1 9 0 0
t w g a r c h . c o m

THESE DRAWINGS AND INFORMATION CONTAINED HEREIN ARE PROPERTY AND THE SOLE PROPERTY OF THE WARREN GROUP ARCHITECTS, INC. THEY MAY NOT BE REUSED, REPRODUCED OR ALTERED IN ANY WAY WITHOUT PRIOR WRITTEN APPROVAL FROM AND APPROPRIATE COMPENSATION TO THE WARREN GROUP ARCHITECTS INC.

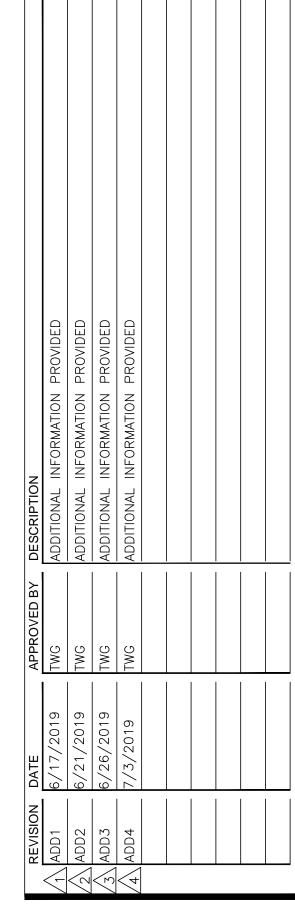

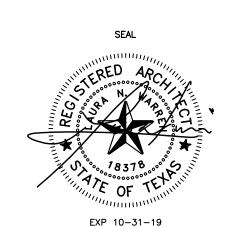

PROPOSED


CITY OF PHARR/PSJA AQUATIC FACILITY

3001 N. CAGE BLVD PHARR, TEXAS 78577

PROJECT DATE REVISED

971805 06/07/2019 07/03/2019


A6.21 ADD4
DOOR AND WINDOW
SCHEDULES

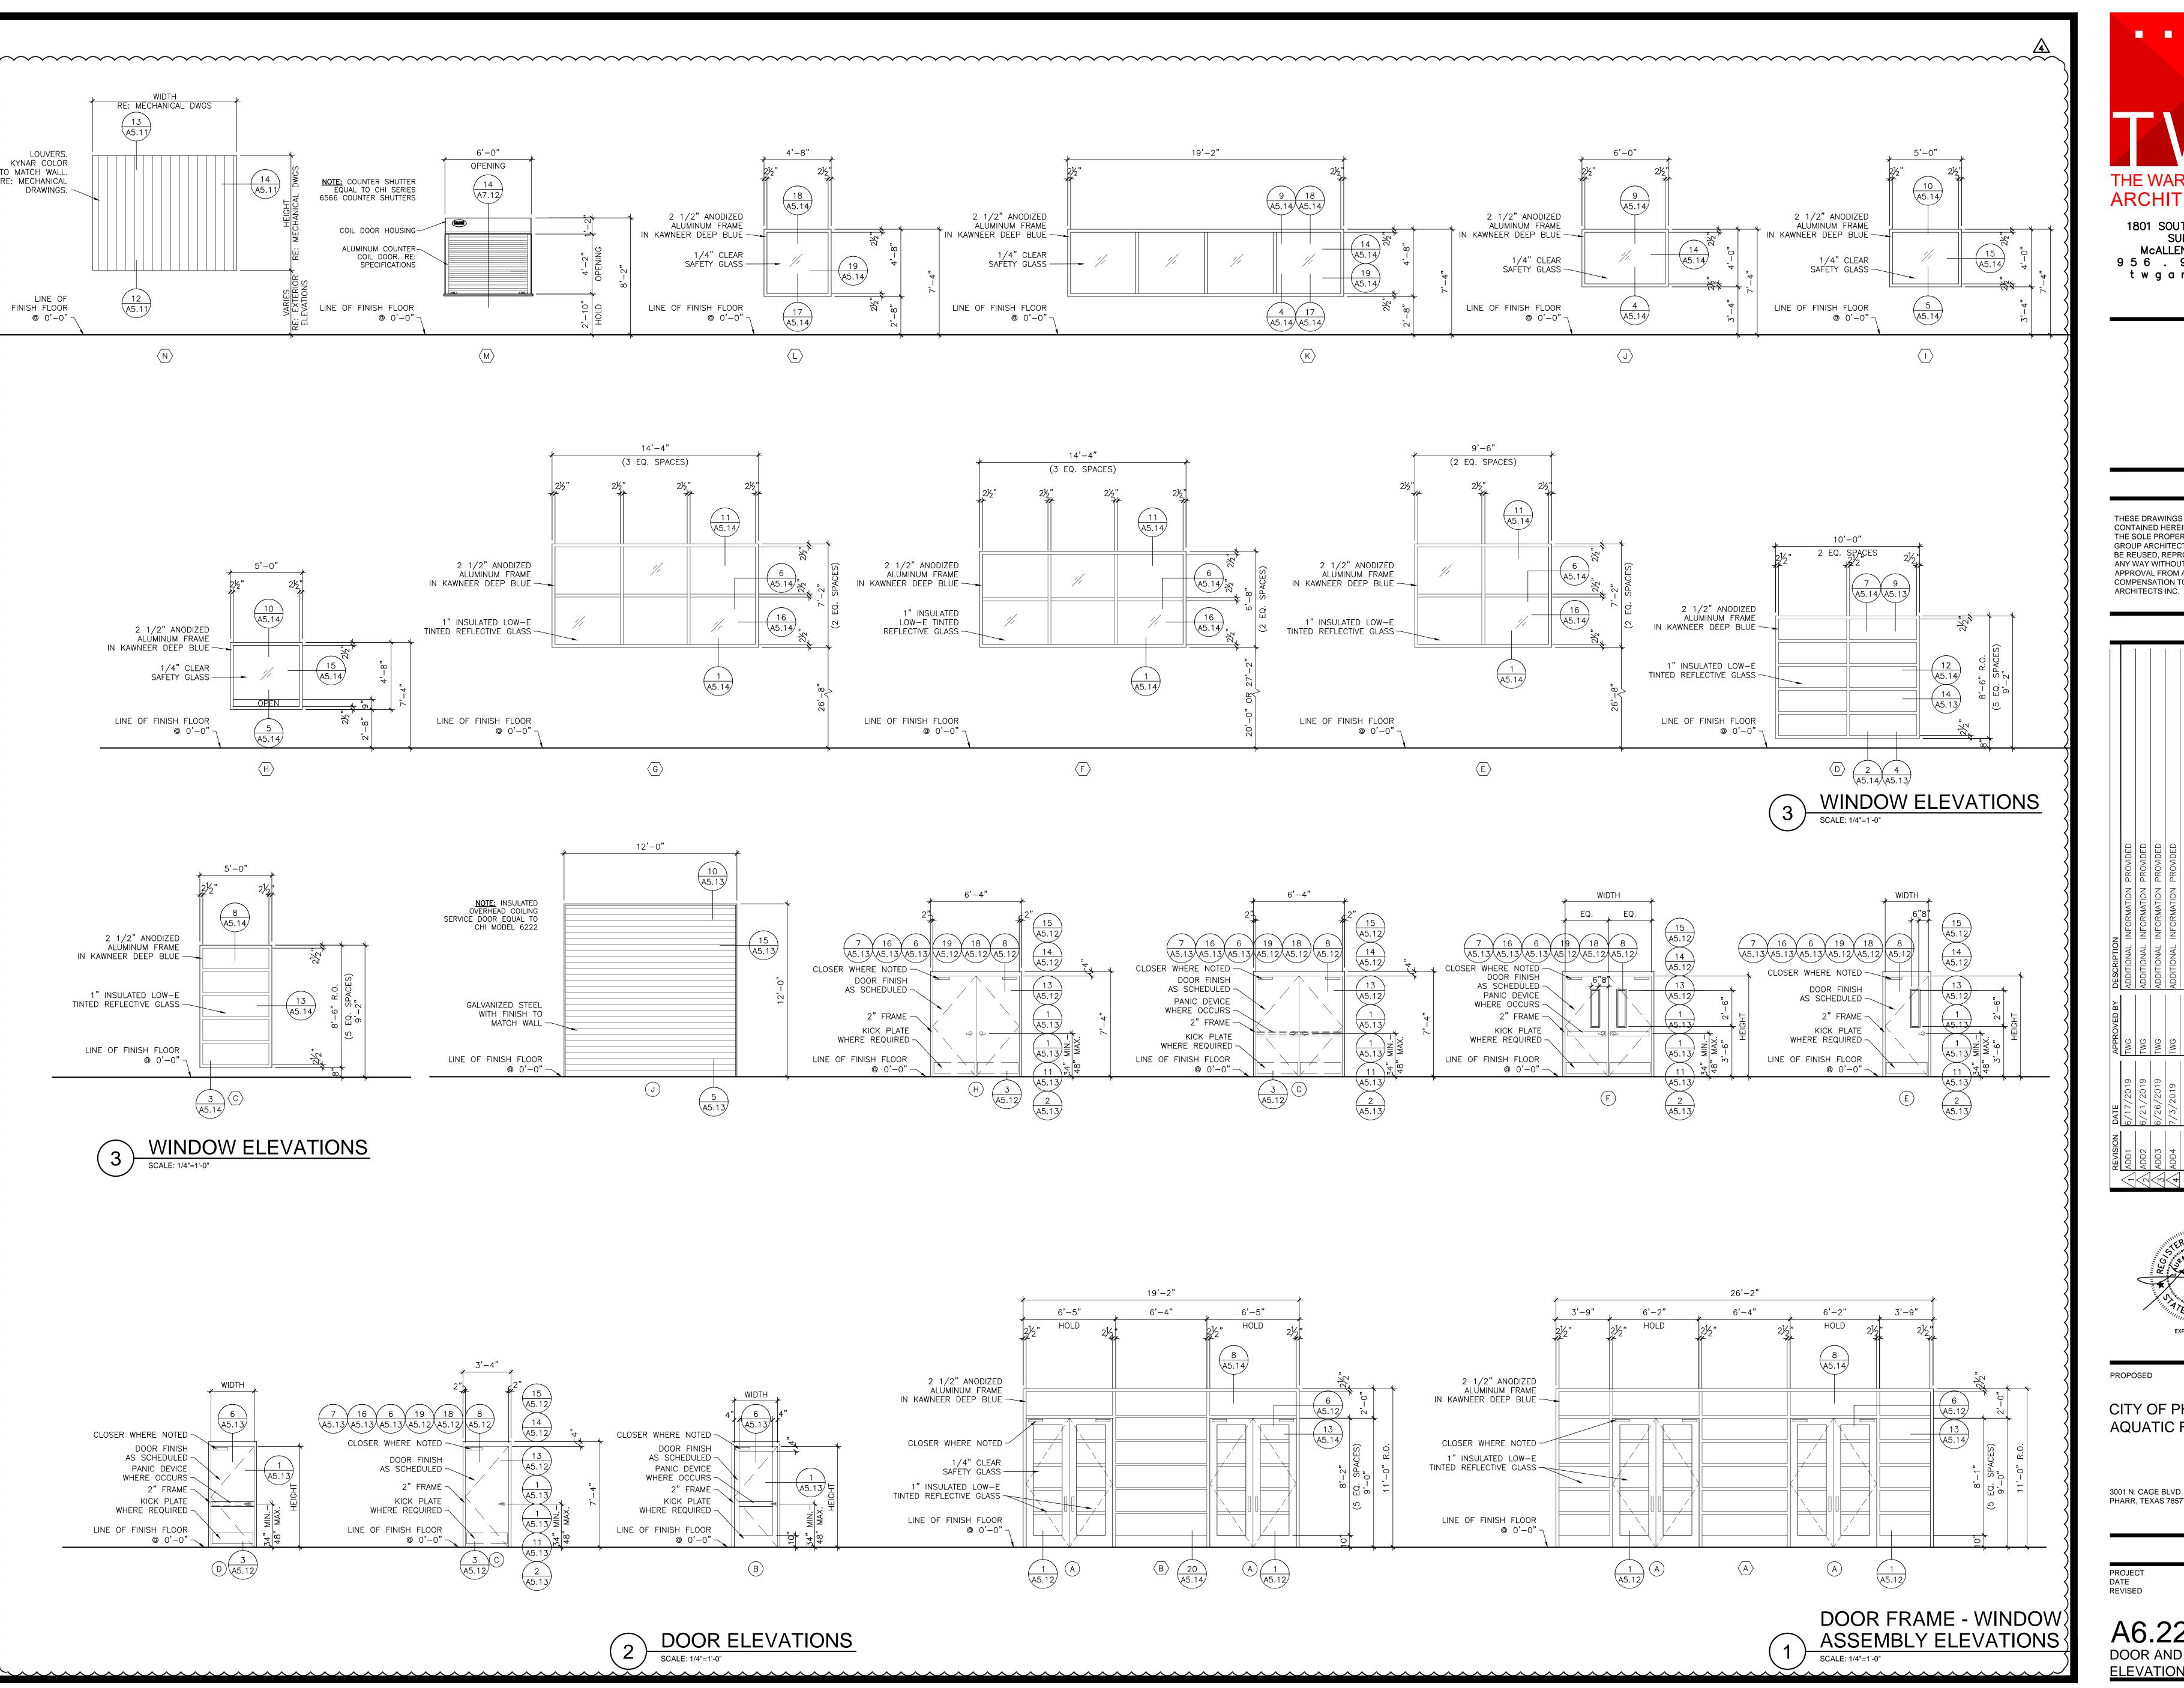


. . . . . ARCHITECTS, INC. 1801 SOUTH SECOND ST. SUITE 330 McALLEN, TX 78503 956 . 994.1900

twgarch.com

THESE DRAWINGS AND INFORMATION CONTAINED HEREIN ARE PROPERTY AND THE SOLE PROPERTY OF THE WARREN GROUP ARCHITECTS, INC. THEY MAY NOT BE REUSED, REPRODUCED OR ALTERED IN ANY WAY WITHOUT PRIOR WRITTEN APPROVAL FROM AND APPROPRIATE COMPENSATION TO THE WARREN GROUP

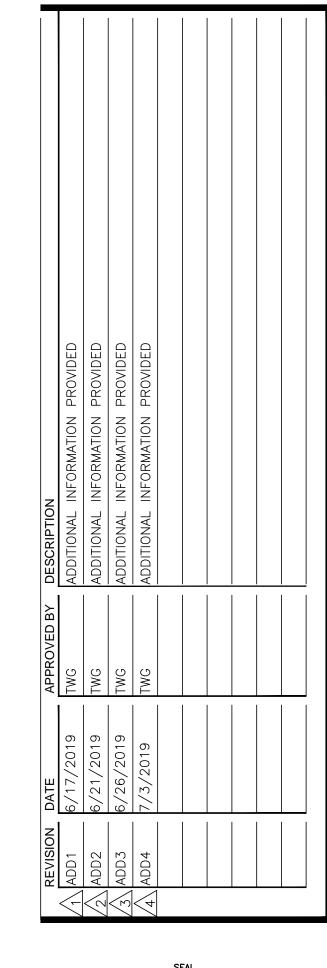

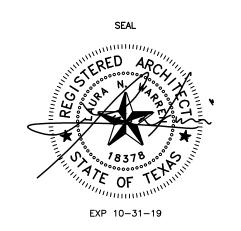


PROPOSED CITY OF PHARR/PSJA AQUATIC FACILITY

3001 N. CAGE BLVD PHARR, TEXAS 78577

PROJECT DATE 971805 06/07/2019 REVISED 07/03/2019


DOOR AND WINDOW **ELEVATIONS** 

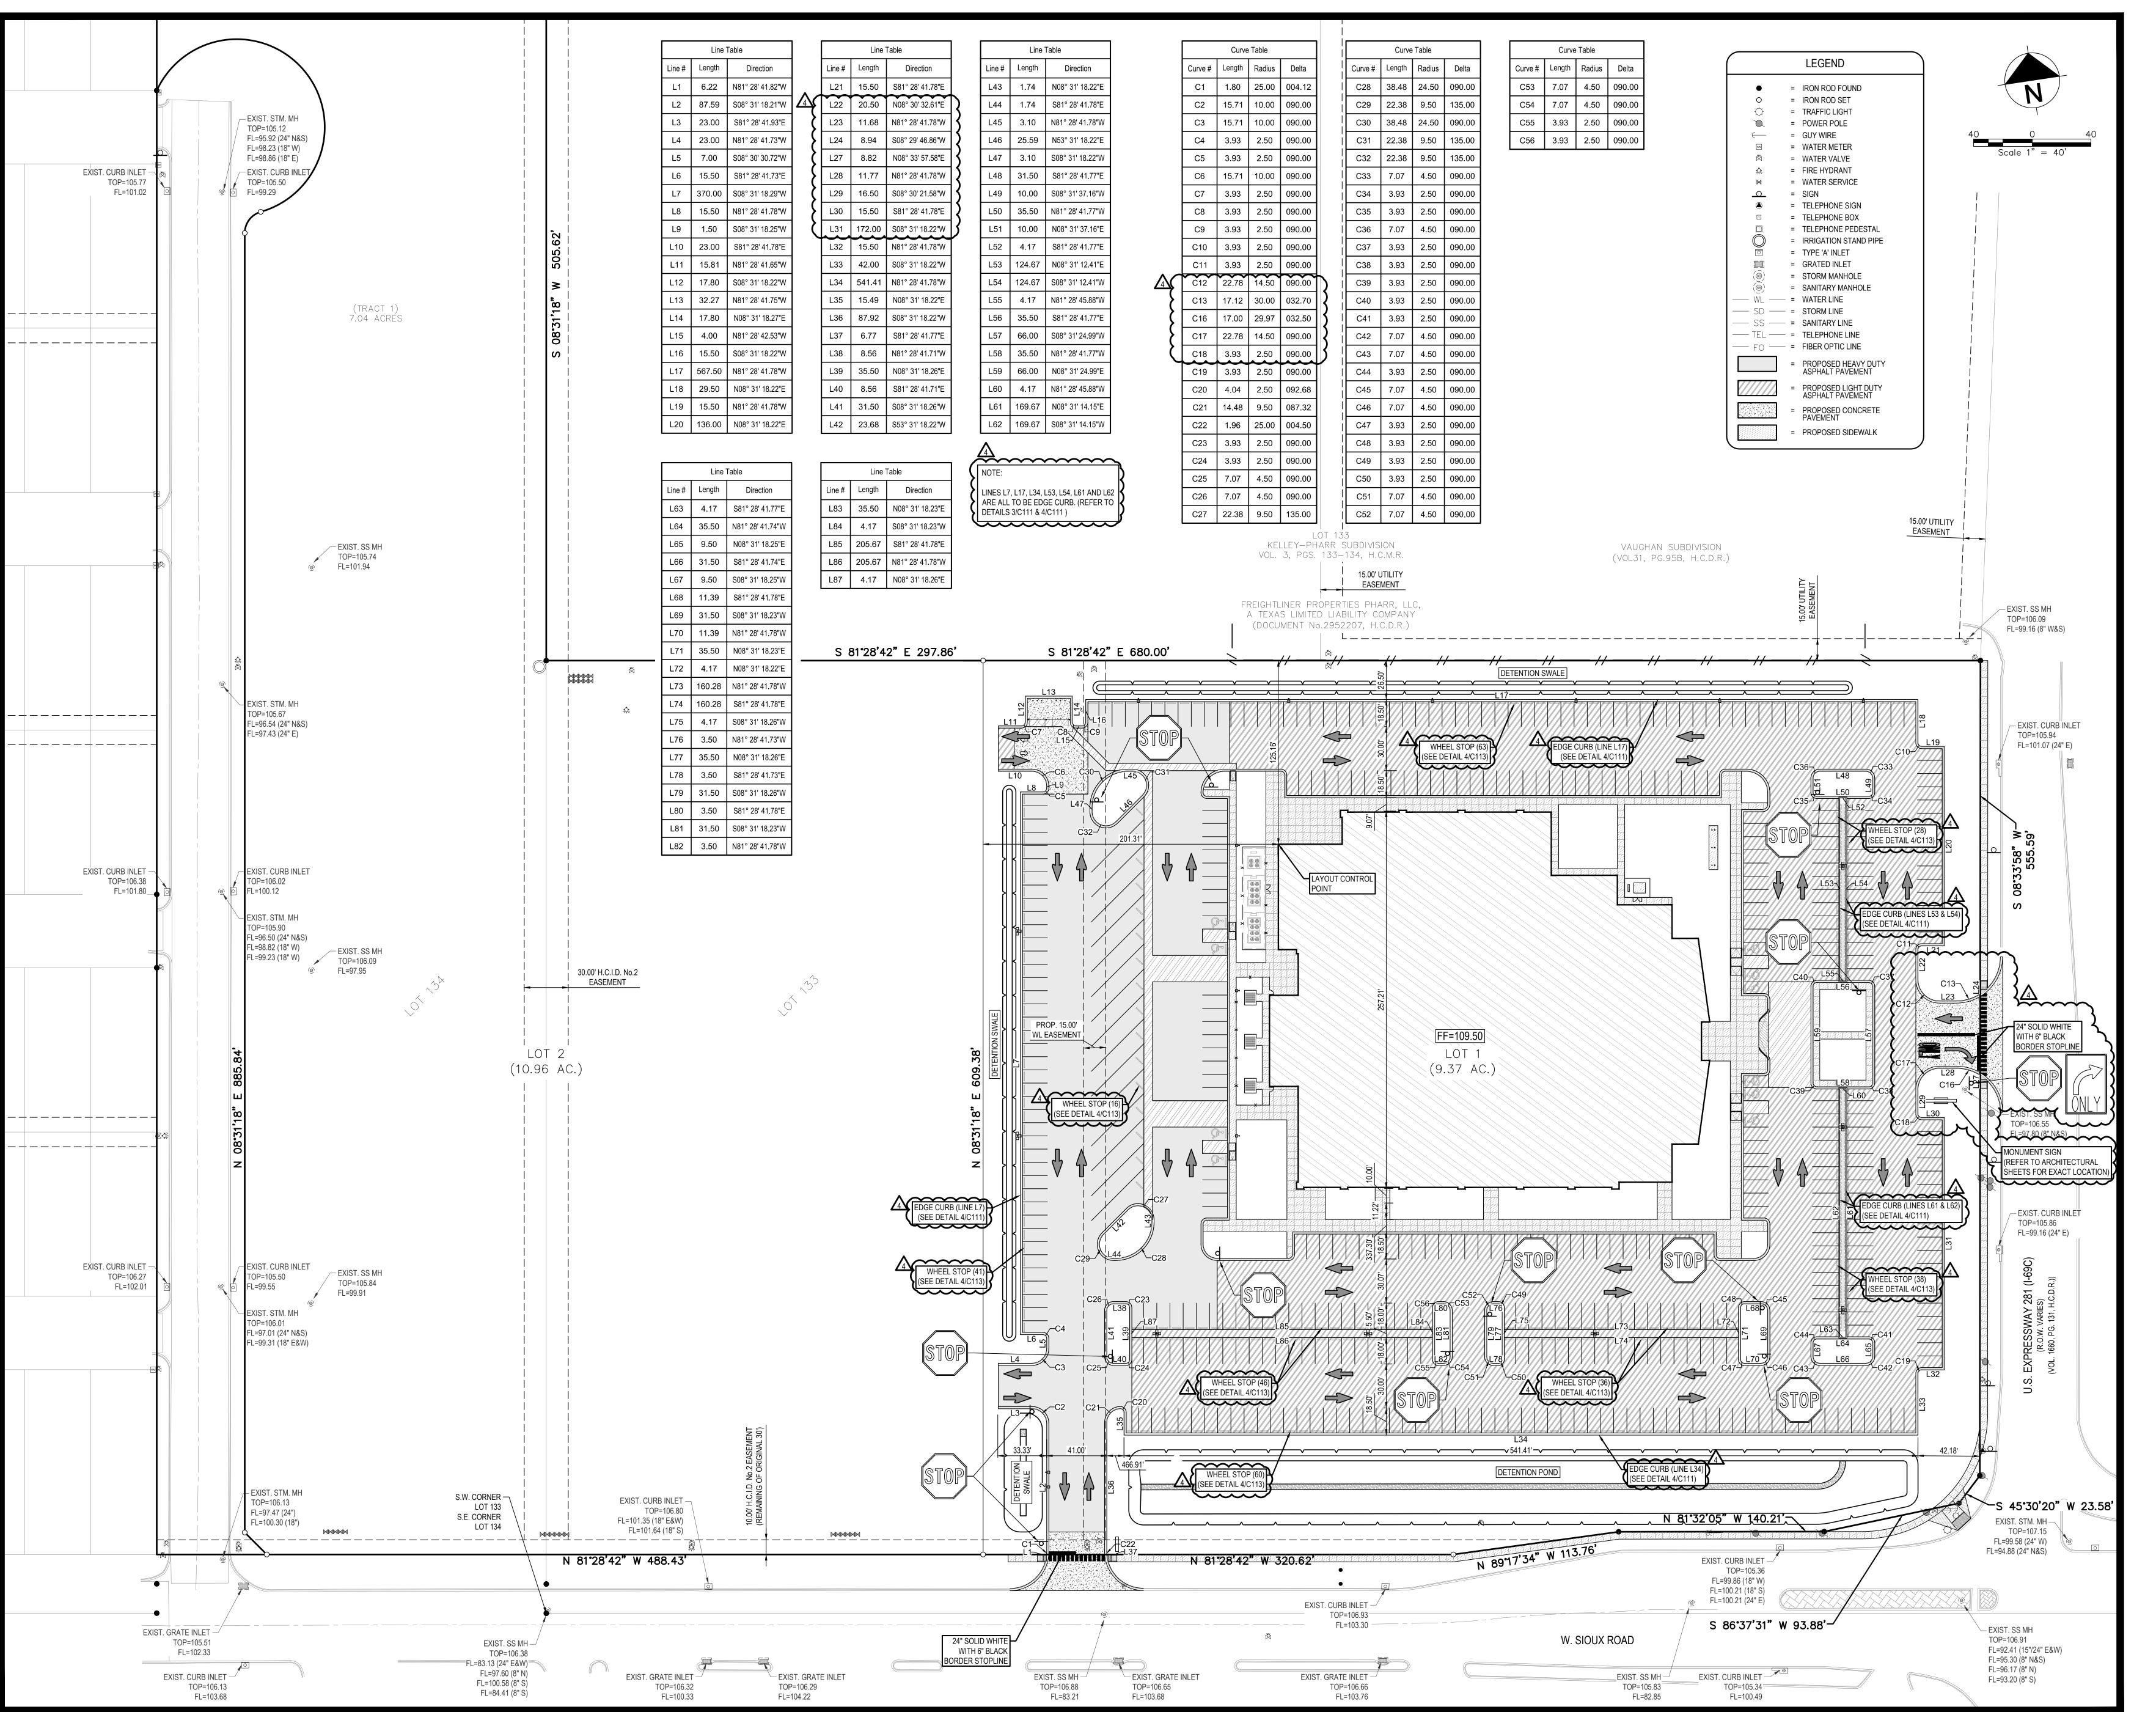





THESE DRAWINGS AND INFORMATION CONTAINED HEREIN ARE PROPERTY AND THE SOLE PROPERTY OF THE WARREN GROUP ARCHITECTS, INC. THEY MAY NOT BE REUSED, REPRODUCED OR ALTERED IN ANY WAY WITHOUT PRIOR WRITTEN APPROVAL FROM AND APPROPRIATE COMPENSATION TO THE WARREN GROUP ARCHITECTS INC.

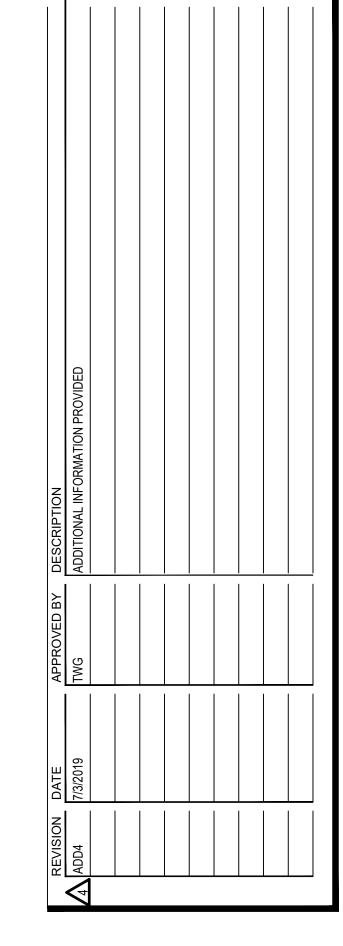




PROPOSED

CITY OF PHARR
AQUATIC FACILITY

W SIOUX RD AND EXPRESSWAY 281 PHARR, TEXAS 78577

PROJECT 971805
6/07/2019
REVISED


C101
DIMENSION
CONTROL & SIGNAGE
PLAN

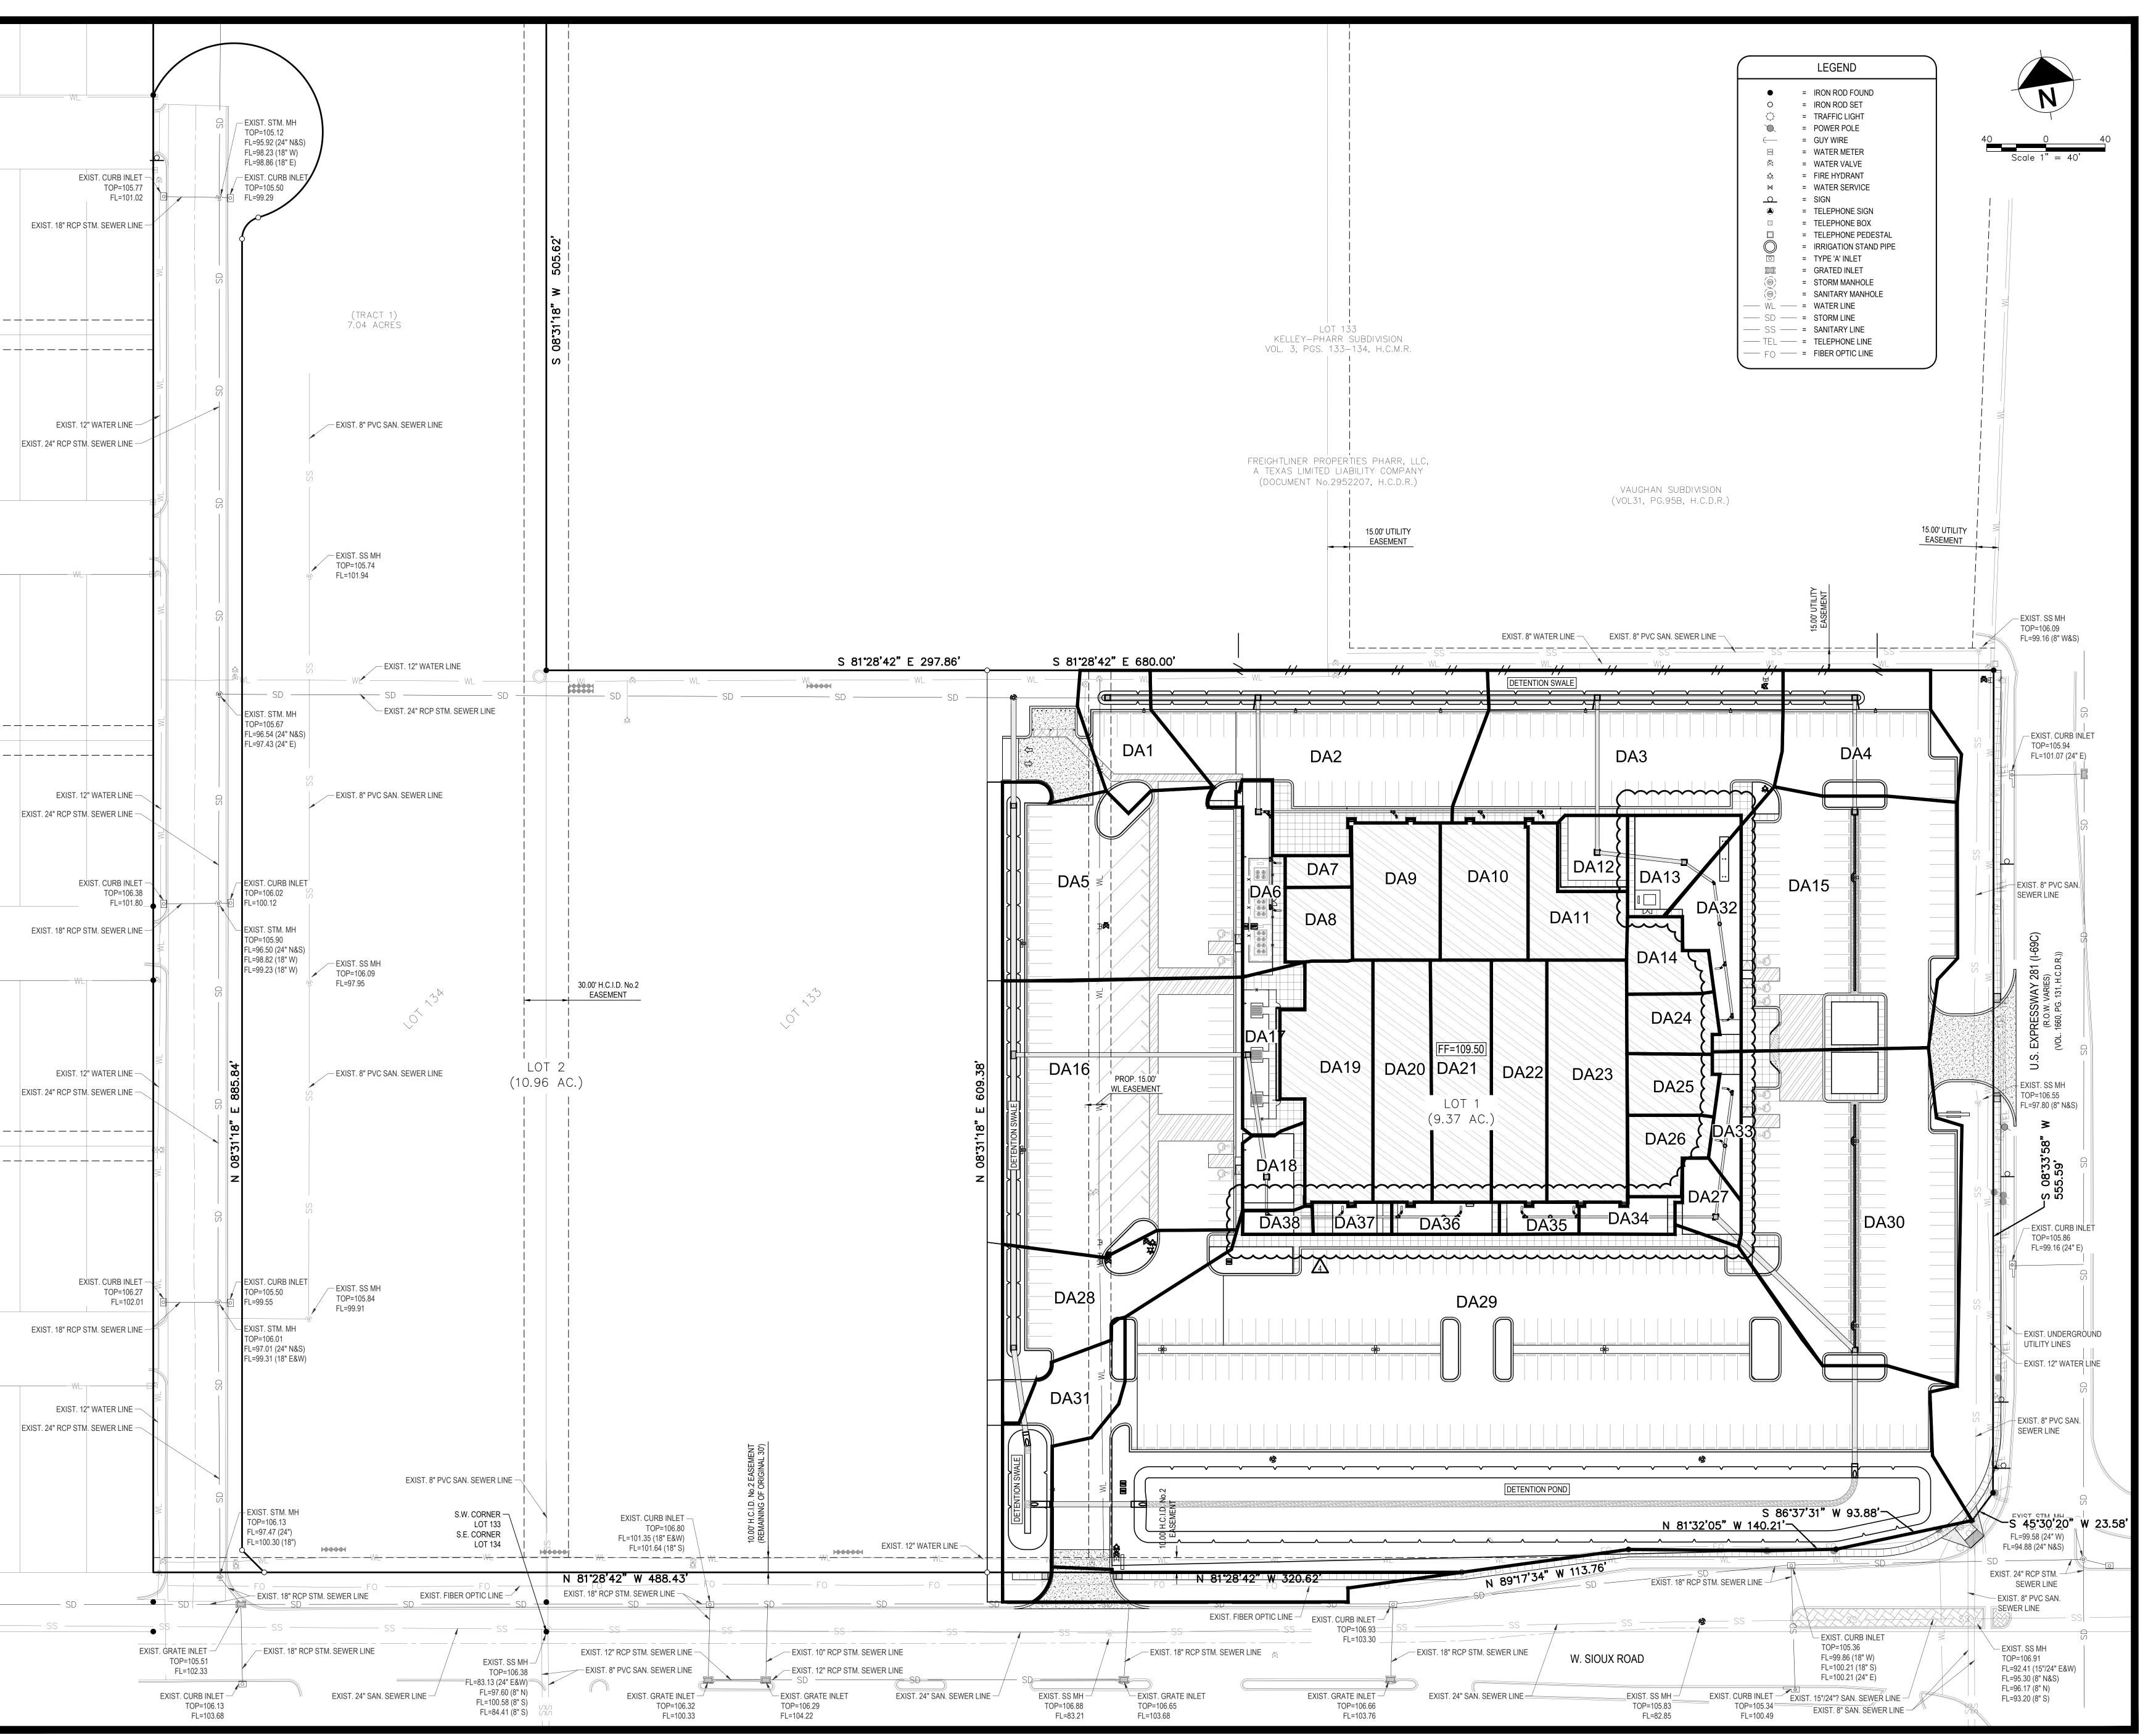





THESE DRAWINGS AND INFORMATION CONTAINED HEREIN ARE PROPERTY AND THE SOLE PROPERTY OF THE WARREN GROUP ARCHITECTS, INC. THEY MAY NOT BE REUSED, REPRODUCED OR ALTERED IN ANY WAY WITHOUT PRIOR WRITTEN APPROVAL FROM AND APPROPRIATE COMPENSATION TO THE WARREN GROUP ARCHITECTS INC.

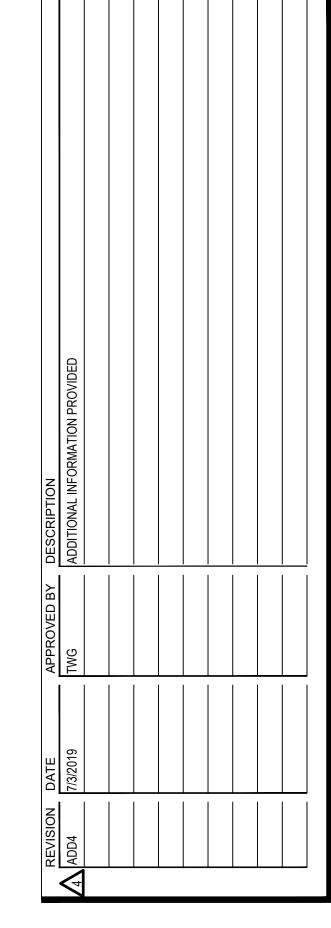



CITY OF PHARR
AQUATIC FACILITY

W SIOUX RD AND EXPRESSWAY 281 PHARR, TEXAS 78577

PROJECT 971805 DATE 6/07/2019 REVISED

C102 DRAINAGE AREA MAP

<u> </u>	<b>~~</b>	······································	······	······	······	······	<b>~~~~</b>	·····	·····	<b>~~~</b>	·····	······	·····	·····	<b>~~~~</b>	·····	·····
PIPE DESIGN CALC	ULATIONS					PIPE DESIGN CALCULATIONS											}
PIPE STRU	T	AREA RUNOFF COEFFICIENT TIME	PIPE DESIGN	HGL RESULTS		PIPE STRUCTURE  3.0000 OUTFALL	AREA R	UNOFF COEFFICIENT	TIME				PIPE DESIGN			HGL RESULTS	3
NO. NO.	TYPE	Incr.Area TotalArea RunoffCoeff. IncrC x A TotalC x A InletTime TimeConc RnfalInt TotalRunoff AdnlFlow TotalFlow CapacFull Veloc LineLength  (ac) (ac) (C) (min) (min) (in/hr) (cfs) (cfs) (cfs) (ft) (ft/s) (ft)	(in) (%)	Inv ElevDn         Inv ElevUp         HGLDn         HGLUp           (ft)         (ft)         (ft)         (ft)		36.0000	0.4700 2.5600 0.69	900 0.3200 1.8600 10.	0000 20.5000 7.6000 14.0	0.0000	14.0800 17.5100	1.9900 101.5890 36.000	0 RCP 0.0130 0.07	00 102.3100	102.3800 105	3700 105.3800	106.2100 106.5300
2.0000	OUTFALL	0.5000         6.2200         0.7600         0.3800         4.4200         10.0000         24.6000         6.9000         30.5900         0.0000         30.5900         17.4600         5.7400         72.9960	36.0000 RCP 0.0130 0.0700	101.3100 101.3600 103.2700 103.670	00 106.4000 105.4400	4.0000 GRATE 37.0000	0.4700 1.5900 0.72	100 0.3300 1.1300 10.	0000 18.0000 8.0000 9.0	700 0.0000	9.0700 17.6200	1.2800 229.2110 36.000	0 RCP 0.0130 0.07	00 102.3800	102.5400 105	5100 105.5400	106.5300 106.5300
2.0000	GRATE	0.7000         5.7200         0.8000         0.5600         4.0400         10.0000         24.0000         7.0000         28.3000         0.0000         28.3000         17.8100         4.0000         168.2700	36,0000 RCP 0.0130 0.0700	101.3600 101.4800 104.3600 104.660	00 105.4400 105.4400	5.0000 GRATE 38.0000	0.2200	500 0.1400 0.6400 10.	0000 10.8000 9.8000 6.3	100 0.0000	6.3100 17.5200	0.8900 173.9890 36.000	0 RCP 0.0130 0.01	00 102.5400	102.6600 105	5900 105.6100	106.5300 106.5300
9.0000	GRATE					6.0000 GRATE	0.6400 0.6400 0.78	300 0.5000 0.5000 10.	0000 10,0000 10,1000 5.0	300 0.0000	5.0300 8.1400	1 6000 77 1670 24 000	0 RCP 0.0130 0.13	00 102 6600	102.7600 105	6200 105,6600	106 5300 107 1200
3.0000	GRATE	0.2400         4.3900         0.6700         0.1600         2.9600         10.0000         23.0000         7.2000         21.1500         0.0000         21.1500         17.7500         2.9900         197.7300	36.0000 RCP 0.0130 0.0700	101.4800         101.6200         105.1500         105.350	00 105.4400 105.4400	7.0000 GRATE	0.0400	330 0.3000 0.3000 13.	10.0000 10.1000 3.0	0.0000	3.0300 0.1400	77.270 24.000	0.0130	102.0000	102.7000	103.0000	}
4.0000	GRATE	0.2000 4.1500 0.4500 0.0900 2.8000 10.0000 22.7000 7.2000 20.1400 0.0000 20.1400 18.1900 2.8500 67.1790	36.0000 RCP 0.0130 0.0700	101.6200 101.6700 105.4300 105.490	00 105.4400 107.0400												<u> </u>
*5	GNATE	0.0000 3.9500 0.0000 0.0000 2.7100 0.0000 22.5000 7.2000 19.5700 0.0000 19.5700 77.3300 2.7700 39.4190	36.0000 RCP 0.0130 1.3400	101.6700 102.2000 105.5600 105.590	00 107.0400 107.2800		0.0600 0.2600 0.33	300 0.0200 0.1500 10.	0000 14.3000 8.9000 1.3	400 0.0000	1.3400 7.9800	0.4300 104.4750 24.000	0 RCP 0.0130 0.12	00 102.7000	102.8300 105	6000 105.6000	106.5300 109.0900
6.0000		2.7500     3.9500     0.6200     1.7100     2.7100     10.0000     22.1000     7.3000     19.7400     0.0000     19.7400     40.6000     2.7900     78.2500	36.0000 RCP 0.0130 0.3700	102.2000 102.4900 105.7700 105.840	00 107.2800 107.5700	19.0000 GRATE	0.0800 0.2000 0.29	200 0.0200 0.1300 10	0000 11 9000 9 5000 1 2	500 0.0000	1 2500 7 7800	0.4000 59.1240 24.000	0 RCP 0.0130 0.13	00 102 8300	102,9000 105	6100 105,6100	109 0900 110 5300
*7	GRATE	0.0000         1.2000         0.0000         1.0000         1.0000         16.2000         8.4000         8.4300         0.0000         8.4300         21.1200         1.1900         478.5710	36.0000 RCP 0.0130 0.1000	102.4900 102.9700 106.0000 106.080	00 107.5700 106.8600	20.0000 GRATE	0.2000 0.23	0.0200 0.1300 10.	3.3000	0.0000	1.2300 7.7000	0.4000 35.1240 24.000	0.0130	102.0300	102.3000	103.0100	103.0300
*8 14.0000	МН	0.0000         1.2000         0.0000         1.0000         0.0000         16.0000         8.5000         8.4700         0.0000         17.8300         1.2000         16.8000	36.0000 RCP 0.0130 0.0700	102.9700 102.9800 106.1100 106.110	00 106.8600 108.0600												1
9.0000	GRATE	0.6400	36,0000 RCP 0,0130 0,0700	102.9800 103.0400 106.1200 106.140	00 108.0600 107.1200	42.0000 GRATE	0.0800 0.5000 0.36	500 0.0300 0.4100 10.	0000 12.2000 9.4000 3.8	300 0.0000	3.8300 7.7300	1.2200 77.0010 24.000	0 RCP 0.0130 0.12	00 102.4300	102.5200 105	5100 105.5300	106.5300 108.5700
16.0000	GRATE		0.0130 0.0700			18.0000 GRATE											1
10.0000	GRATE	0.1000         0.5600         0.4200         0.0400         0.4600         10.0000         11.5000         9.6000         4.3900         0.0000         4.3900         17.5400         0.6200         130.1690	36.0000 RCP 0.0130 0.0700	103.0400 103.1300 106.1800 106.190	00 107.1200 108.8900	20,000											3
11.0000 58.0000		0.0000 0.3400 0.0000 0.0000 0.3100 0.0000 10.4000 9.9000 3.0400 0.0000 3.0400 2.5400 3.8800 93.0000	12.0000 PVC 0.0100 0.3000	103.1300 103.4100 106.2000 106.600	00 108.8900 104.4300	20.0000 GRATE 43.0000	0.0000 0.1200 0.00	000 0.0000 0.1100 0.0	0000 11.6000 9.6000 1.0	400 0.0000	1.0400 2.4800	1.3200 24.4400 12.000	0 PVC 0.0100 0.29	00 102.9000	102.9700 105	6100 105.6300	110.5300 104.0500
12.0000 59.0000	BEIND	0.0000 0.1400 0.0000 0.0000 0.1300 0.0000 10.0000 10.1000 1.2700 0.0000 1.2700 2.5400 1.6100 35.0000	12.0000 PVC 0.0100 0.3000	103.4100 103.5200 106.9700 106.990	00 104.4300 104.4700	40.0000 BEND 44.0000	0.0000 0.1200 0.00	000 0.0000 0.1100 0.0	0000 10.9000 9.8000 1.0	600 0.0000	1.0600 2.5000	1.3500 54.8110 12.000	D PVC 0.0100 0.29	00 102.9700	103.1300 105	6500 105.6800	104.0500 104.2100
\$ 59.0000	RFND					41.0000 BEND 45.0000	0.0000 0.0600 0.00	000 0.0000 0.0500 0.0	0000 10.0000 10.1000 0.5	400 0.0000	0.5400 2.5900	0.6900 35.2600 12.000	0 PVC 0.0100 0.3°	00 103.1300	103.2400 105	7200 105.7200	104.2100 104.3200
17.0000	GRATE					42.0000 BEND	3.00	3.333				22.300	3.3		133		3
13.0000	BEND	0.0000         0.1200         0.0000         0.0000         0.1100         0.0000         10.9000         9.8000         1.0600         0.0000         1.0600         2.5300         1.3500         48.4640	12.0000 PVC 0.0100 0.3000	103.1300 103.2800 106.2000 106.220	00 108.8900 104.3800												}
14.0000		0.0000 0.0600 0.0000 0.0000 0.0500 0.0000 10.0000 10.1000 0.5400 0.0000 0.5400 2.5300 0.6900 35.3950	12.0000 PVC 0.0100 0.3000	103.2800 103.3800 106.2600 106.270	00 104.3800 104.4200		0.0000 0.4200 0.00	0.00 0.0000 0.3800 0.00	0000 12.2000 9.4000 3.5	600 0.0000	3.5600 2.4300	4.5300 5.0300 12.000	0 PVC 0.0100 0.40	00 102.5200	102.5400 105	5700 105.6100	108.5700 103.6200
}						23.0000 BEND	0.0000 0.3500 0.00	0.00 0.0000 0.3200 0.00	0000 11.7000 9.6000 3.0	100 0.0000	3.0100 4.0600	2.4600 81.3850 15.000	0 PVC 0.0100 0.23	00 102.5400	102.7300 106	0800 106.1800	103.6200 103.8700
59.0000	REND					24.0000 BEND 48.0000	0.0000 0.2200 0.00	000 0,0000 0,2000 0,0	0000 11 0000 9 8000 1 9	300 0.0000	1.9300 4.0100	1.5800 65.6670 15.000	0 PVC 0.0100 0.23	00 102.7300	102 8800 106	3100 106.3400	103.8700 104.0700
15.0000 60.0000	BEND	0.0000         0.1400         0.0000         0.0000         0.1300         0.0000         10.1000         1.2700         0.0000         1.2700         1.1100         3.6400         4.0000	8.0000 PVC 0.0100 0.5000	103.5200 103.5400 107.0200 107.050	00 104.4700 104.1400	25.0000 BEND		0.0000 0.2000 0.6	9.8000	0.0000	1.5300 4.0100	25555		102.7300	101.0000	200.0100	}
16.0000		0.1400	8.0000 PVC 0.0100 0.5000	103.5400 103.5600 107.2100 107.230	00 104.1400 0.0000	49.0000 BEND	0.0000 0.0900 0.00	0.00 0.0000 0.0000 0.00	0000 10.0000 10.1000 0.8	200 0.0000	0.8200 4.1200	0.6600 37.4170 15.000	0 PVC 0.0100 0.24	00 102.8800	102.9700 106	4000 106.4100	104.0700 104.1800
<b>}</b>	BEIND																}
58.0000	BEND					42.0000 BEND	0.0000 0.0600 0.00	000 0,0000 0,0500 0,0	0000 10.0000 10.1000 0.5	400 0.0000	0.5400 0.6100	2.7700 4.2430 6.000	PVC 0.0100 0.7;	00 103.2400	103.2700 105	7300 105.7500	104.3200 103.8100
17.0000 62.0000	BEND	0.0000         0.2000         0.0000         0.0000         0.1800         0.0000         10.1000         1.8100         0.0000         1.8100         1.1300         5.1900         4.2430	8.0000 PVC 0.0100 0.5200	103.4100 103.4300 106.7700 106.830	00 104.4300 104.1000	43.0000 BEND			10.0000 10.1000 0.5			2.7700 4.2430 0.000	0.0100	103.2400	103.2700	7300 103.7300	3
18.0000		0.2000         0.2000         0.9000         0.1800         0.1800         10.0000         10.1000         1.8100         0.0000         1.8100         1.1100         5.2000         4.0000	8.0000 PVC 0.0100 0.5000	103.4300 103.4500 107.1500 107.200	00 104.1000 0.0000	51.0000 44.0000 BEND	0.0600 0.0600 0.90	000 0.0500 0.0500 10.	0000 10.0000 10.1000 0.5	400 0.0000	0.5400 0.5300	2.7700 4.0000 6.000	PVC 0.0100 0.78	00 103.2700	103.3000 105	8400 105.8700	103.8100 0.0000
}	BEND																
65.0000	BEND					26.0000 BEND 52.0000	0.0000 0.0900 0.00	0.0 0080.0 0000.0 000	0000 10.0000 10.1000 0.8	200 0.0000	0.8200 1.0800	2.3400 4.2430 8.000	) PVC 0.0100 0.4	00 102.9700	102.9900 106	4100 106.4200	104.1800 103.8500
19.0000 66.0000	BEND	0.0000         0.0600         0.0000         0.0000         0.0500         0.0000         10.0000         10.1000         0.5400         0.0000         0.5400         0.6300         2.7700         4.2430	6.0000 PVC 0.0100 0.7500	103.3800 103.4100 106.2800 106.300	00 104.4200 103.9100	27.0000 BEND	0.0900 0.0900 0.90					2,3400 2,0000 8,000		00 102 9900		4900 106.4900	5
20.0000 67.0000		0.0600         0.0600         0.9000         0.0500         0.0500         10.0000         10.0000         10.1000         0.5400         0.0000         0.5400         0.6300         2.7700         4.0000	6.0000 PVC 0.0100 0.7500	103.4100 103.4400 106.3900 106.410	00 103.9100 0.0000	28.0000 BEND	0.0900 0.0900 0.90	0.0800 0.0800 10.	0000 10.0000 10.1000 0.8	200 0.0000	0.8200 0.9300	2.5400 2.0000 8.000	7 PVC 0.0100 0.30	102.9900	103.0000 106	4900 106.4900	103.8300 0.0000
}																	1
64.0000	BEND	0.0000 0.0600 0.0000 0.0000 0.0500 0.0000 10.0000 10.1000 0.5400 0.0000 0.5400 0.6400 2.7700 4.2430	6 0000 PVC 0 0100 0 7800	103.2800 103.3100 106.2400 106.270	00 104 3800 103 8700		0.0000 0.0600 0.00	0.000 0.0000 0.0500 0.0	0000 10.0000 10.1000 0.5	400 0.0000	0.5400 0.6200	2.7700 4.1490 6.000	PVC 0.0100 0.72	00 103.1300	103.1600 105	7000 105.7200	104.2100 103.7000
21.0000 68.0000	BEND		5,5000			45.0000 BEND	0.0600 0.0600 0.90	000 0.0500 0.0500 10	0000 10,0000 10,1000 0.5	400 0.0000	0.5400 0.6300	2 7700 4 0000 6 000	PVC 0.0100 0.75	00 103.1600	103.1900 105	8100 105,8300	103,7000 0,0000
22.0000 69.0000	BEND	0.0600         0.0600         0.9000         0.0500         0.0500         10.0000         10.0000         10.1000         0.5400         0.0000         0.5400         0.6300         2.7700         4.0000	6.0000 PVC 0.0100 0.7500	103.3100 103.3400 106.3600 106.380	00 103.8700 0.0000	46.0000 BEND	0.0000 0.000	333 3.5500 3.5500 13.	2000 200000 200200 0.0		0.000	2.7760	0.0250	1331233	20012300	100,0000	3
<b>}</b>																	}
9.0000			30,0000 RCP 0.0130 0.0900	101.3500 101.4900 105.2700 105.290	00 105.4400 108.8100		0.0000 0.1300 0.00	000 0.0000 0.1200 0.0	0000 10.0000 10.1000 1.1	800 0.0000	1.1800 1.0800	3.3800 4.2430 8.000	) PVC 0.0100 0.4	00 102.8800	102.9000 106	3700 106.3900	104.0700 103.7400
21.0000	GRATE						0.1300 0.1300 0.90	000 0.1200 0.1200 10.	0000 10.0000 10.1000 1.1	800 0.0000	1.1800 1.2500	3.3800 1.5740 8.000	) PVC 0.0100 0.64	00 102.9000	102.9100 106	5300 106.5400	103.7400 0.0000
22.0000		0.0500         0.5500         0.4200         0.0200         0.4700         10.0000         11.3000         9.7000         4.5600         0.0000         4.5600         7.8300         1.4500         83.4360		102.4500 102.5500 105.3200 105.350	2003200	30.0000 BEND											1
25.0000 47.0000	BEND	0.0000         0.5000         0.0000         0.0000         0.4500         0.0000         11.2000         9.7000         4.3700         0.0000         4.3700         3.8300         3.5600         24.0320	15.0000 PVC 0.0100 0.2100	102.6200 102.6700 105.3700 105.430	00 108.9800 103.6600	10,000											
26.0000 48.0000	BEND	0.0000 0.5000 0.0000 0.0000 0.4500 0.0000 11.1000 9.7000 4.3700 0.0000 4.3700 4.0800 3.5600 4.2430	15.0000 PVC 0.0100 0.2400	102.6700 102.6800 105.5800 105.590	00 103.6600 103.6700		0.0000 0.0700 0.00	000 0.0000 0.0600 0.0	0000 11.6000 9.6000 0.6	0.0000	0.6000 2.2500	0.7700 4.2430 12.000	0 PVC 0.0100 0.24	00 102.5400	102.5500 106	1600 106.1600	103.6200 103.6300
27.0000		0.0000 0.5000 0.0000 0.0000 0.4500 0.0000 10.9000 9.8000 4.4000 0.0000 4.4000 4.1400 3.5900 45.2800	15.0000 PVC 0.0100 0.2400	102.6800 102.7900 105.7400 105.860	00 103.6700 103.8100	33.0000 BEND 59.0000	0.0000 0.0700 0.00			200 0.0000		0.7800 28.7190 12.000	D PVC 0.0100 0.35	00 102.5500	102.6500 106	1700 106.1700	103.6300 103.7300
28.0000		0.0000 0.3000 0.0000 0.0000 0.2700 0.0000 10.6000 9.9000 2.6700 0.0000 2.6700 3.9800 2.1700 40.0000	15.0000 PVC 0.0100 0.2200	102.7900 102.8800 106.1400 106.180	00 103.8100 103.9300	34.0000 BEND 60.0000	0.0000 0.0500 0.00	0.00 0.0000 0.0500 0.0		500 0.0000			0 PVC 0.0100 0.3:	00 102.6500	102.7500 106	1800 106.1900	103.7300 103.8300
29.0000	BEND	0.0000         0.1500         0.0000         0.1400         0.0000         10.0000         10.1000         1.3600         0.0000         1.3600         3.9800         1.1100         40.0000	15.0000 PVC 0.0100 0.2300		00 103.9300 104.0500	35.0000 BEND	3.5555	3.555	201200 0.4	2.0000	2.5000	12.000			100	255.2560	3
30.0000	BEND	0.0000         0.1500         0.0000         0.0000         0.1400         0.0000         10.0000         10.1000         1.3600         0.0000         1.3600         1.0800         3.9000         4.2430	8.0000 PVC 0.0100 0.4700	102.9700 102.9900 106.3200 106.350	00 104.0500 103.7200												}
\$ 52.0000 31.0000	BEND	0.1500         0.9000         0.1400         0.1400         10.0000         10.1000         1.3600         0.0000         1.3600         1.1100         3.9000         4.0000	8.0000 PVC 0.0100 0.5000	102.9900 103.0100 106.5200 106.550	00 103.7200 0.0000	24.0000 BEND	0.0000 0.1300 0.00	000 0.0000 0.1200 0.0	0000 10.0000 10.1000 1.1	800 0.0000	1.1800 1.0800	3.3800 4.2430 8.000	) PVC 0.0100 0.4	00 102.7300	102.7500 106	2500 106.2700	103.8700 103.5400
53.0000	BEND					31.0000 BEND 62.0000		000 0.1200 0.1200 10.	0000 10.0000 10.1000 1.1	800 0.0000	1.1800 1.2500	3.3800 1.5740 8.000	) PVC 0.0100 0.64	00 102.7500	102.7600 106	4100 106.4200	103.5400 0.0000
<b>}</b>						32.0000 BEND											1
32.0000	BEND		8.0000 PVC 0.0100 0.4700	102.8500     102.8700     106.2400     106.270	00 103.9300 103.6000	35,0000											
\$ 54.0000 33.0000	BEND		8.0000 PVC 0.0100 0.5000	102.8300 102.8500 106.4500 106.480	00 103.6000 0.0000	00.0000	0.0000 0.0500 0.00	0.0000   0.0000   0.0	0000 10.0000 10.1000 0.4	500 0.0000	0.4500 0.6100	2.3100 4.2430 6.000	PVC 0.0100 0.7	00 102.7500	102.7800 106	1900 106.2100	103.8300 103.3200
55.0000	BEND			253.100		36.0000 BEND	0.0500 0.0500 0.90	000 0.0500 0.0500 10.	0000 10.0000 10.1000 0.4	500 0.0000	0.4500 0.6300	2.3100 4.0030 6.000	PVC 0.0100 0.75	00 102.7800	102.8100 106	2700 106.2900	103.3200 0.0000
}						37.0000 BEND											1
34.0000		0.0000         0.2000         0.0000         0.0000         0.1800         0.0000         10.0000         10.1000         1.8100         0.0000         1.8100         1.0800         5.1900         4.2430	8.0000 PVC 0.0100 0.4700	102.7900     102.8100     106.0100     106.070	00 103.8100 103.4800	34.0000 BEND											3
35.0000	BEND	0.2000         0.2000         0.9000         0.1800         0.1800         10.0000         10.1000         1.8100         0.0000         1.8100         1.1100         5.2000         4.0000	8.0000 PVC 0.0100 0.5000	102.8100     102.8300     106.3900     106.440	00 103.4800 0.0000	65.0000	0.0000   0.0200   0.00	000 0.0000 0.0200 0.0	0000 10.1000 10.1000 0.1	800 0.0000	0.1800 0.6100	0.9200 4.2430 6.000	0 PVC 0.0100 0.73	00 102.6500	102.6800 106	1800 106.1800	103.7300 103.2200
57.0000	BEND						0.0200 0.0200 0.90	000 0.0200 0.0200 10.	0000 10.0000 10.1000 0.1	800 0.0000	0.1800 0.6300	0.9200 4.0000 6.000	PVC 0.0100 0.75	00 102.6800	102.7100 106	1900 106.2000	103.2200 0.0000
(					1	39.0000 BEND											<b>}</b>

PIPE DESIGN CALCULATIONS PIPE STRUCTURE AREA RUNOFF COEFFICIENT TIME PIPE DESIGN HGL RESULTS 3.0000 OUTFALL																									
3.0000	OUTFALL								7.5000	11.0000	0.0000	44.0000	47.5400	1 0000	404 5000	25,0000	D.CD.			402.2400	402 2000			105 2100	105 5200
36.0000 4.0000	GRATE	0.4700	2.5600	0.6900	0.3200	1.8600	10.0000	20.5000	7.6000	14.0800	0.0000	14.0800	17.5100	1.9900	101.5890	36.0000	RCP	0.0130	0.0700	102.3100	102.3800	105.3700	105.3800	106.2100	106.5300
37.0000 5.0000	GRATE	0.4700	1.5900	0.7100	0.3300	1.1300	10.0000	18.0000	8.0000	9.0700	0.0000	9.0700	17.6200	1.2800	229.2110	36.0000	RCP	0.0130	0.0700	102.3800	102.5400	105.5100	105.5400	106.5300	106.5300
38.0000 6.0000	GRATE	0.2200	0.8600	0.6500	0.1400	0.6400	10.0000	10.8000	9.8000	6.3100	0.0000	6.3100	17.5200	0.8900	173.9890	36.0000	RCP	0.0130	0.0700	102.5400	102.6600	105.5900	105.6100	106.5300	106.5300
39.0000 7.0000		0.6400	0.6400	0.7800	0.5000	0.5000	10.0000	10.0000	10.1000	5.0300	0.0000	5.0300	8.1400	1.6000	77.1670	24.0000	RCP	0.0130	0.1300	102.6600	102.7600	105.6200	105.6600	106.5300	107.1200
7.0000	GRATE																								
5.0000	GRATE																								
40.0000	GRATE	0.0600	0.2600	0.3300	0.0200	0.1500	10.0000	14.3000	8.9000	1.3400	0.0000	1.3400	7.9800	0.4300	104.4750	24.0000	RCP	0.0130	0.1200	102.7000	102.8300	105.6000	105.6000	106.5300	109.0900
41.0000	GRATE	0.0800	0.2000	0.2900	0.0200	0.1300	10.0000	11.9000	9.5000	1.2500	0.0000	1.2500	7.7800	0.4000	59.1240	24.0000	RCP	0.0130	0.1200	102.8300	102.9000	105.6100	105.6100	109.0900	110.5300
20.0000	GRATE																								
4.0000	GRATE																								
42.0000 18.0000	GRATE	0.0800	0.5000	0.3600	0.0300	0.4100	10.0000	12.2000	9.4000	3.8300	0.0000	3.8300	7.7300	1.2200	77.0010	24.0000	RCP	0.0130	0.1200	102.4300	102.5200	105.5100	105.5300	106.5300	108.5700
20.0000 43.0000	GRATE	0.0000	0.1200	0.0000	0.0000	0.1100	0.0000	11.6000	9.6000	1.0400	0.0000	1.0400	2.4800	1.3200	24.4400	12.0000	PVC	0.0100	0.2900	102.9000	102.9700	105.6100	105.6300	110.5300	104.0500
40.0000	BEND																								
44.0000	BEND	0.0000	0.1200	0.0000	0.0000	0.1100	0.0000	10.9000	9.8000	1.0600	0.0000	1.0600	2.5000	1.3500	54.8110	12.0000	PVC	0.0100	0.2900	102.9700	103.1300	105.6500	105.6800	104.0500	104.2100
45.0000 42.0000	BEND	0.0000	0.0600	0.0000	0.0000	0.0500	0.0000	10.0000	10.1000	0.5400	0.0000	0.5400	2.5900	0.6900	35.2600	12.0000	PVC	0.0100	0.3100	103.1300	103.2400	105.7200	105.7200	104.2100	104.3200
			_																		<u> </u>				
18.0000 46.0000	GRATE	0.0000	0.4200	0.0000	0.0000	0.3800	0.0000	12.2000	9.4000	3.5600	0.0000	3.5600	2.4300	4.5300	5.0300	12.0000	PVC	0.0100	0.4000	102.5200	102.5400	105.5700	105.6100	108.5700	103.6200
23.0000	BEND																								
47.0000 24.0000	BEND	0.0000	0.3500	0.0000	0.0000	0.3200		11.7000	9.6000	3.0100	0.0000	3.0100	4.0600	2.4600	81.3850	15.0000	PVC	0.0100	0.2300	102.5400	102.7300	106.0800	106.1800	103.6200	103.8700
48.0000 25.0000	BEND	0.0000	0.2200	0.0000	0.0000	0.2000	0.0000	11.0000	9.8000	1.9300	0.0000	1.9300	4.0100	1.5800	65.6670	15.0000	PVC	0.0100	0.2300	102.7300	102.8800	106.3100	106.3400	103.8700	104.0700
49.0000	BEND	0.0000	0.0900	0.0000	0.0000	0.0800	0.0000	10.0000	10.1000	0.8200	0.0000	0.8200	4.1200	0.6600	37.4170	15.0000	PVC	0.0100	0.2400	102.8800	102.9700	106.4000	106.4100	104.0700	104.1800
	DENTO																								
42.0000	BEND																								
50.0000 43.0000	BEND	0.0000	0.0600	0.0000	0.0000	0.0500	0.0000	10.0000	10.1000	0.5400	0.0000	0.5400	0.6100	2.7700	4.2430	6.0000	PVC	0.0100	0.7100	103.2400	103.2700	105.7300	105.7500	104.3200	103.8100
51.0000 44.0000	BEND	0.0600	0.0600	0.9000	0.0500	0.0500	10.0000	10.0000	10.1000	0.5400	0.0000	0.5400	0.5300	2.7700	4.0000	6.0000	PVC	0.0100	0.7500	103.2700	103.3000	105.8400	105.8700	103.8100	0.0000
26.0000	BEND	0.0000	0.0000	0.0000	0.0000	0.0800	0.0000	10,0000	10 1000	0.8300	0.0000	0.8300	1.0000	2.2400	4 2420	8 0000	DVC	0.0100	0.4700	102.0700	102.0000	100 4100	106 4200	104 1800	103.8500
52.0000 27.0000	BEND	0.0000	0.0900		0.0000	0.0800	0.0000	10.0000	10.1000	0.8200	0.0000	0.8200	1.0800	2.3400	4.2430	8.0000	PVC	0.0100	0.4700	102.9700	102.9900	106.4100	106.4200	104.1800	
53.0000 28.0000	BEND	0.0900	0.0900	0.9000	0.0800	0.0800	10.0000	10.0000	10.1000	0.8200	0.0000	0.8200	0.9300	2.3400	2.0000	8.0000	PVC	0.0100	0.5000	102.9900	103.0000	106.4900	106.4900	103.8500	0.0000
41.0000 54.0000	BEND	0.0000	0.0600	0.0000	0.0000	0.0500	0.0000	10.0000	10.1000	0.5400	0.0000	0.5400	0.6200	2.7700	4.1490	6.0000	PVC	0.0100	0.7200	103.1300	103.1600	105.7000	105.7200	104.2100	103.7000
45.0000	BEND																								0.0000
55.0000 46.0000	BEND	0.0600	0.0600	0.9000	0.0500	0.0500	10.0000	10.0000	10.1000	0.5400	0.0000	0.5400	0.6300	2.7700	4.0000	6.0000	PVC	0.0100	0.7500	103.1600	103.1900	105.8100	105.8300	103.7000	0.0000
25.0000 56.0000	BEND	0.0000	0.1300	0.0000	0.0000	0.1200	0.0000	10.0000	10.1000	1.1800	0.0000	1.1800	1.0800	3.3800	4.2430	8.0000	PVC	0.0100	0.4700	102.8800	102.9000	106.3700	106.3900	104.0700	103.7400
29.0000 57.0000	BEND	0.1300	0.1300	0.9000	0.1200	0.1200	10.0000	10.0000	10.1000	1.1800	0.0000	1.1800	1.2500	3.3800	1.5740	8.0000	PVC	0.0100	0.6400	102.9000	102.9100	106.5300	106.5400	103.7400	0.0000
30.0000	BEND																								
10,0000																									•
58.0000	BEND	0.0000	0.0700	0.0000	0.0000	0.0600	0.0000	11.6000	9.6000	0.6000	0.0000	0.6000	2.2500	0.7700	4.2430	12.0000	PVC	0.0100	0.2400	102.5400	102.5500	106.1600	106.1600	103.6200	103.6300
33.0000 59.0000	BEND	0.0000	0.0700	0.0000	0.0000	0.0600	0.0000	11.0000	9.8000	0.6200	0.0000	0.6200	2.7300	0.7800	28.7190	12.0000	PVC	0.0100	0.3500	102.5500	102.6500	106.1700	106.1700	103.6300	103.7300
60.0000 34.0000	BEND	0.0000	0.0500	0.0000	0.0000	0.0500	0.0000	10.1000	10.1000	0.4500	0.0000	0.4500	2.5800	0.5800	32.0780	12.0000	PVC	0.0100	0.3100	102.6500	102.7500	106.1800	106.1900	103.7300	103.8300
35.0000	BEND																								
24,000	DE:::																								•
61.0000	BEND	0.0000	0.1300	0.0000	0.0000	0.1200	0.0000	10.0000	10.1000	1.1800	0.0000	1.1800	1.0800	3.3800	4.2430	8.0000	PVC	0.0100	0.4700	102.7300	102.7500	106.2500	106.2700	103.8700	103.5400
62.0000 31.0000	BEND	0.1300	0.1300	0.9000	0.1200	0.1200	10.0000	10.0000	10.1000	1.1800	0.0000	1.1800	1.2500	3.3800	1.5740	8.0000	PVC	0.0100	0.6400	102.7500	102.7600	106.4100	106.4200	103.5400	0.0000
32.0000	BEND																								
35.0000	BEND								_						_										
63.0000		0.0000	0.0500	0.0000	0.0000	0.0500	0.0000	10.0000	10.1000	0.4500	0.0000	0.4500	0.6100	2.3100	4.2430	6.0000	PVC	0.0100	0.7100	102.7500	102.7800	106.1900	106.2100	103.8300	103.3200
64.0000	BEND	0.0500	0.0500	0.9000	0.0500	0.0500	10.0000	10.0000	10.1000	0.4500	0.0000	0.4500	0.6300	2.3100	4.0030	6.0000	PVC	0.0100	0.7500	102.7800	102.8100	106.2700	106.2900	103.3200	0.0000
37.0000	BEND																								-
34.0000	BEND																				<u> </u>				
65.0000		0.0000	0.0200	0.0000	0.0000	0.0200	0.0000	10.1000	10.1000	0.1800	0.0000	0.1800	0.6100	0.9200	4.2430	6.0000	PVC	0.0100	0.7100	102.6500	102.6800	106.1800	106.1800	103.7300	103.2200
66.0000	BEND	0.0200	0.0200	0.9000	0.0200	0.0200	10.0000	10.0000	10.1000	0.1800	0.0000	0.1800	0.6300	0.9200	4.0000	6.0000	PVC	0.0100	0.7500	102.6800	102.7100	106.1900	106.2000	103.2200	0.0000
39.0000	BEND																								

LINES 5, 7 AND 8 WERE IMPLEMENTED INTO THE DESIGN ANALYSIS TO PROPERLY DESIGN THE CONVEYENCE WITHOUT A FLOW DELAY CAUSED BY DETENTION. OUTFALL AT THE DOWN STREAM OF LINE 1 IS IN ACTUALLITY THE JUNCTION WITH THE EXISTING 24" PIPE. OUTFALL AT THE DOWN STREAM OF LINE 36 IS IN ACTUALLITY THE JUNCTION WITH THE EXISTING 24" PIPE.



1801 SOUTH SECOND ST. SUITE 330 MCALLEN, TX 78503 956.994.1900 twgarch.com



THESE DRAWINGS AND INFORMATION CONTAINED HEREIN ARE PROPERTY AND THE SOLE PROPERTY OF THE WARREN GROUP ARCHITECTS, INC. THEY MAY NOT BE REUSED, REPRODUCED OR ALTERED IN ANY WAY WITHOUT PRIOR WRITTEN APPROVAL FROM AND APPROPRIATE COMPENSATION TO THE WARREN GROUP ARCHITECTS INC.




CITY OF PHARR AQUATIC FACILITY

W SIOUX RD AND EXPRESSWAY 281 PHARR, TEXAS 78577

PROJECT DATE REVISED

DRAINAGE AREA CALCULATIONS


971805 6/07/2019

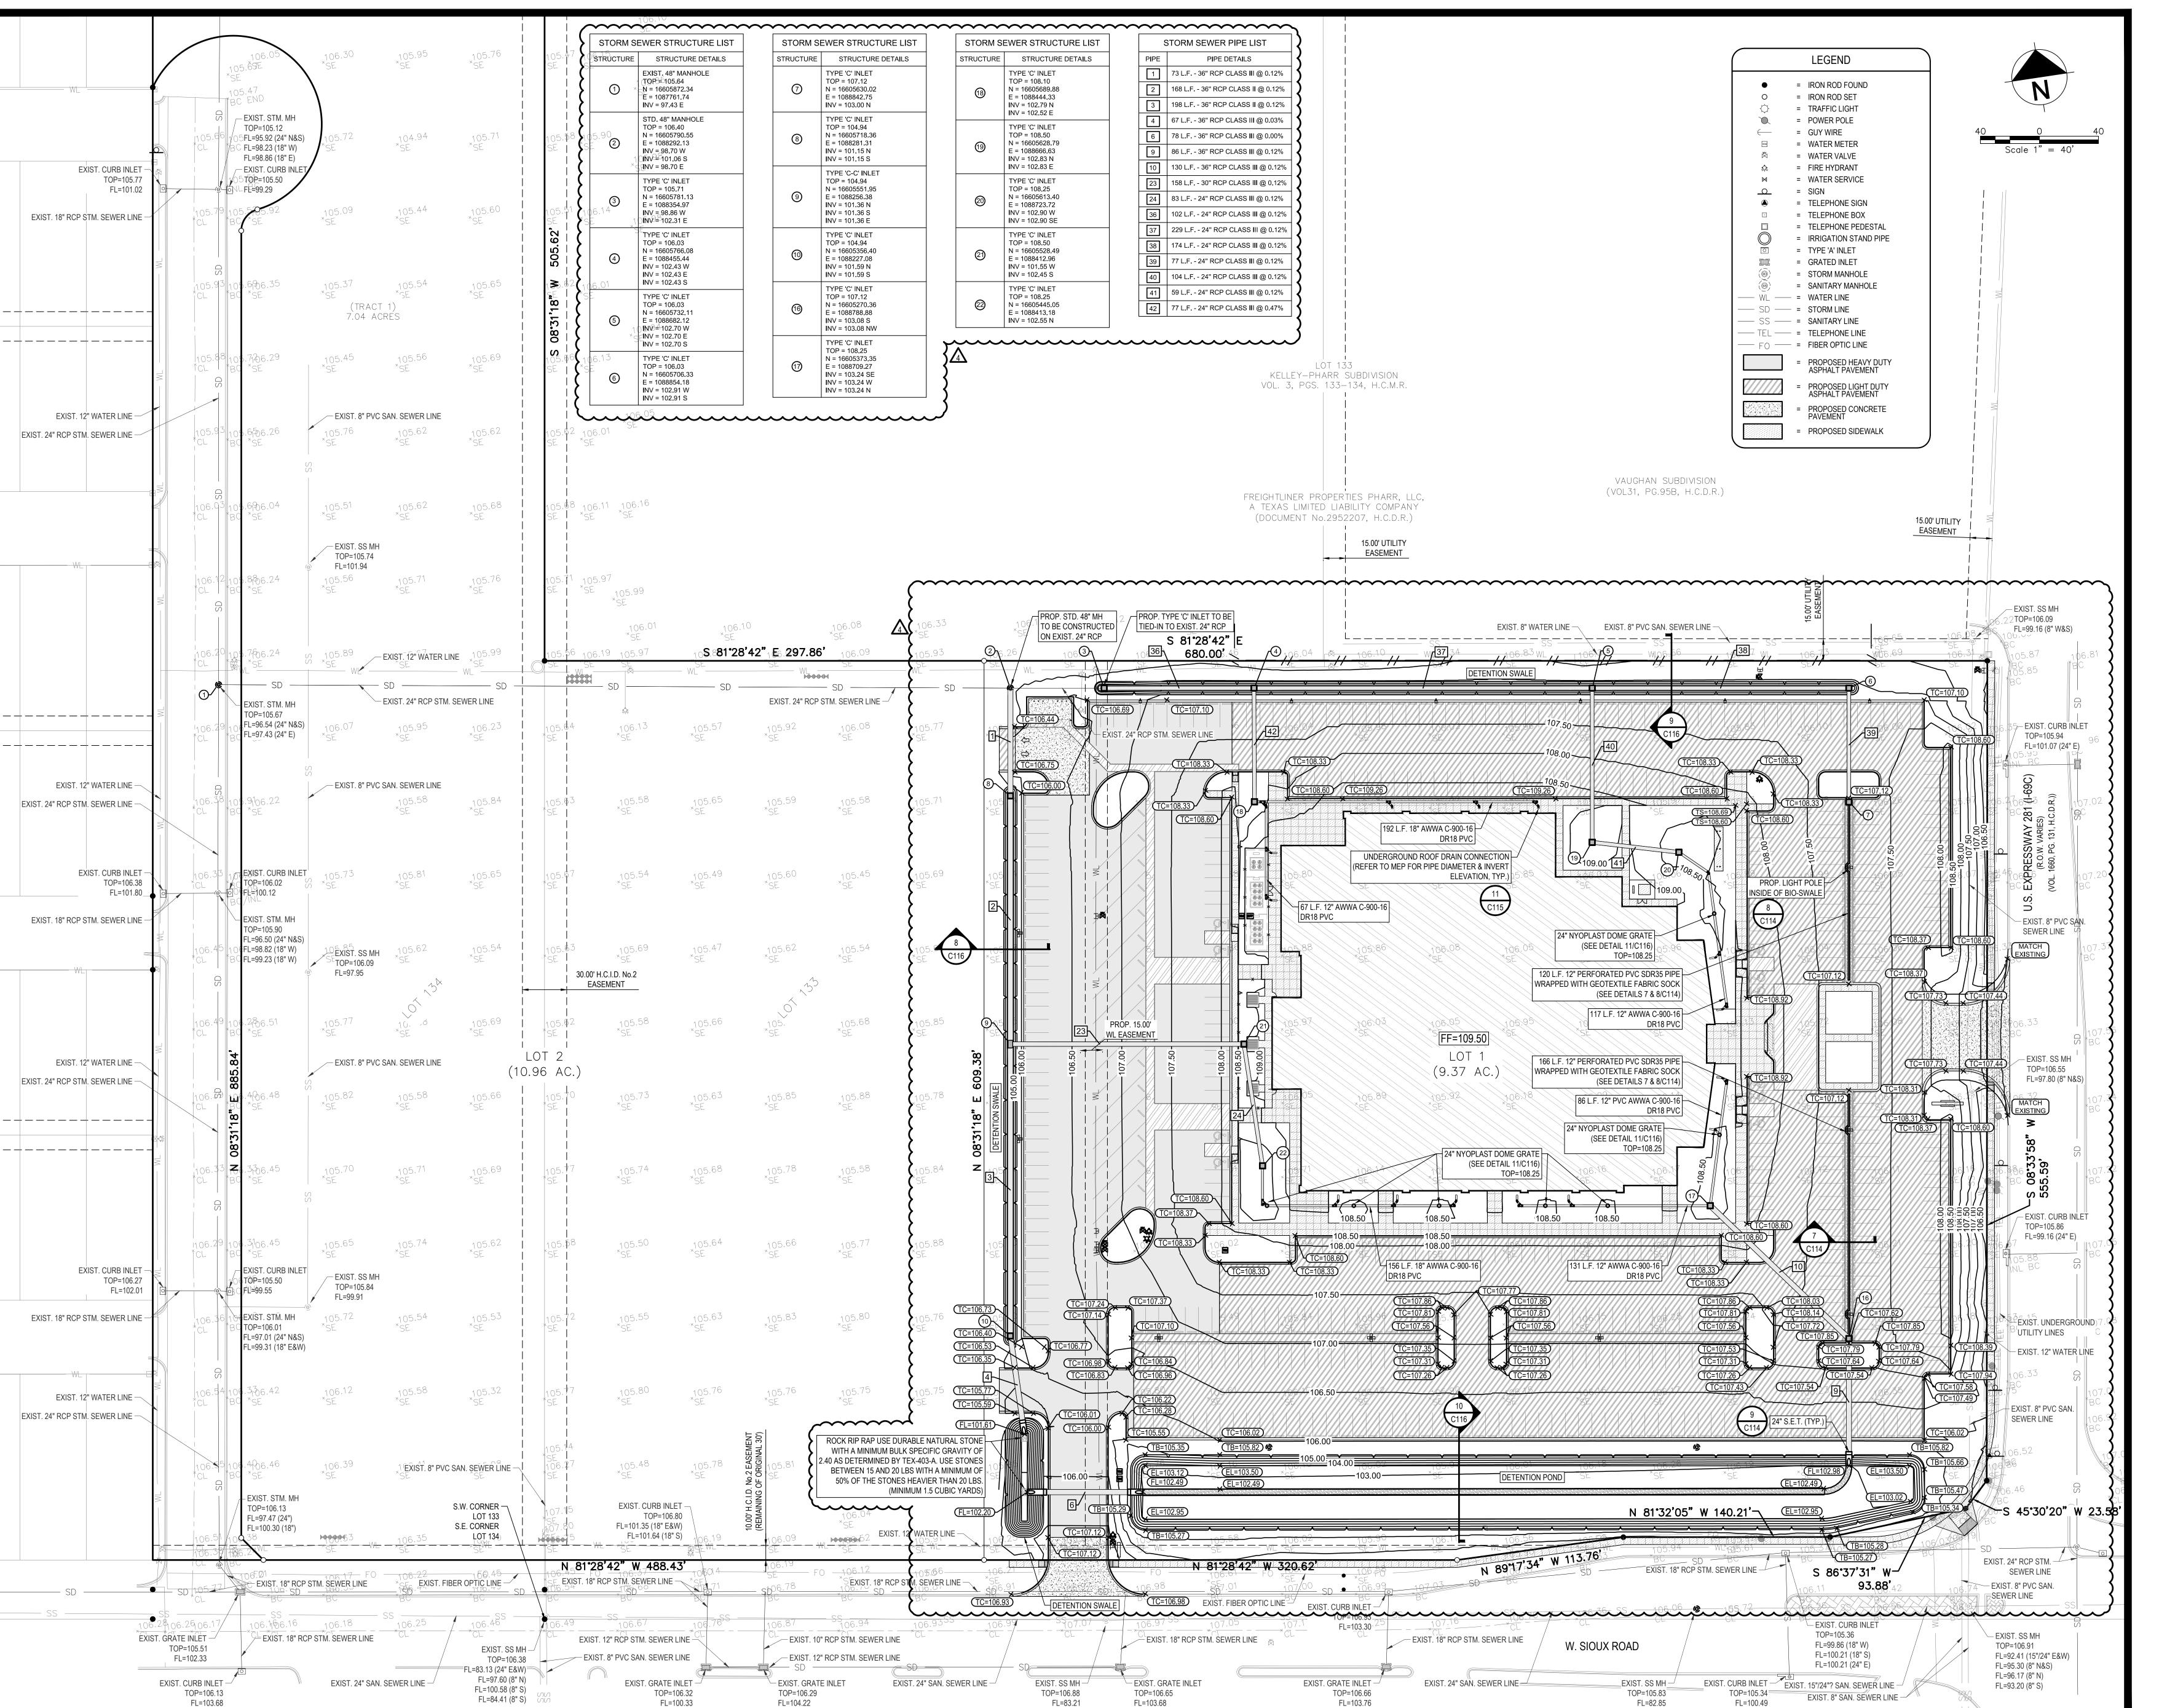





THESE DRAWINGS AND INFORMATION CONTAINED HEREIN ARE PROPERTY AND THE SOLE PROPERTY OF THE WARREN GROUP ARCHITECTS, INC. THEY MAY NOT BE REUSED, REPRODUCED OR ALTERED IN ANY WAY WITHOUT PRIOR WRITTEN APPROVAL FROM AND APPROPRIATE COMPENSATION TO THE WARREN GROUP ARCHITECTS INC.

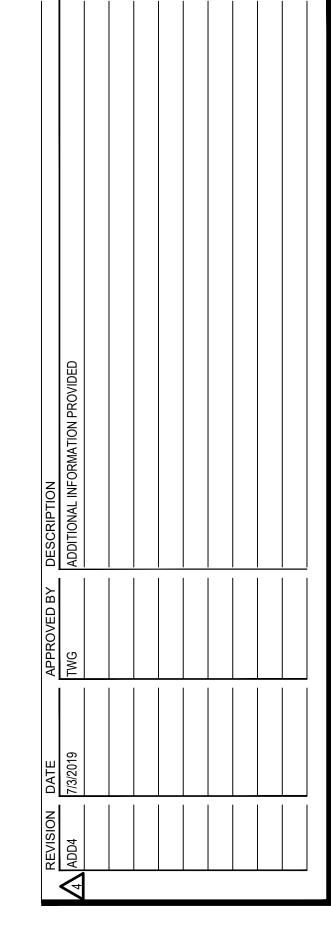





CITY OF PHARR
AQUATIC FACILITY


W SIOUX RD AND EXPRESSWAY 281 PHARR, TEXAS 78577

PROJECT 971805
6/07/2019
REVISED

C104
GRADING AND
DRAINAGE PLAN

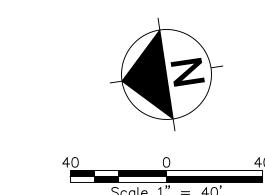

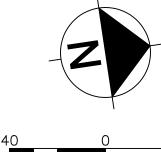

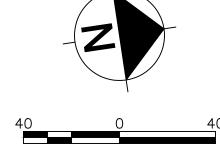



= WATER METER ₩ = WATER VALVE ⇒ = FIRE HYDRANT = WATER SERVICE

= TRAFFIC LIGHT

= POWER POLE

- ☐ = TELEPHONE PEDESTAL = IRRIGATION STAND PIPE = TYPE 'A' INLET = GRATED INLET = STORM MANHOLE

= TELEPHONE SIGN 

LEGEND


- WL —— = WATER LINE — SS — = SANITARY LINE TEL - TELEPHONE LINE
- FO = FIBER OPTIC LINE


= SANITARY MANHOLE

- = PROPOSED LIGHT DUTY ASPHALT PAVEMENT PROPOSED CONCRETE PAVEMENT
  - = PROPOSED SIDEWALK

STORM SEWER LINE 'B' PROFILE SCALE H: 1" = 40' V: 1" = 4'

STORM SEWER LINE 'C' PROFILE SCALE H: 1" = 40' V: 1" = 4'

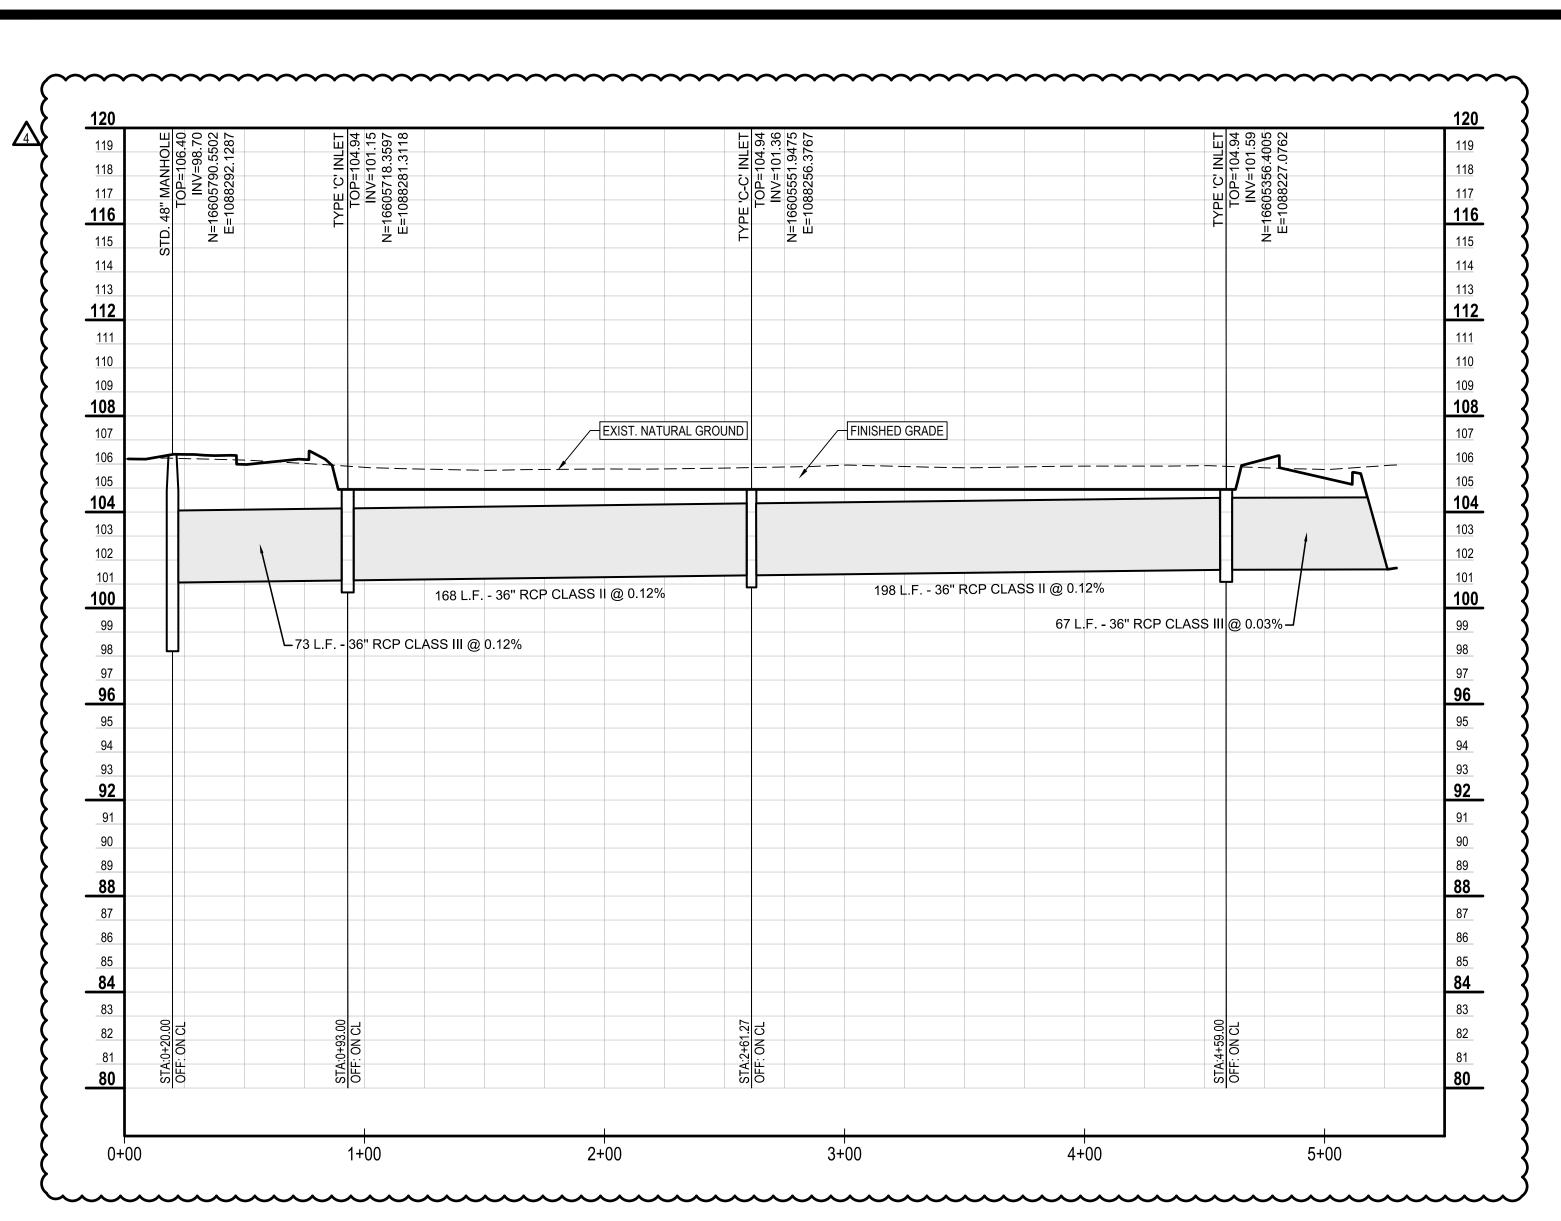

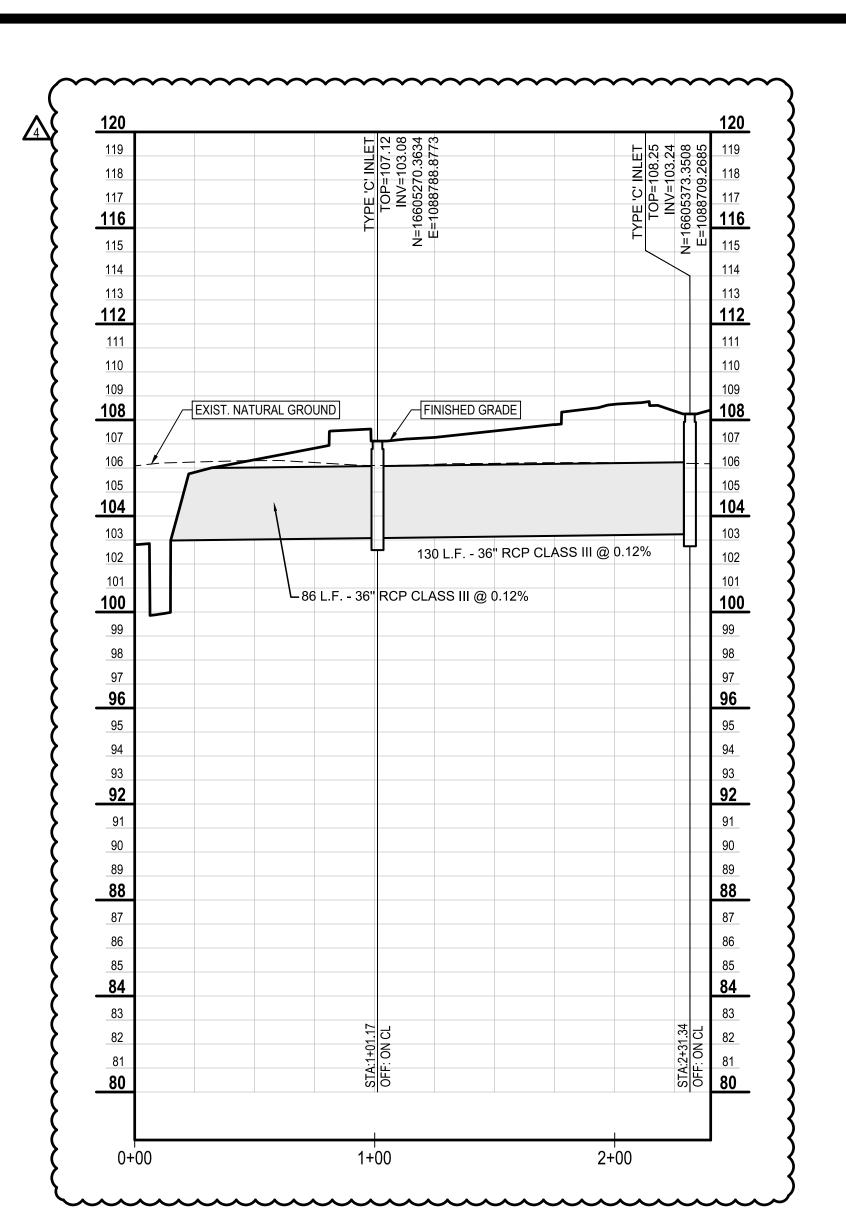




1801 SOUTH SECOND ST. SUITE 330 McALLEN, TX 78503 956.994.1900 twgarch.com



THESE DRAWINGS AND INFORMATION CONTAINED HEREIN ARE PROPERTY AND THE SOLE PROPERTY OF THE WARREN GROUP ARCHITECTS, INC. THEY MAY NOT BE REUSED, REPRODUCED OR ALTERED IN ANY WAY WITHOUT PRIOR WRITTEN APPROVAL FROM AND APPROPRIATE COMPENSATION TO THE WARREN GROUP ARCHITECTS INC.

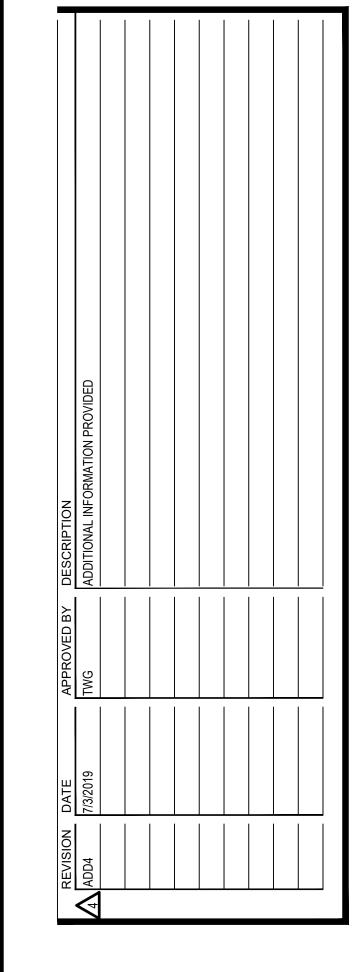



PROPOSED


CITY OF PHARR AQUATIC FACILITY

W SIOUX RD AND EXPRESSWAY 281 PHARR, TEXAS 78577

REVISED

971805 6/07/2019

C106 STORM SEWER LINE 'B' & 'C'

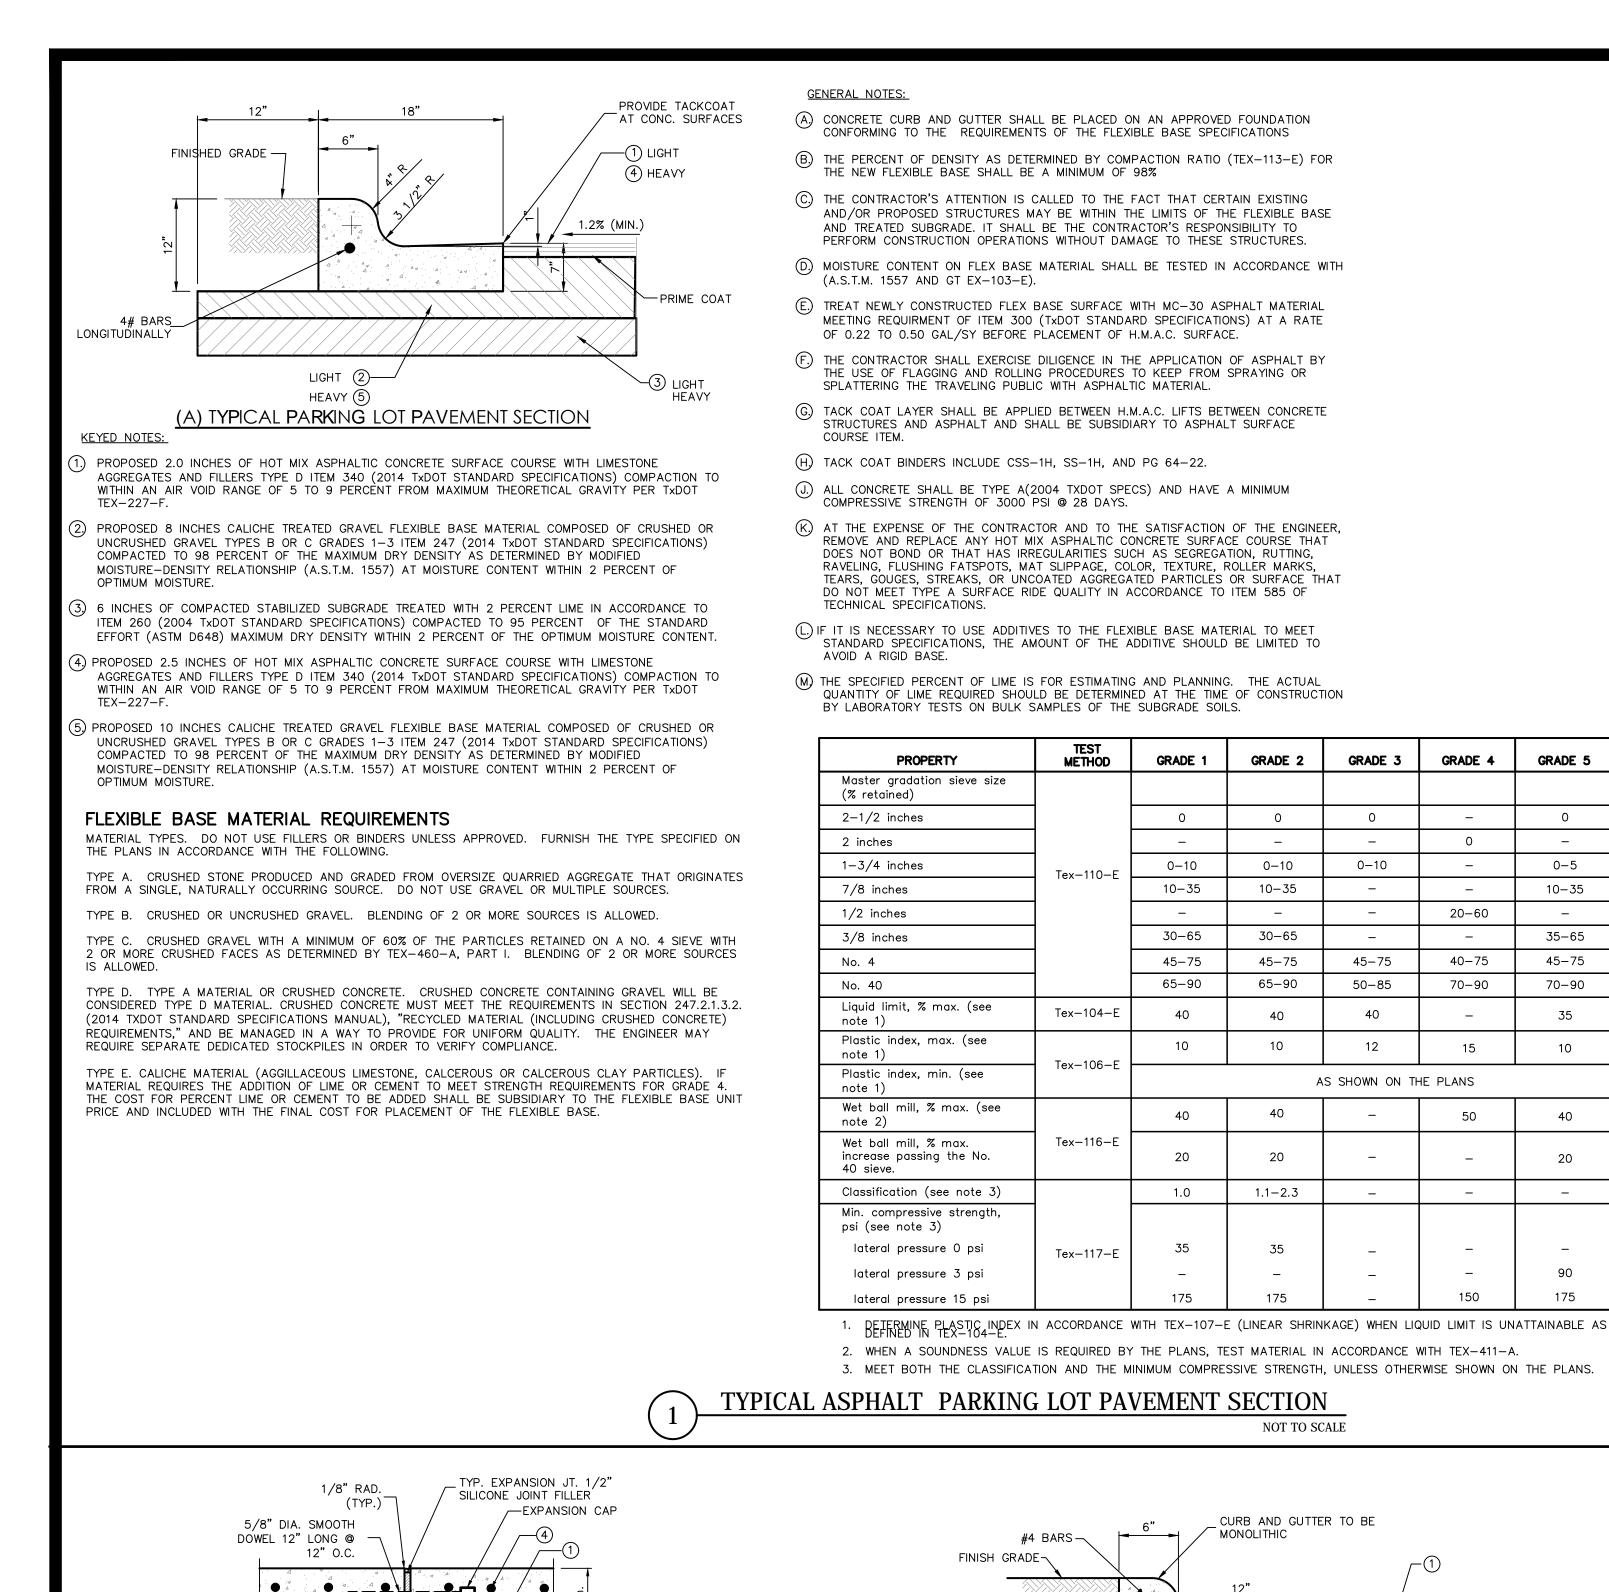

3/4" REDWOOD BOARD

EXPANSION JOINT TYPE "A"

SAW DUMMY JOINT TYPE "B'

ISOLATION JOINT - TYPE "C"

SPACING OF CONTROL JOINTS IN FEET

SLUMP 4 TO 6 IN.

MAXIMUM-SIZE

AGGREGATE

LESS THAN


3/4" REDWOOD BOARD


AGGREGATE

16


ESS THAN 3/4 IN.


THICKNESS,

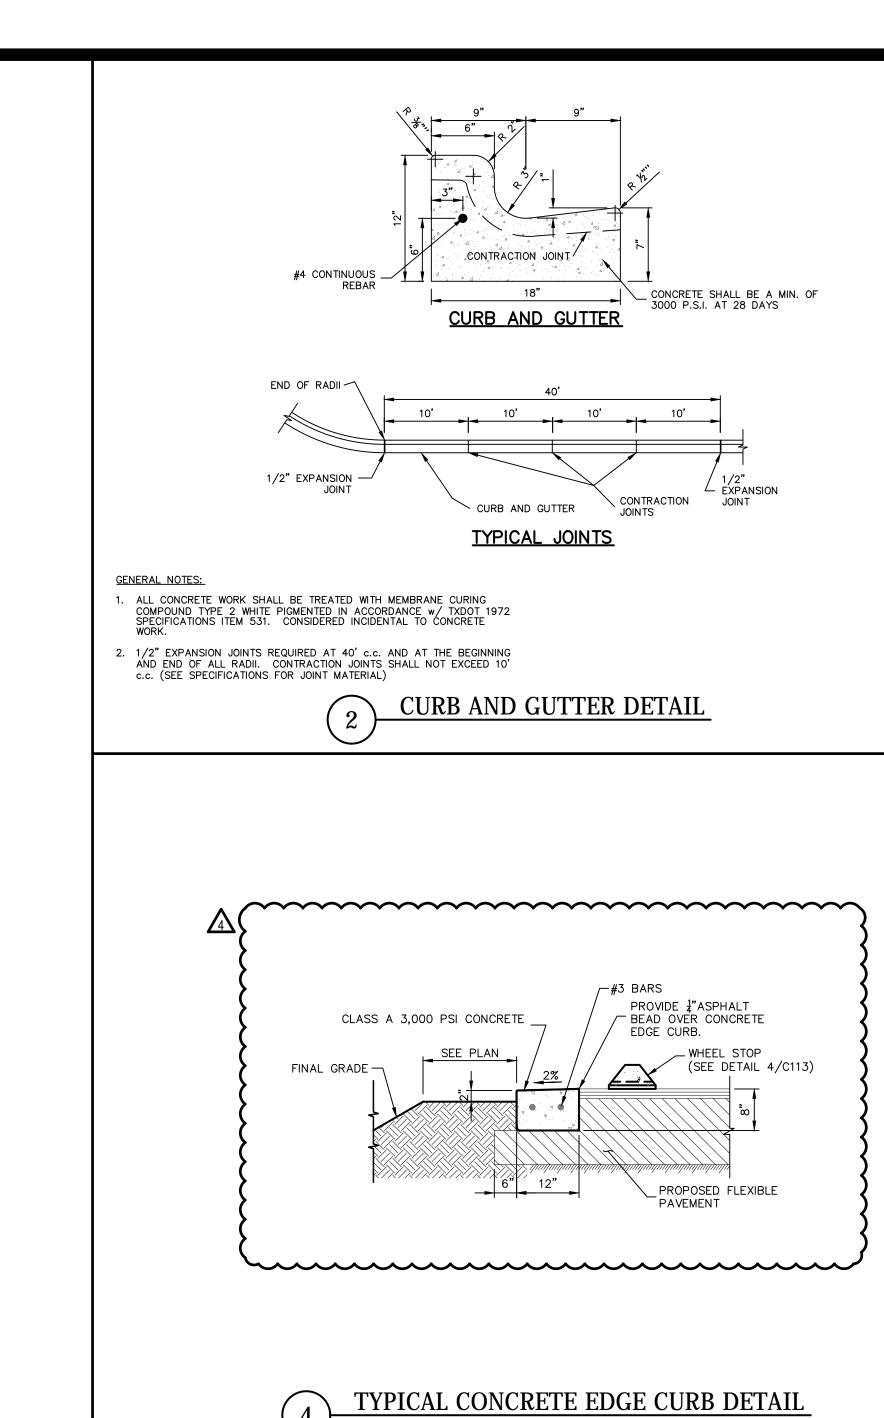

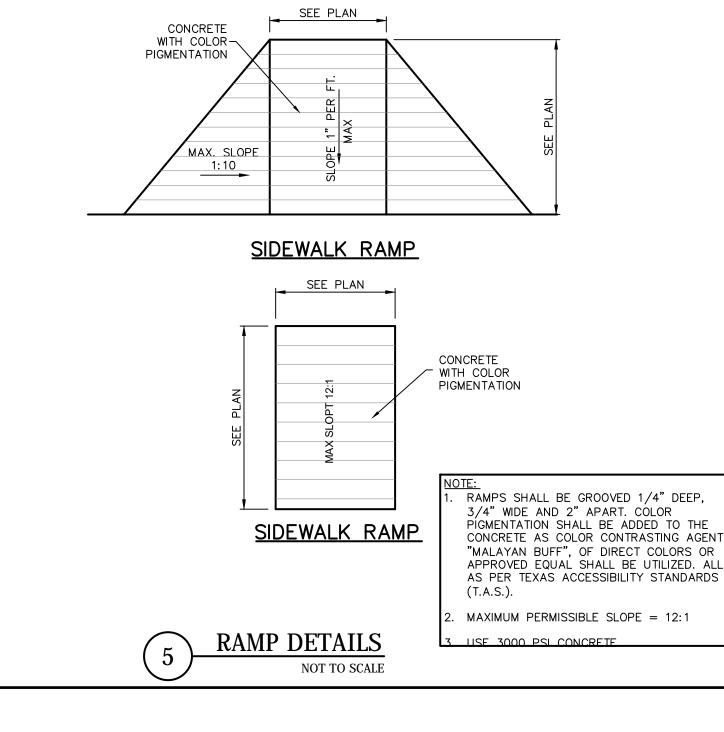

TYPICAL CURB TERMINATION

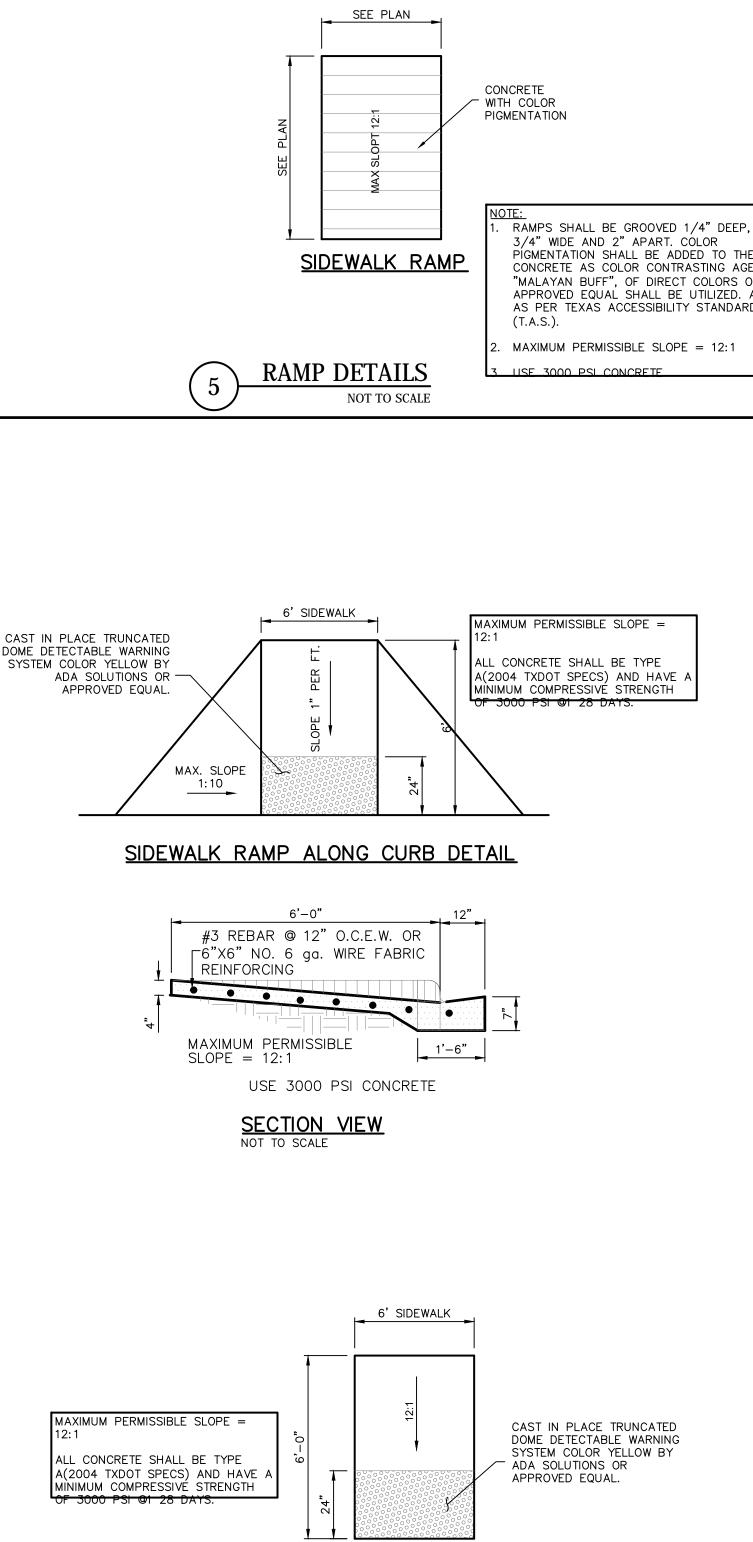

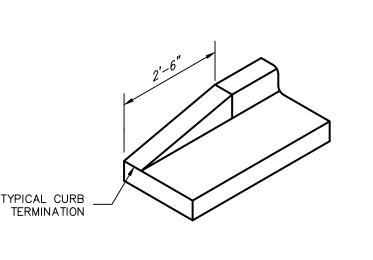

NOTES: PROVIDE 1/2" EXPANSION JOINT @ 10'-0" O.C. 2. ALL EXPOSED SURFACES SHALL BE STRIPPED GREEN TROWELD AND CURB EDGING RUBBED SMOOTH. 2. 3000 psi CONCRETE

NOT TO SCALE



ARCHITECTS, INC.

1801 SOUTH SECOND ST.


SUITE 330

MCALLEN, TX 78503

956.994.1900

twgarch.com

THESE DRAWINGS AND INFORMATION CONTAINED HEREIN ARE PROPERTY AND THE SOLE PROPERTY OF THE WARREN GROUP ARCHITECTS, INC. THEY MAY NOT BE REUSED, REPRODUCED OR ALTERED II ANY WAY WITHOUT PRIOR WRITTEN APPROVAL FROM AND APPROPRIATE COMPENSATION TO THE WARREN GROUP ARCHITECTS INC.

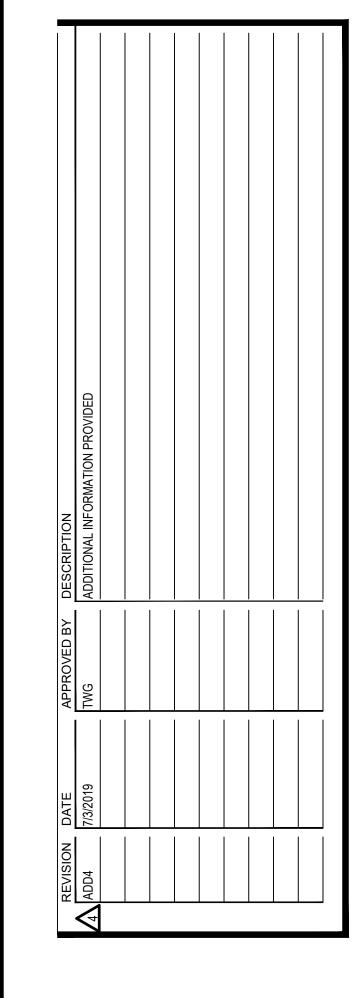





PROPOSED


CITY OF PHARR AQUATIC FACILITY


W SIOUX RD AND EXPRESSWAY 281 PHARR, TEXAS 78577

6/07/2019 REVISED TYPICAL DETAILS

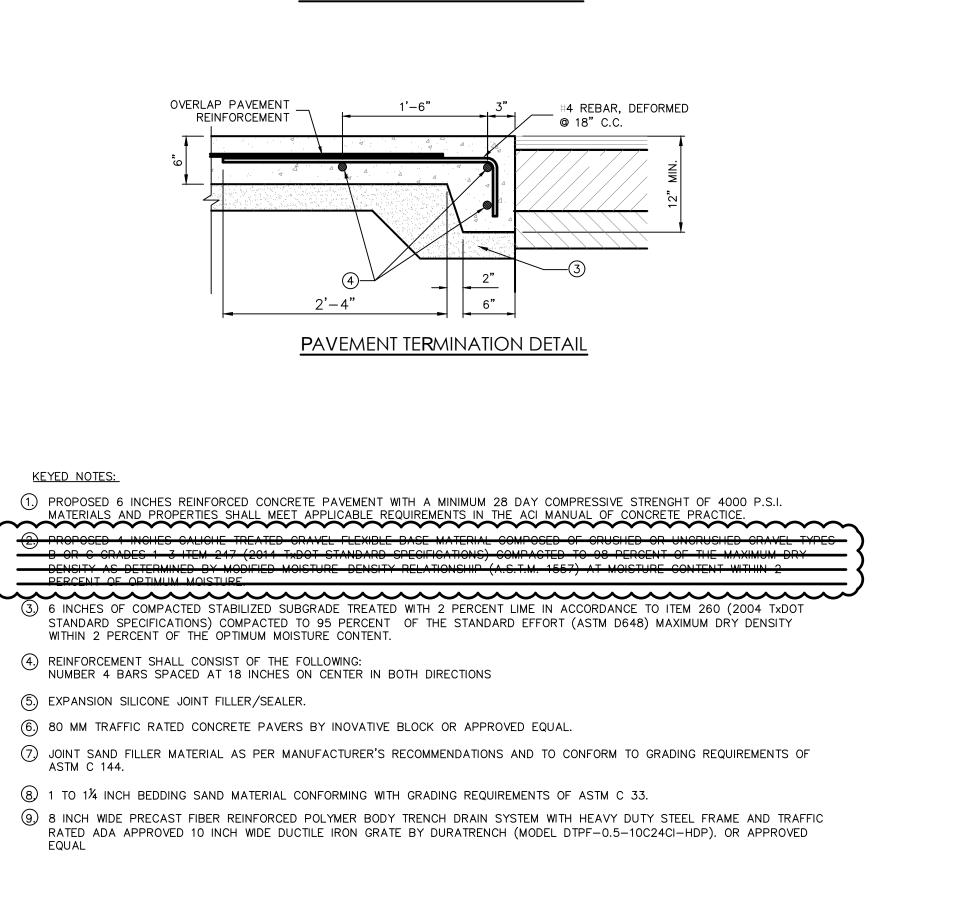

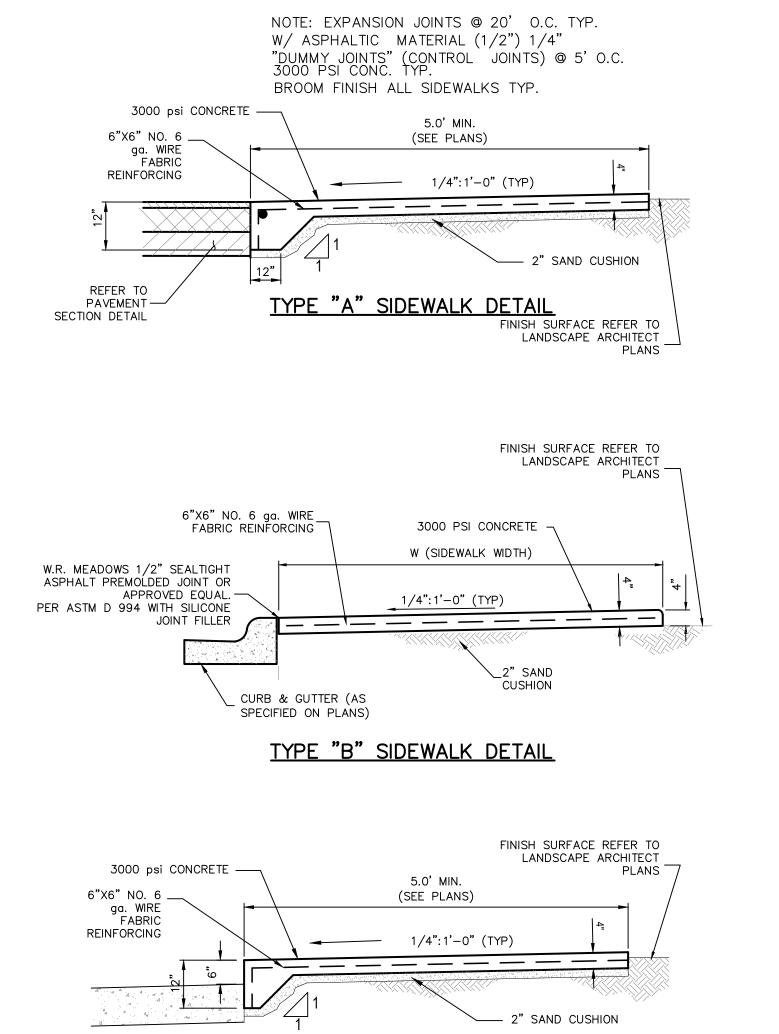

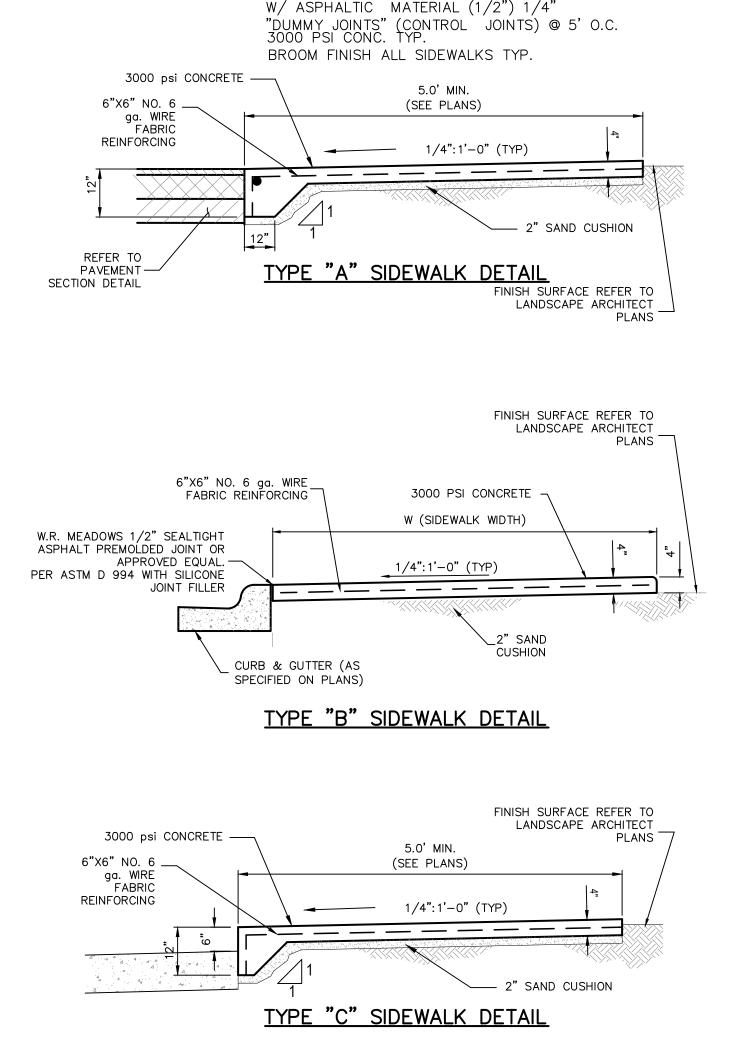

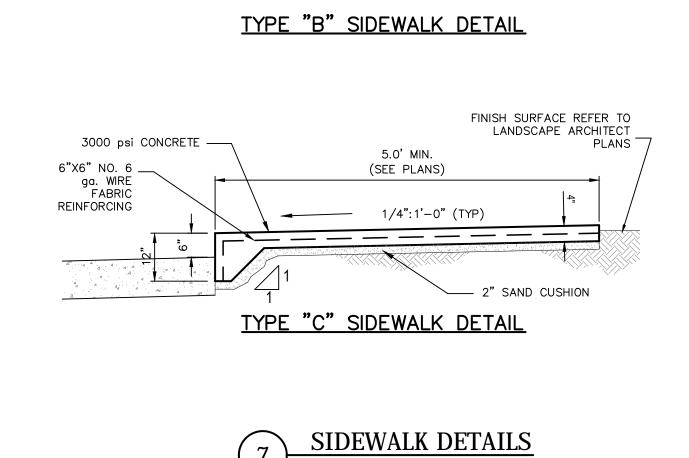

NOT TO SCALE

SIDEWALK RAMP DETAILS NOT TO SCALE

SIDEWALK RAMP

TYPICAL REINFORCED CONCRETE PAVEMENT SECTION & JOINT DETAILS

NOT TO SCALE

GRADE 1

0

\_

0-10

10-35

30-65

45-75

65-90

40

1.0

GRADE 2

0

\_

0-10

10-35

30-65

45-75

65-90

1.1 - 2.3

CURB AND GUTTER TO BE

MONOLITHIC

CONCRETE PAVEMENT SECTION

GRADE 3

\_

0-10

\_

\_

45-75

50-85

40

AS SHOWN ON THE PLANS

12

GRADE 4

\_

0

\_

\_

20-60

40-75

70-90

0-5

10-35

35-65

45-75

70-90

METHOD

Tex-110-E

Tex-104-E

Tex-106-E

Tex-116-E


Tex-117-E

PROPERTY


lateral pressure 0 psi

lateral pressure 3 psi


FINISH GRADE-

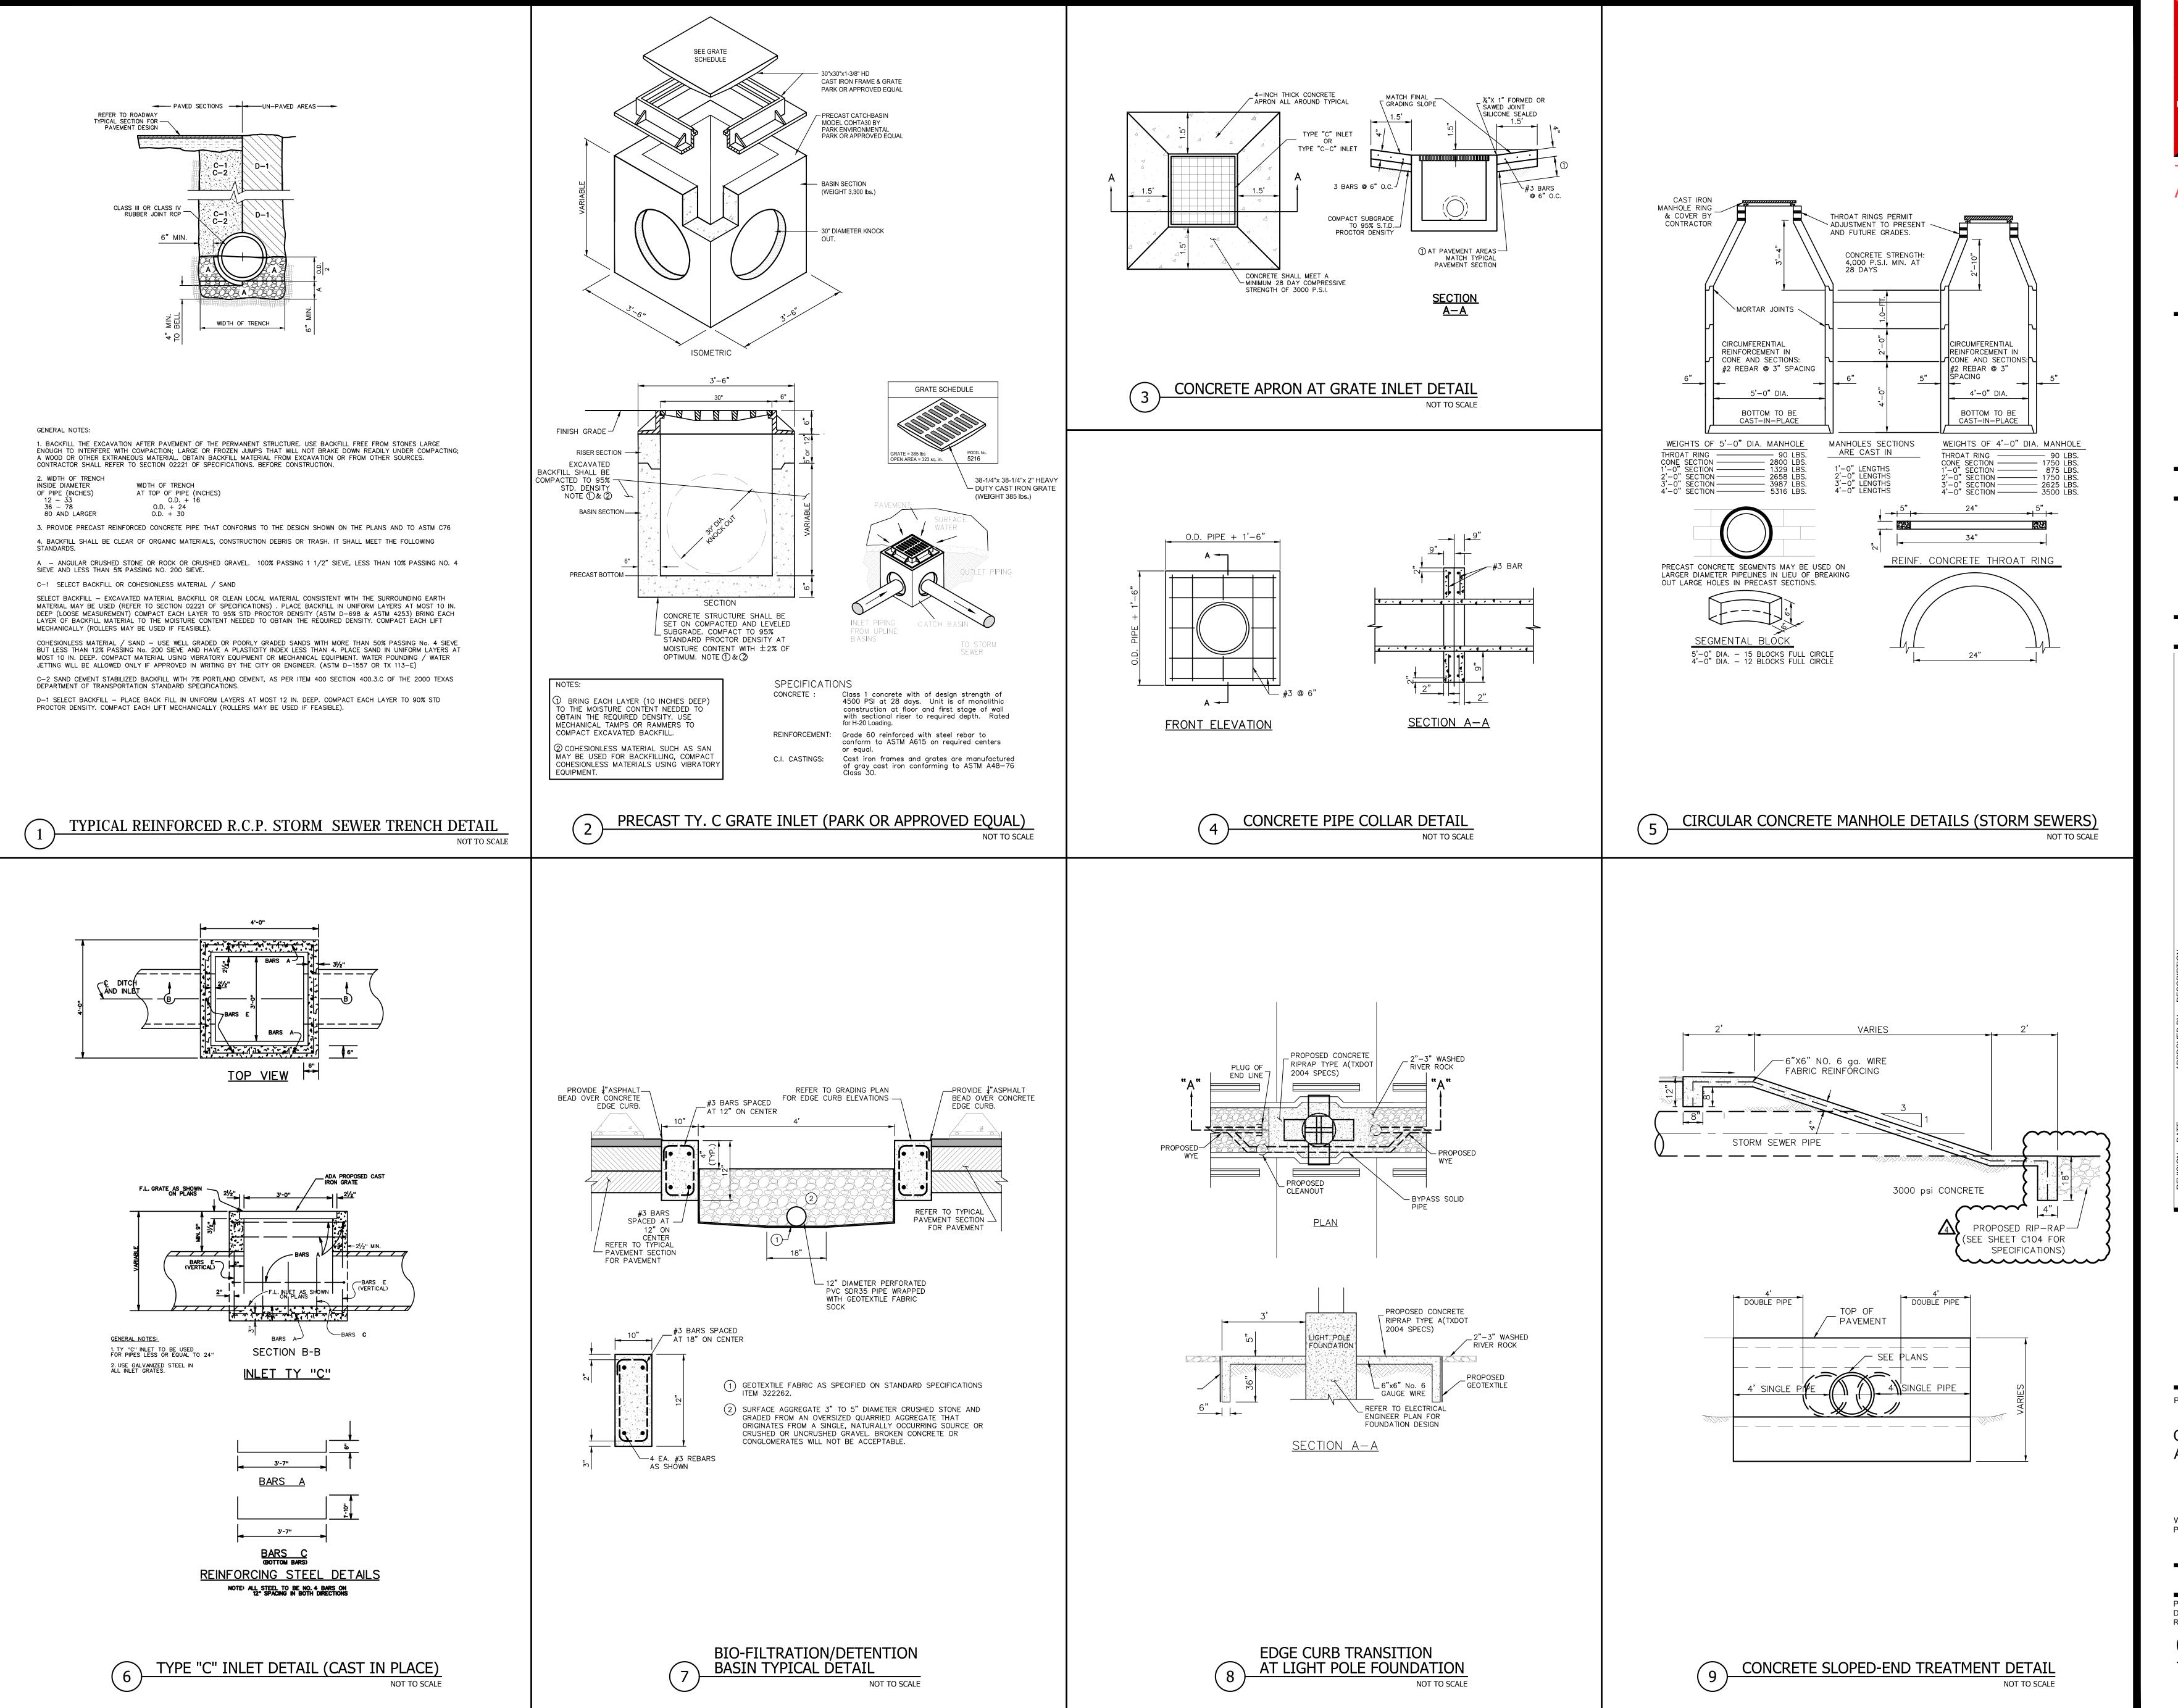



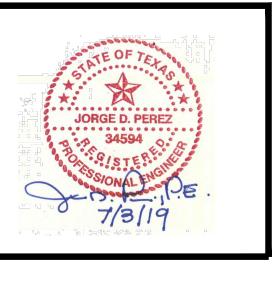

THESE DRAWINGS AND INFORMATION CONTAINED HEREIN ARE PROPERTY AND THE SOLE PROPERTY OF THE WARREN GROUP ARCHITECTS, INC. THEY MAY NOT BE REUSED, REPRODUCED OR ALTERED IN ANY WAY WITHOUT PRIOR WRITTEN APPROVAL FROM AND APPROPRIATE COMPENSATION TO THE WARREN GROUP ARCHITECTS INC.

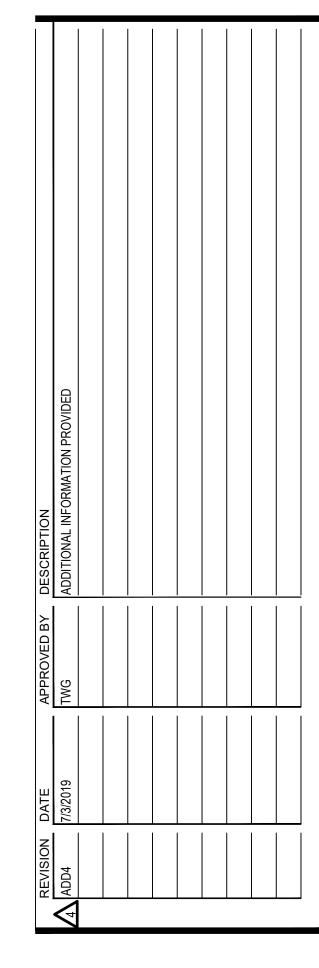




PROPOSED


CITY OF PHARR AQUATIC FACILITY

W SIOUX RD AND EXPRESSWAY 281 PHARR, TEXAS 78577

PROJECT 971805 DATE 6/07/2019 REVISED

C114
TYPICAL DETAILS

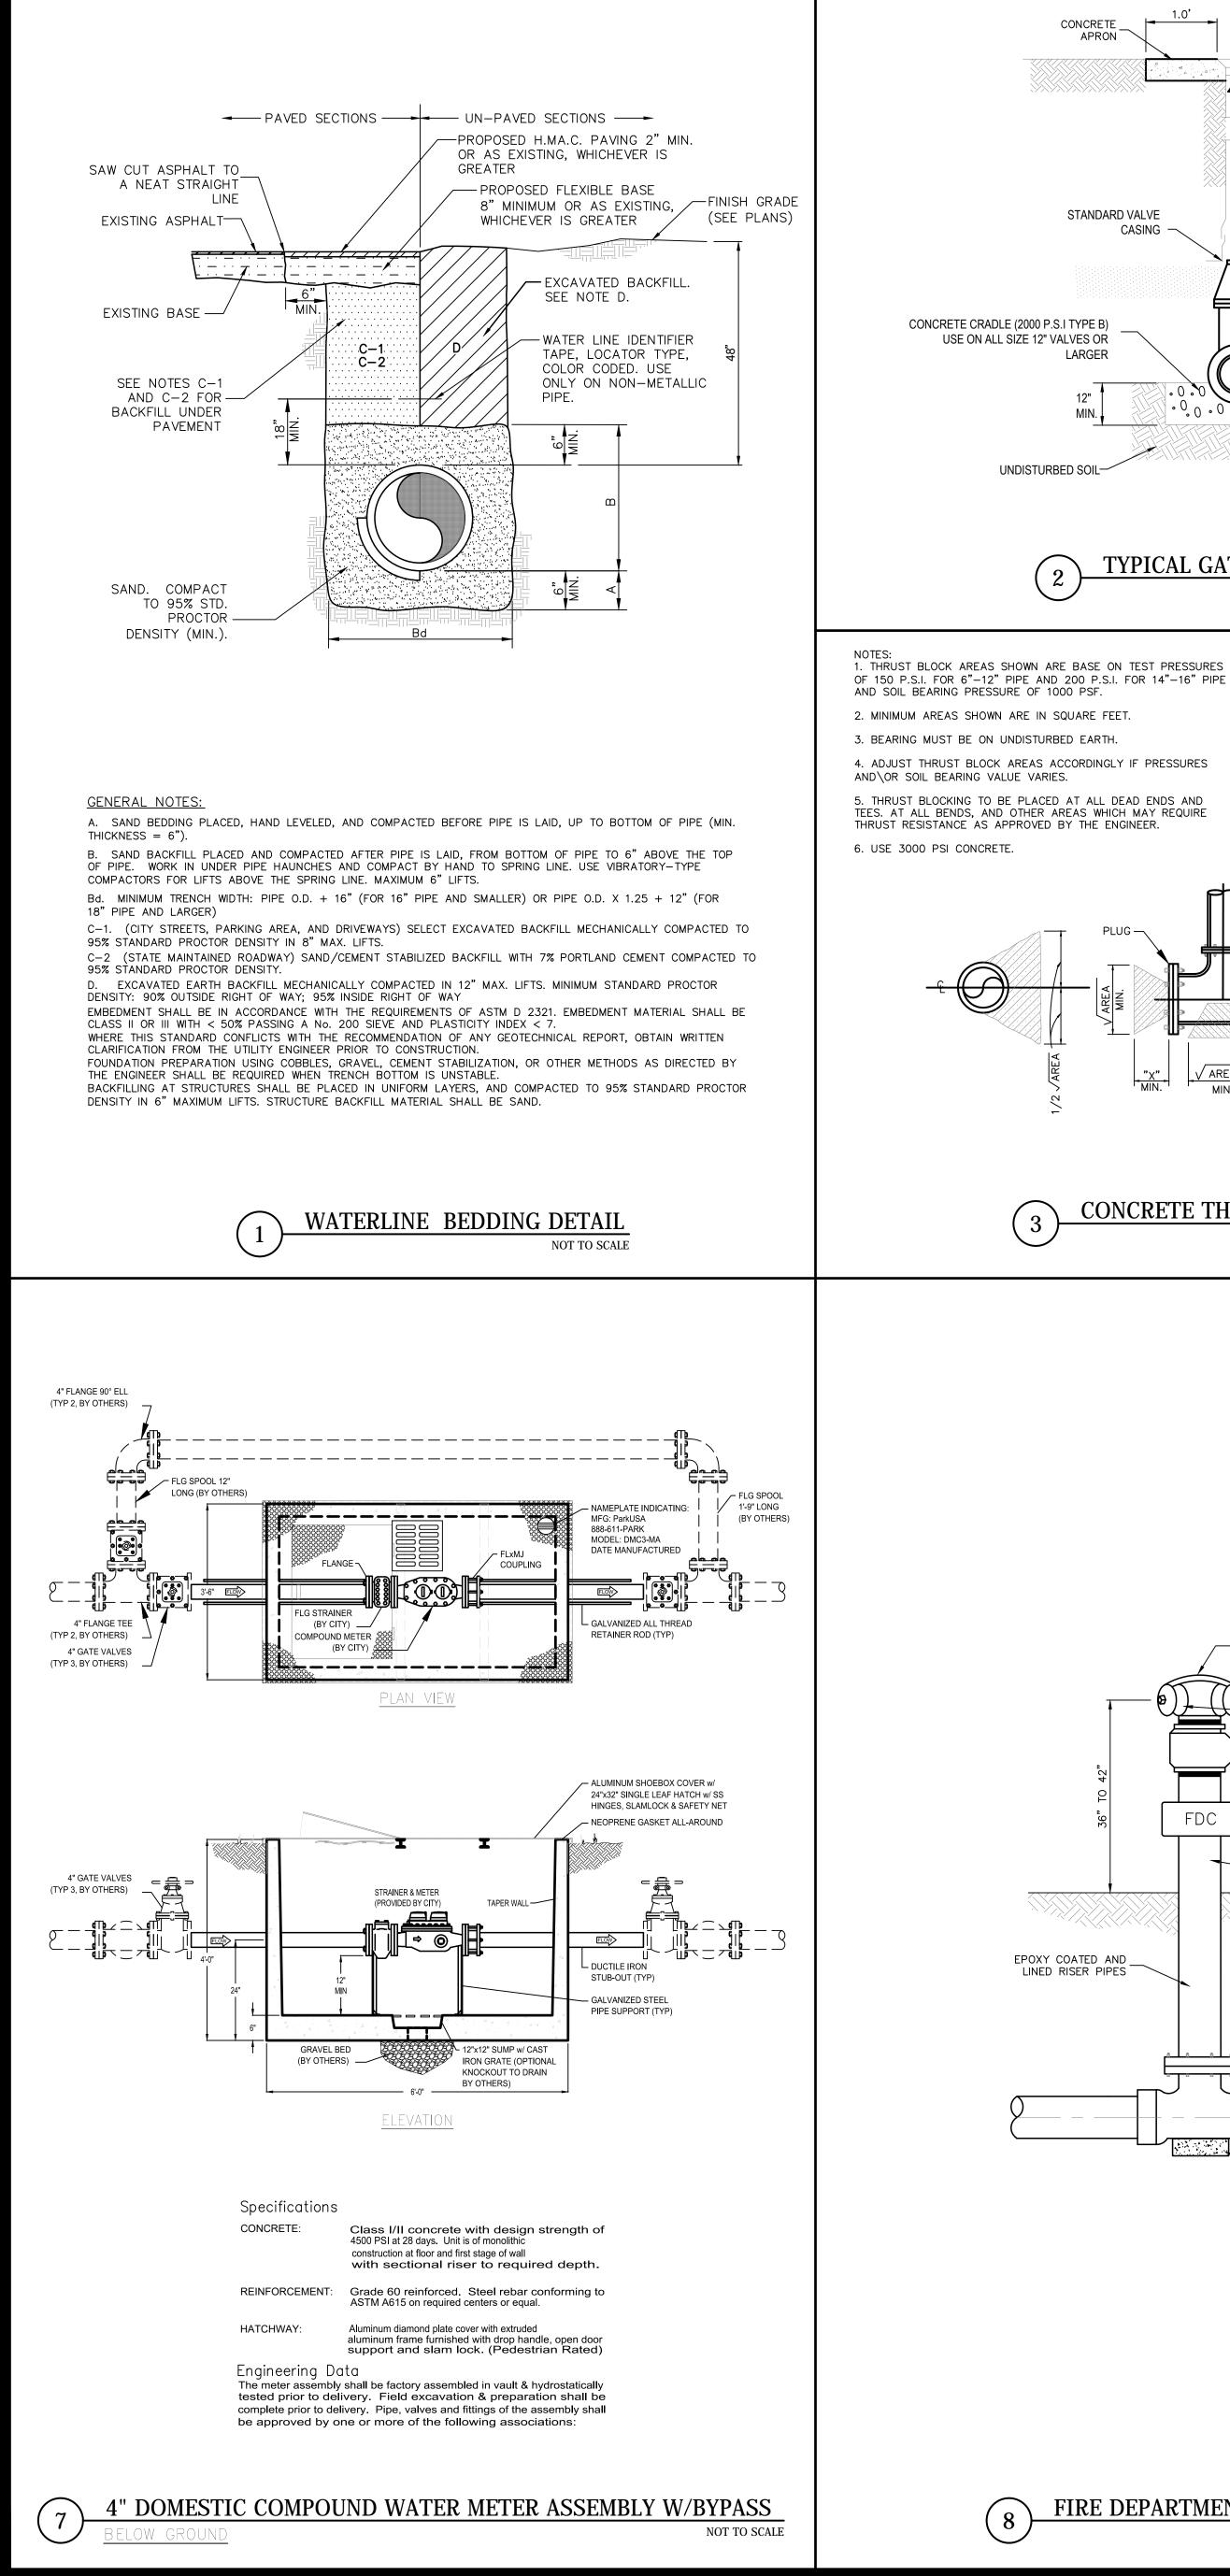

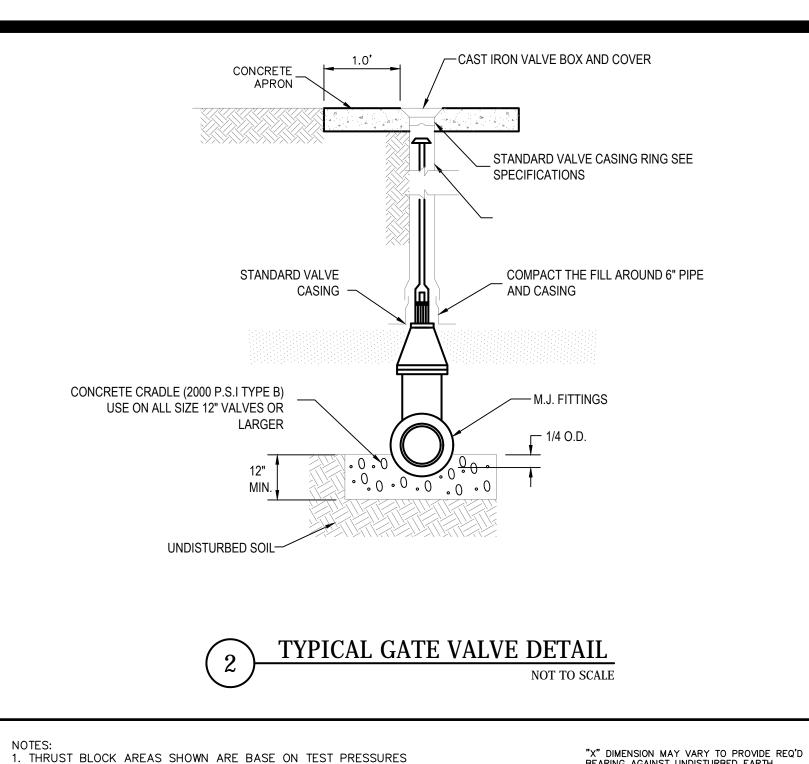

BEARING AGAINST UNDISTURBED EARTH.

BEARING AREA OF BLOCK IN SQUARE FEET

MEGA LUG JOINT

FITTINGS (TYP.)

NOT TO SCALE

√AREA

CONCRETE THRUST BLOCK DETAIL

FIRE DEPARTMENT

- CAP & LOCK (KNOX CAPS)

- SWING CHECK VALVE

SIZE TO MATCH MAIN

PVC MAIN -

FIRE DEPARTMENT CONNECTION DETAIL

PROVIDE SIGN WHITE - BACKGROUND WITH RED


REFLECTIVE LETTERS


PAINTED METAL RISER (RED),

CONNECTION


EPOXY COATED AND

LINED RISER PIPES

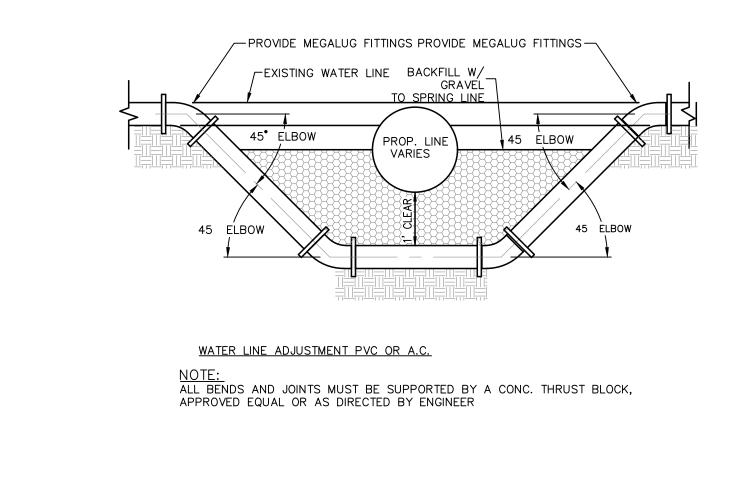

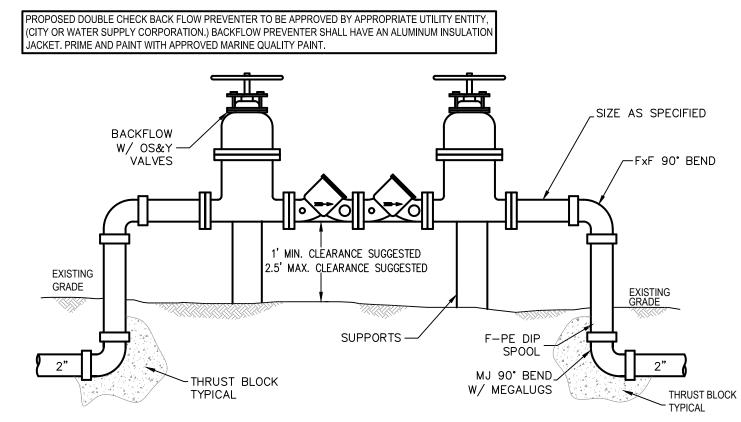



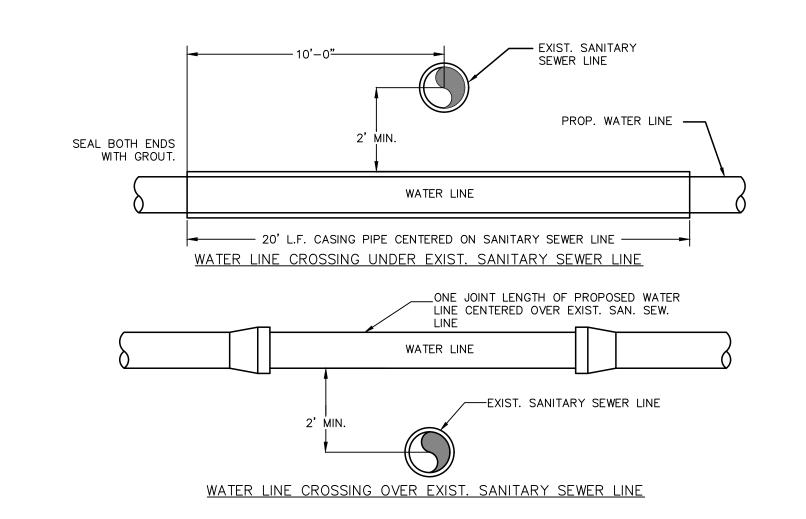

FIRE HYDRANT TO BE -

VARIES

CONCRETE -

6" GATE VALVE, WITH

CAST IRON BOX AND

NOTES:

4" X 12" X 12" CONCRETE BLOCK 3000 PSI.

CRUSH STONE OR GRAVEL SHALL BE PLACED AROUND THE

BOTTOM OF THE HYDRANT FOR A RADIUS OF AT LEAST 12 INCHES

AND EXTENDING AT LEAST 12 INCHES ABOVE THE OUTLET. DO NOT —

SET PLUMB

BURY DEPTH 4'

BLOCK DRAIN HOLES.

BLOCK DRAIN HOLES.

NOTE: USE FLANGED

JOINTS FOR F.H. AND


VALVE ASSEMBLY


CONCRETE BLOCKING WITH A MINIMUM 1 1/2 SQUARE FOOT BEARING AREA CLASS A CONCRETE. DO NOT ———


1. USE CAST IRON OR DUCTILE IRON VALVES AND FITTINGS

2. ALL CAST IRON OR DUCTILE IRON FITTINGS SHALL BE MECHANICAL JOINT-TYPE.


FIRE HYDRANT INSTALLATION DETAIL

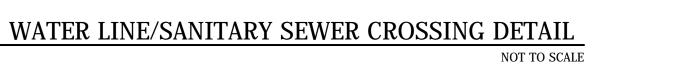

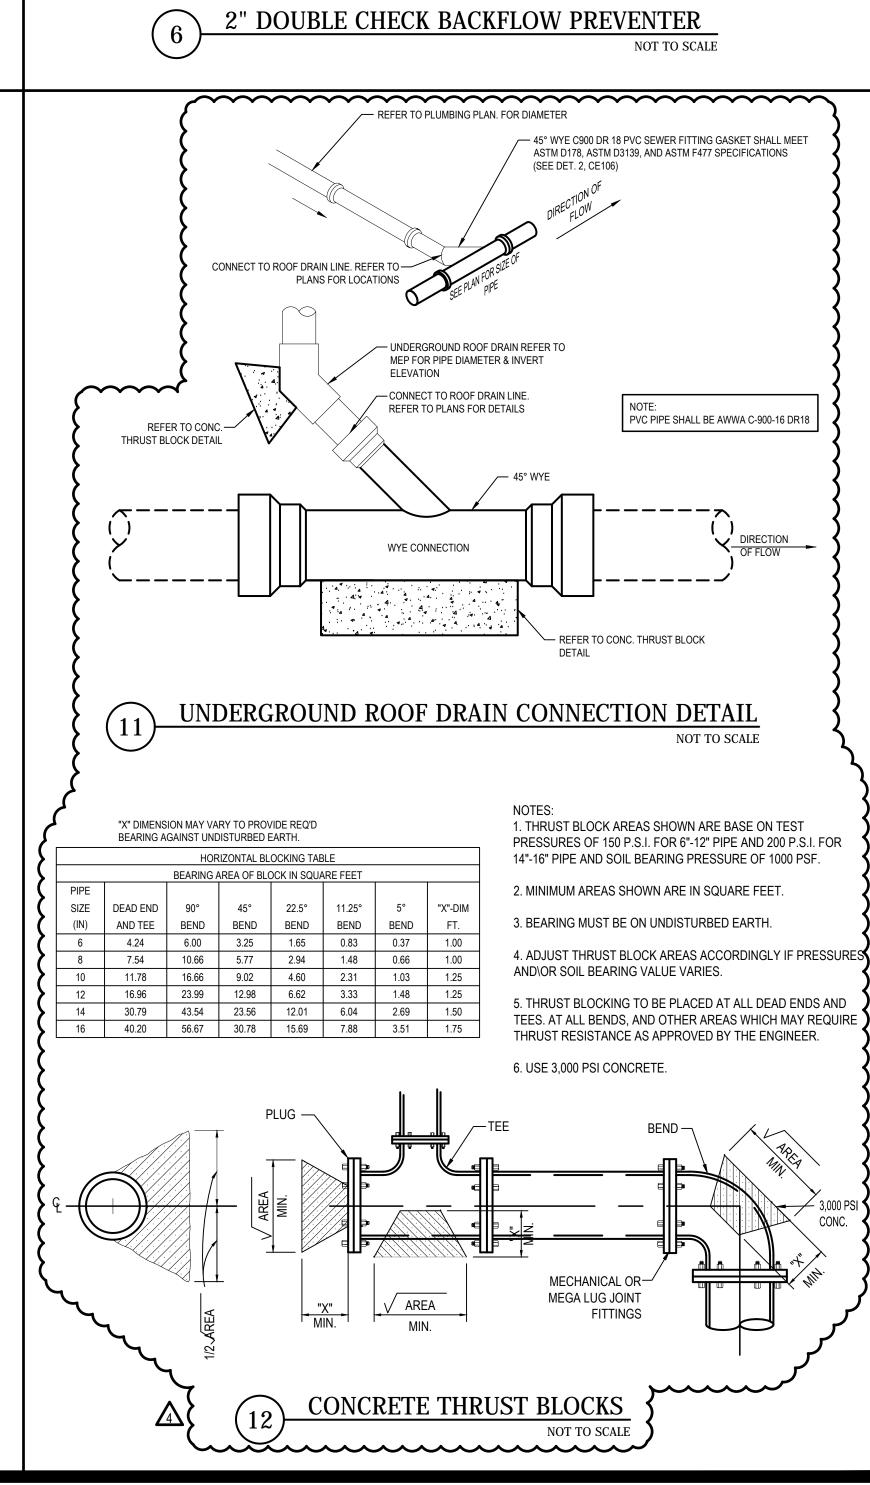

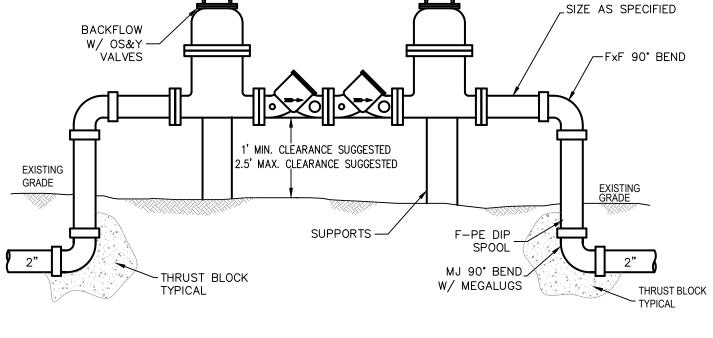



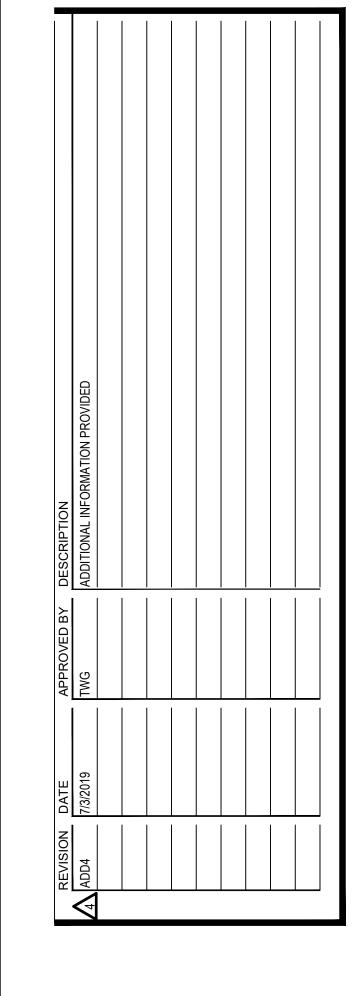

ARCHITECTS, INC.

1801 SOUTH SECOND ST.

SUITE 330

MCALLEN, TX 78503

956.994.1900

twgarch.com

THESE DRAWINGS AND INFORMATION

CONTAINED HEREIN ARE PROPERTY AND THE SOLE PROPERTY OF THE WARREN

GROUP ARCHITECTS, INC. THEY MAY NOT

BE REUSED, REPRODUCED OR ALTERED IN

COMPENSATION TO THE WARREN GROUP

ANY WAY WITHOUT PRIOR WRITTEN

ARCHITECTS INC.

APPROVAL FROM AND APPROPRIATE




PROPOSED CITY OF PHARR **AQUATIC FACILITY** 

W SIOUX RD AND EXPRESSWAY 281 PHARR, TEXAS 78577

6/07/2019 REVISED

TYPICAL DETAILS

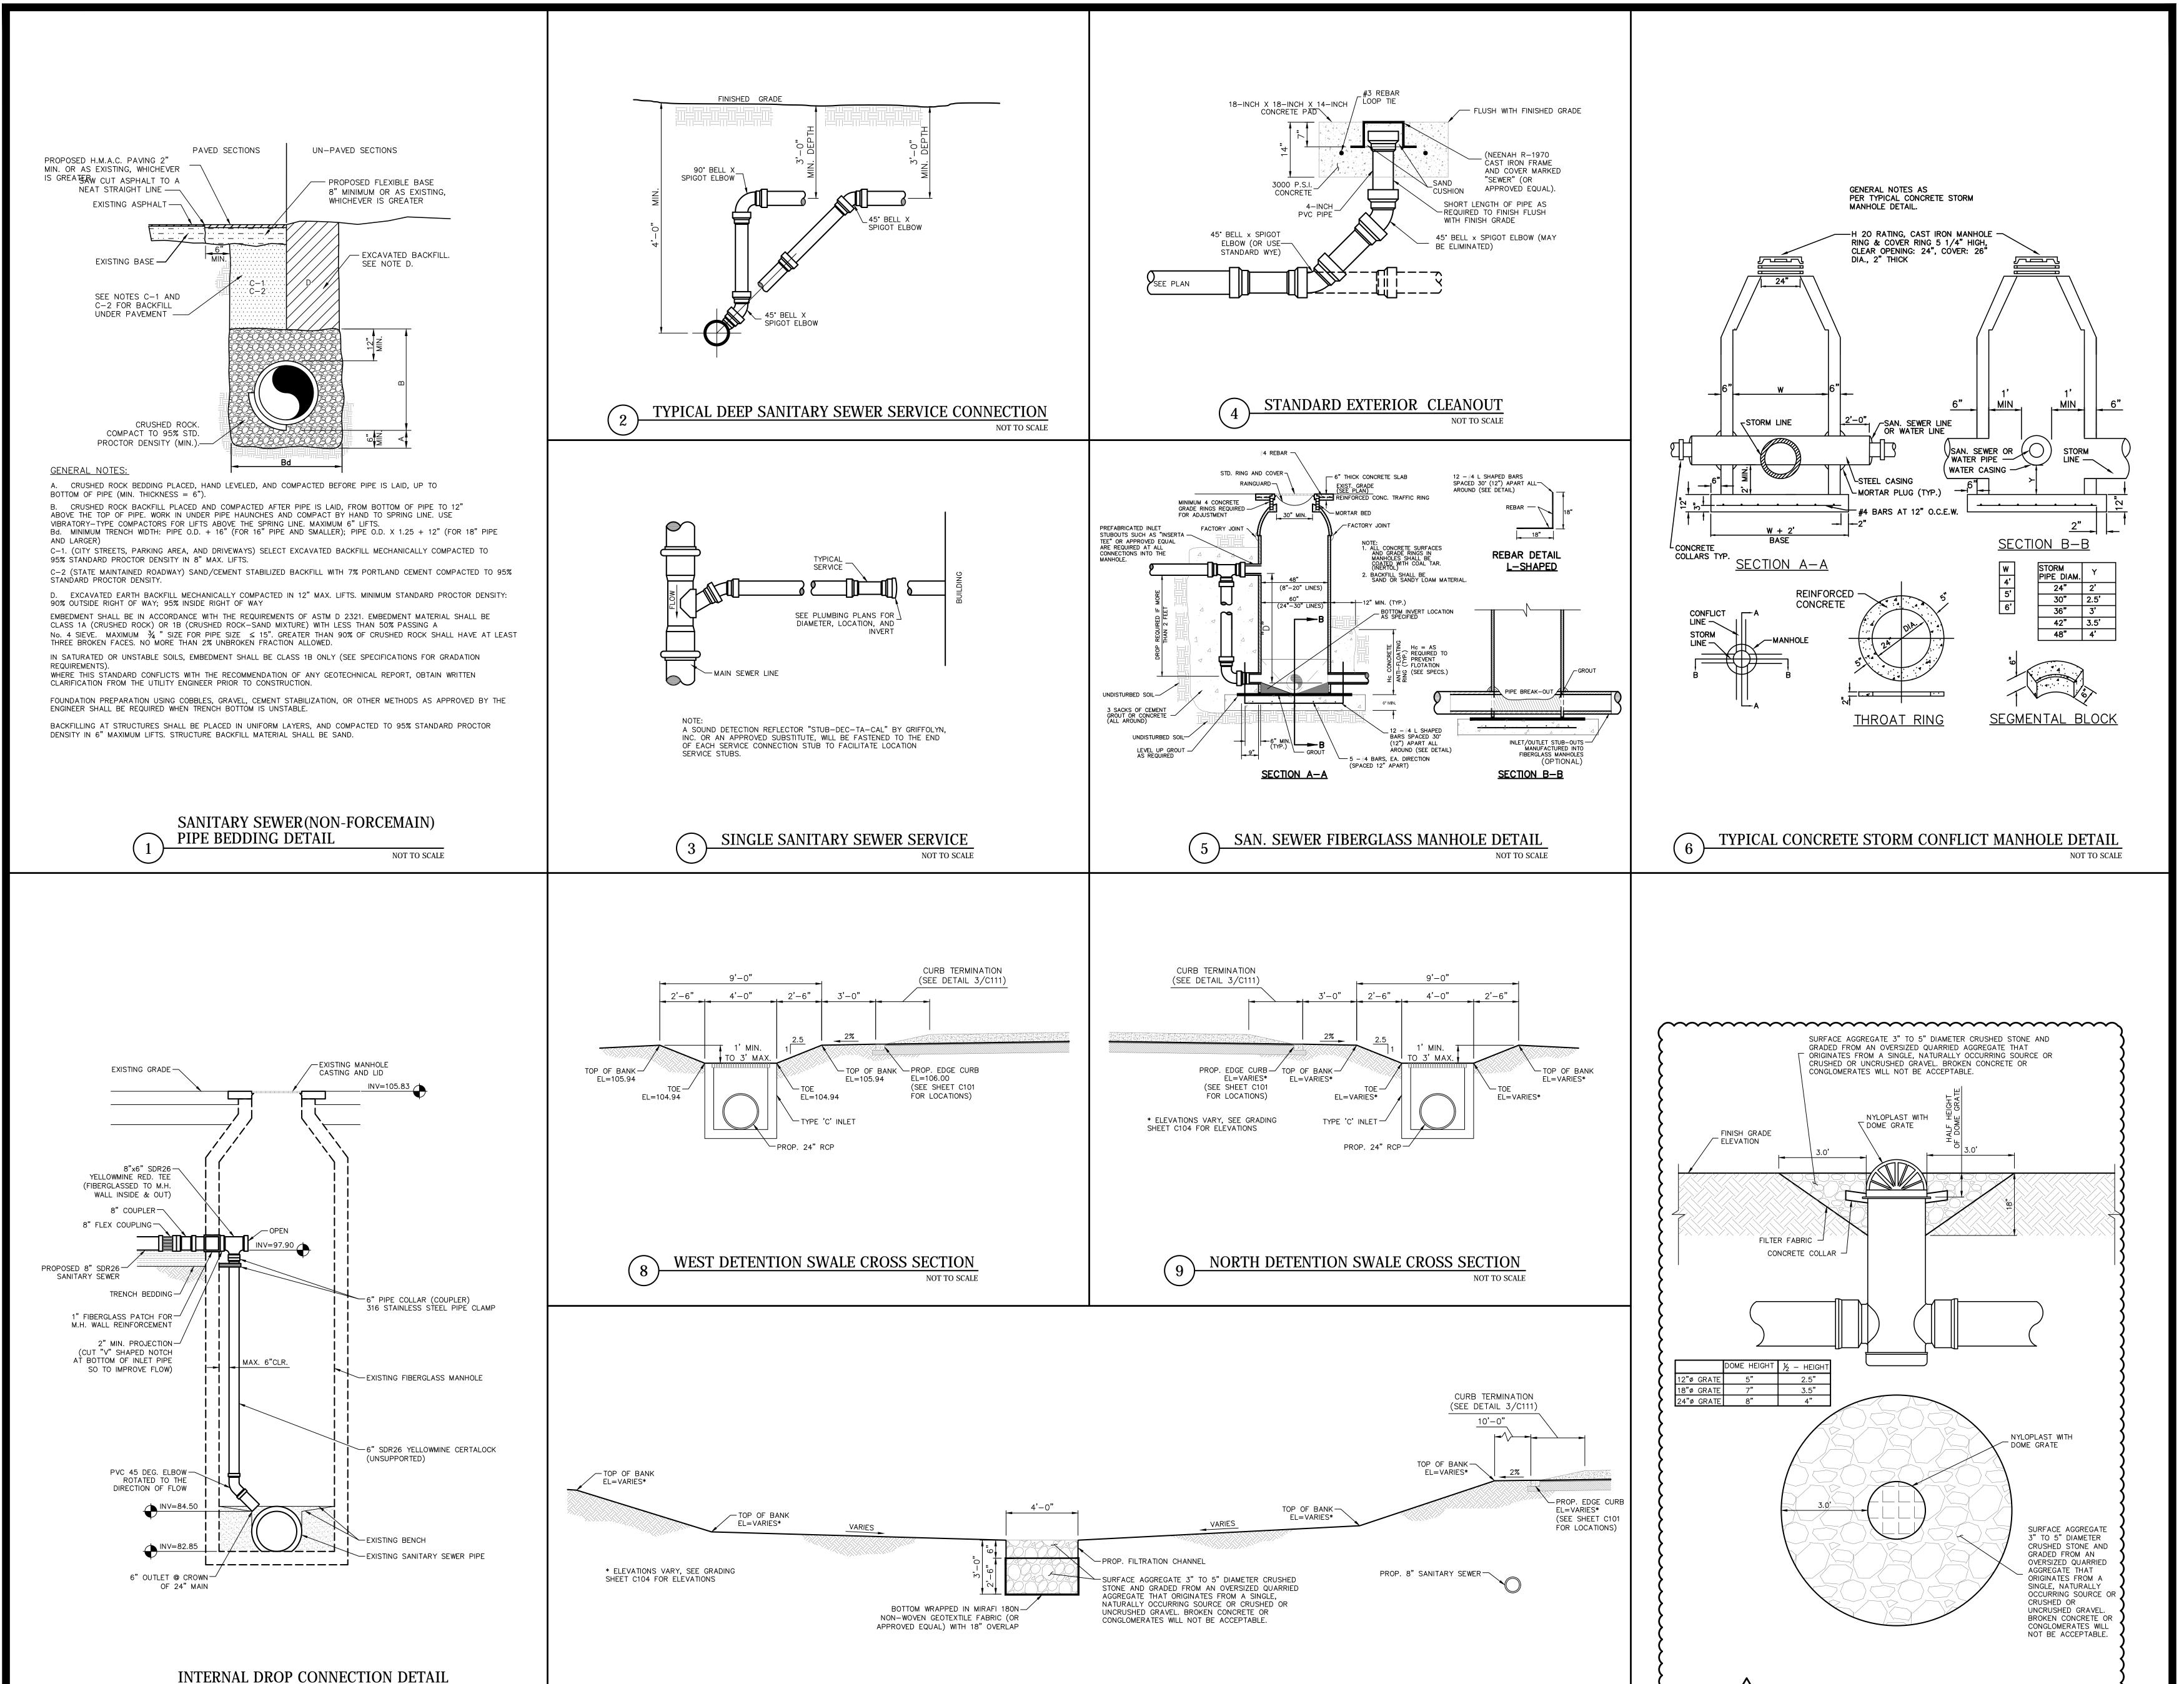

DETENTION POND WITH FILTRATION CHANNEL TYPICAL CROSS SECTION

TO EXISTING MANHOLE (SIOUX ROAD)


NOT TO SCALE



1801 SOUTH SECOND ST. SUITE 330 MCALLEN, TX 78503 956.994.1900 twgarch.com



THESE DRAWINGS AND INFORMATION CONTAINED HEREIN ARE PROPERTY AND THE SOLE PROPERTY OF THE WARREN GROUP ARCHITECTS, INC. THEY MAY NOT BE REUSED, REPRODUCED OR ALTERED IN ANY WAY WITHOUT PRIOR WRITTEN APPROVAL FROM AND APPROPRIATE COMPENSATION TO THE WARREN GROUP ARCHITECTS INC.

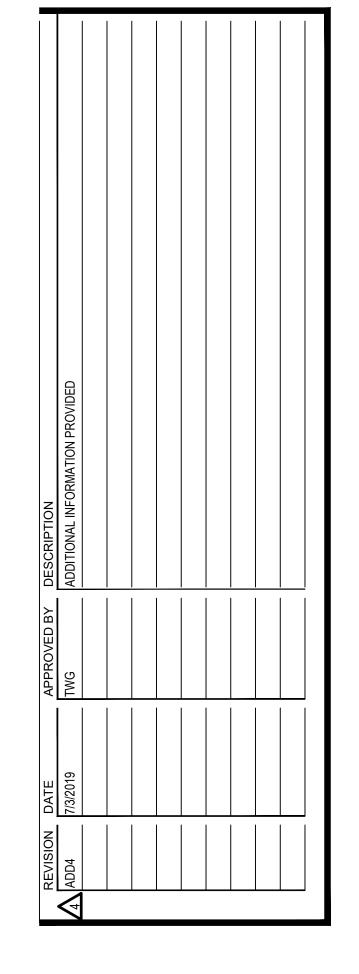



PROPOSED


CITY OF PHARR AQUATIC FACILITY

W SIOUX RD AND EXPRESSWAY 281 PHARR, TEXAS 78577

PROJECT 971805 DATE 6/07/2019 REVISED

TYPICAL DETAILS

TYPICAL NYLOPLAST SECTION

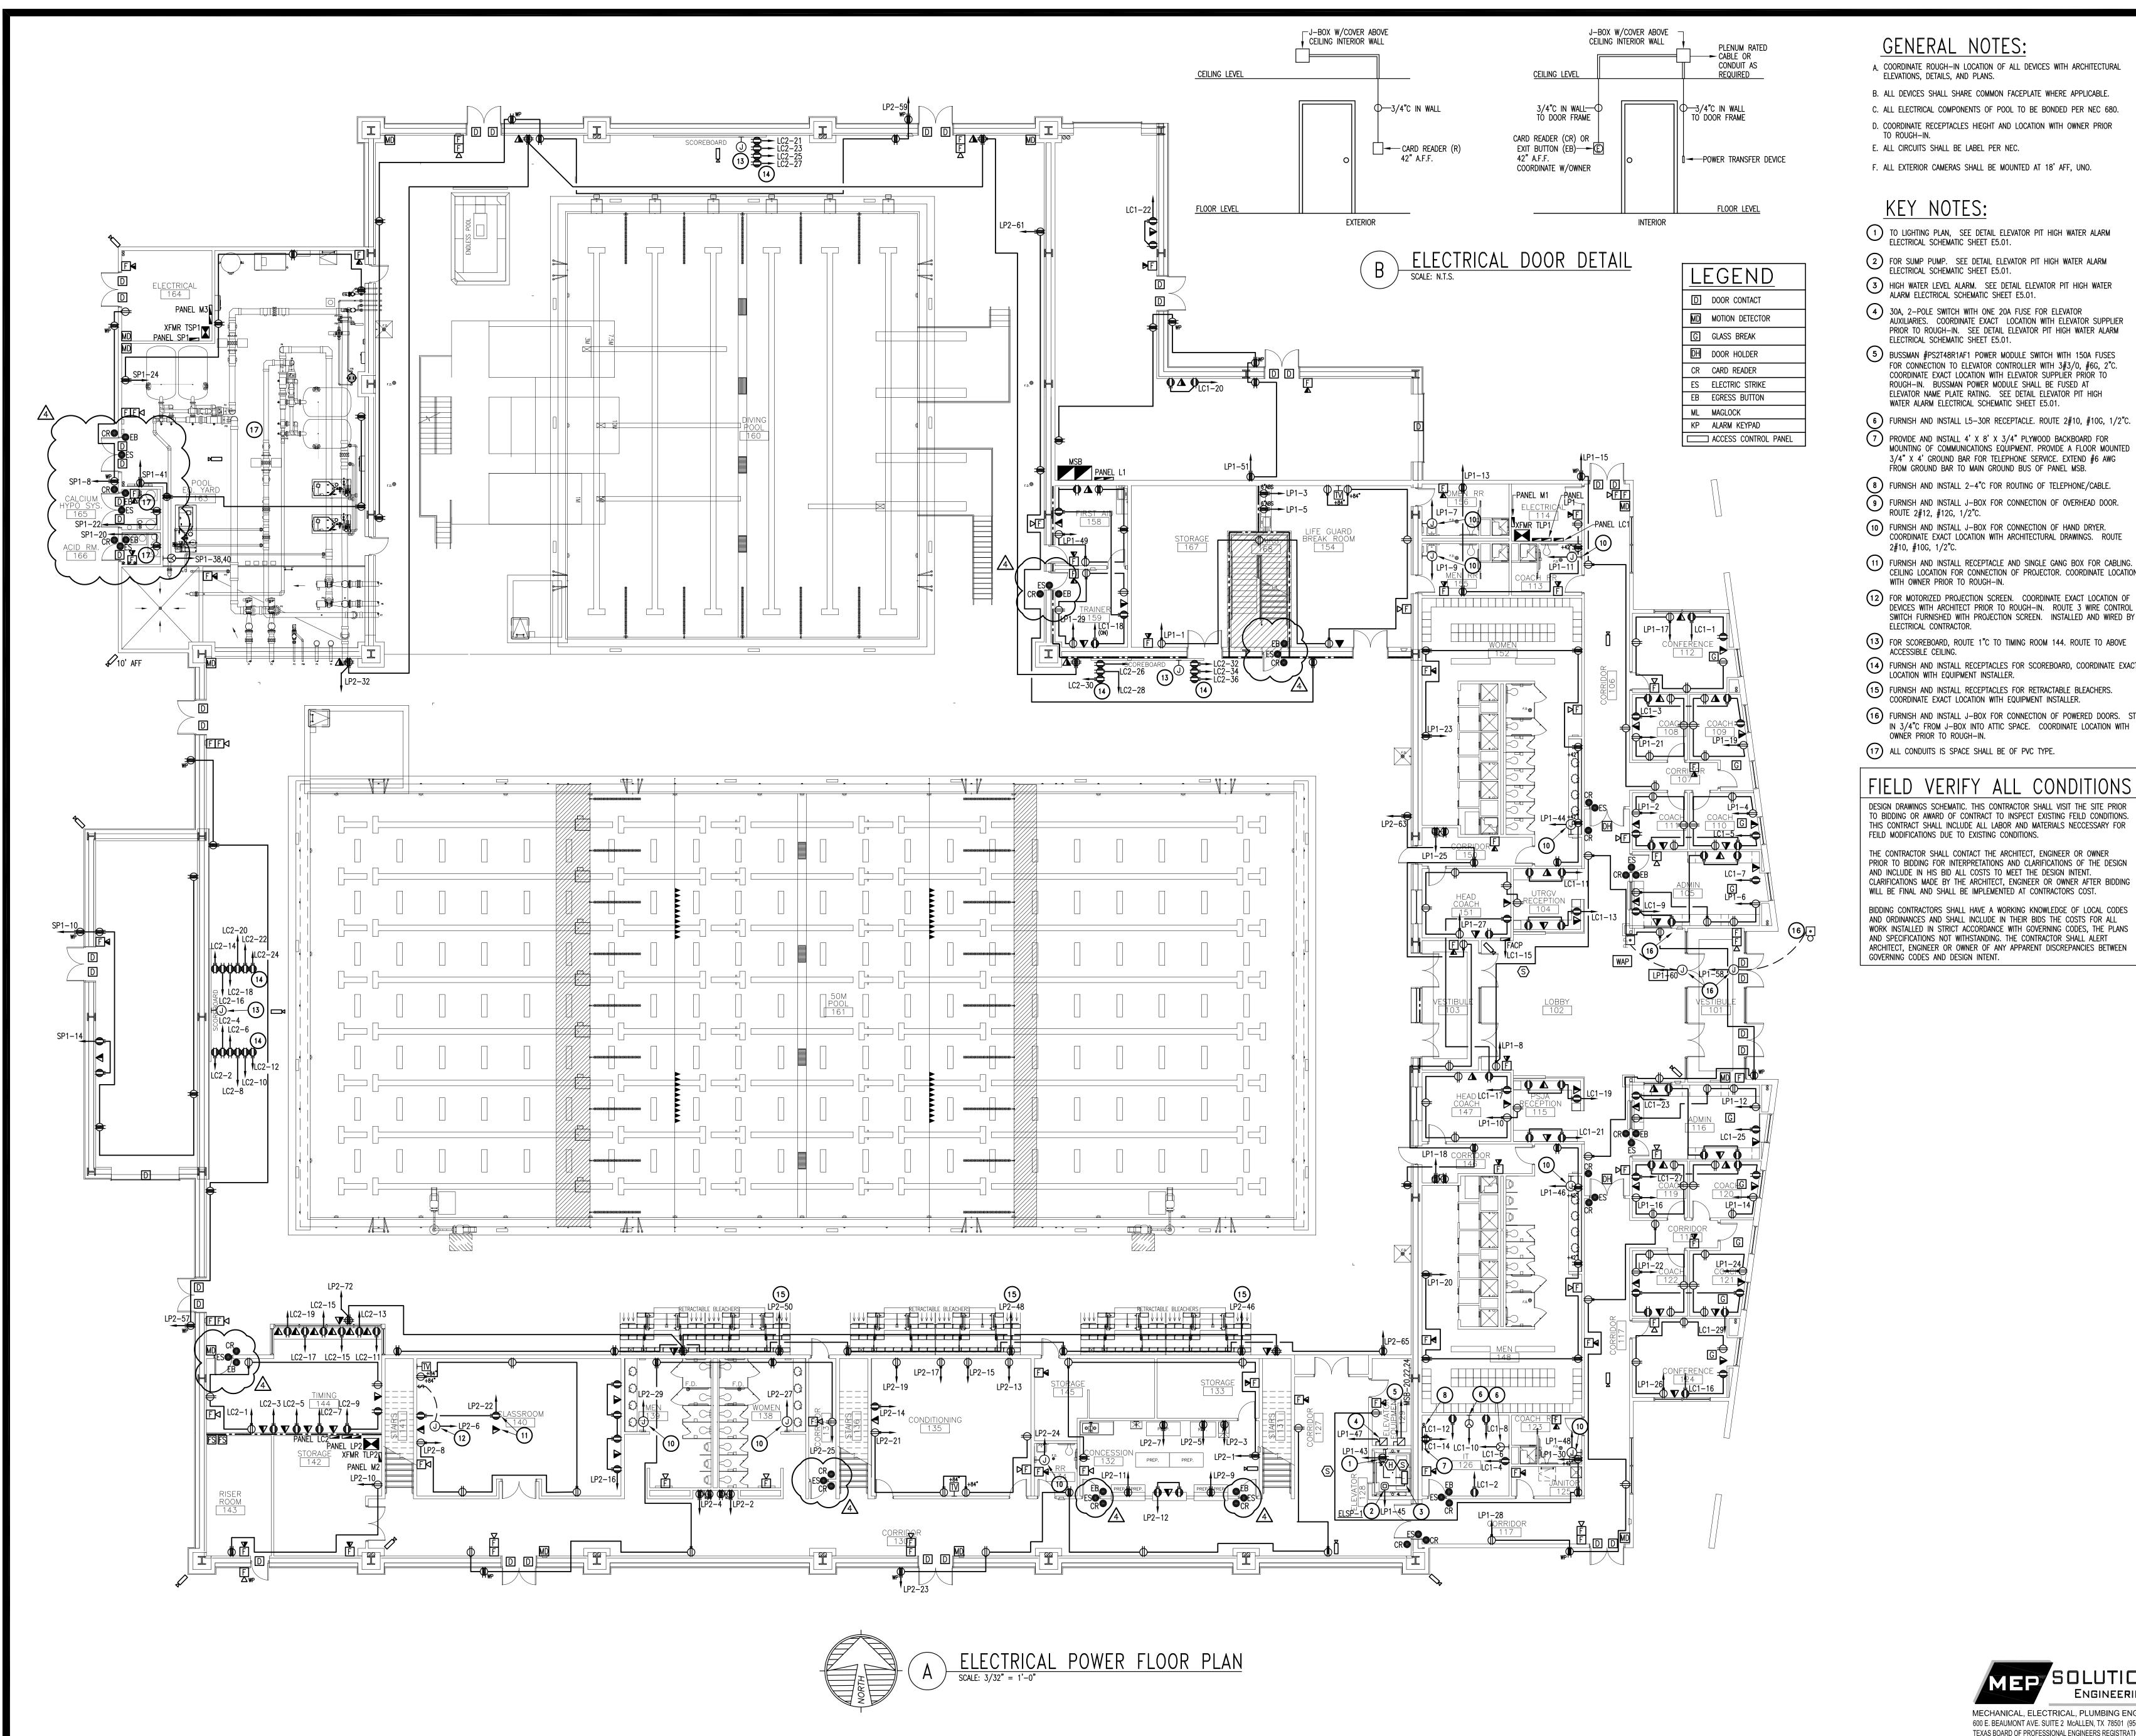

## **GENERAL NOTES:**

- A. COORDINATE ROUGH-IN LOCATION OF ALL DEVICES WITH ARCHITECTURAL
- ELEVATIONS, DETAILS, AND PLANS. B. ALL DEVICES SHALL SHARE COMMON FACEPLATE WHERE APPLICABLE.
- C. ALL ELECTRICAL COMPONENTS OF POOL TO BE BONDED PER NEC 680.
- D. COORDINATE RECEPTACLES HIEGHT AND LOCATION WITH OWNER PRIOR
- E. ALL CIRCUITS SHALL BE LABEL PER NEC.
- F. ALL EXTERIOR CAMERAS SHALL BE MOUNTED AT 18' AFF, UNO.

# KEY NOTES:

- TO LIGHTING PLAN, SEE DETAIL ELEVATOR PIT HIGH WATER ALARM ELECTRICAL SCHEMATIC SHEET E5.01.
- FOR SUMP PUMP. SEE DETAIL ELEVATOR PIT HIGH WATER ALARM ELECTRICAL SCHEMATIC SHEET E5.01.
- HIGH WATER LEVEL ALARM. SEE DETAIL ELEVATOR PIT HIGH WATER ALARM ELECTRICAL SCHEMATIC SHEET E5.01.
- 30A, 2-POLE SWITCH WITH ONE 20A FUSE FOR ELEVATOR AUXILIARIES. COORDINATE EXACT LOCATION WITH ELEVATOR SUPPLIER PRIOR TO ROUGH-IN. SEE DETAIL ELEVATOR PIT HIGH WATER ALARM ELECTRICAL SCHEMATIC SHEET E5.01.
- 5 BUSSMAN #PS2T48R1AF1 POWER MODULE SWITCH WITH 150A FUSES FOR CONNECTION TO ELEVATOR CONTROLLER WITH 3#3/0, #6G, 2°C. COORDINATE EXACT LOCATION WITH ELEVATOR SUPPLIER PRIOR TO ROUGH-IN. BUSSMAN POWER MODULE SHALL BE FUSED AT ELEVATOR NAME PLATE RATING. SEE DETAIL ELEVATOR PIT HIGH WATER ALARM ELECTRICAL SCHEMATIC SHEET E5.01.
- PROVIDE AND INSTALL 4' X 8' X 3/4" PLYWOOD BACKBOARD FOR MOUNTING OF COMMUNICATIONS EQUIPMENT. PROVIDE A FLOOR MOUNTED 3/4" X 4' GROUND BAR FOR TELEPHONE SERVICE. EXTEND #6 AWG FROM GROUND BAR TO MAIN GROUND BUS OF PANEL MSB.
- 8 FURNISH AND INSTALL 2-4"C FOR ROUTING OF TELEPHONE/CABLE. 9 FURNISH AND INSTALL J-BOX FOR CONNECTION OF OVERHEAD DOOR.
- FURNISH AND INSTALL J-BOX FOR CONNECTION OF HAND DRYER. COORDINATE EXACT LOCATION WITH ARCHITECTURAL DRAWINGS. ROUTE 2#10, #10G, 1/2°C.
- FURNISH AND INSTALL RECEPTACLE AND SINGLE GANG BOX FOR CABLING. AT CEILING LOCATION FOR CONNECTION OF PROJECTOR. COORDINATE LOCATION WITH OWNER PRIOR TO ROUGH-IN.
- FOR MOTORIZED PROJECTION SCREEN. COORDINATE EXACT LOCATION OF DEVICES WITH ARCHITECT PRIOR TO ROUGH-IN. ROUTE 3 WIRE CONTROL TO SWITCH FURNISHED WITH PROJECTION SCREEN. INSTALLED AND WIRED BY
- FOR SCOREBOARD, ROUTE 1"C TO TIMING ROOM 144. ROUTE TO ABOVE ACCESSIBLE CEILING.
- FURNISH AND INSTALL RECEPTACLES FOR SCOREBOARD, COORDINATE EXACT LOCATION WITH EQUIPMENT INSTALLER.
- furnish and install receptacles for retractable bleachers. Coordinate exact location with equipment installer.
- FURNISH AND INSTALL J-BOX FOR CONNECTION OF POWERED DOORS. STUB IN 3/4"C FROM J-BOX INTO ATTIC SPACE. COORDINATE LOCATION WITH OWNÉR PRIOR TO ROUGH-IN.
- (17) ALL CONDUITS IS SPACE SHALL BE OF PVC TYPE.

DESIGN DRAWINGS SCHEMATIC. THIS CONTRACTOR SHALL VISIT THE SITE PRIOR TO BIDDING OR AWARD OF CONTRACT TO INSPECT EXISTING FEILD CONDITIONS. THIS CONTRACT SHALL INCLUDE ALL LABOR AND MATERIALS NECCESSARY FOR FEILD MODIFICATIONS DUE TO EXISTING CONDITIONS.

THE CONTRACTOR SHALL CONTACT THE ARCHITECT, ENGINEER OR OWNER PRIOR TO BIDDING FOR INTERPRETATIONS AND CLARIFICATIONS OF THE DESIGN AND INCLUDE IN HIS BID ALL COSTS TO MEET THE DESIGN INTENT. CLARIFICATIONS MADE BY THE ARCHITECT, ENGINEER OR OWNER AFTER BIDDING WILL BE FINAL AND SHALL BE IMPLEMENTED AT CONTRACTORS COST.

BIDDING CONTRACTORS SHALL HAVE A WORKING KNOWLEDGE OF LOCAL CODES AND ORDINANCES AND SHALL INCLUDE IN THEIR BIDS THE COSTS FOR ALL WORK INSTALLED IN STRICT ACCORDANCE WITH GOVERNING CODES, THE PLANS AND SPECIFICATIONS NOT WITHSTANDING. THE CONTRACTOR SHALL ALERT ARCHITECT, ENGINEER OR OWNER OF ANY APPARENT DISCREPANCIES BETWEEN GOVERNING CODES AND DESIGN INTENT.





ARCHITECTS, INC.

1801 SOUTH SECOND ST. SUITE 330 McALLEN, TX 78503 956.994.1900 twgarch.com

THESE DRAWINGS AND INFORMATION CONTAINED HEREIN ARE PROPERTY AND THE SOLE PROPERTY OF THE WARREN GROUP ARCHITECTS, INC. THEY MAY NOT BE REUSED, REPRODUCED OR ALTERED IN ANY WAY WITHOUT PRIOR WRITTEN APPROVAL FROM AND APPROPRIATE COMPENSATION TO THE WARREN GROUP

ARCHITECTS INC.

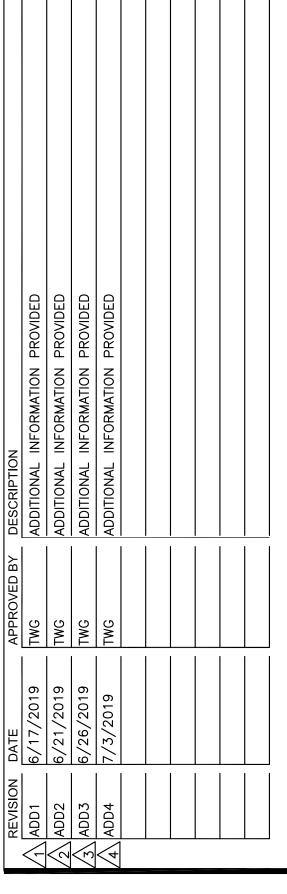

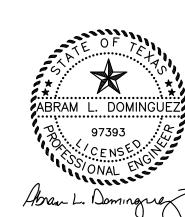

PROPOSED

CITY OF PHARR/PSJA AQUATIC FACILITY

3001 N. CAGE BLVD PHARR, TEXAS 78577

REVISED

MED SOLUTIONS

MECHANICAL, ELECTRICAL, PLUMBING ENGINEERS

600 E. BEAUMONT AVE. SUITE 2 McALLEN, TX 78501 (956) 664-2727 TEXAS BOARD OF PROFESSIONAL ENGINEERS REGISTRATION # F-9748

ENGINEERING

06/07/2019 07/03/2019

E1.02

**ELECTRICAL POWER** FLOOR PLAN

		LIGHTING FIXTURE SCHEDULE						
TYPE	DESCRIPTION	MANUFACTURER & MODEL #	LAMPS/TEMP/VA	VOLT				
A	2X4 EDGE LIT FLAT PANEL FIXTURE	LITHONIA #EPANL 2X4 4800LM 40K MIN1 ZT MVOLT	LED	120/				
		WILLIAMS #LP24 L50 8 40 DIM UNV	4000K					
		METALUX #24FP4740C	47					
		SIGNIFY #2FXP48L840-4-DS-UNV-DIM						
AE	2X4 EDGE LIT FLAT PANEL FIXTURE	LITHONIA #EPANL 2X4 4800LM 40K MIN1 ZT MVOLT E10WCP	LED	120/				
	EMERGENCY BATTERY PACK	WILLIAMS #LP24 L50 8 40 EM/10WRM DIM UNV	4000K					
		METALUX #24FP4740C-EL14W	47					
		SIGNIFY #2FXP48L840-4-DS-UNV-DIM-EMLED						
В	2X4 EDGE LIT FLAT PANEL FIXTURE	LITHONIA #EPANL 2X4 3000LM 40K MIN1 ZT MVOLT	LED	120/				
		WILLIAMS #LP24 L50 8 40 DIM UNV	4000K					
		METALUX #24FP3140C	39					
		SIGNIFY #2FXP38L840-4-DS-UNV-DIM						
BE	2X4 EDGE LIT FLAT PANEL FIXTURE	LITHONIA #EPANL 2X4 3000LM 40K MIN1 ZT MVOLT E10WCP	LED	120/				
	EMERGENCY BATTERY PACK	WILLIAMS #LP24 L50 8 40 EM/10WRM DIM UNV	4000K					
		METALUX #24FP3140C-EL14W	39					
		SIGNIFY #2FXP38L840-4-DS-UNV-DIM-EMLED						
С	6" RECESSED DOWNLIGHT	LITHONIA #LDN6 40/10 L06 AR MVOLT	LED	120/				
		WILLIAMS # 6DR-TL L10 8 40 DIM UNV O W CS	4000K					
		HALO COMMERCIAL #PD610ED010-PDM6A840-61VC	13					
		SIGNIFY #6RN / P6RDL10840CLZ10U						
CE	6" RECESSED DOWNLIGHT	LITHONIA #LDN6 40/10 L06 AR MVOLT EM	LED	120/				
	EMERGENCY BATTERY PACK	WILLIAMS # 6DR-TL L10 8 40 EM/10W DIM UNV 0 W CS	4000K					
		HALO COMMERCIAL #PD610ED010IEM-PDM6A840-61VC	13					
		SIGNIFY #6RNEM / P6RDL10840CLZ10U						
D	6" RECESSED DOWNLIGHT	LITHONIA #LDN6 40/20 L06 AR MVOLT	LED	120/				
		WILLIAMS # 6DR-TL L20 8 40 DIM UNV O W CS	4000K					
		HALO COMMERCIAL #PD620ED010-PDM6A840-61VC	23					
		SIGNIFY #6RN / P6RDL20840CLZ10U						
DE	6" RECESSED DOWNLIGHT	LITHONIA #LDN6 40/20 L06 AR MVOLT EM	LED	120/				
0_	EMERGENCY BATTERY PACK	WILLIAMS # 6DR-TL L20 8 40 EM/10W DIM UNV 0 W CS	4000K	,				
	EMERGENOT BATTERY THOR	HALO COMMERCIAL #PD620ED010IEM-PDM6A840-61VC	23					
		SIGNIFY #6RNEM / P6RDL20840CLZ10U						
F	4' STRIPLIGHT	LITHONIA #ZL1N L48 3000LM FST MVOLT 40K WH	LED	120/				
'	- Sittli Liotti	METALUX #4SNLED-33SL-LW-UNV-L840-CD1	4000K	120/				
		WILLIAMS #75R 4 L30 8 40 DIM UNV	33					
		SIGNIFY #FSS430L840-UNV-DIM						
FE	4' LED STRIPLIGHT	LITHONIA #ZL1N L48 3000LM FST MVOLT 40K 80CRI E7W WH	LED	120/				
'-	EMERGENCY BATTERY PACK	METALUX #4SNLED-33SL-LW-UNV-EL7W-L840-CD1	4000K	1207				
	EMENGENCI BATTENT FACIN	WILLIAMS #75R 4 L30 8 40 EM/7WRM DIM UNV	33					
		SIGNIFY #FSS430L840-UNV-DIM-EMLED						
G2	2' RECESSED PERIMETER LIGHTING	MARK ARCHITECTURAL #SPRLED LOP 2FT RLP FL 80CRI 40K 400LMF MVOLT	LED	120/				
GZ	2 RECESSED FERIMETER LIGHTING	CORONET #FLAWLESS LED 2 40 LTG1 UNV	4000K	120/				
		CONONLY #1 DAMLESS LED Z 40 LIGI ONV	7					
			'					
G3	3' RECESSED PERIMETER LIGHTING	MARK ARCHITECTURAL #SPRLED LOP 3FT RLP FL 80CRI 40K 400LMF MVOLT	LED	120/				
GO	3 RECESSED PERIMETER LIGHTING	CORONET #FLAWLESS LED 3 40 LTG1 UNV	4000K	120/				
		CONONEL #FLAWLESS LED S 40 LIGI ONV						
			10					
	d process provided Lighting	MADIC ADOLUTECTURAL #CDDLED LOD AFT DLD EL SOCOL AGIC AGGLAE ANGLE	LED	100 /				
G4	4' RECESSED PERIMETER LIGHTING	MARK ARCHITECTURAL #SPRLED LOP 4FT RLP FL 80CRI 40K 400LMF MVOLT		120/				
		CORONET #FLAWLESS LED 4 40 LTG1 UNV	4000K					
			14					
117	7, 150 0/0757	CODONET #DUCH DEC LED 7' 40 LTG4 LIMI	LED	400 /				
Н3	3' LED SYSTEM	CORONET #RUSH REC LED 3' 40 LTG1 UNV	LED	120/				
	STANDARD OUTPUT	MARK ARCHITECTURAL #SL2L-LOP-3FT-FLP-TG-80CRI-40K-600LMF-MIN10-277-ZT	4000K					
	120 DEGREE SYMMETRIC		21					
		OODONET #PUOL PEOLED 42 40 1704 1984	1.50	100				
H4	4' LED SYSTEM	CORONET #RUSH REC LED 4' 40 LTG1 UNV	LED	120/				
	STANDARD OUTPUT	MARK ARCHITECTURAL #SL2L-LOP-4FT-FLP-TG-80CRI-40K-600LMF-MIN10-277-ZT	4000K					
	120 DEGREE SYMMETRIC		28					
		POPPOUET HOUSE PER AL 12 1721 HOUSE TO	1.50					
H4E	4' LED SYSTEM	CORONET #RUSH REC LED 4' 40 LTG1 UNV EM	LED	120/				
	STANDARD OUTPUT	MARK ARCHITECTURAL #SL2L-LOP-4FT-FLP-TG-80CRI-40K-600LMF-MIN10-277-E10WLCP-ZT	4000K					
	120 DEGREE SYMMETRIC		28					
	EMERGENCY BATTERY PACK							
K	4' LED HIGH BAY	LUX DYNAMICS #LUX-WAVE-8-D-HO2-850-4'-U10-CA4'	LED	120/				
	INDOOR DIRECT/INDIRECT LUMINAIRE	SPECGRADE #AFL-800-5000K-90X90-110/277-WT-NAT-CTAX1	5000K					
	CLEAR ACRYLIC	AMETRIX #ASYX-QP-S-6-NT-U-L40-1-UNV-W-C-XX-STD	724					
		METALUMEN #NATA DI 22L40K-NC M-L2 4						
KE	4' LED HIGH BAY	LUX DYNAMICS #LUX-WAVE-8-D-HO2-850-4'-U10-CA4' EM	LED	120/				
	INDOOR DIRECT/INDIRECT LUMINAIRE	SPECGRADE #AFL-800-5000K-90X90-110/277-WT-NAT-CTAX1 EM	5000K	<u> </u>				
	CLEAR ACRYLIC	AMETRIX #ASYX-QP-S-6-NT-U-L40-1-UNV-W-C-XX-STD EM	724					
	· <del></del> · -	METALUMEN #NATA DI 22L40K-NC M-L2 4 EM	1	ĺ				

D/D =	DECODIFICAL	LIGHTING FIXTURE SCHEDULE  [MANUFACTURER & MODEL #	LAMPS/TEMP/VA	
	DESCRIPTION	"	<u> </u>	VOLTA
М	THE MARINER	SOLAS RAY LIGHTING #LQ-H4-112-50-X-XX	LED	120/
	4' VAPOR TIGHT LINEAR	DURAGUARD #LV4AOQ F 112 U 4K XX XX	4000K	
	EMERGENCY BATTERY PACK		127	
				100 /
ME	THE MARINER	SOLAS RAY LIGHTING #LQ-H4-112-50-X-XX-BB	LED	120/2
	4' VAPOR TIGHT LINEAR	DURAGUARD #LV4AOQ F 112 U 4K XX XBU	4000K	
	EMERGENCY BATTERY PACK		127	
NE	4' STAIRWAY FIXTURE	LITHONIA #WL4 30L LP840 MSD7 DIM10 EL14L	LED	120/2
	EMERGENCY BATTERY PACK	METALUX #4SWLED-LD4-32SL-LW-UNV-EL14W-L840-CD1-SVPD2	4000K	
	DIMS TO 10% UNOCCUPIED	ILP CVL4-30WLED-UNIV-40-USBD/HL	30	
		SIGNIFY #SF4C33A40UDZT-US-EMLED		
Р	2'X4' EDGE LIT FLAT PANEL FIXTURE	LITHONIA #EPANL 2X4 4800LM 40K MIN1 ZT MVOLT DGA24	LED	120/2
	DRYWALL GRID ADAPTER	WILLIAMS #LP24 L50 8 40 DFK-2448W DIM UNV	4000K	
		METALUX #24FP4740C-DF-4W-U	47	
		SIGNIFY #2FXP48L840-4-DS-UNV-DIM-FMA24		
Q	2'X4' EDGE LIT FLAT PANEL FIXTURE	LITHONIA #EPANL 2X4 3000LM 40K MIN1 ZT MVOLT DGA24	LED	120/2
	DRYWALL GRID ADAPTER	WILLIAMS #LP24 L50 8 40 DFK-2448W DIM UNV	4000K	
		METALUX #24FP3140C-DF-4W-U	39	
		SIGNIFY #2FXP38L840-4-DS-UNV-DIM-FMA24		
QE	2'X4' EDGE LIT FLAT PANEL FIXTURE	LITHONIA #EPANL 2X4 3000LM 40K MIN1 ZT MVOLT E10WCP DGA24	LED	120/2
	EMERGENCY BATTERY PACK	WILLIAMS #LP24 L50 8 40 DFK-2448W EM/10WRM DIM UNV	4000K	
	DRYWALL GRID ADAPTER	METALUX #24FP3140C-EL14W-DF-4W-U	39	
	Sitting Control of the Control of th	SIGNIFY #2FXP38L840-4-DS-UNV-DIM-EMLED-FMA24		
SA	SINGLE HEAD ARM MOUNTED AREA LIGHT	LITHONIA #RSX2 LED P2 40K R3	LED	120/2
<b>5</b> , (	TYPE R3 DISTRIBUITION	LSI #SLM LED 18L SIL 3 UNV DIM 40 70CRI XX	4000K	120/2
	30' POLE, 24" PEDESTAL	LOT WOLL LED TOL OLD O ONY DIM TO YOUN AN	114	
	30 FOLE, 24 FEDESTAL		''+	
SB	FOUR HEAD ARM MOUNTED AREA LIGHT	LITHONIA #RSX2 LED P2 40K R5	LED	120/2
SD	TYPE R5 DISTRIBUITION	LSI #SLM LED 18L SIL 5W UNV DIM 40 70CRI XX	4000K	120/2
		LSI #SLM LED TOL SIL SW ONV DIM 40 /OCK XX		
	30' POLE, 24" PEDESTAL		456	
SC	ARCHITECTURAL WALL SCONCE	LITHONIA #WST LED P3 40K VF MVOLT	LED	120/2
<b>3</b> C				120/2
	TYPE FORWARD THROW DISTRIBUTION	RAYON #T630LED 40 UNI12 40 T3 BZ	4000K	
	FINISH AS SELECTED BY ARCHITECT	McGRAW-EDISON #IST-AF-1000-LED-E1-T4FT-XX	50	
	TEGO III ODOLING LIBINARE	SIGNIFY #101L-32L-700-NW-G1-4-UNV-XX	1.50	400 /0
SD	TESIS IN-GROUND LUMINAIRE	ERCO #33640.000	LED	120/2
	RECESSED HOUSING POLYMER	HYDREL #M9710C-SS-P1-30K-MVOLT-NSP-FLC20-34S-BL	4000K	
			20	
		LINADEL MUCZOOO LED DO 401/ HIND		
SF	M9700C IN-GRADE LUMINAIRE	HYDREL #M9700C LED P2 40K WWD	LED	120/2
		LUMASCAPE # LS3080 30 S 840 A X XX XX 24 0 01 ND	4000K	
			35	
SH	16" SITE IN-GROUND LUMINAIRE	ERCO #32848.023	LED	120/2
	GRAZING LIGHT WALLWASHER	TARGETTI #JE-R-10-WG-24-30K-L	3000K	
			24	
SJ	THREE HEAD ARM MOUNTED AREA LIGHT	LITHONIA #RSX2 LED P2 40K R3	LED	120/2
	TYPE R3 DISTRIBUITION	LSI #SLM LED 18L SIL 3 UNV DIM 40 70CRI XX	4000K	
	30' POLE, 24" PEDESTAL		342	
SK4	4' RHYTHM LINEAR LED FLOOD	HYDREL #RHY4 SSBR WHT41K MVOLT WWD ASM EASRM18 HVSR CSL20 ETE DBL	LED	120/2
	WALL WASH DISTRIBUTION, ADJUSTABLE SURFACE MOUNT	ORGATECH 3 1200 4 LH 40 U ND 120 SW XX	4100K	
	18" EXTENDED ARM WITH STRUT, HALF VISOR		57	
SL	4' LINEAR LED FLOOD LIGHT	HYDREL #4750L 4FT 2000LMF 40K VNSP	LED	120/2
		ORGATECH 3 1200 4 LH 40 U ND 120 SW XX	4000K	<b>'</b>
			64	
Х	UNIVERSAL EXIT LIGHT WITH BATTERY PACK,	LITHONIA #LQMSW3R120/277ELN	LED'S FURNISHED	120/2
		MULE #MX-B-R-U		
		SURE-LITES #LPX7		
		EELP #XE2RW—EM		
	1		Ī	1

A ELECTRICAL LIGHTING FIXTURE SCHEDULE SCALE: N.T.S.

 $\bigcirc$ 

JNIT	HVLS-1, HVLS-2
SPACE SERVED	SPECTATOR AREA
AIRFLOW AT 100% SPEED (CFM)	86,400
AIRFLOW AT 80% SPEED (CFM)	69,000
AIRFLOW AT 60% SPEED (CFM)	50,500
AIRFLOW AT 40% SPEED (CFM)	34,300
AIRFLOW AT 20% SPEED (CFM)	18,800
FAN TYPE	DIRECT DRIVE
FAN MOTOR HP	3/4
MAX RATED CURRENT (A)	1.0
VOLTAGE	460/3/60
MAX DIAMETER (FT)	14
NUMBER OF FAN BLADES	5
MAX OP WEIGHT (LB)	168
NOTES	ALL
NOTES:	
1. FAN CFM AIRFLOW SHALL BE RATED PER AMCA 230-15.	
2. PROVIDE NEMA 4X VFD REMOTE MOUNTED MOTOR CONTRACCEPTABLE.	COLLER. FAN MOUNTED MOTOR CONTROLLERS ARE NOT

B ELECTRICAL HVLS FAN SCHEDULE
SCALE: N.T.S.

4. PROVIDE DIRECT DRIVE MOTOR. GEAR DRIVEN SYSTEMS ARE NOT ALLOWED.

5. SEE SPECIFICATION FOR CONSTRUCTION AND OTHER REQUIREMENTS.





1801 SOUTH SECOND ST.

SUITE 330

McALLEN, TX 78503

956.994.1900

twgarch.com

ESE DRAWINGS AND INFORMATION
NTAINED HEREIN ARE PROPERTY AND
SOLE PROPERTY OF THE WARREN
DUP ARCHITECTS, INC. THEY MAY NOT
REUSED, REPRODUCED OR ALTERED IN
WAY WITHOUT PRIOR WRITTEN
PROVAL FROM AND APPROPRIATE
MPENSATION TO THE WARREN GROUP
CHITECTS INC.

REVISION         DATE         APPROVED BY         DESCRIPTION           ADD1         TWG         ADDITIONAL INFORMATION PROVIDED           ADD3         6/26/2019         TWG         ADDITIONAL INFORMATION PROVIDED           ADD4         7/3/2019         TWG         ADDITIONAL INFORMATION PROVIDED           ADD4         7/3/2019         TWG         ADDITIONAL INFORMATION PROVIDED           ADD4         ADDITIONAL INFORMATION PROVIDED         ADDITIONAL INFORMATION PROVIDED								
6/17/2019 6/21/2019 6/26/2019 7/3/2019	DESCRIPTION	ADDITIONAL INFORMATION PROVIDED	ADDITIONAL INFORMATION PROVIDED	ADDITIONAL INFORMATION PROVIDED	ADDITIONAL INFORMATION PROVIDED			
z	APPROVED BY	TWG	TWG	TWG	TWG			
z	DATE	6/17/2019	6/21/2019	6/26/2019	7/3/2019			
	REVISION				ADD4			



PROPOSED

CITY OF PHARR/PSJA AQUATIC FACILITY

3001 N. CAGE BLVD PHARR, TEXAS 78577

PROJECT DATE REVISED

971805 06/07/2019 07/03/2019

E3.01

ELECTRICAL LIGHTING FIXTURE SCHEDULE